



I-89 RAMP "D" STA. 52+00

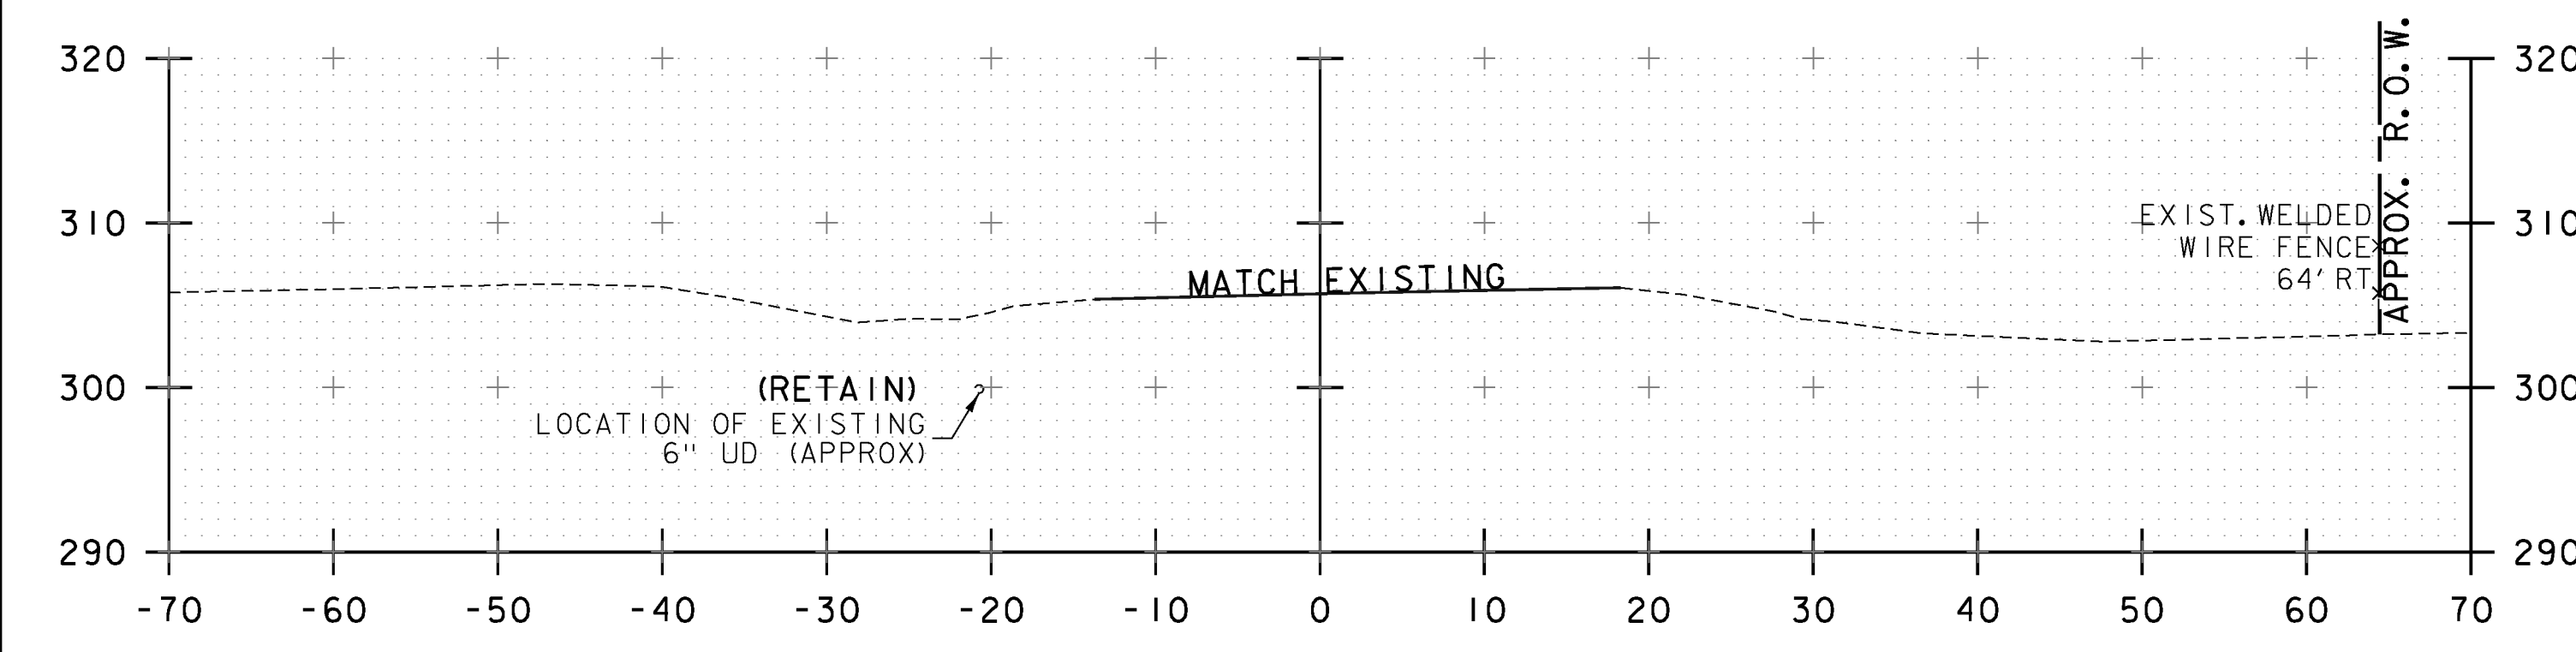


I-89 RAMP "D" STA. 51+50


MATCH EXISTING BCP I-89 RAMP "D" STA. 51+25

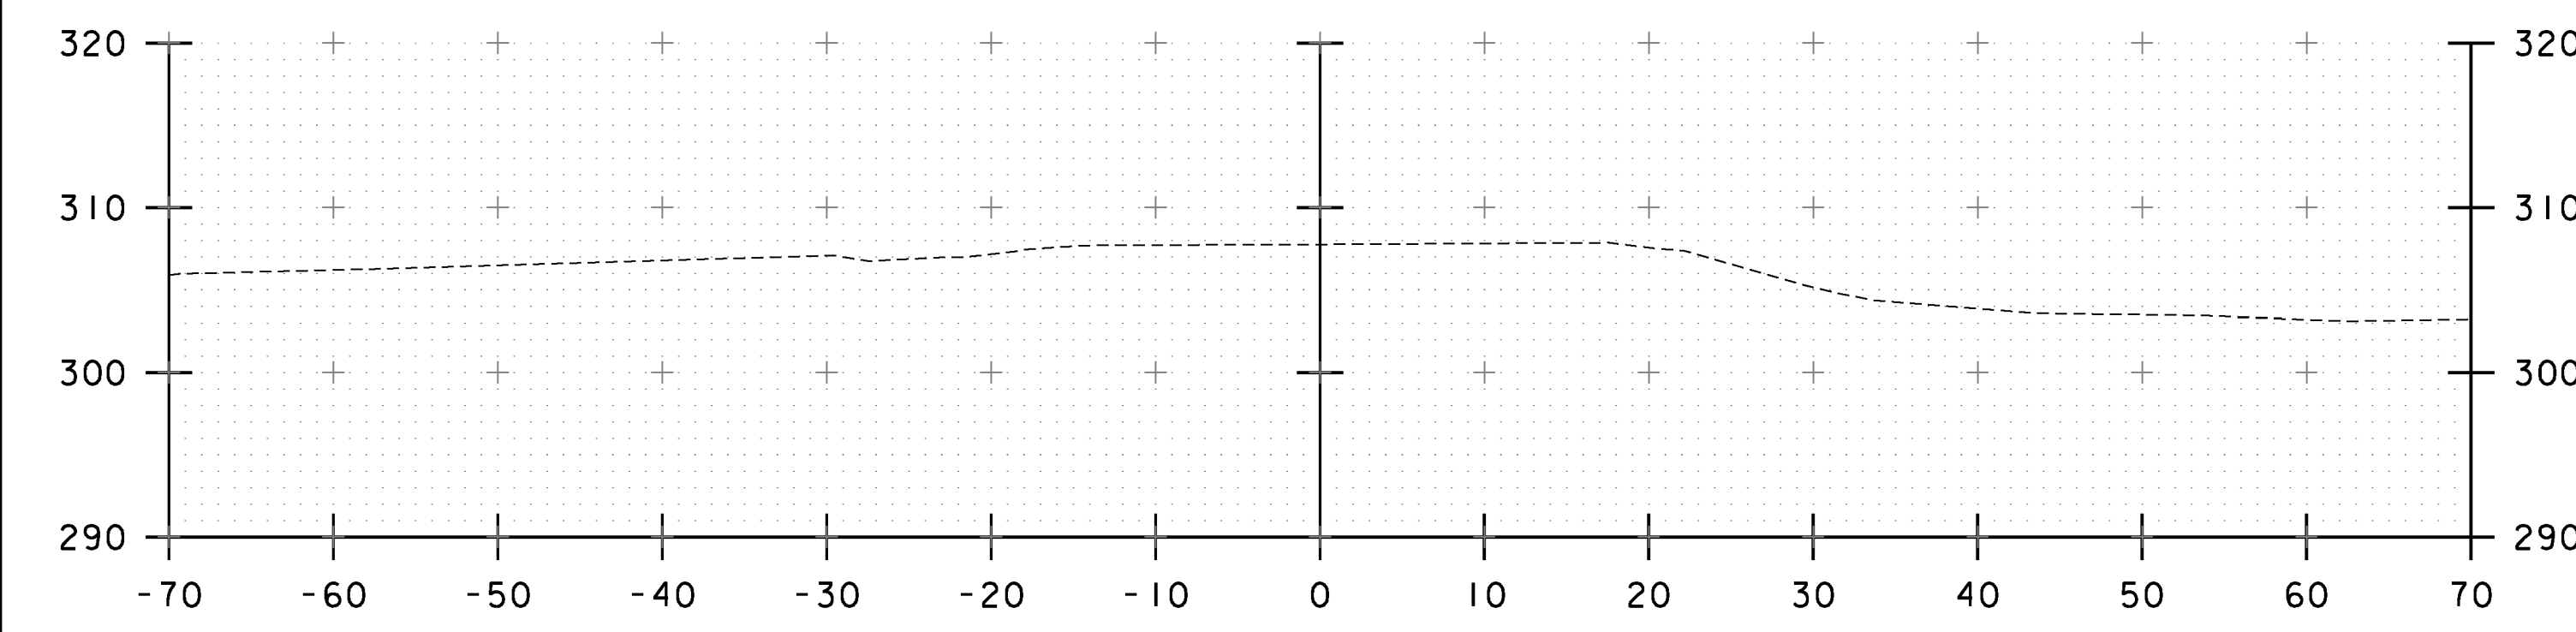


I-89 RAMP "D" STA. 51+00

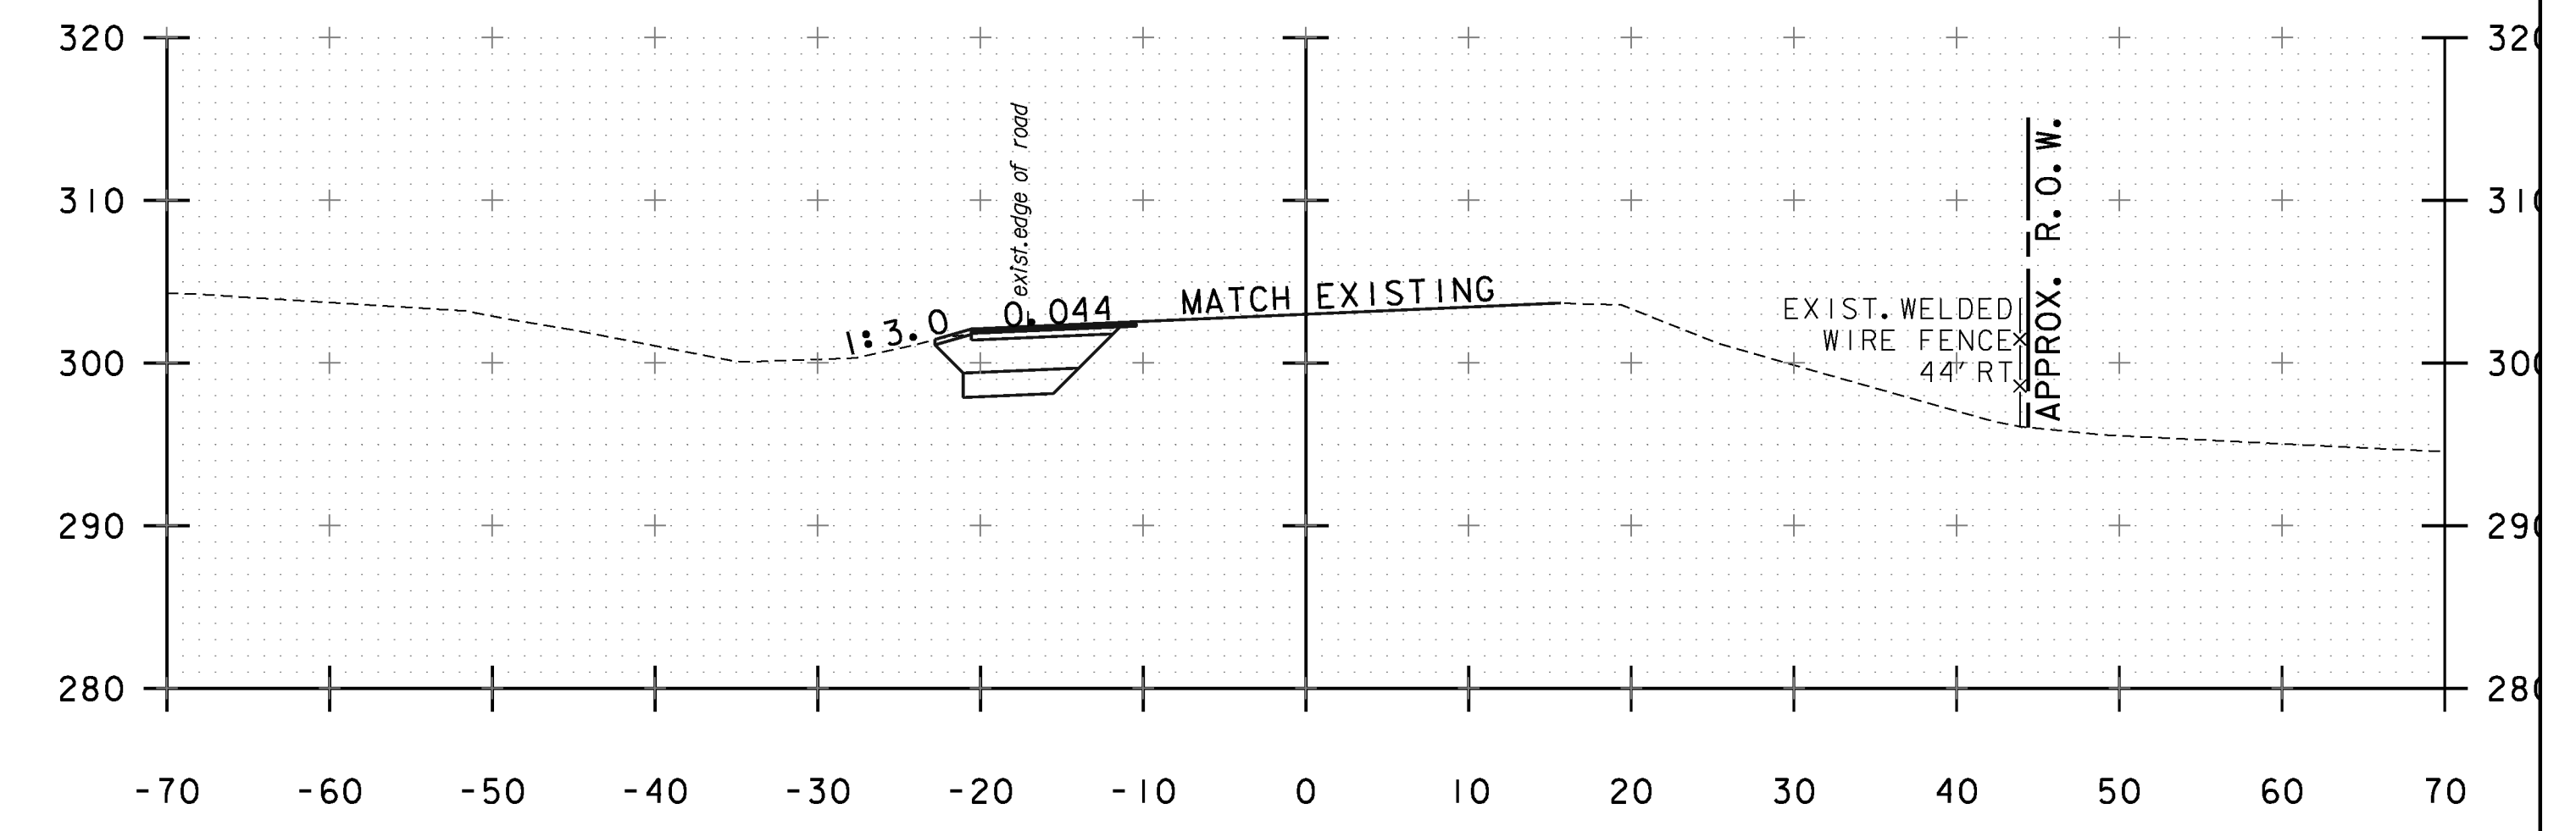

I-89 RAMP "D" STA. 53+00

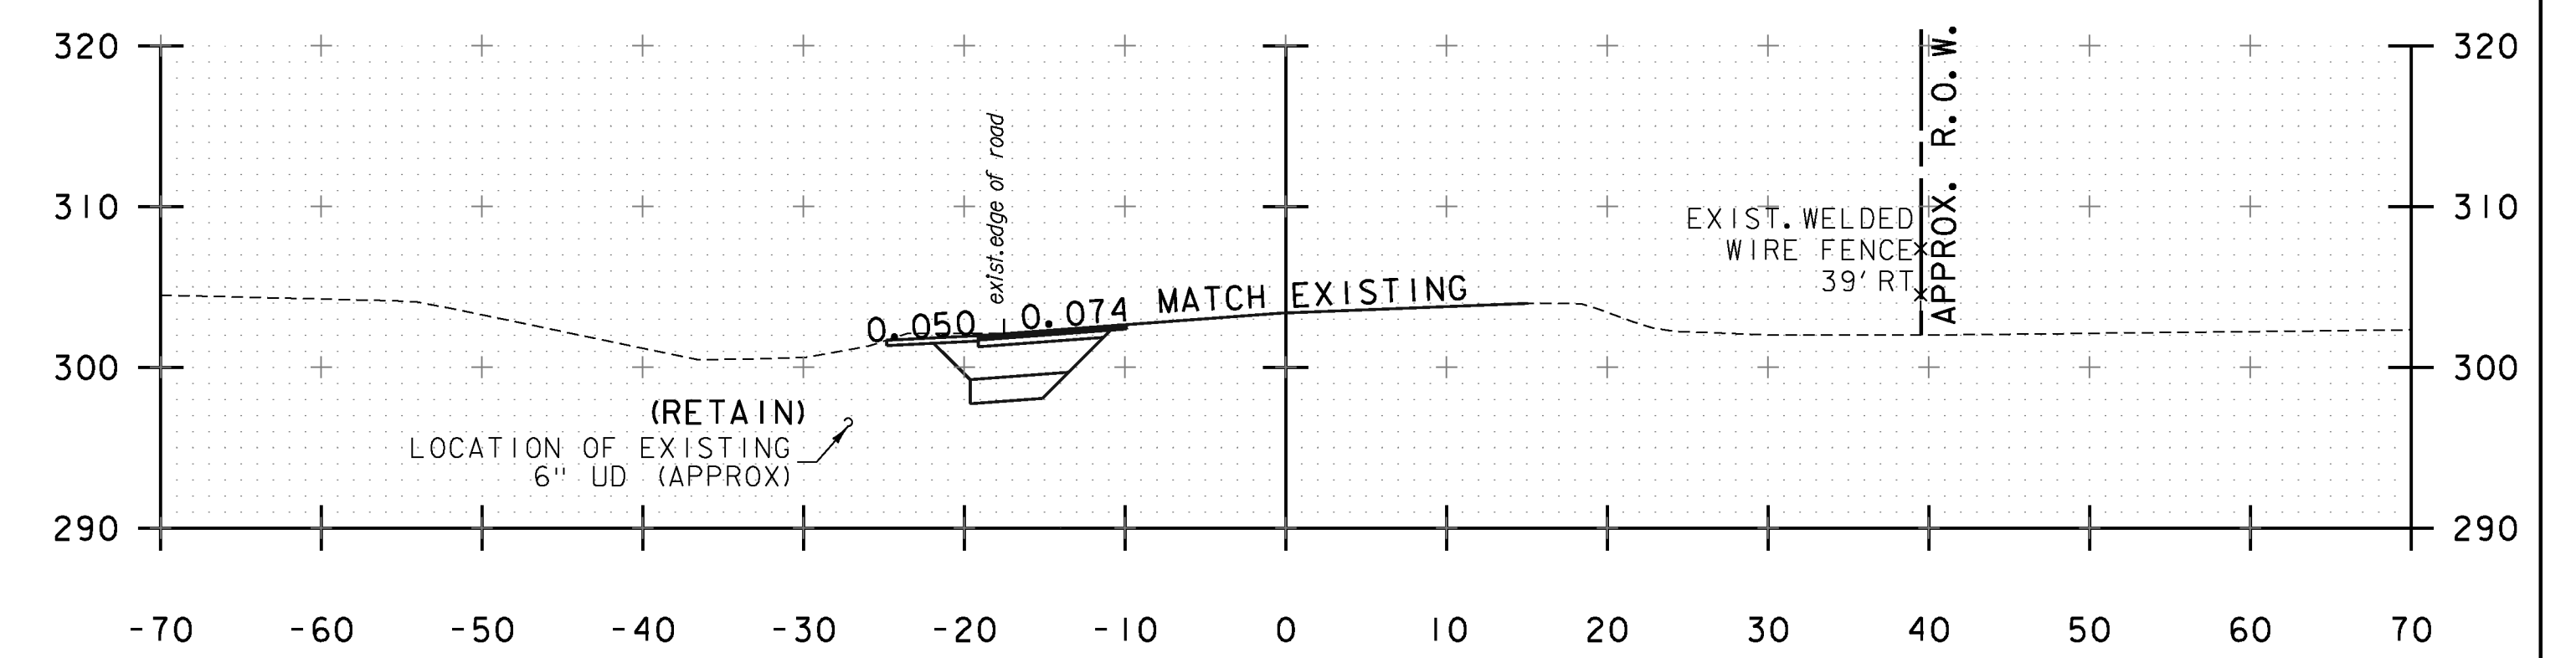

I-89 RAMP "D" STA. 52+50

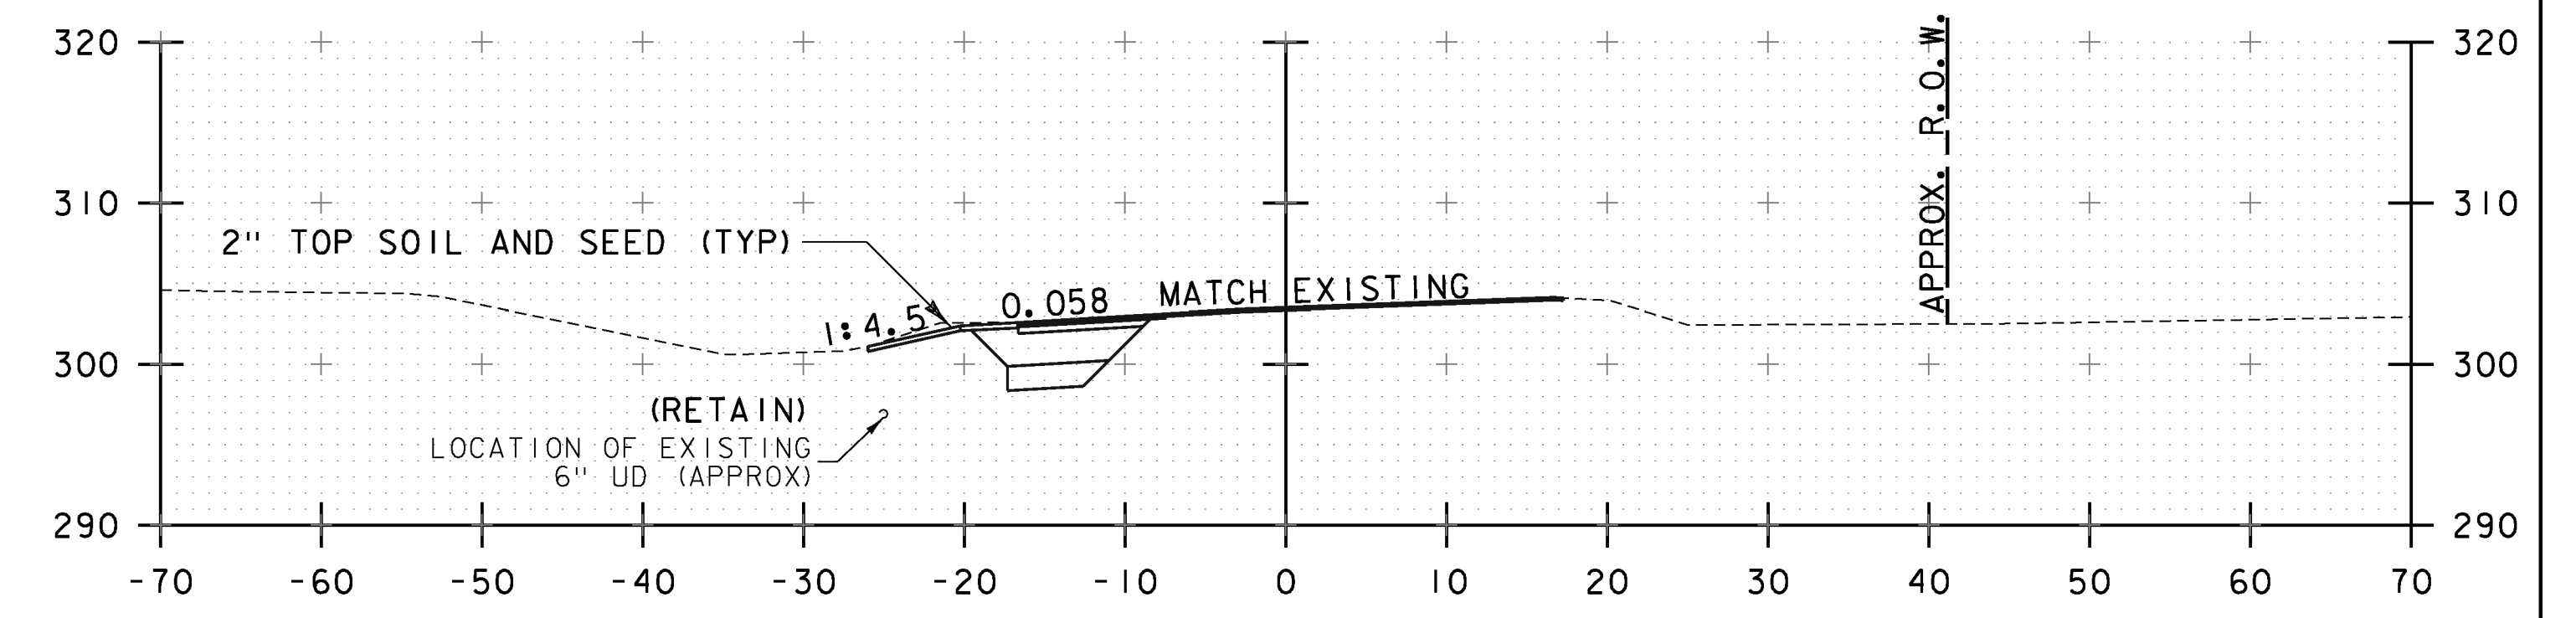

PC 52+35.51

PROJECT NAME: RICHMOND	FILE NAME: z97cl86xsl.dgn	PLOT DATE: 4/29/2013
PROJECT NUMBER: STP 0284 (17)	PROJECT LEADER: ERIK ATKINS	DRAWN BY: S. FORTIER
	DESIGNED BY: T. BIGELOW	CHECKED BY: E. ATKINS
	I-89 RAMP "D" CROSS SECTIONS SHEET 1	SHEET 92 OF 133

I-89 RAMP "D" STA. 51+00 TO I-89 RAMP "D" STA. 53+00