


MATERIAL ITEM	THICKNESS	TOLERANCE
PAVEMENT (TOTAL DEPTH ALL LAYERS)		+/- 1/4"
SUBBASE (TOTAL DEPTH ALL LAYERS)		+/- 1"
SAND BORROW (TOTAL DEPTH ALL LAYERS)		+/- 1"


TYPICAL SECTIONS

1/2" SUPERPAVE BITUMINOUS CONCRETE PAVEMENT (TYPE IVS)
 3/2" SUPERPAVE BITUMINOUS CONCRETE PAVEMENT (TYPE IIS)
 15" SUBBASE OF DENSE GRADED CRUSHED STONE
 20" SAND BORROW

TACK COAT: EMULSIFIED ASPHALT IS TO BE APPLIED AT THE RATE OF 0.025 GAL/SY BETWEEN SUCCESSIVE COURSES OF PAVEMENT AS DIRECTED BY THE ENGINEER.

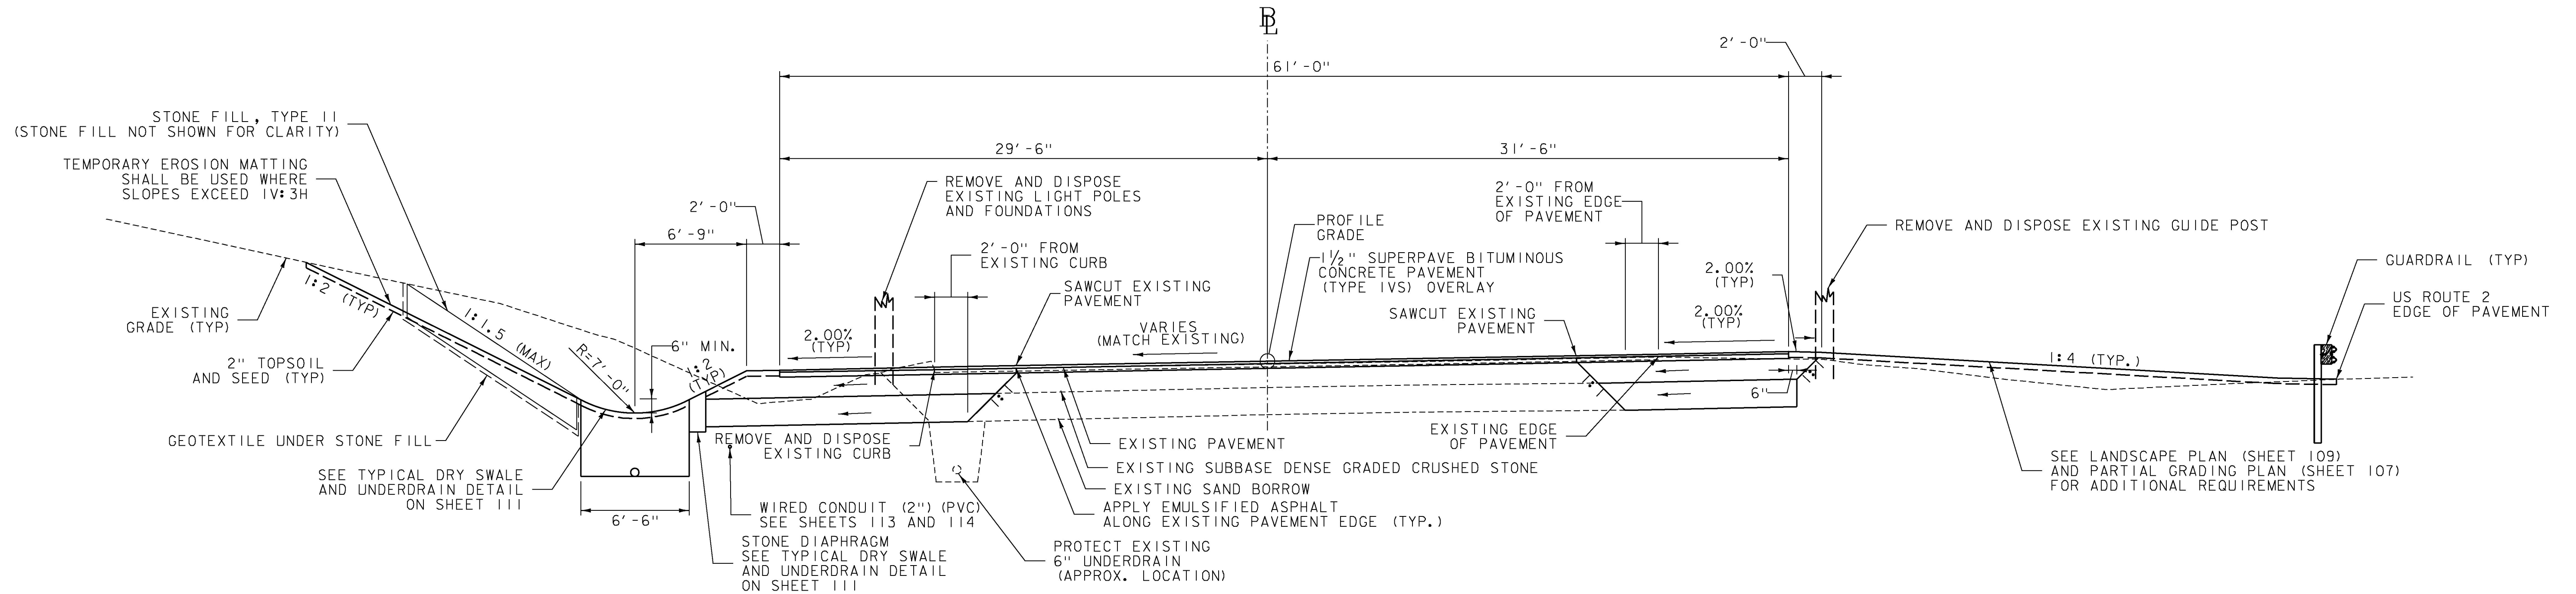

PARK AND RIDE SECTION
 STA. 71+24.52 - 71+62.82
 NOT TO SCALE

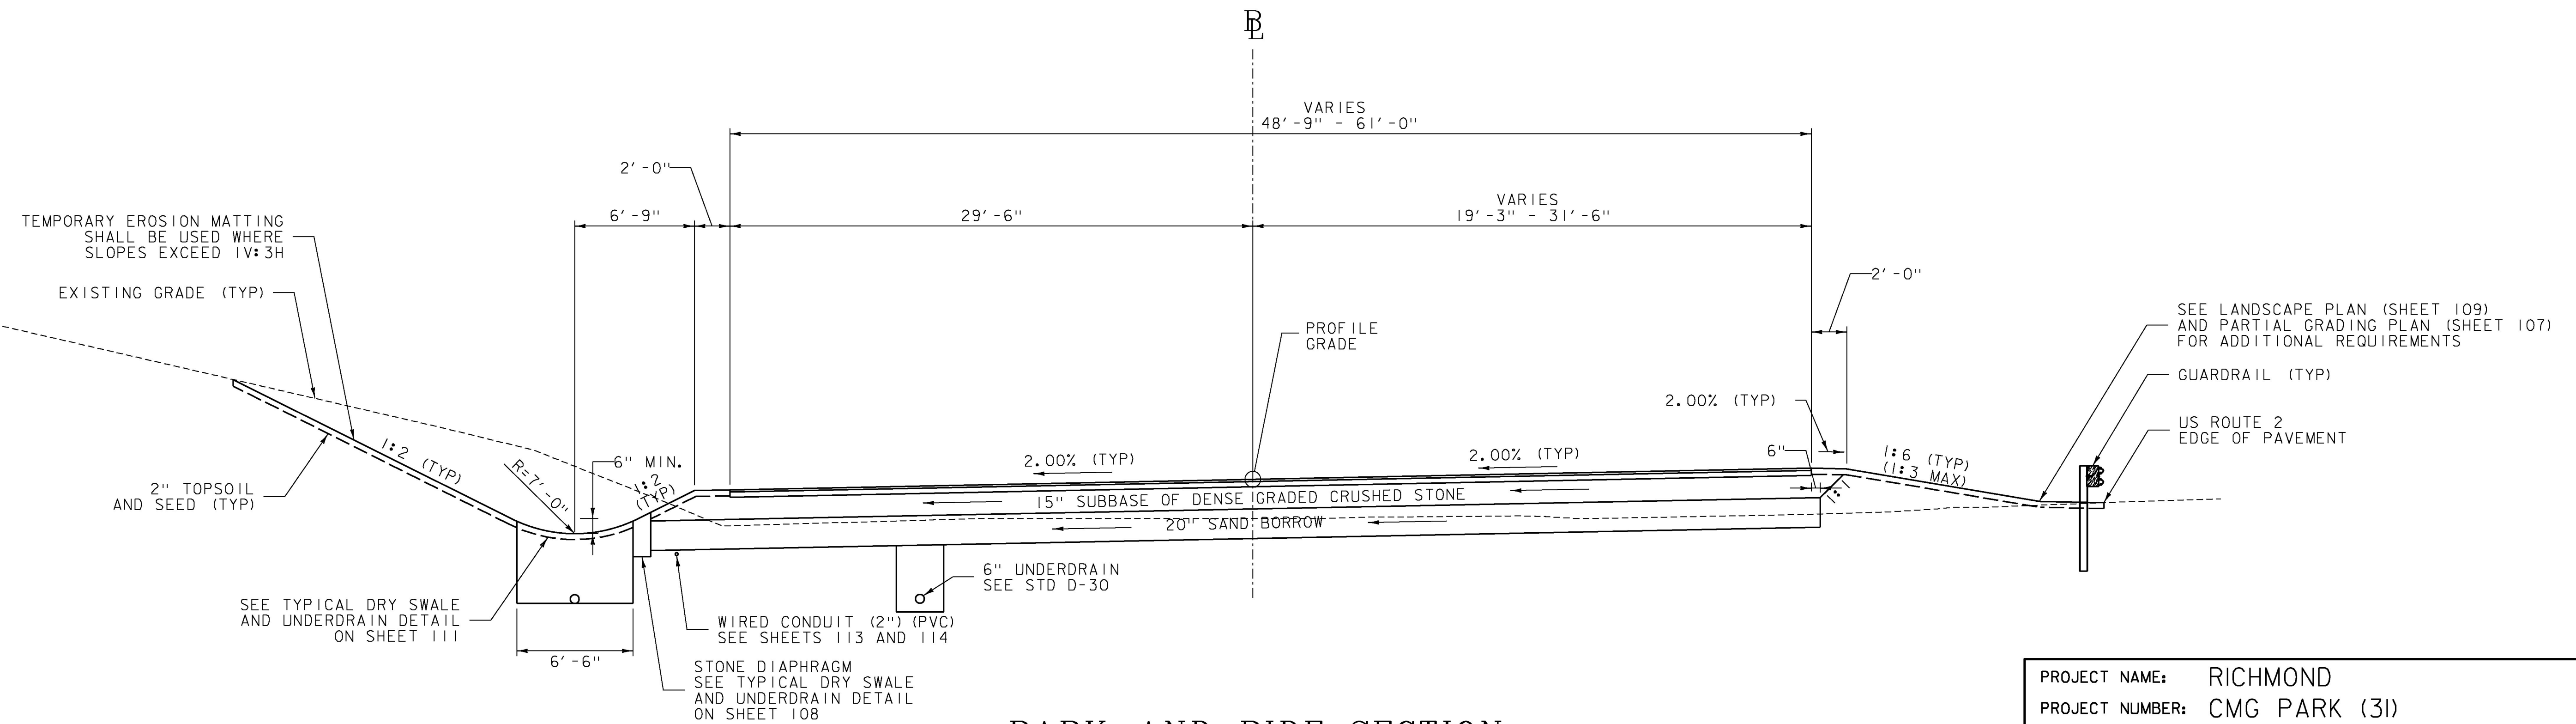

PARK AND RIDE SECTION
 STA. 70+50.00 - 71+24.52
 NOT TO SCALE

PROJECT NAME:	RICHMOND
PROJECT NUMBER:	CMG PARK (31)
FILE NAME:	z97c186+yp.dgn
PROJECT LEADER:	ERIK ATKINS
DESIGNED BY:	T. BIGELOW
PARK AND RIDE TYPICAL SECTIONS SHEET 1	
PLOT DATE:	5/14/2013
DRAWN BY:	S. FORTIER
CHECKED BY:	E. ATKINS
SHEET	95 OF 133