



TYPICAL SECTIONS

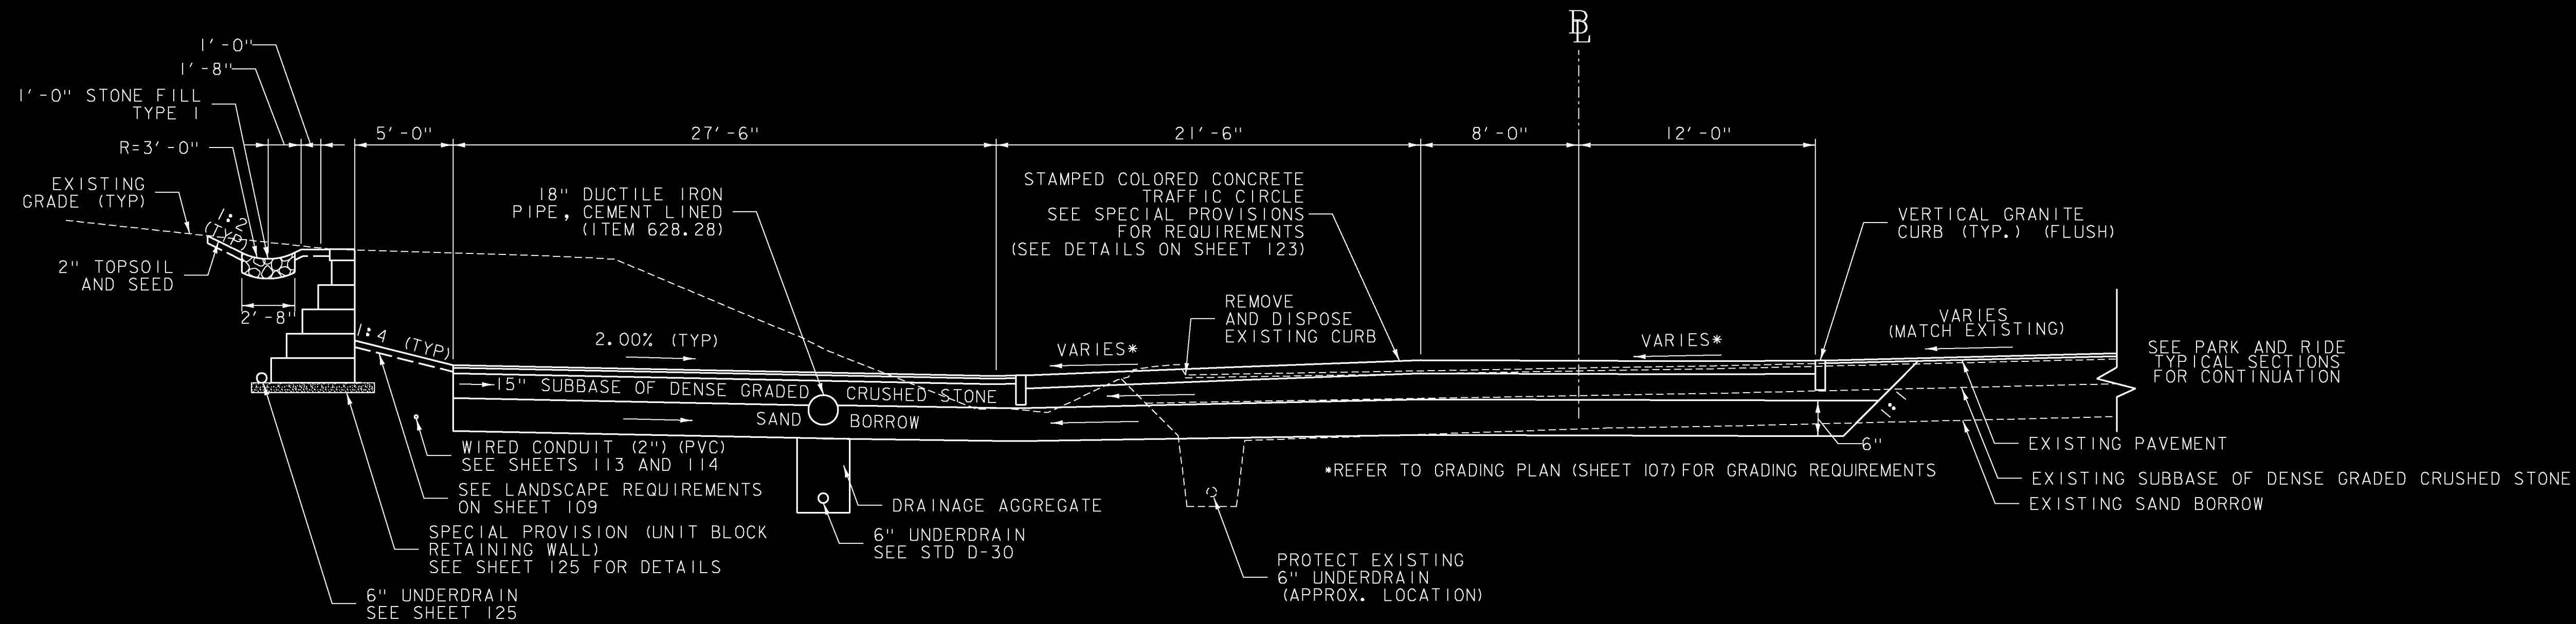

PARK AND RIDE TRAFFIC CIRCLE SECTION
NOT TO SCALE

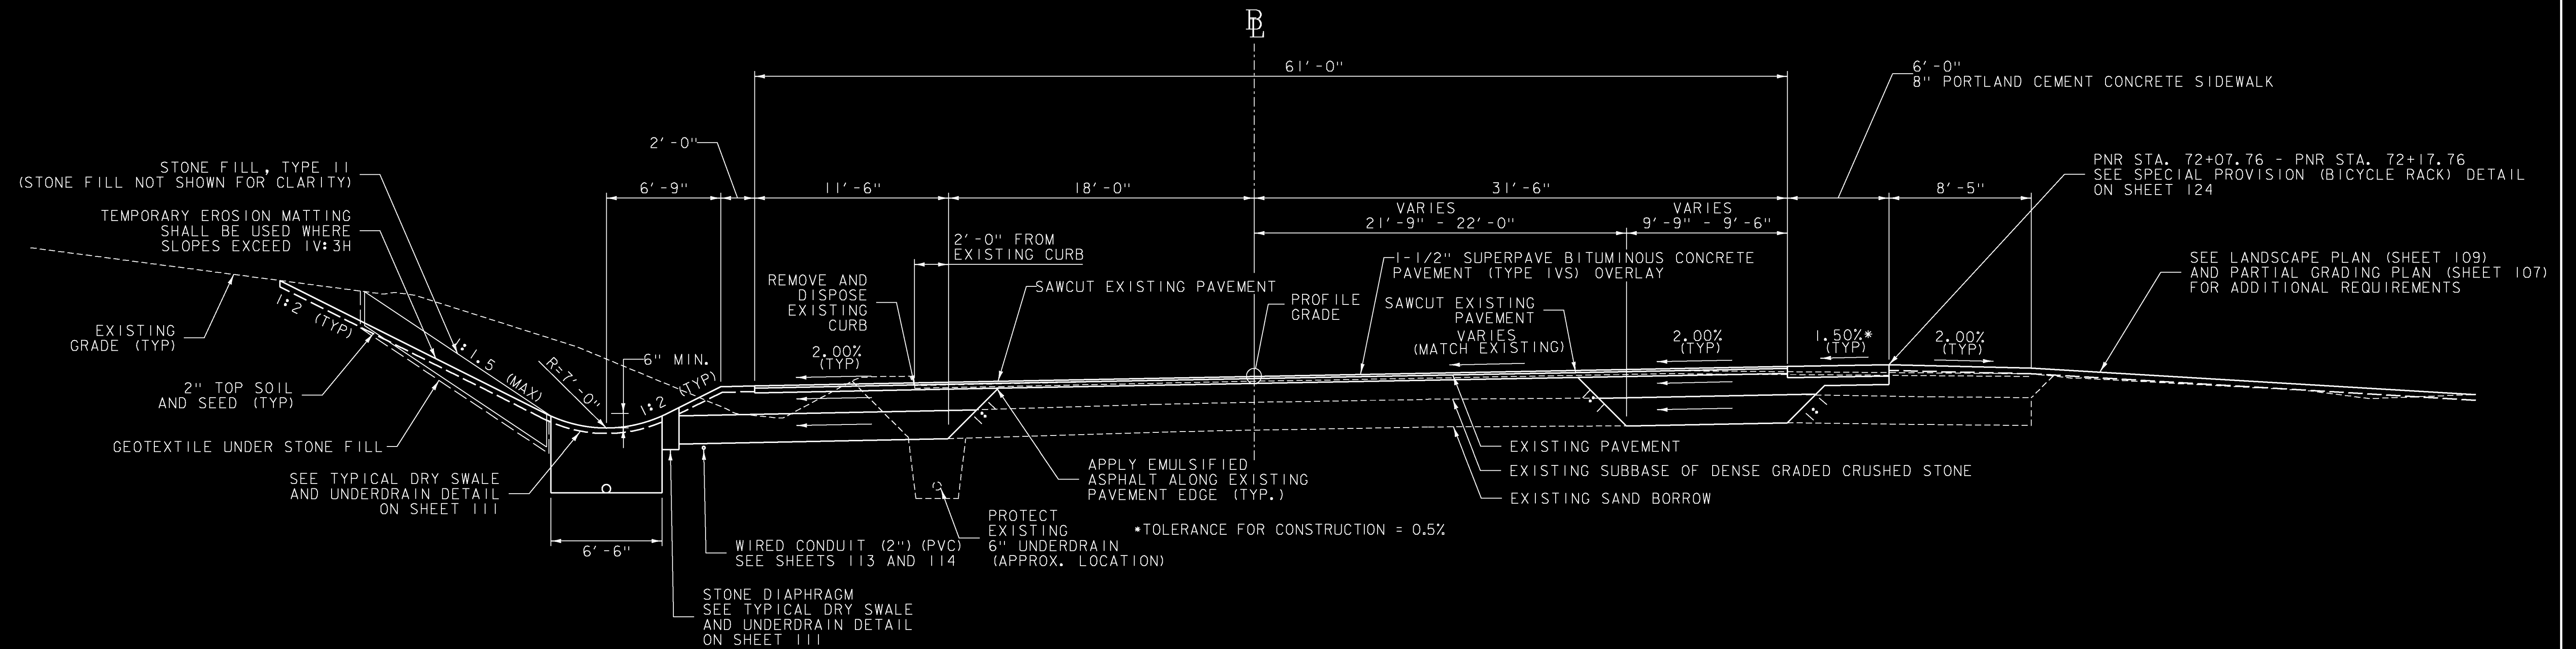

PARK AND RIDE SECTION
STA. 71+62.82 - 72+28.02
NOT TO SCALE

PROJECT NAME:	RICHMOND
PROJECT NUMBER:	CMG PARK (31)
FILE NAME:	z97c186+yp.dgn
PROJECT LEADER:	ERIK ATKINS
DESIGNED BY:	T. BIGELOW
PLOT DATE:	5/2/2013
DRAWN BY:	S. FORTIER
CHECKED BY:	E. ATKINS
PARK AND RIDE TYPICAL SECTIONS SHEET 2 SHEET 96 OF 133	