


CURVE TABLE		
LABEL	RADIUS (ft)	LENGTH (ft)
C14	10.00	10.07
C15	49.00	98.72
C16	10.00	10.07
C17	5.00	7.85
C18	6.00	9.37
C19	6.00	9.42
C20	2.00	4.43
C21	7.00	6.50
C22	40.00	59.07
C23	20.00	30.63
C24	7.00	11.27
C25	4.00	3.14
C26	2.00	5.52
C27	30.00	11.40
C28	3.00	9.42

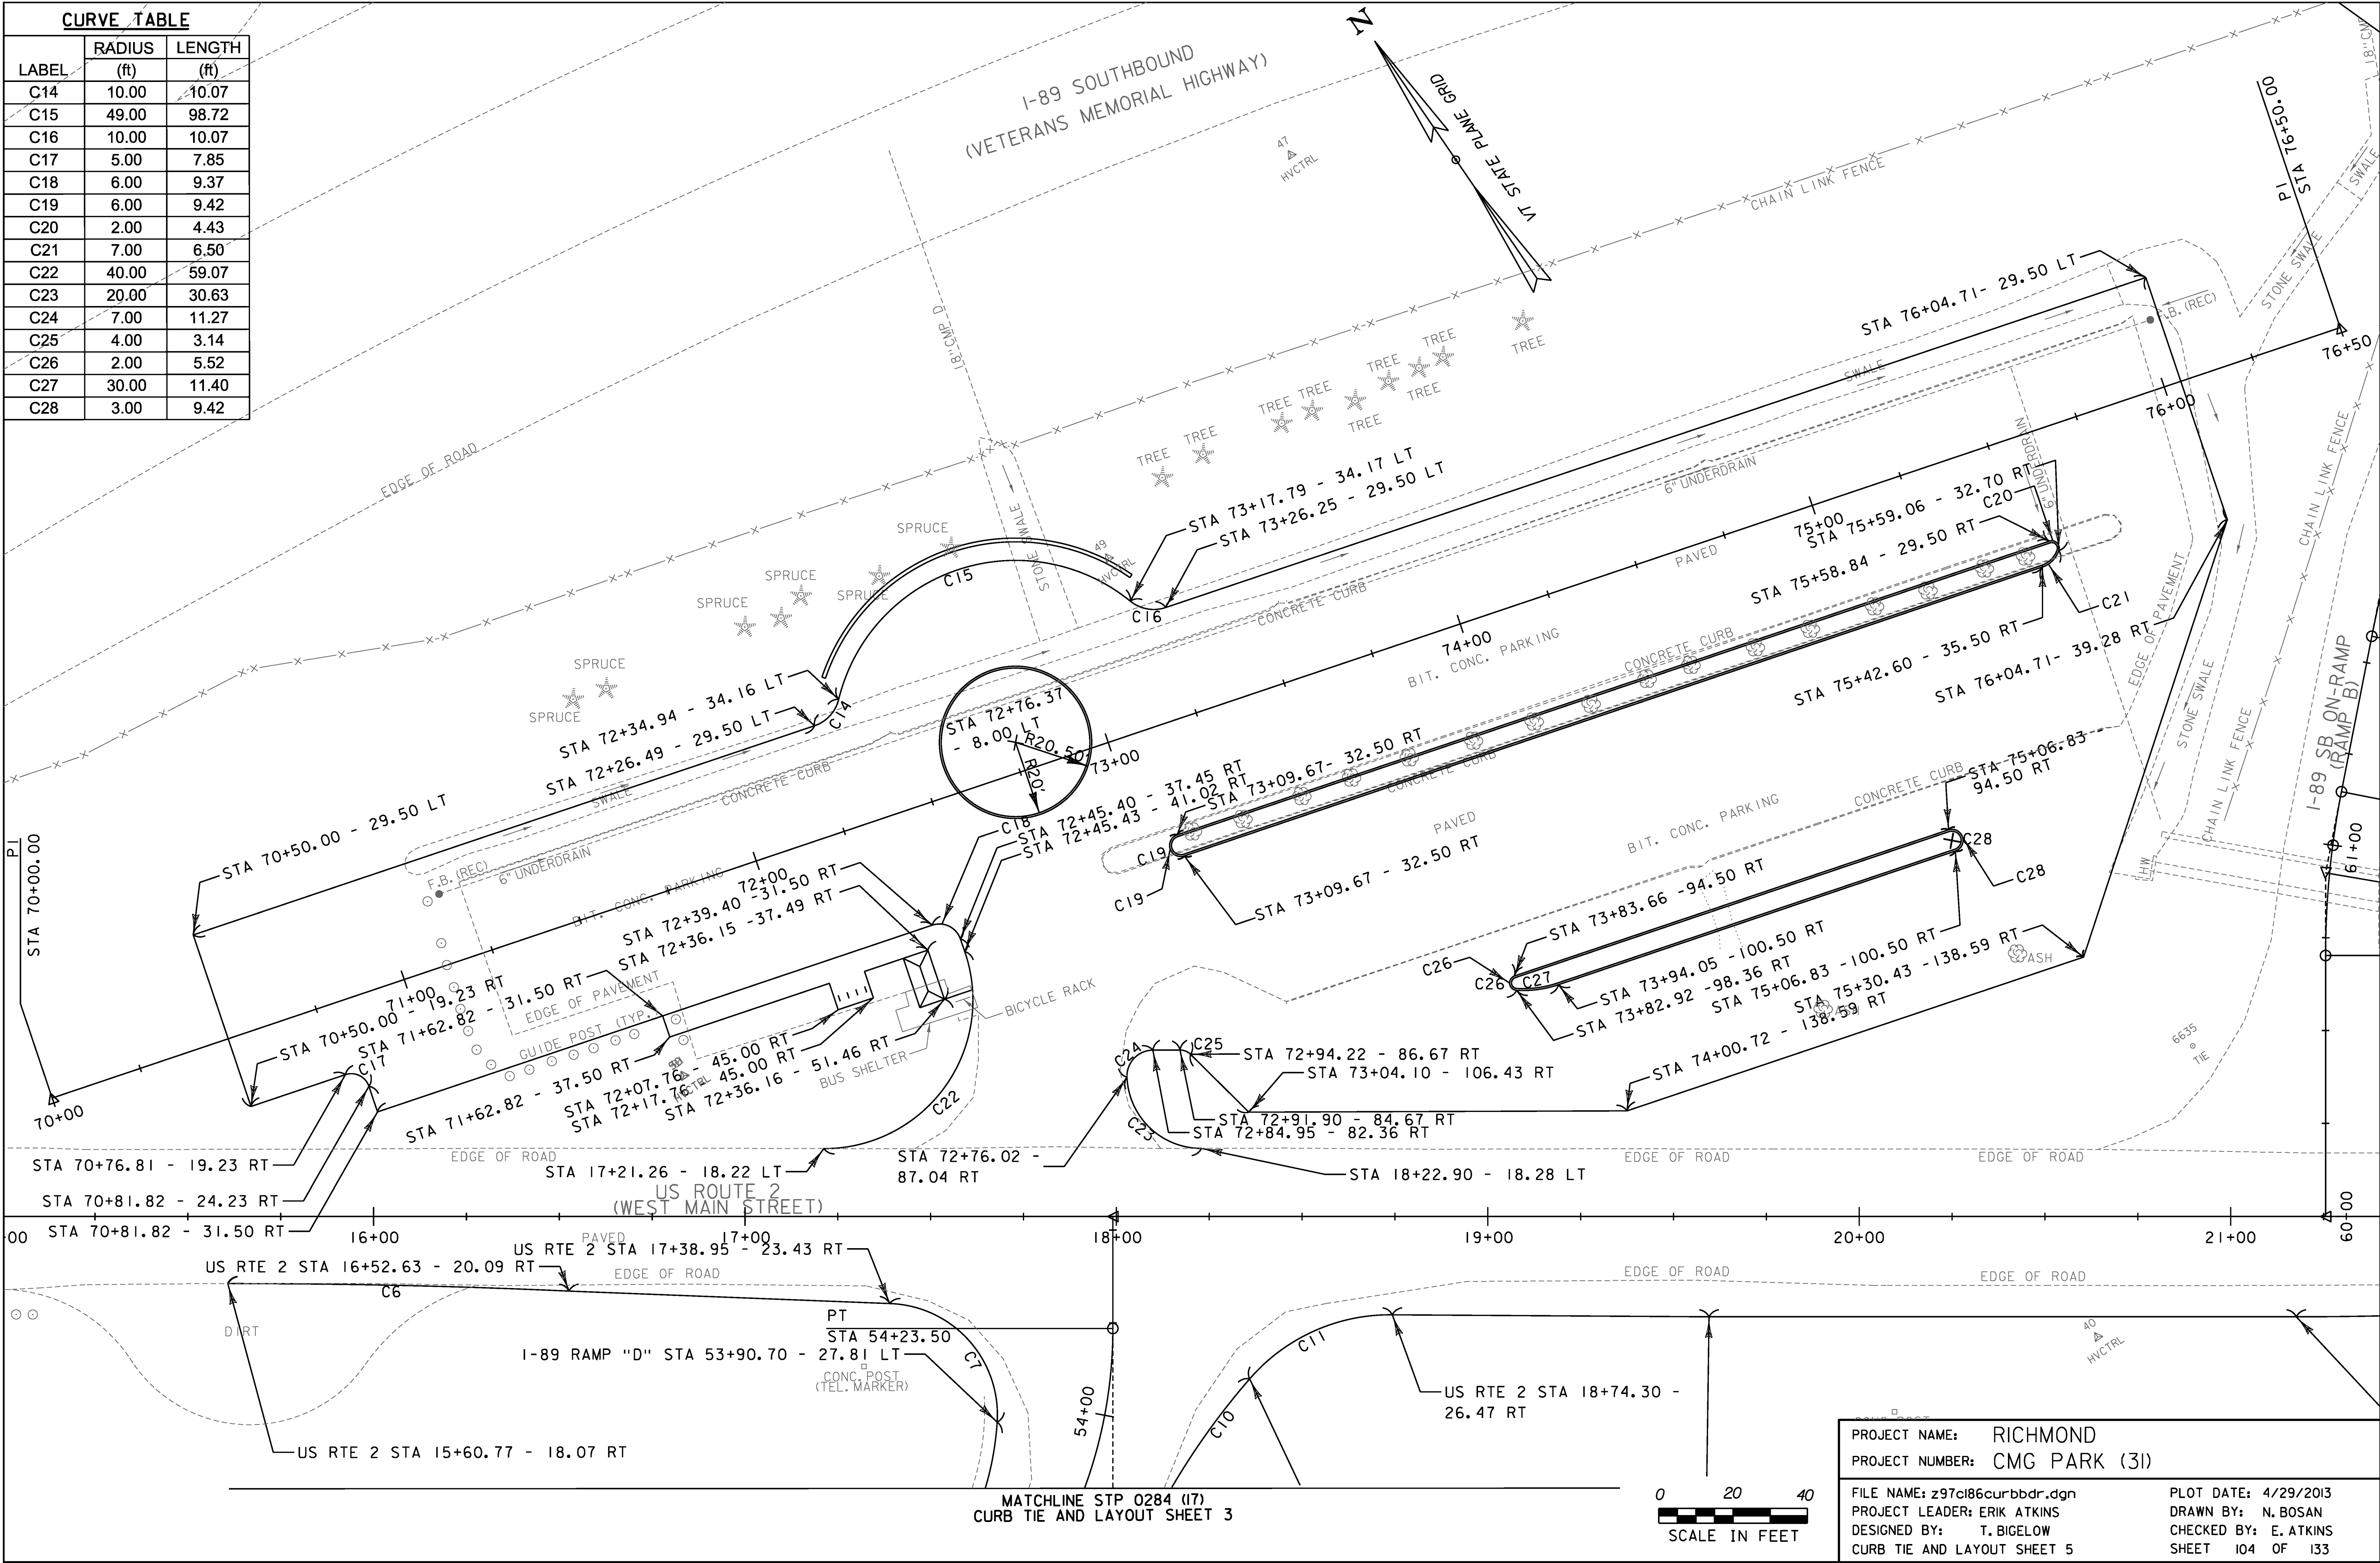

PROJECT NAME:	RICHMOND	
PROJECT NUMBER:	CMG PARK (3I)	
FILE NAME:	z97ci86curbbdr.dgn	PLOT DATE: 4/29/2013
PROJECT LEADER:	ERIK ATKINS	DRAWN BY: N. BOSAN
DESIGNED BY:	T. BIGELOW	CHECKED BY: E. ATKINS
CURB TIE AND LAYOUT SHEET 5		SHEET 104 OF 133