




70+50

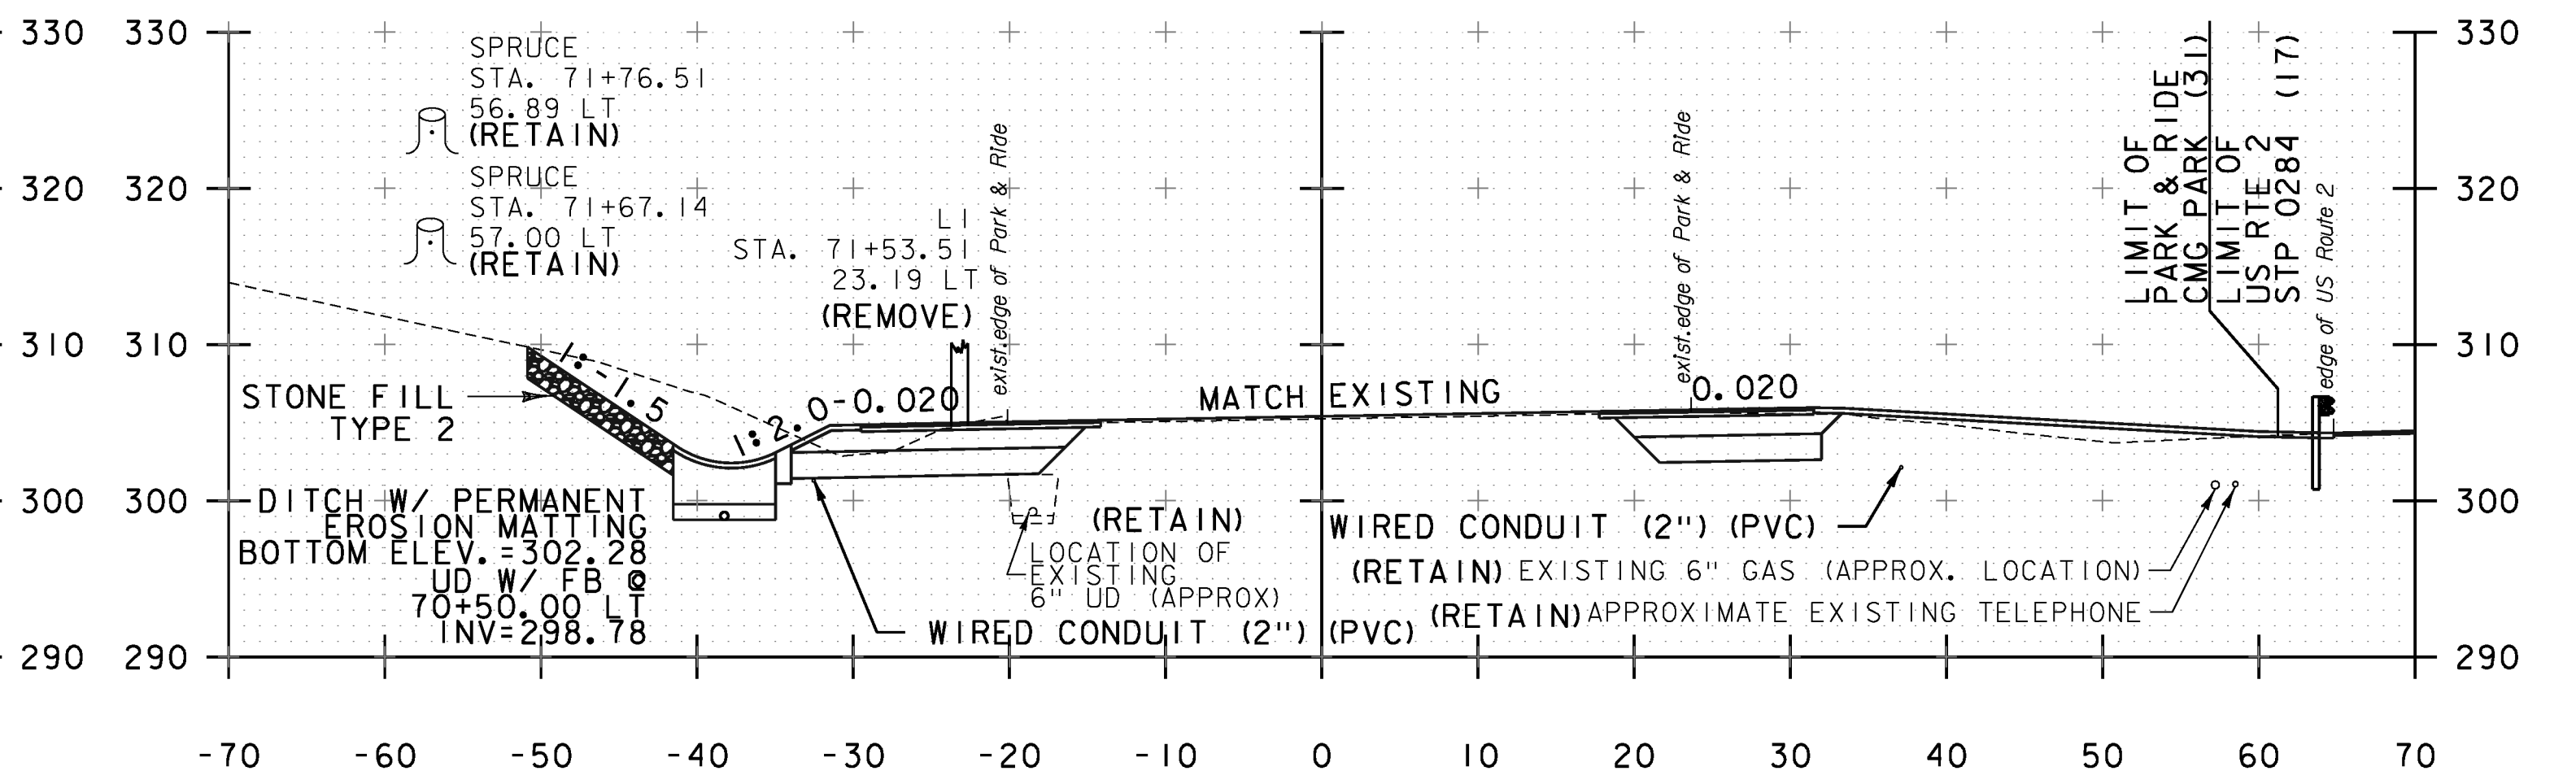

71+50

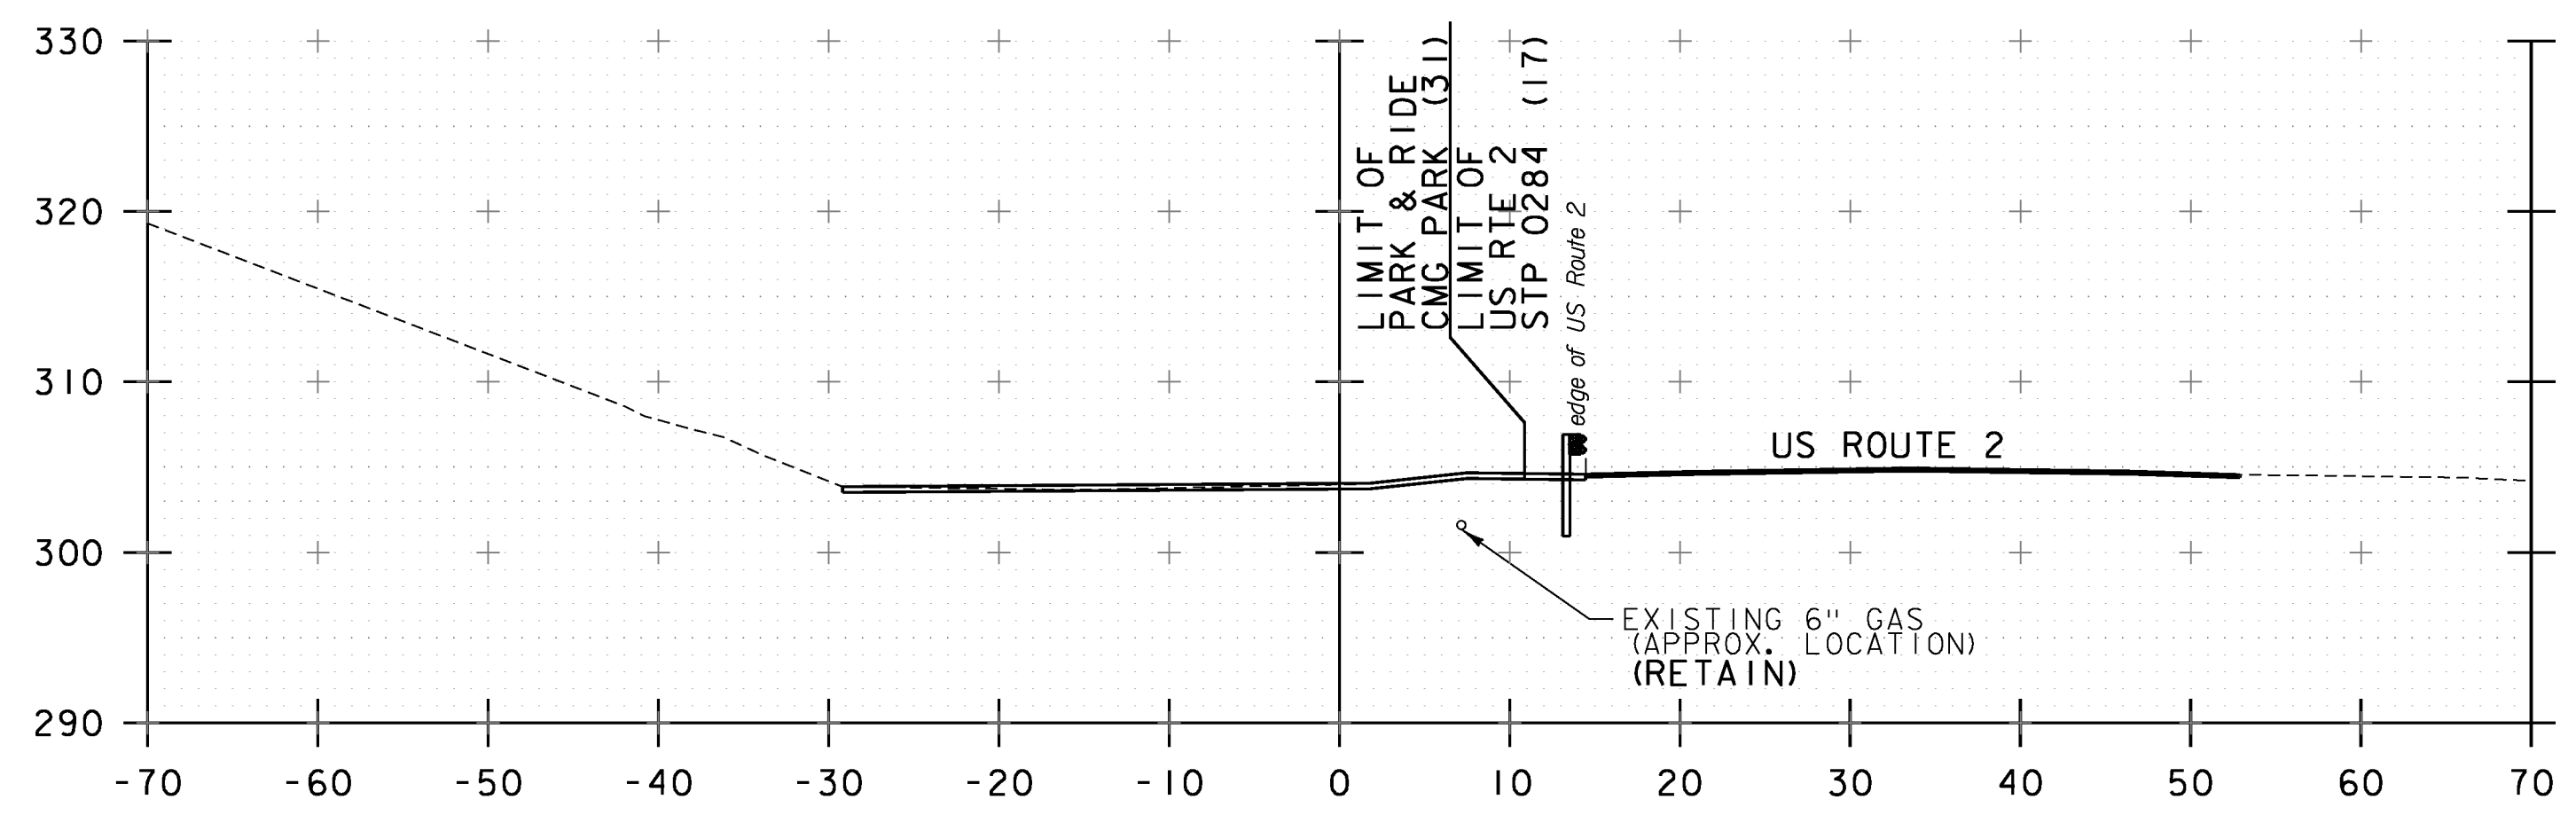

70+00

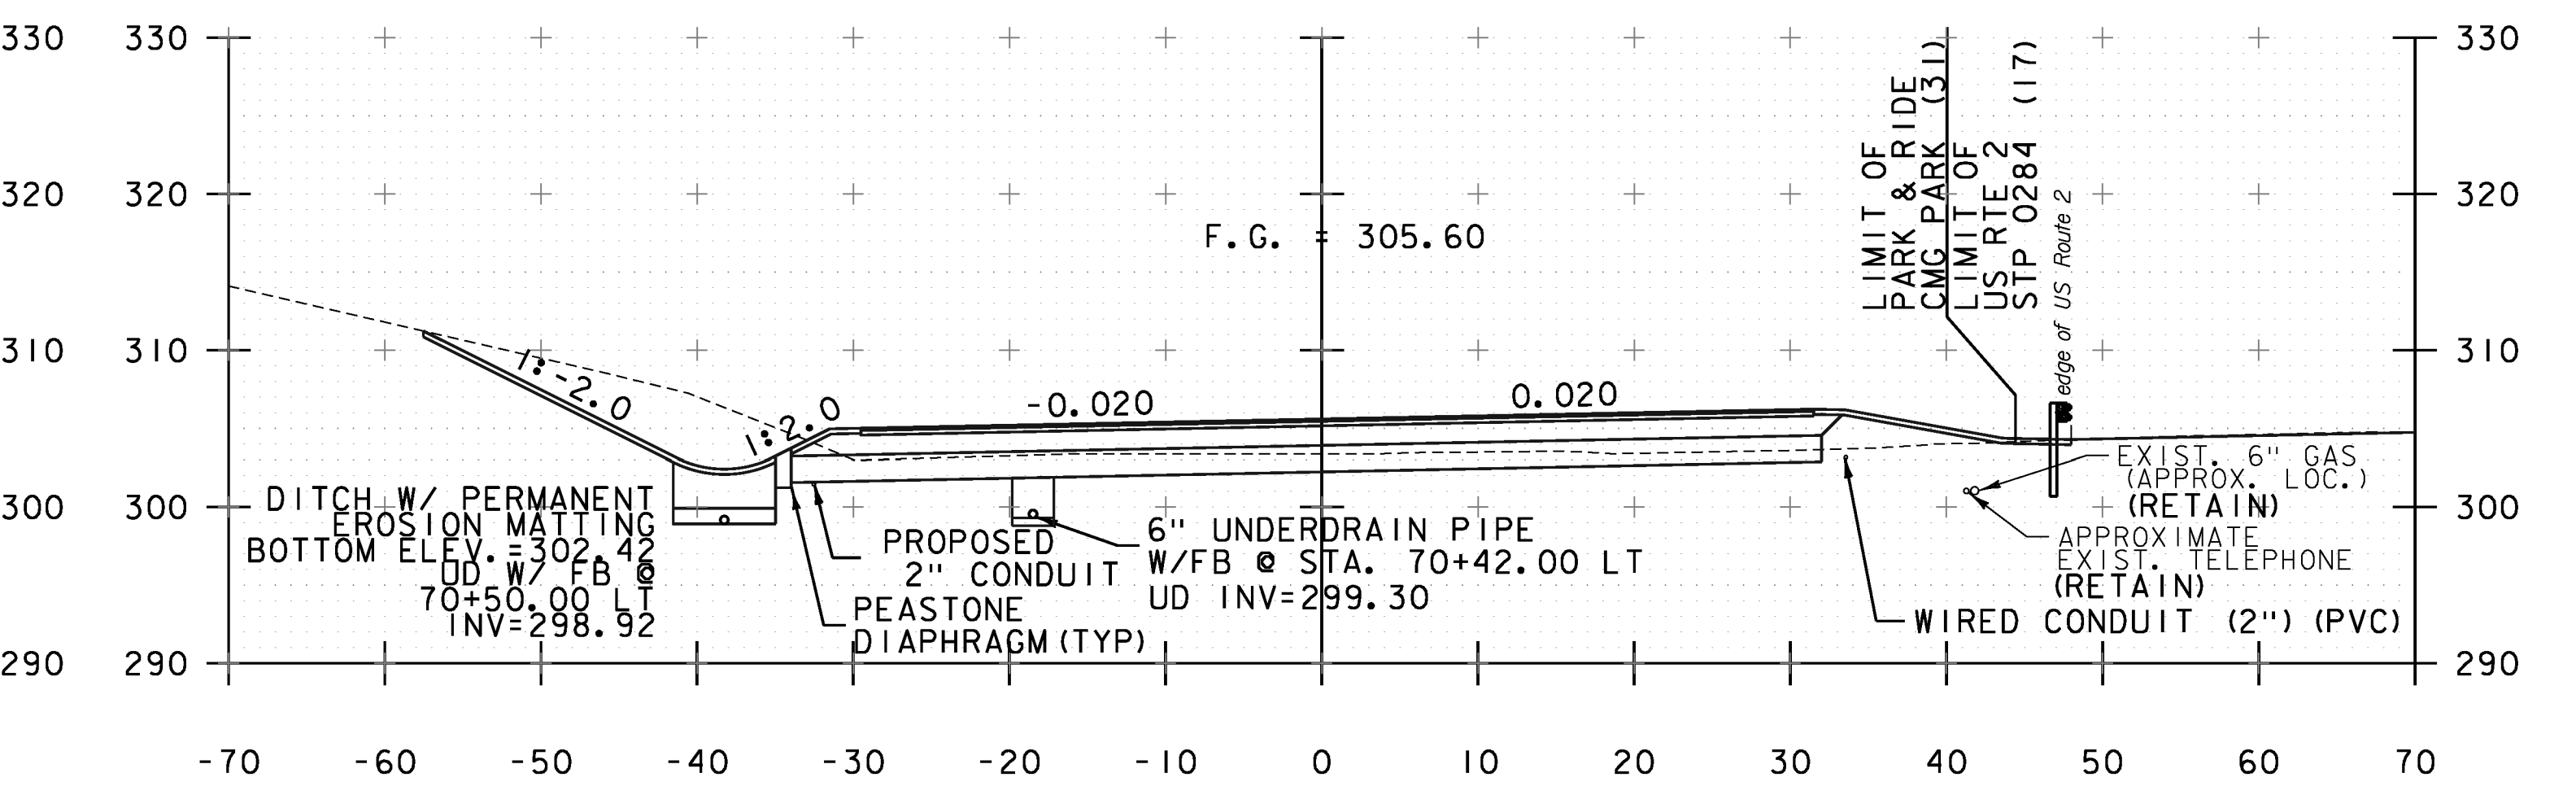

71+00

STA. 70+00 TO STA. 71+50

PROJECT NAME:	RICHMOND
PROJECT NUMBER:	CMG PARK (31)
FILE NAME:	z97ci86xsl.dgn
PROJECT LEADER:	ERIK ATKINS
DESIGNED BY:	T. BIGELOW
PLOT DATE:	4/29/2013
DRAWN BY:	S. FORTIER
CHECKED BY:	E. ATKINS
PARK & RIDE CROSS SECTIONS SHEET 1	
SHEET 129 OF 133	