



74+50

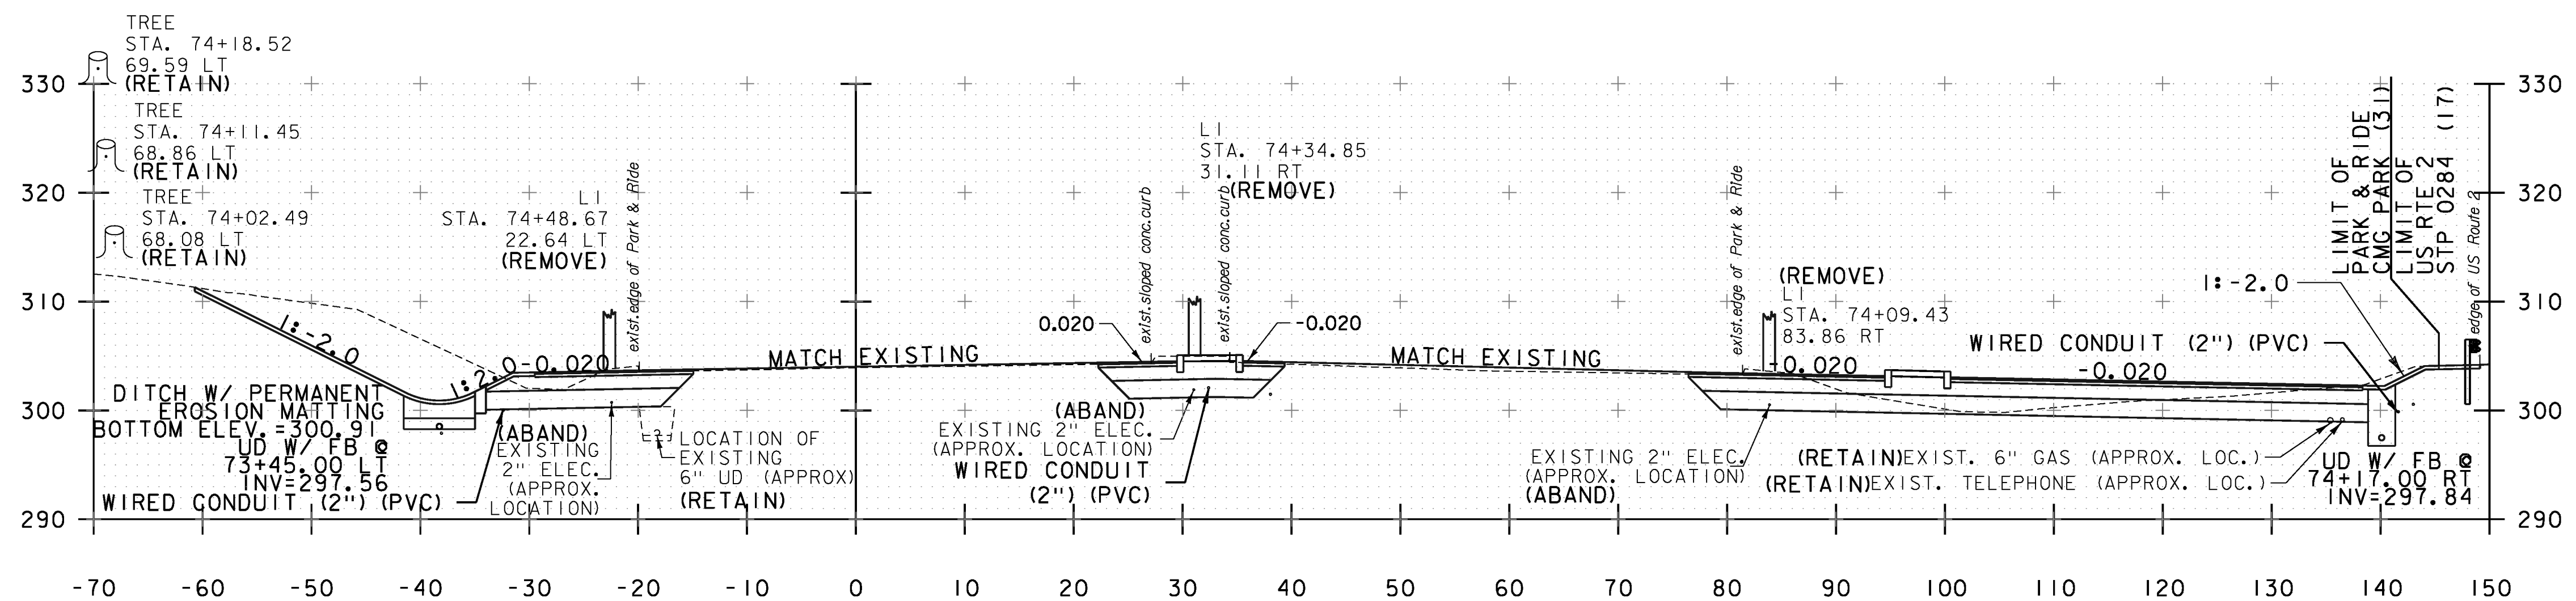

74+00

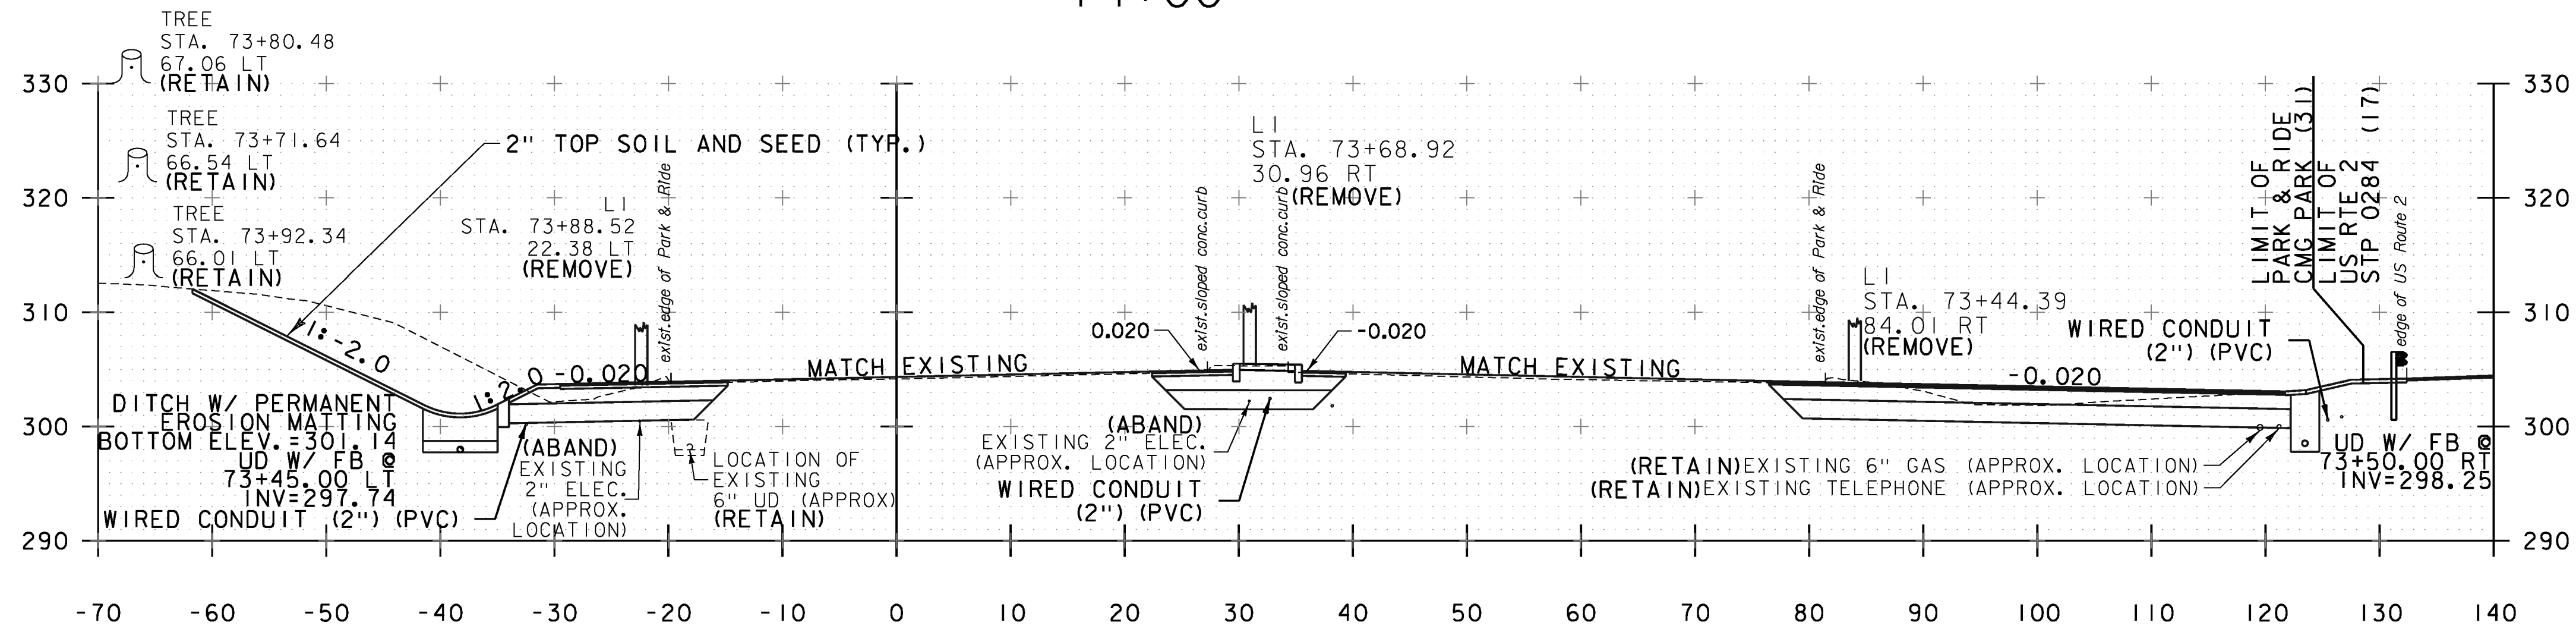

73+50

STA. 73+50 TO STA. 74+50

PROJECT NAME:	RICHMOND
PROJECT NUMBER:	CMG PARK (31)
FILE NAME:	z97ci86xsl.dgn
PROJECT LEADER:	ERIK ATKINS
DESIGNED BY:	T. BIGELOW
PARK & RIDE CROSS SECTIONS SHEET 4	
PLOT DATE:	4/29/2013
DRAWN BY:	S. FORTIER
CHECKED BY:	E. ATKINS
SHEET	132 OF 133