



76+00

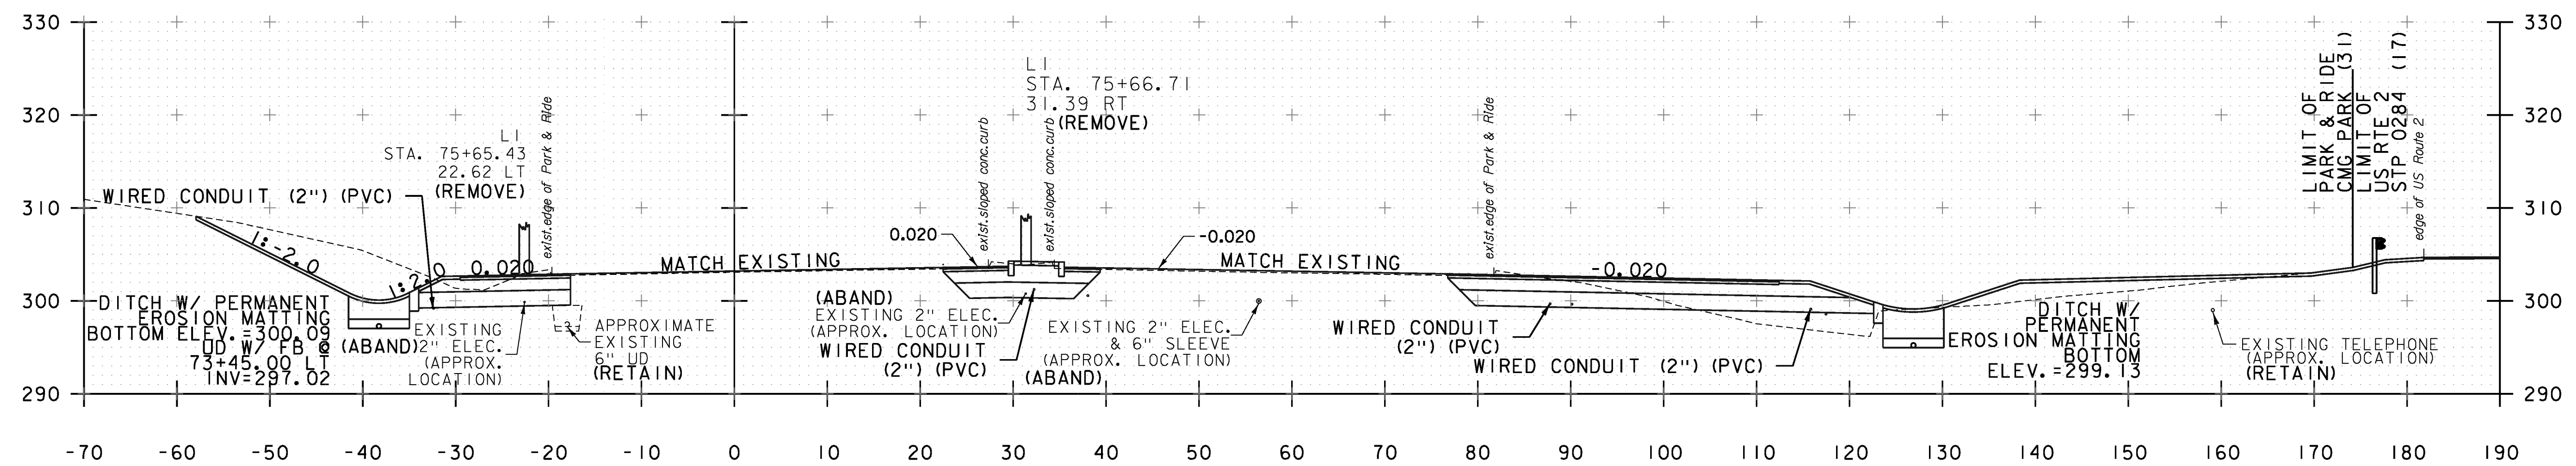

75+50

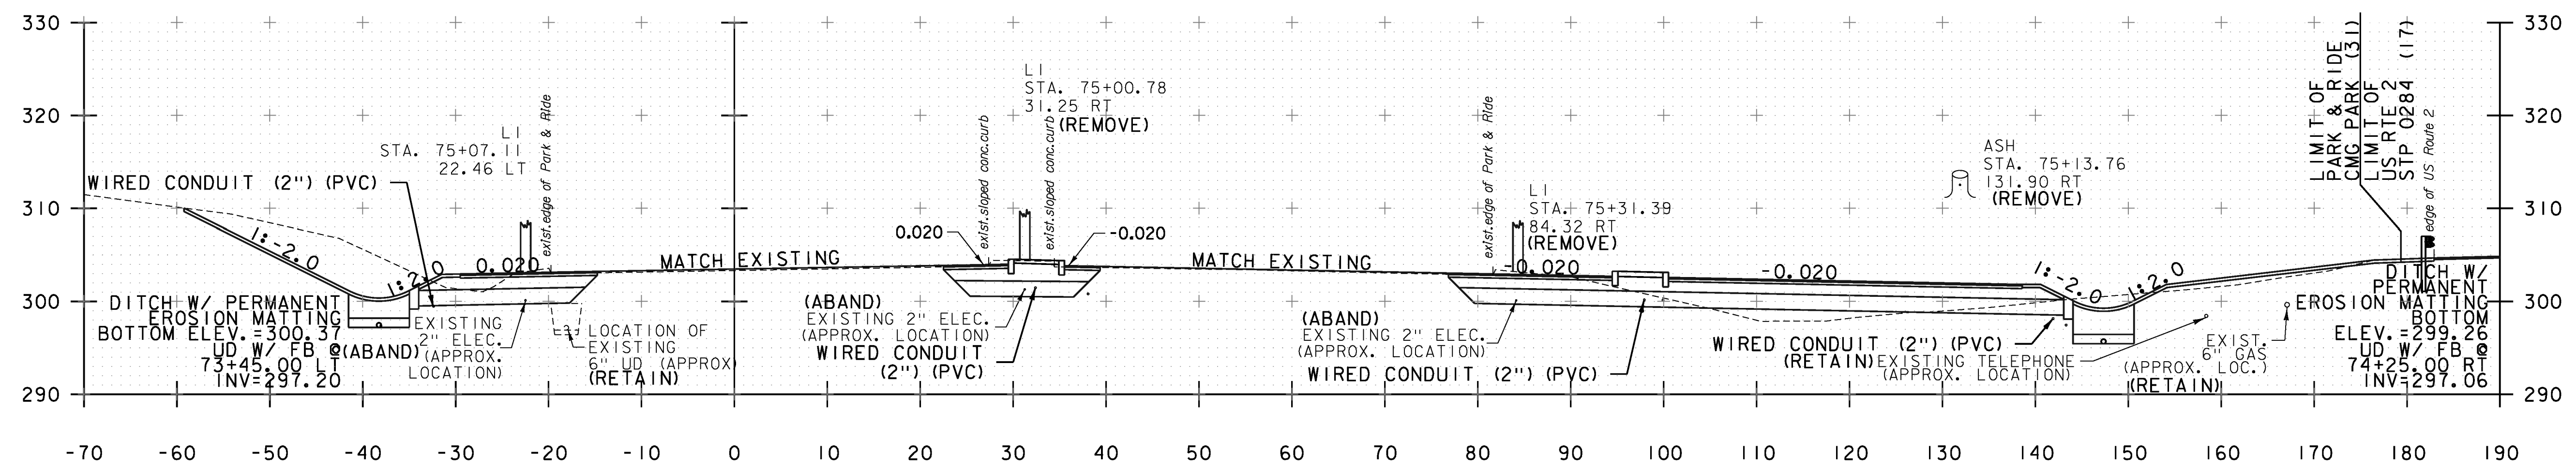

75+00

STA. 75+00 TO STA. 76+00

| | |
|------------------------------------|----------------|
| PROJECT NAME: | RICHMOND |
| PROJECT NUMBER: | CMG PARK (31) |
| FILE NAME: | z97ci86xsl.dgn |
| PROJECT LEADER: | ERIK ATKINS |
| DESIGNED BY: | T. BIGELOW |
| PARK & RIDE CROSS SECTIONS SHEET 5 | |
| PLOT DATE: | 4/29/2013 |
| DRAWN BY: | S. FORTIER |
| CHECKED BY: | E. ATKINS |
| SHEET | 133 OF 133 |