


**APPROVED**  
By Derek Lyman at 2:53 pm, Mar 05, 2014

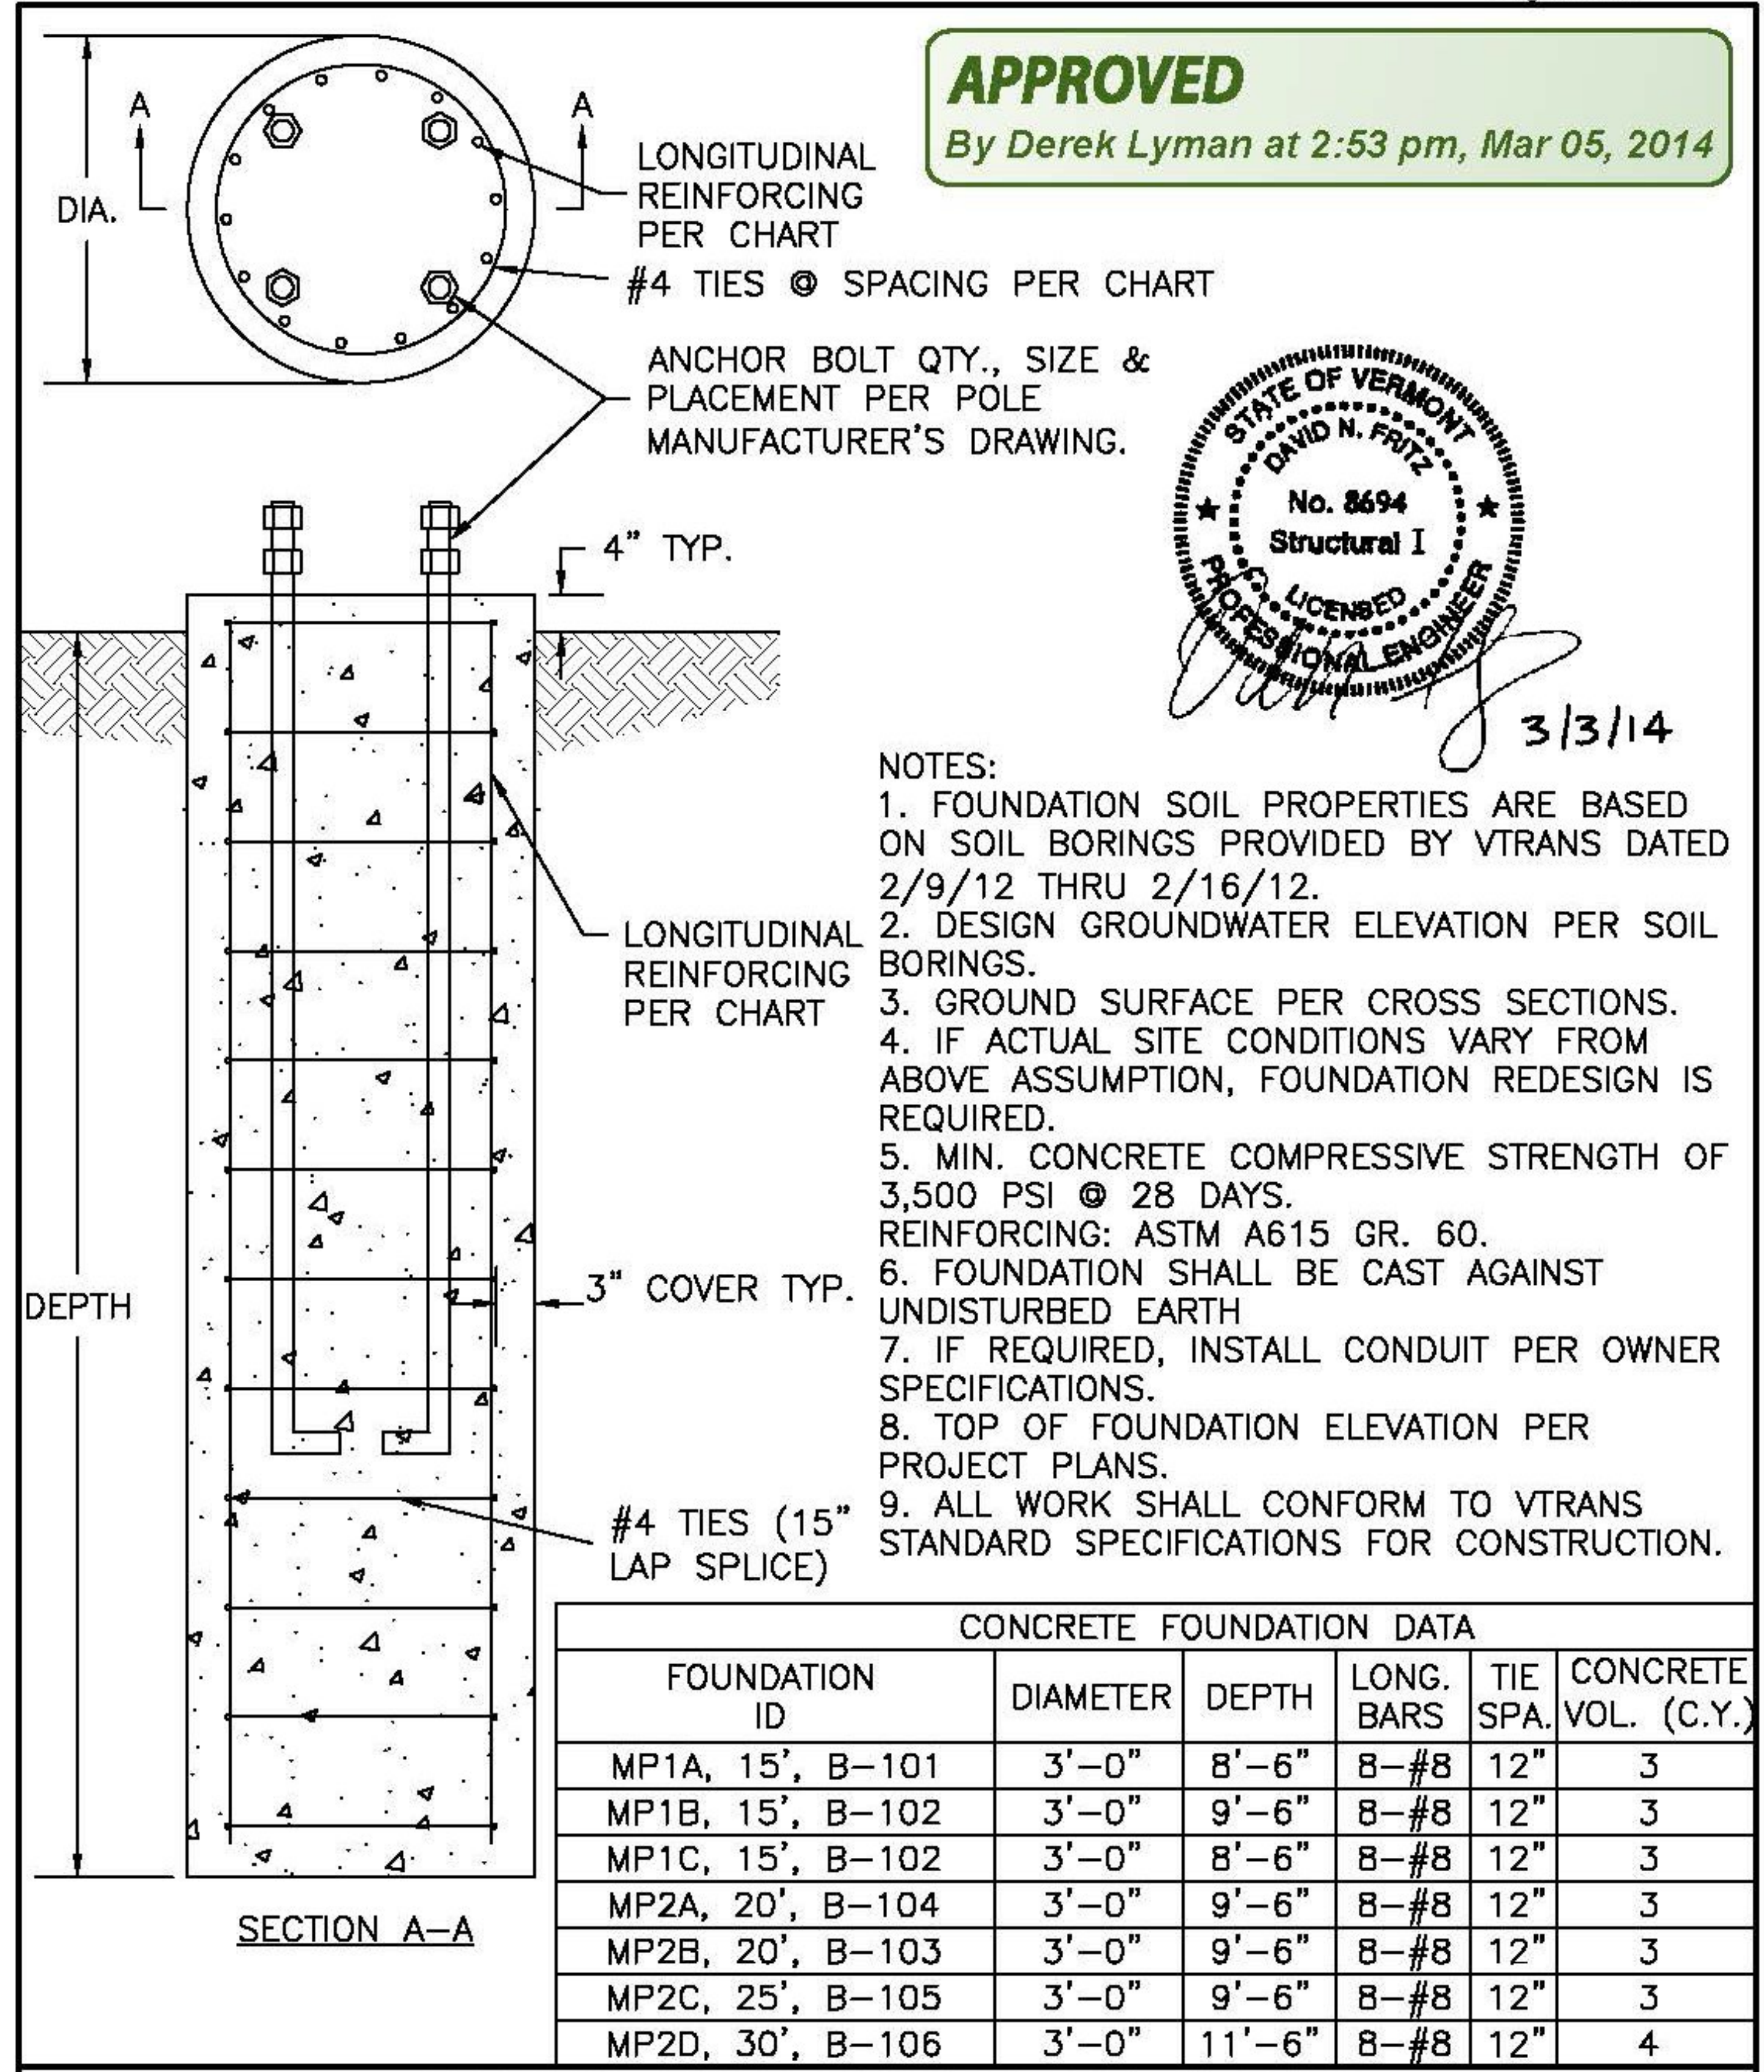

**TRAFFIC POLE FOUNDATION DESIGN**  
**RICHMOND, VERMONT**  
**STP 0284 (17)**  
**DRAWING NO. 51660-R1**