


(EXAMPLE SHOWN FOR SINGLE & TWIN MASTARMS)

NOTE:

1. MATERIAL- .032 TK 1100-H14 ALUMINUM
2. STAMP THE IDENTIFICATION NUMBERS AS SHOWN ON THE SINGLE POST DRAWING

EX: 3GAx13x10x210 = VERTICAL POLE;  
GRADE 55 THICKNESS, BOTTOM OD,  
TOP OD, LENGTH &  
GRADE OF STEEL

5/16x10x3.7x450 = SIGNAL MASTARM &  
3/16x10x5.1x350 = TWIN SIGNAL MASTARM;  
GRADE 55 THICKNESS, BOTTOM OD,  
TOP OD, LENGTH &  
GRADE OF STEEL

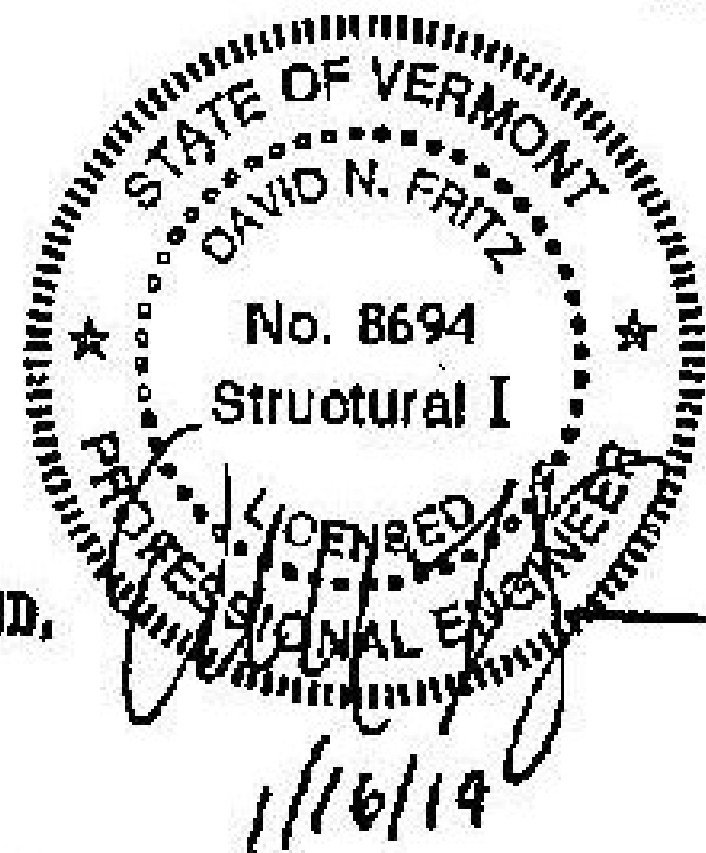

-2	2 3/4	1 3/8	5 ROWS STAMPING TWIN MASTARM
-1	2 1/4	1 1/8	4 ROWS STAMPING SINGLE MASTARM
DASH NO	'A'	'B'	DESCRIPTION

PO#3250-2139 / VT DOT: STP.0284(17) RICHMOND / US ROUTE 2,  
VT ROUTE 117 US ROUTE 2, OFF-RAMP (RAMP D)

MILLERBERND SALES ORDER #51660

**APPROVED**  
By Derek Lyman at 8:57 am, Feb 11, 2014

DWN: PAUL F.	IDENTIFICATION TAG (VERMONT)	
DATE: 3-15-06	GRADE OF STEEL & SHAFT SIZE FOR POST & MASTARM	
CHK: WILL Q.	<b>Millerbernd</b> MANUFACTURING CO. WINSTON, NH	500A1098
SCALE: NTS		