

SEED
 US RTE 2 10+00 RT - 10+48 RT
 US RTE 2 13+83 RT - 15+00 RT
 US RTE 2 14+09 LT - 15+00 RT


HAY MULCH
 US RTE 2 10+00 RT - 10+48 RT
 US RTE 2 13+83 RT - 15+00 RT
 US RTE 2 14+09 LT - 15+00 RT

BARRIER FENCE
 I-89 RAMP "C" 40+86 RT - 41+50 RT

SEED, WINTER RYE
 US RTE 2 10+00 RT - 10+48 RT
 US RTE 2 13+83 RT - 15+00 RT
 US RTE 2 14+09 LT - 15+00 RT

TOP SOIL
 US RTE 2 10+00 RT - 10+48 RT
 US RTE 2 13+83 RT - 15+00 RT
 US RTE 2 14+09 LT - 15+00 RT

PROJECT DEMARICATION FENCE
 US RTE 2 10+00 RT - 10+15 RT
 I-89 RAMP "C" 40+86 RT - US RTE 2 10+15 LT

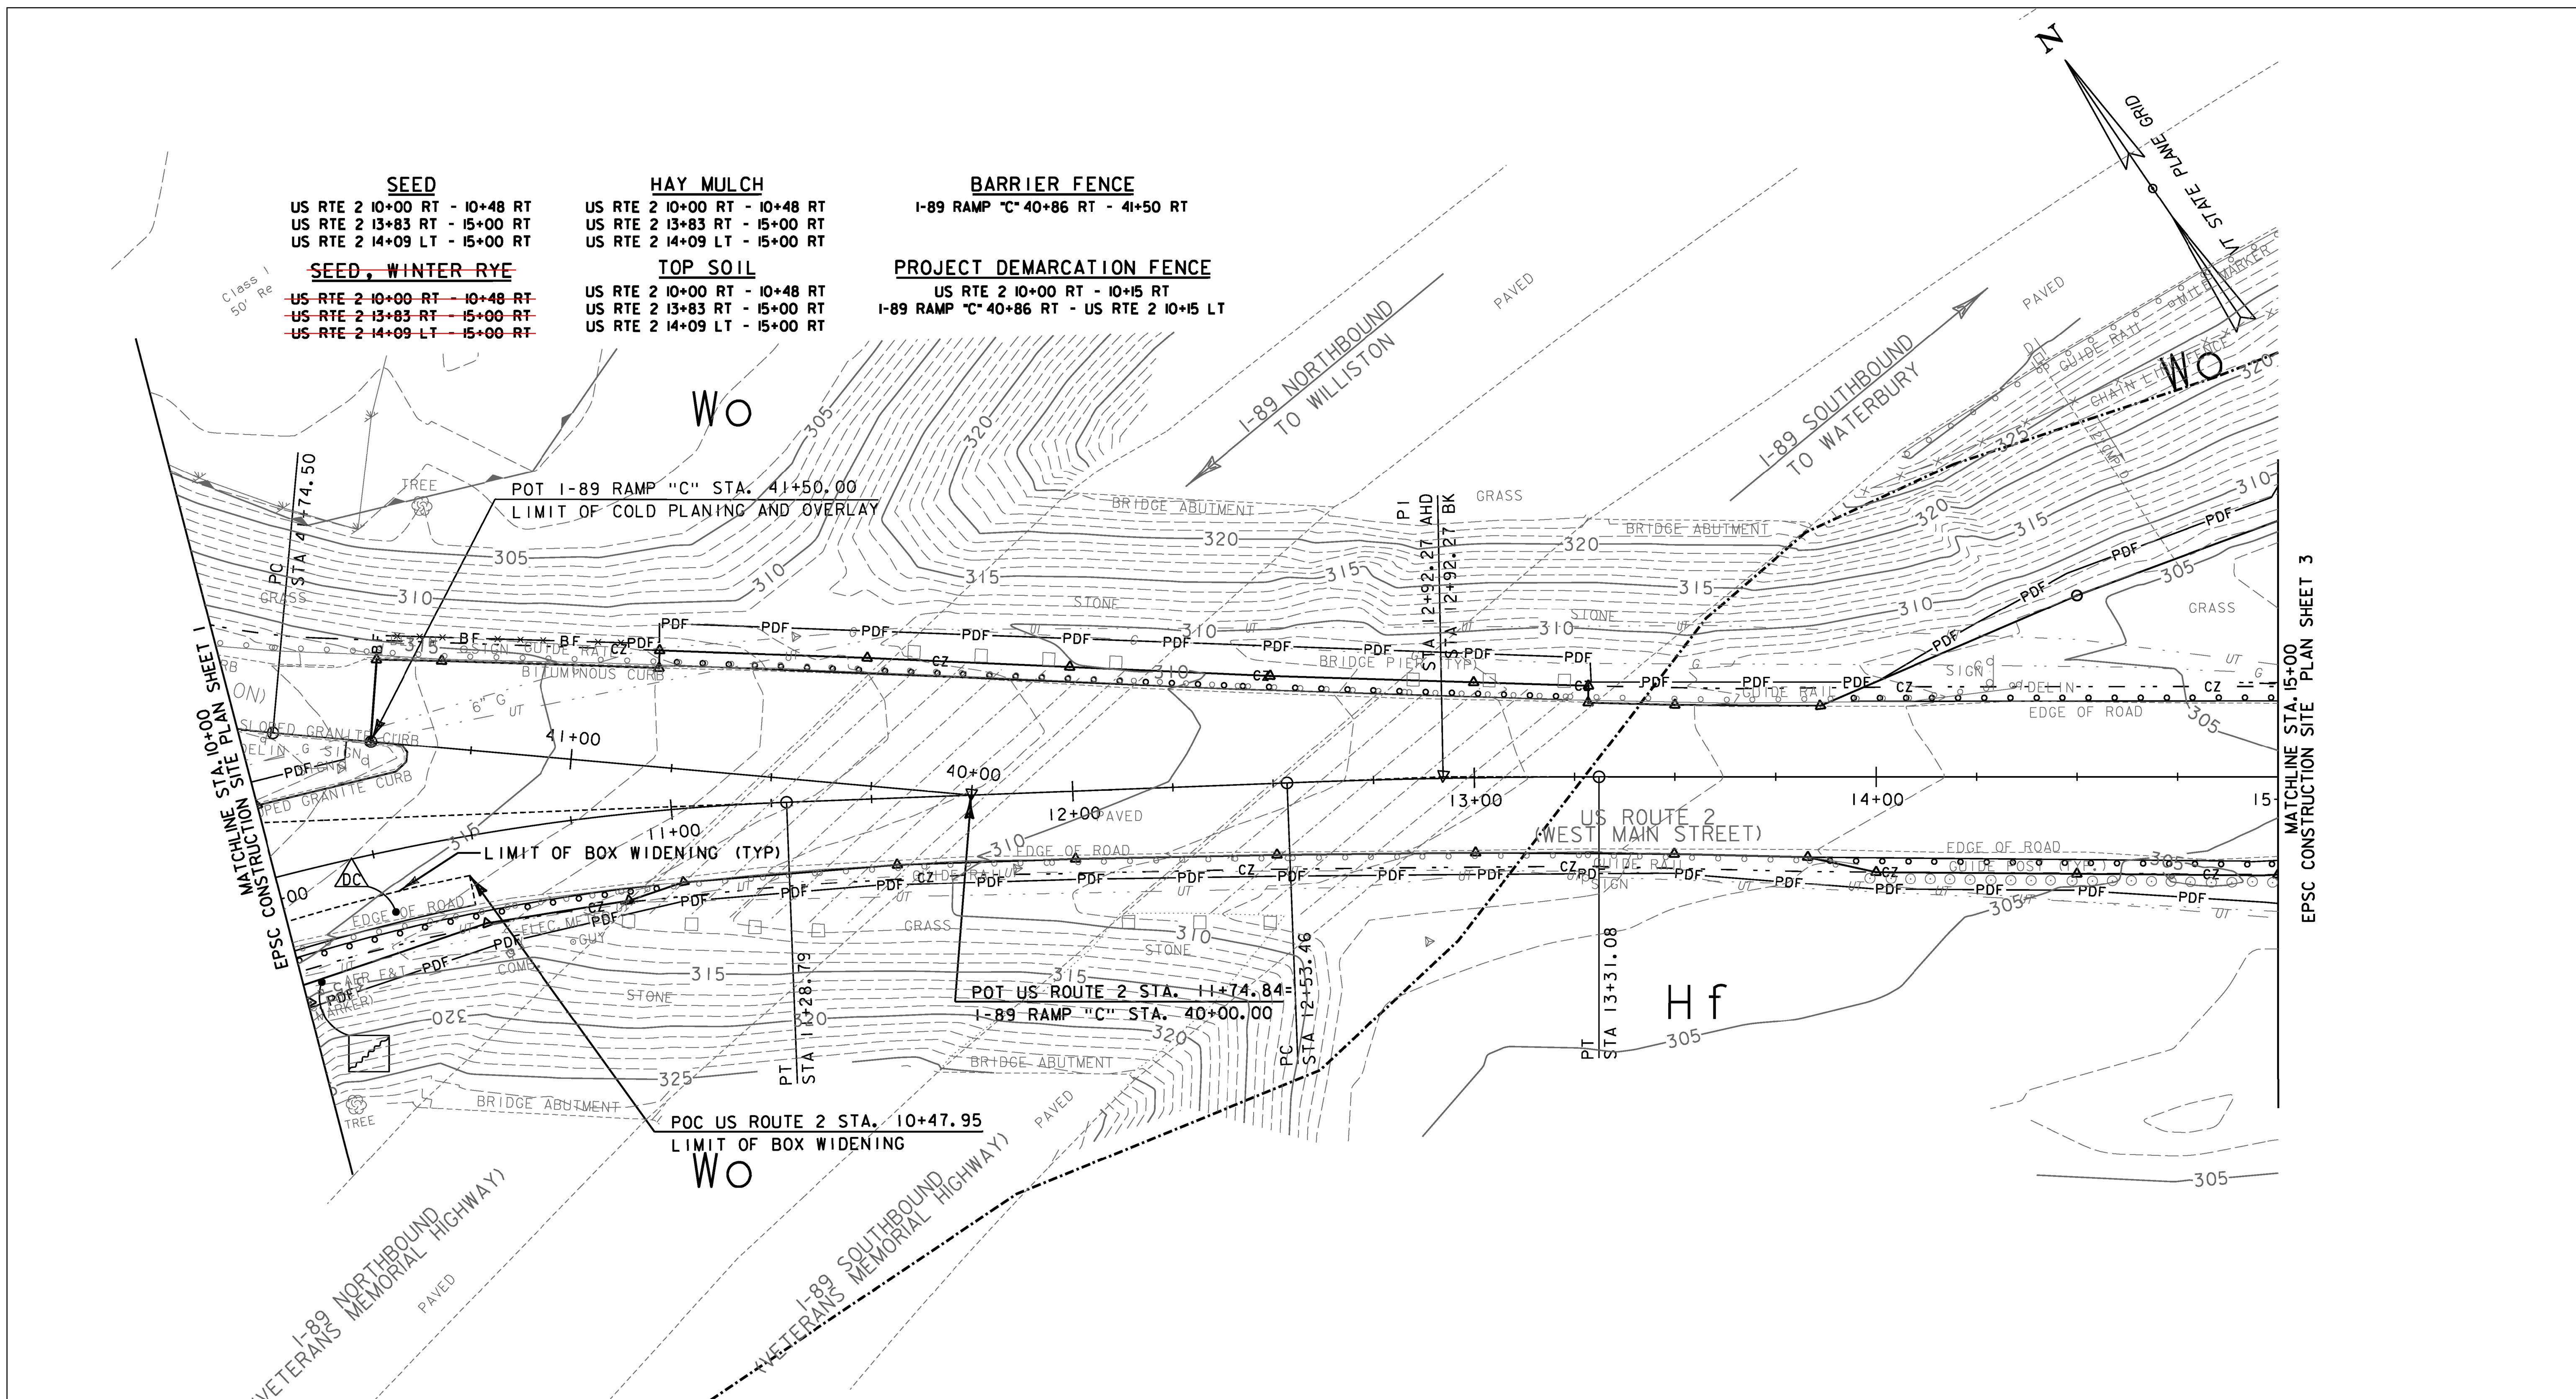

LEGEND

---	SOIL TYPE BOUNDARY		SURFACE ROUGHENING		PIPE INLET PROTECTION
—300—	5' INTERVAL PROPOSED CONTOUR		SILT FENCE		FILTER FABRIC DROP INLET PROTECTION
- - -300 - - -	1' INTERVAL PROPOSED CONTOUR		SILT FENCE WOVEN WIRE		ROLLED EROSION CONTROL PRODUCT, DITCH/SIDESLOPE
---	5' INTERVAL EXISTING CONTOUR		STABILIZED CONSTRUCTION ENTRANCE (SEE TRAFFIC MANAGEMENT PLANS)		-BF- BARRIER FENCE
- - -	1' INTERVAL EXISTING CONTOUR		-PDF- PROJECT DEMARICATION FENCE		▲ DUST CONTROL
---	EXIST. PROPERTY/ROW LINE				
○-▲	LIMIT OF WORK (LIMIT OF DISTURBANCE)				

NOTE:
 SEE EPSC NARRATIVE FOR ADDITIONAL REQUIREMENTS.



PROJECT NAME:	RICHMOND	PLOT DATE:	4/29/2013
PROJECT NUMBER:	STP 0284 (17)	DRAWN BY:	A. ACHARYA
FILE NAME:	z97cl86eccsbdr.dgn	CHECKED BY:	E. ATKINS
PROJECT LEADER:	ERIK ATKINS	SHEET	19 OF 133
DESIGNED BY:	T. BIGELOW		
EPSC CONSTRUCTION SITE PLAN SHEET 2			