

**GEOTEXTILE FOR SILT FENCE,  
WOVEN WIRE REINFORCED**  
US RTE 2 20+00 RT - 21+05 RT

**SEED**  
US RTE 2 20+00 RT - 22+89 RT

**SEED, WINTER RYE**  
~~US RTE 2 20+00 RT - 22+89 RT~~


**HAY MULCH**  
US RTE 2 20+00 RT - 22+89 RT

**TOP SOIL**  
US RTE 2 20+00 RT - 22+89 RT

**BARRIER FENCE**  
US RTE 2 20+00 - 21+05 RT  
US RTE 2 22+13 LT - 24+50 LT

**PROJECT DEMARCATION FENCE**  
US RTE 2 20+00 - 21+50 LT  
US RTE 2 21+05 - 24+50 RT


MATCHLINE STA. 20+00  
EPSC CONSTRUCTION SITE PLAN SHEET 3

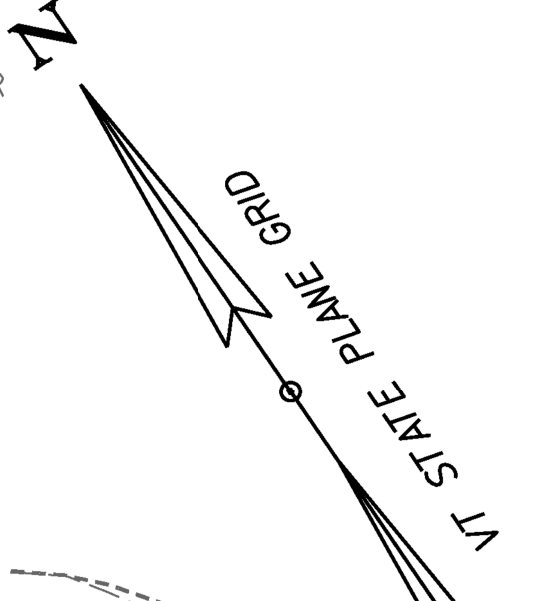

**LEGEND**

- |           |                                      |  |   |  |                                      |
|-----------|--------------------------------------|--|---|--|--------------------------------------|
| -----     | SOIL TYPE BOUNDARY                   |  | SURFACE ROUGHENING  |  | PIPE INLET PROTECTION                |
| —300—     | 5' INTERVAL PROPOSED CONTOUR         |  | SILT FENCE  |  | FILTER FABRIC DROP INLET PROTECTION  |
| - - - - - | 1' INTERVAL PROPOSED CONTOUR         |  | SILT FENCE WOVEN WIRE   |  | -BF- BF- BARRIER FENCE               |
| —300—     | 5' INTERVAL EXISTING CONTOUR         |  | ROLLED EROSION CONTROL PRODUCT, DITCH/SIDESLOPE                 |  | -PDF- PDF- PROJECT DEMARCATION FENCE |
| - - - - - | 1' INTERVAL EXISTING CONTOUR         |  | STABILIZED CONSTRUCTION ENTRANCE (SEE TRAFFIC MANAGEMENT PLANS) |  | ΔC DUST CONTROL                      |
| —         | EXIST. PROPERTY/ROW LINE             |  |   |  |                                      |
| ○—△       | LIMIT OF WORK (LIMIT OF DISTURBANCE) |  |   |  |                                      |

NOTE:  
SEE EPSC NARRATIVE FOR ADDITIONAL REQUIREMENTS.

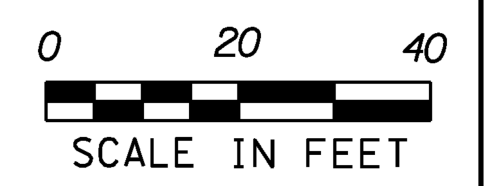

PROJECT NAME: RICHMOND  
PROJECT NUMBER: STP 0284 (17)

FILE NAME: z97cl86eccsbdr.dgn  
PROJECT LEADER: ERIK ATKINS  
DESIGNED BY: T.BIGELOW  
EPSC CONSTRUCTION SITE PLAN SHEET 4

PLOT DATE: 4/29/2013  
DRAWN BY: A. ACHARYA  
CHECKED BY: E. ATKINS  
SHEET 21 OF 133