

SEED, WINTER RYE
 PNR 70+05 - 72+70 LT
 PNR 74+48 - 76+25 LT
 PNR 75+57 - 76+15 LT
 PNR 70+50 - 72+19 LT
 PNR 73+12 - 74+92 RT

SEED
 PNR 70+00 LT - 76+46 LT
 PNR 70+00 RT - 76+46 RT

SEED, WINTER RYE
~~PNR 70+00 LT - 76+46 LT~~
~~PNR 70+00 RT - 76+46 RT~~

HAY MULCH
 PNR 70+00 LT - 76+46 LT
 PNR 70+00 RT - 76+46 RT

TOP SOIL
 PNR 70+00 LT - 76+46 LT
 PNR 70+00 RT - 76+46 RT



TEMPORARY EROSION MATTING
 PNR 70+50 LT - 76+05 LT

PERMANENT EROSION MATTING
 PNR 70+47 LT - 72+26 LT
 PNR 73+41 LT - 76+18 LT
 PNR 74+23 RT - 76+18 RT

INLET PROTECTION DEVICE, TYPE I
 (STAKED FABRIC)
 PNR 75+56 RT

INLET PROTECTION DEVICE, TYPE I
 (PIPE INLET PROTECTION)
 PNR 75+56 RT


PROJECT DEMARCATION FENCE
 PNR 70+00 LT - 76+50 RT

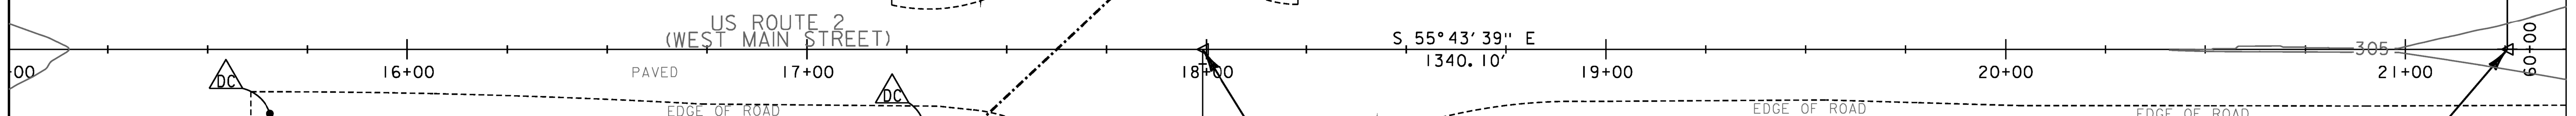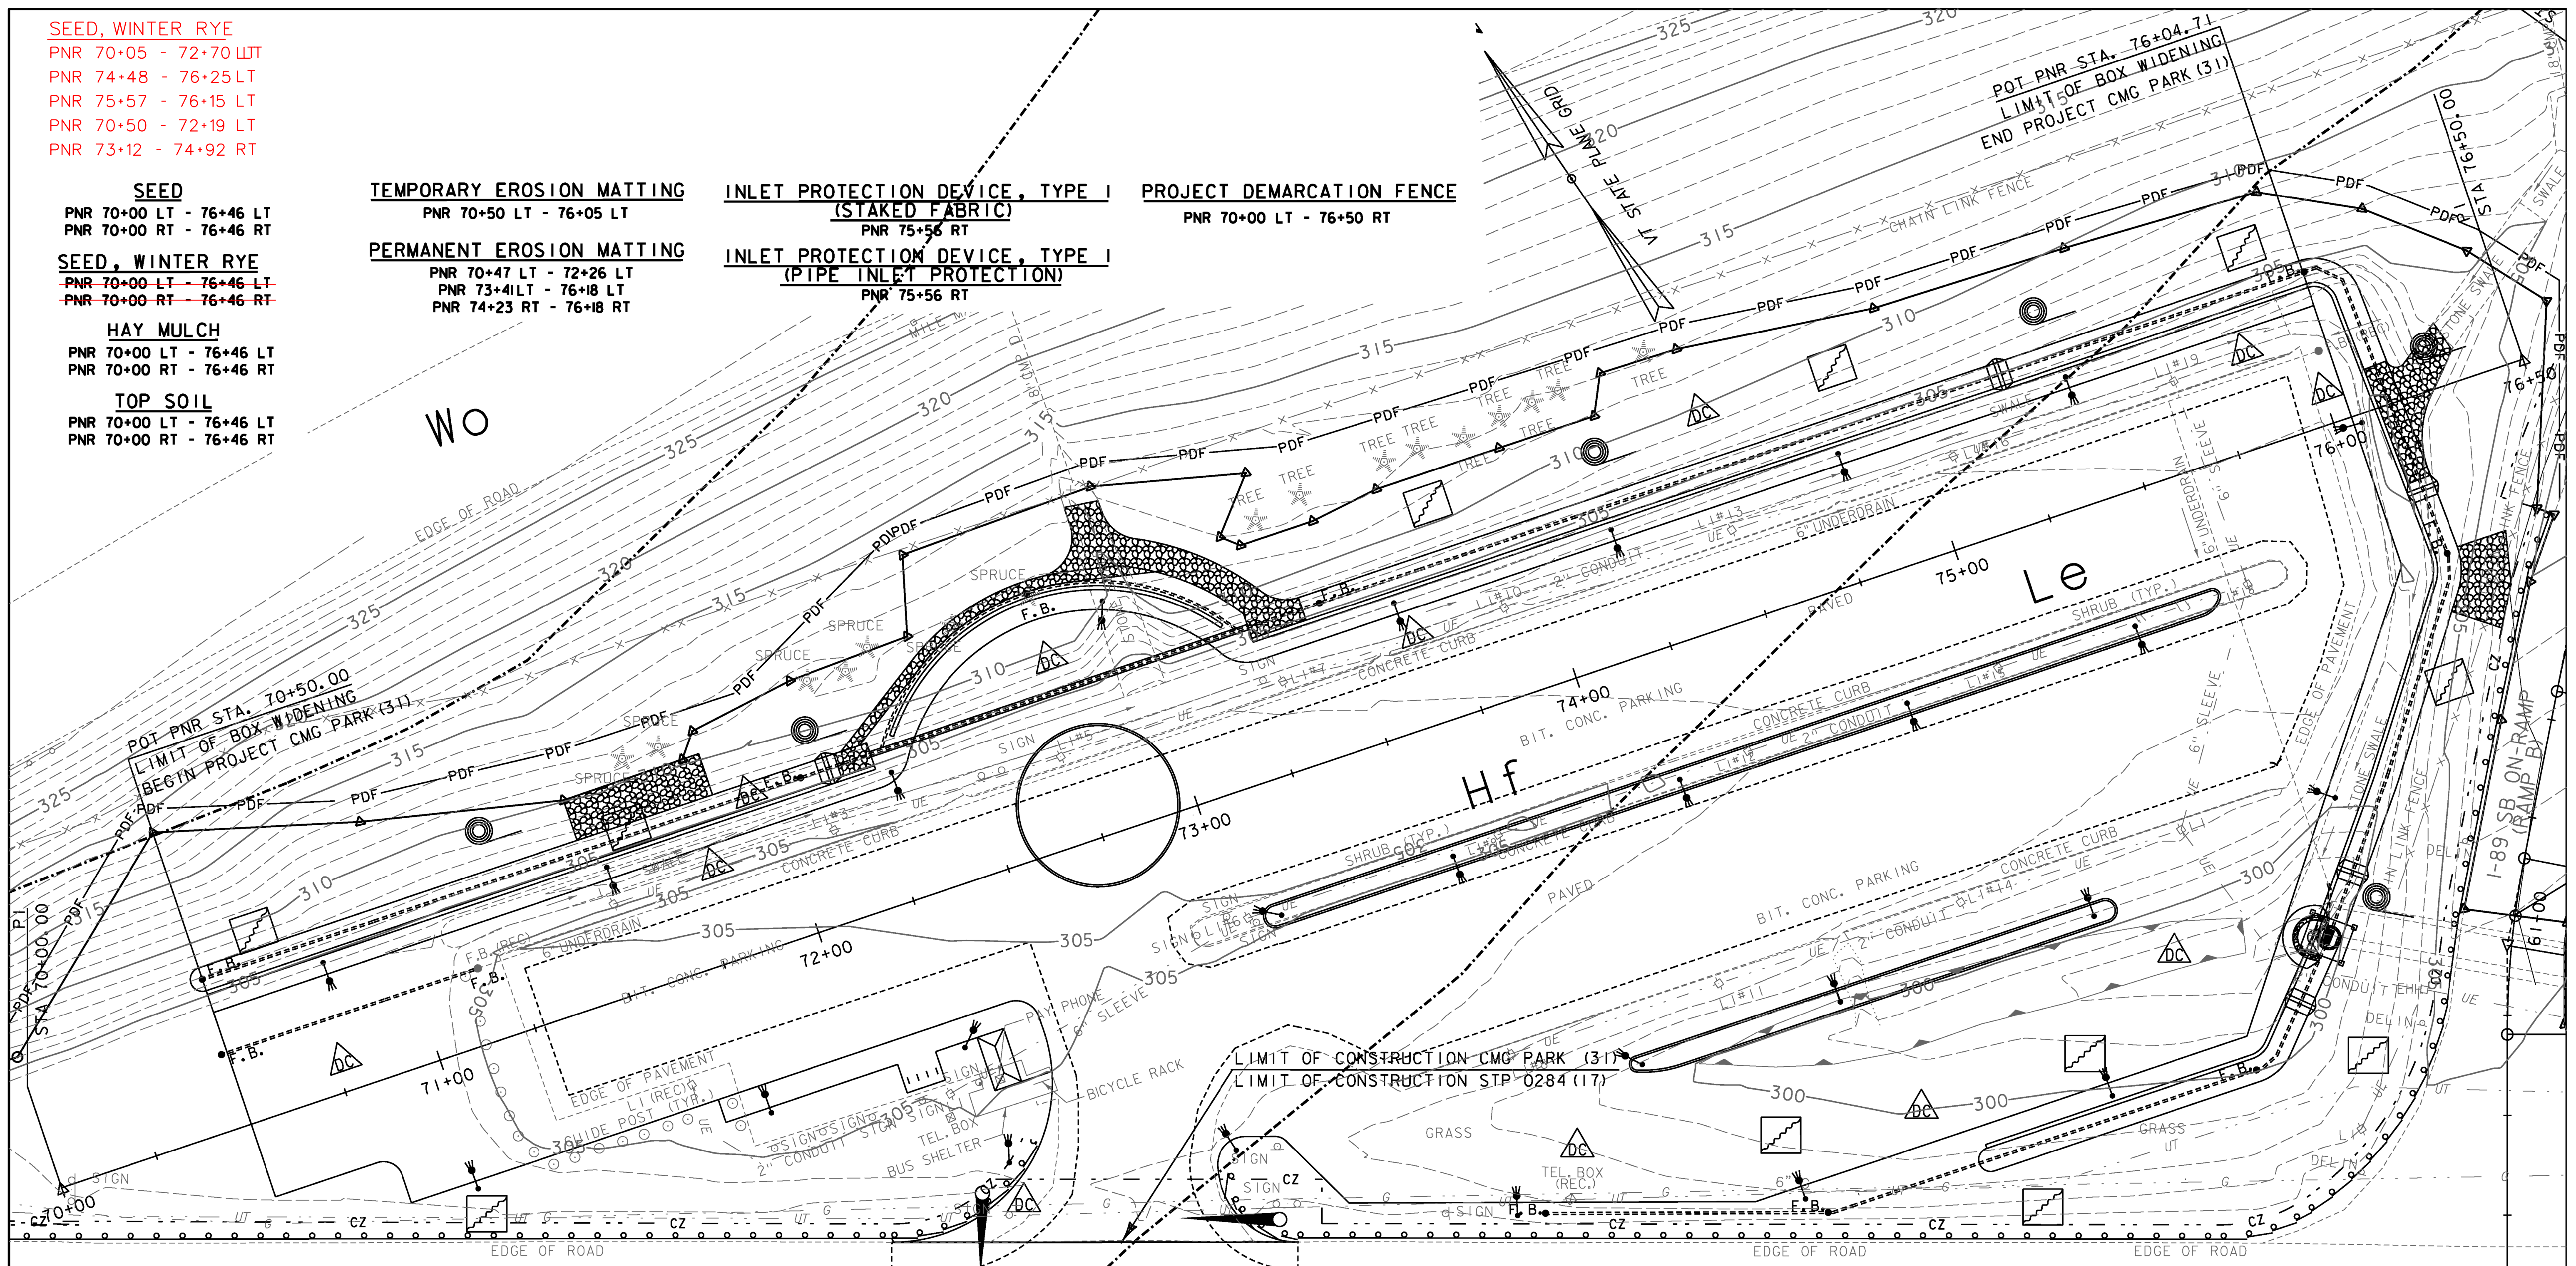

LEGEND

- | | | | |
|-------|--------------------------------------|--|---|
| --- | SOIL TYPE BOUNDARY | | SURFACE ROUGHENING |
| -300- | 5' INTERVAL PROPOSED CONTOUR | | SILT FENCE |
| -1'- | 1' INTERVAL PROPOSED CONTOUR | | SILT FENCE WOVEN WIRE |
| -300- | 5' INTERVAL EXISTING CONTOUR | | ROLLED EROSION CONTROL PRODUCT, DITCH/SIDESLOPE |
| -1'- | 1' INTERVAL EXISTING CONTOUR | | STABILIZED CONSTRUCTION ENTRANCE (SEE TRAFFIC MANAGEMENT PLANS) |
| --- | EXIST. PROPERTY/ROW LINE | | PIPE INLET PROTECTION |
| ○-△ | LIMIT OF WORK (LIMIT OF DISTURBANCE) | | FILTER FABRIC DROP INLET PROTECTION |
| | | | -BF- BF - BARRIER FENCE |
| | | | PDF - PROJECT DEMARCATION FENCE |
| | | | △ - DUST CONTROL |

NOTE:
 SEE EPSC NARRATIVE FOR ADDITIONAL REQUIREMENTS.

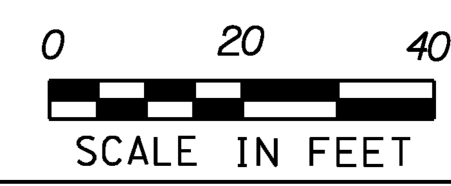

PROJECT NAME: RICHMOND
 PROJECT NUMBER: CMG PARK (31)
 FILE NAME: z97c186eccsldr.dgn
 PROJECT LEADER: ERIK ATKINS
 DESIGNED BY: T.BIGELOW
 EPSC CONSTRUCTION SITE PLAN SHEET 5
 PLOT DATE: 4/29/2013
 DRAWN BY: A. ACHARYA
 CHECKED BY: E. ATKINS
 SHEET 22 OF 133