


NOTE:
SEE CROSS SECTIONS AND PARTIAL GRADING PLAN FOR ADDITIONAL PROPOSED GRADING.

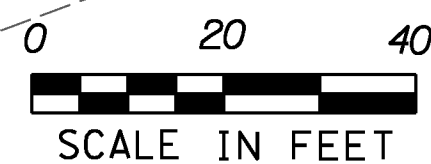

PROJECT NAME:	RICHMOND	FILE NAME:	z97cl86ecfinalbdr.dgn	PLOT DATE:	4/26/2013
PROJECT NUMBER:	CMG PARK (31)	PROJECT LEADER:	ERIK ATKINS	DRAWN BY:	N. BOSAN
		DESIGNED BY:	T. BIGELOW	CHECKED BY:	E. ATKINS
			EPSC FINAL CONDITIONS PLAN SHEET 5		SHEET 27 OF 133