

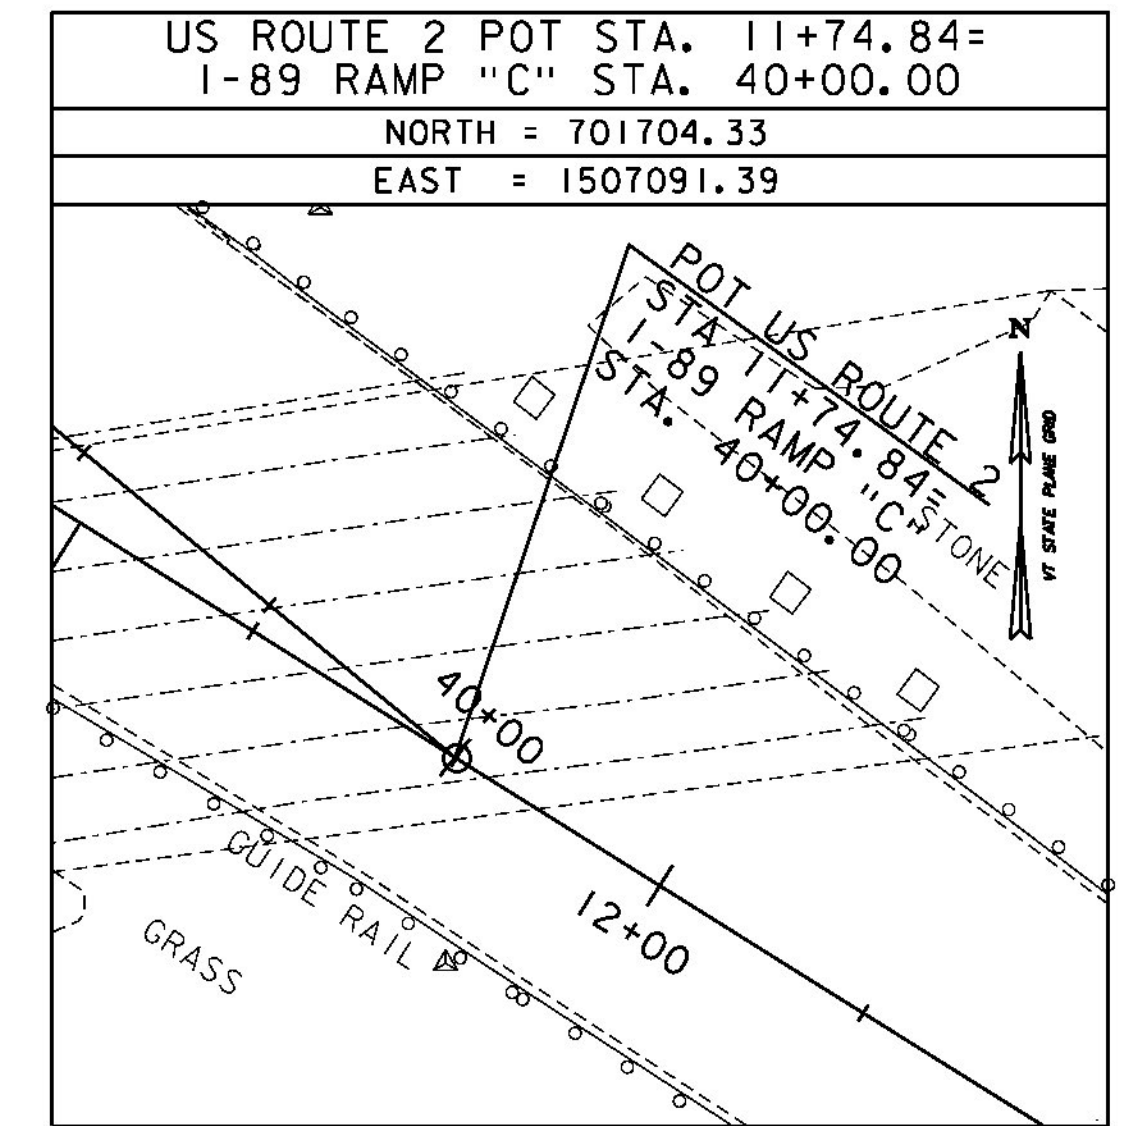
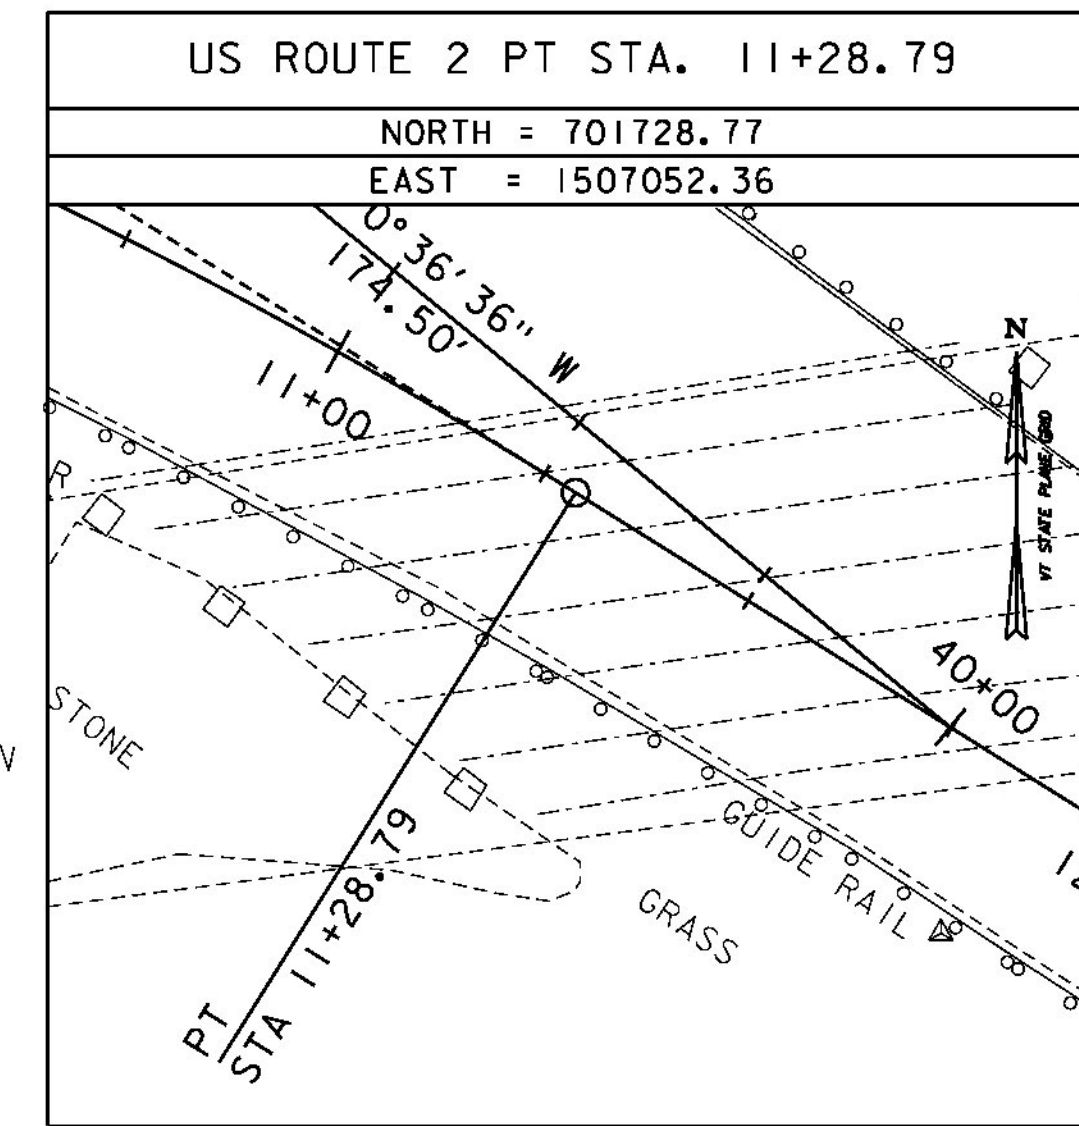
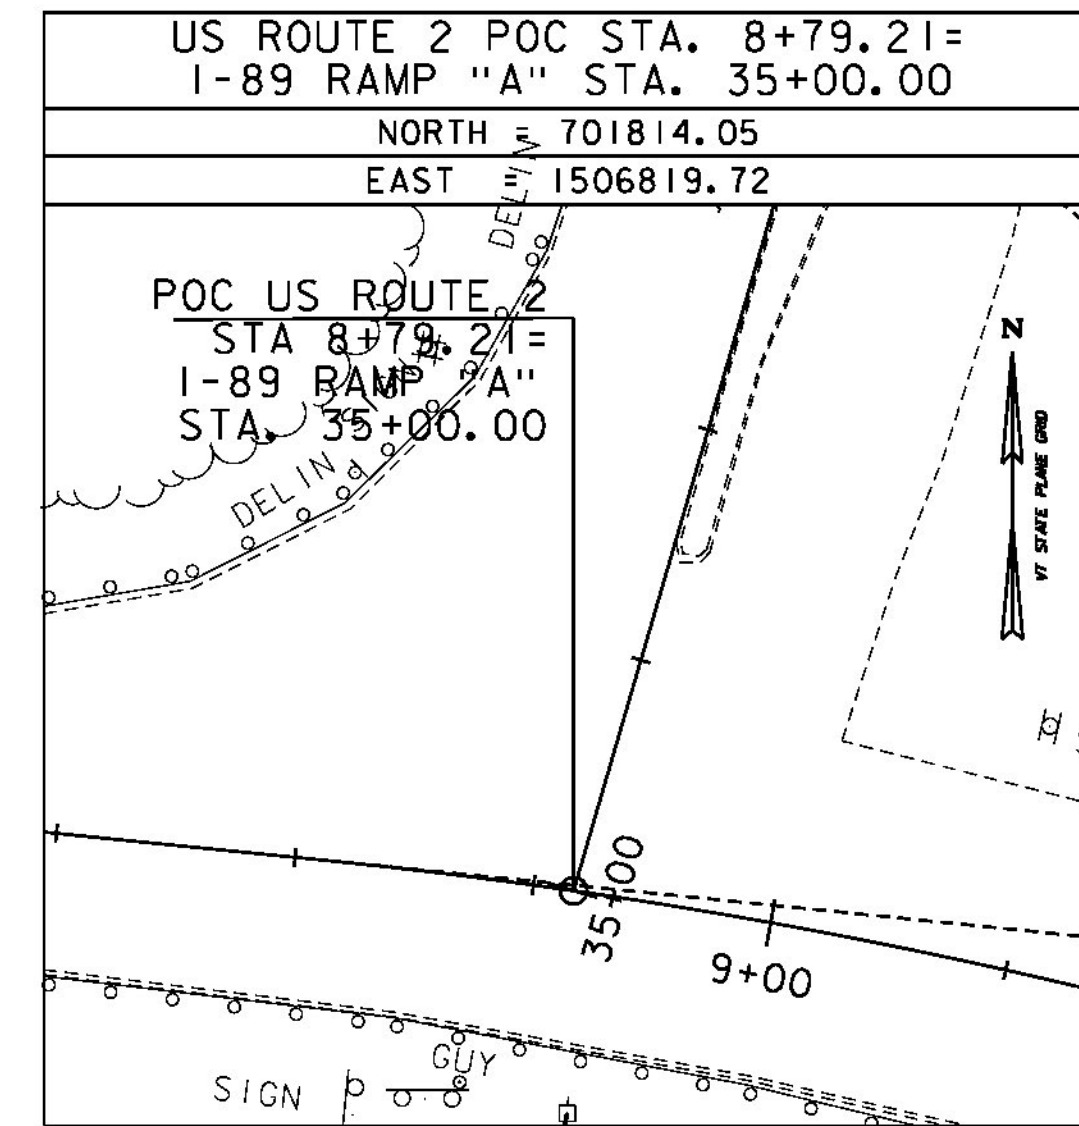
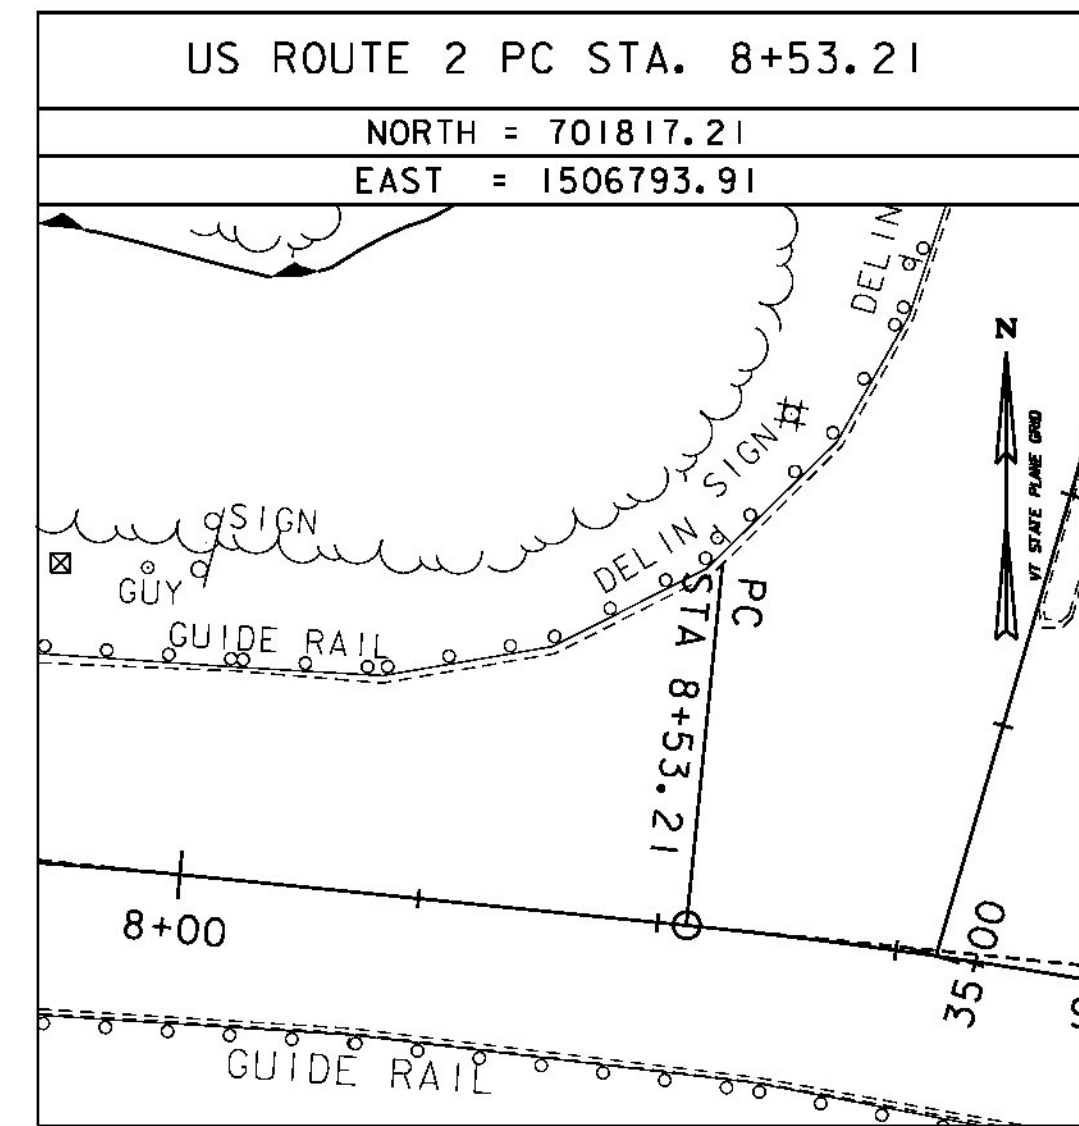
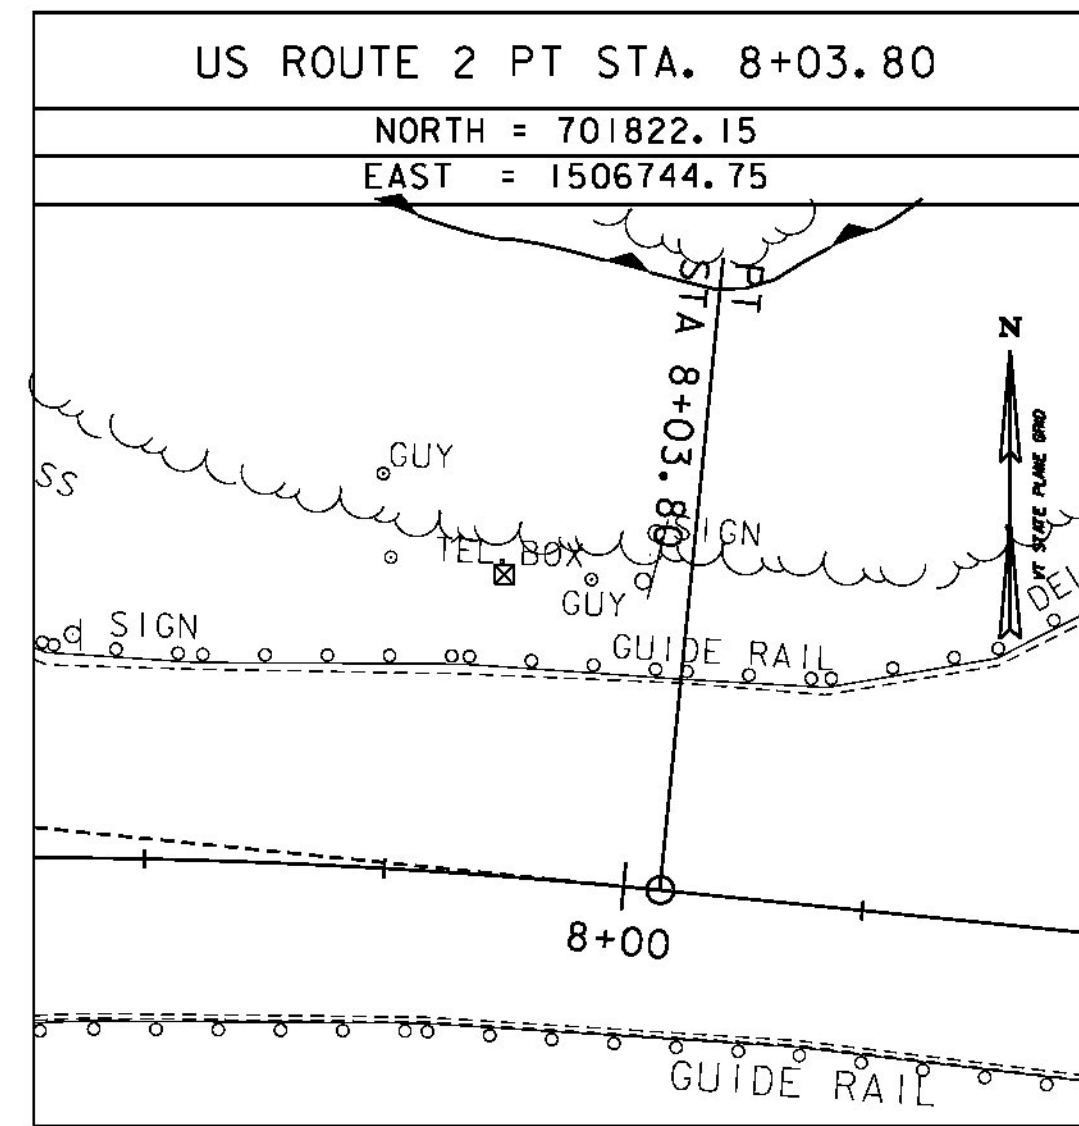
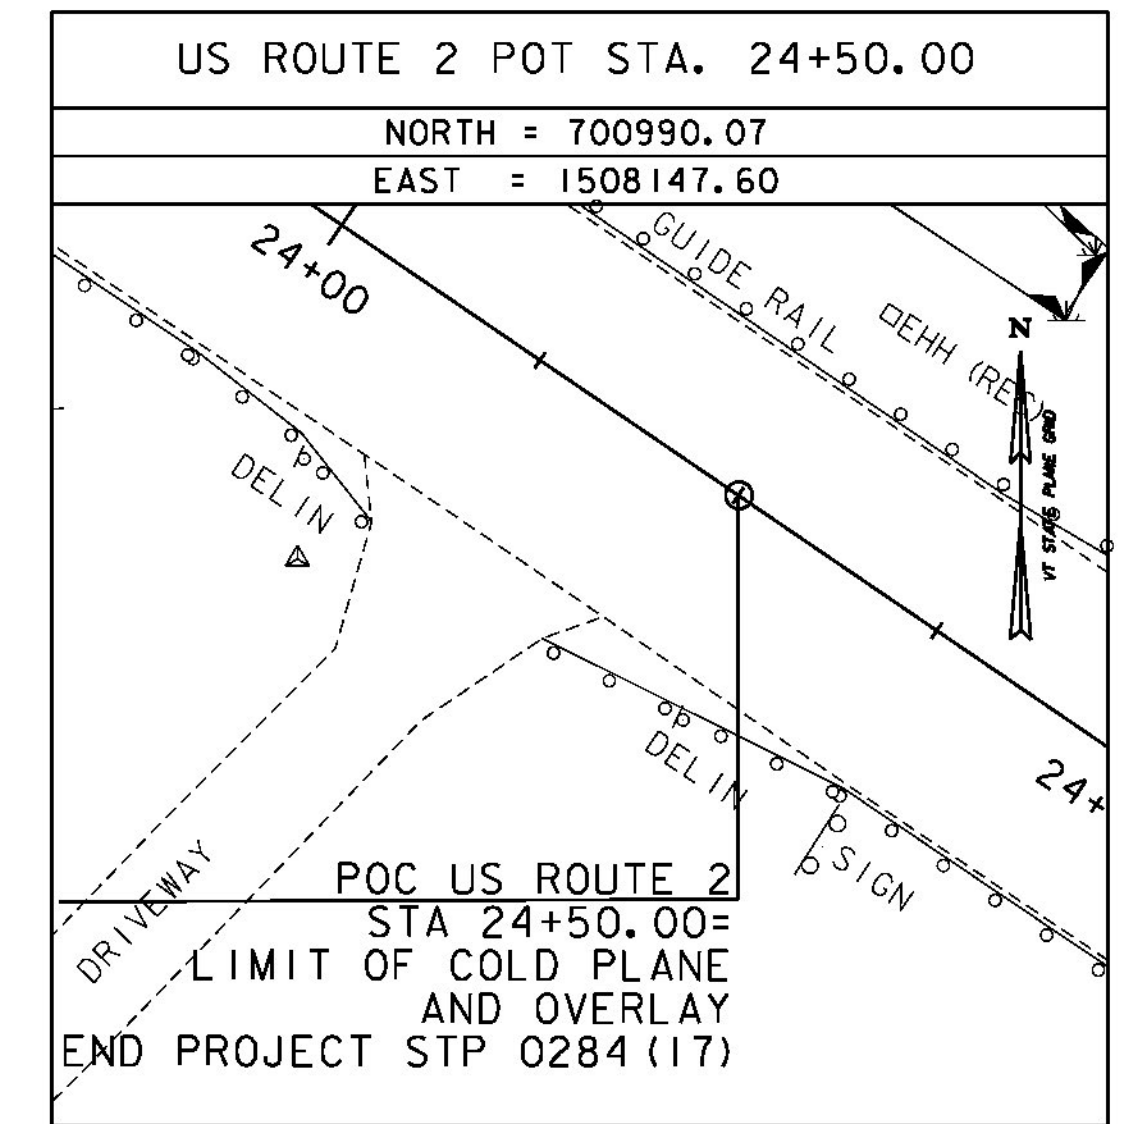
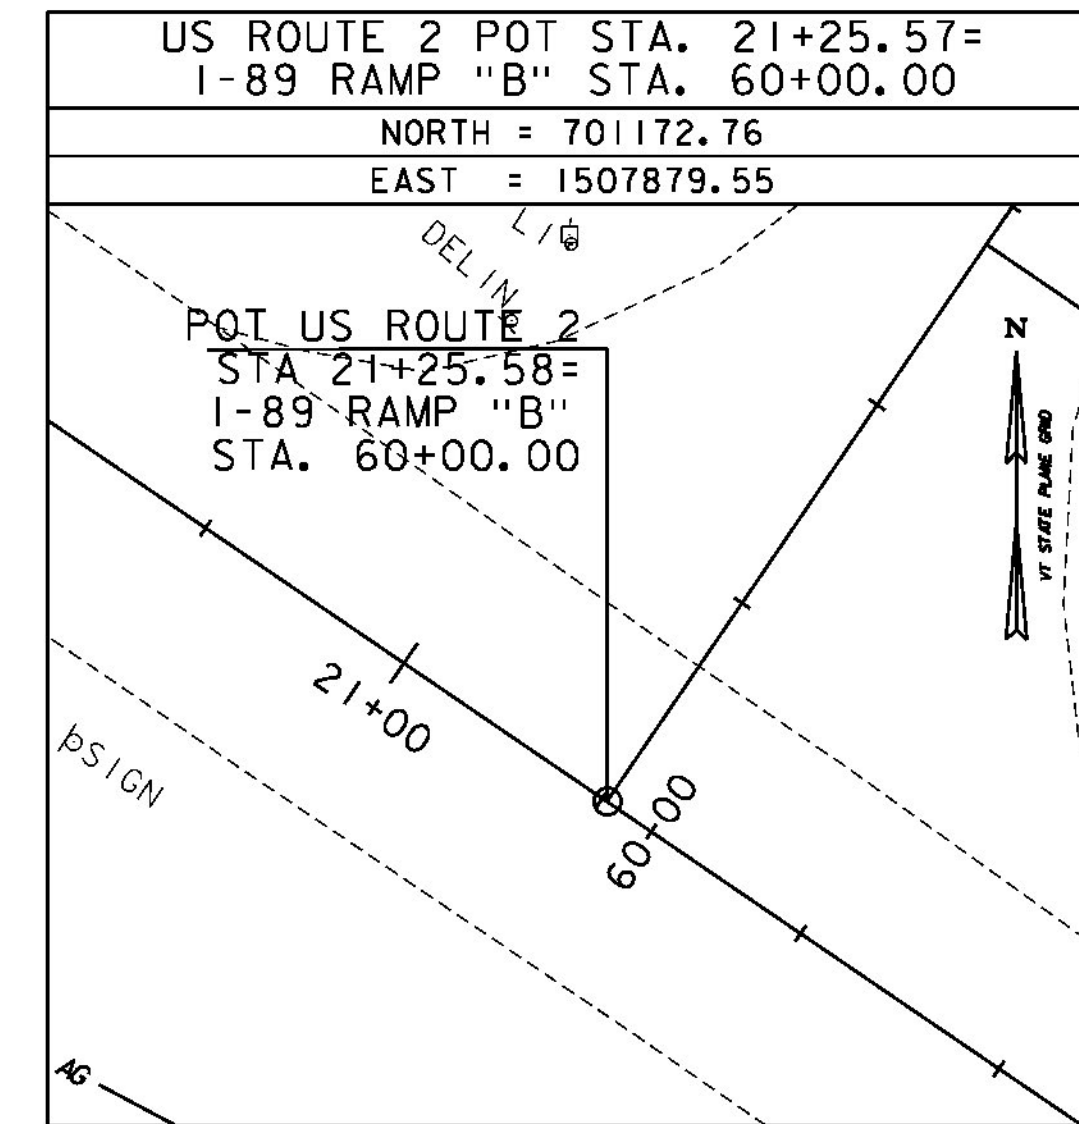
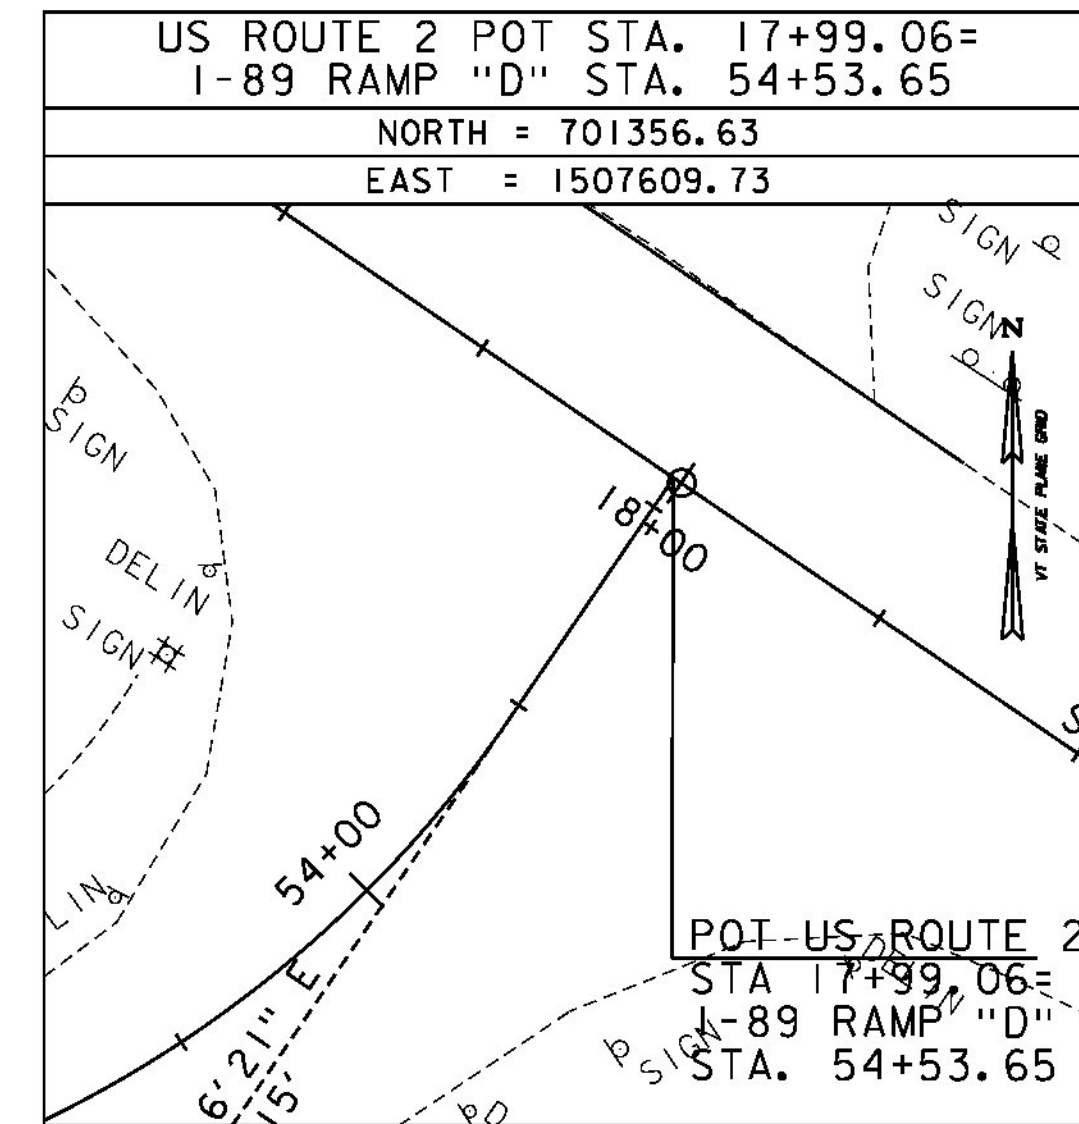







ALIGNMENT TIES

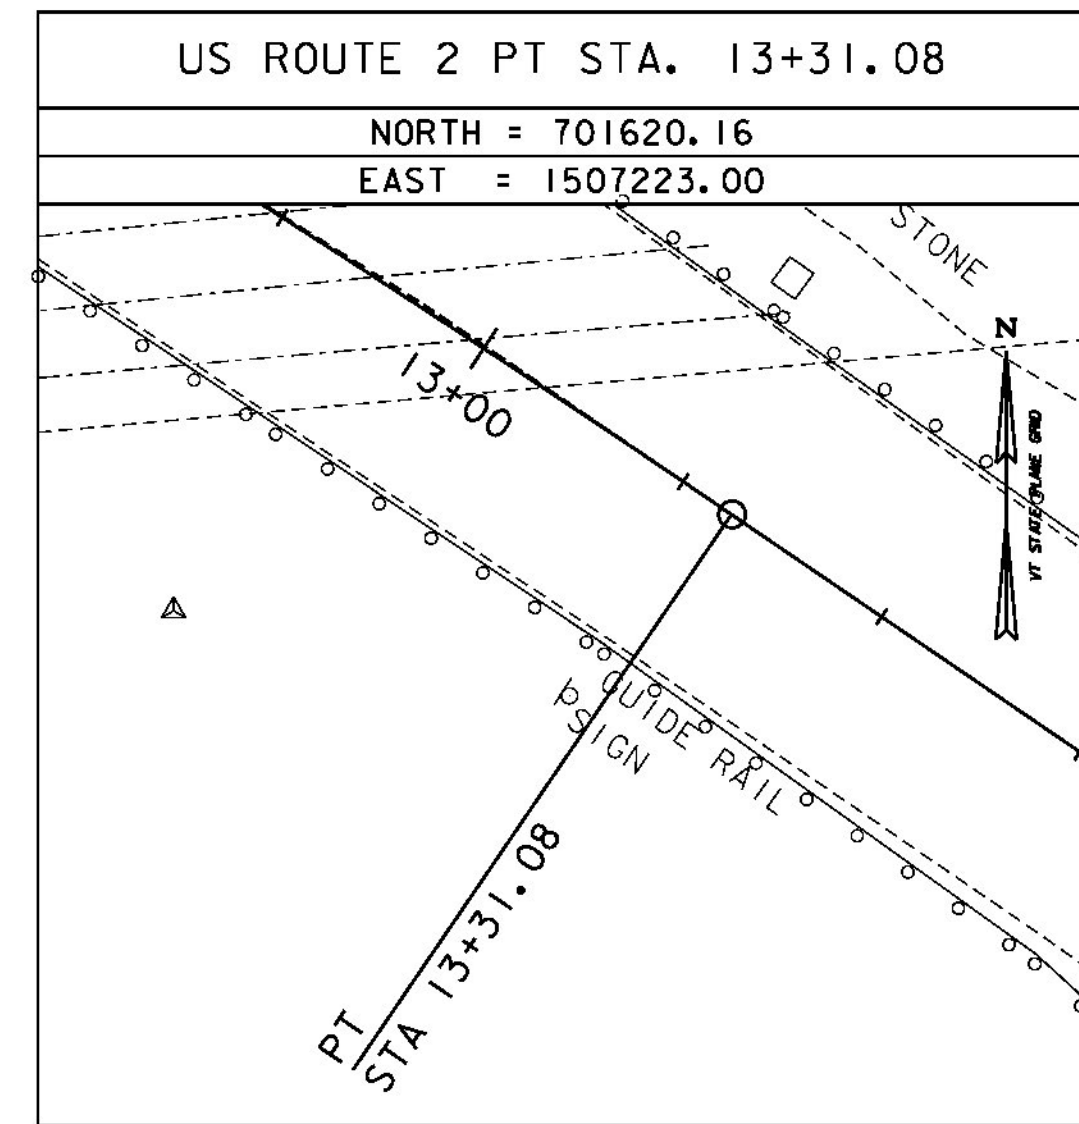


ALIGNMENT TIES

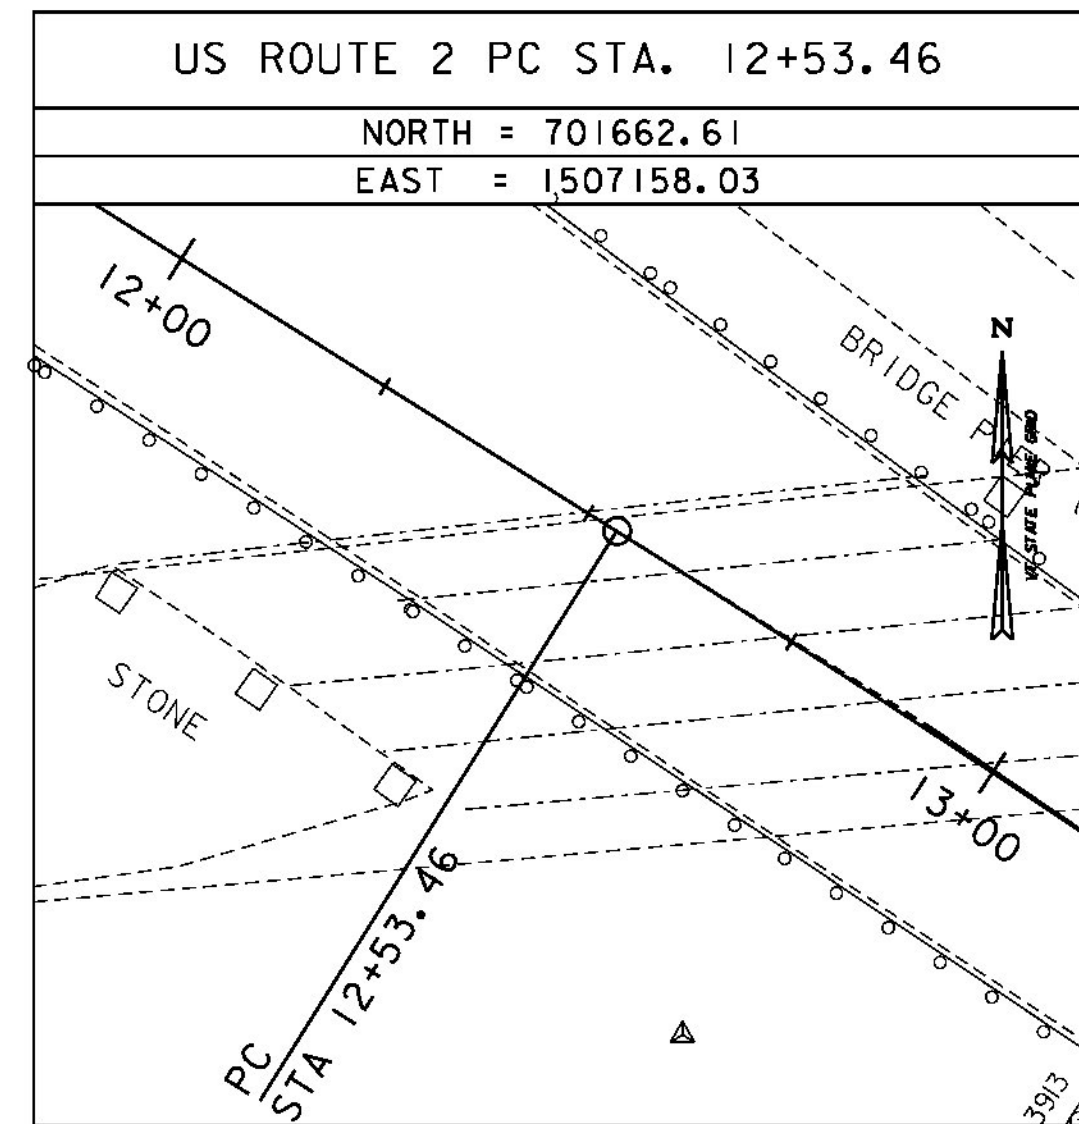

ALIGNMENT TIES

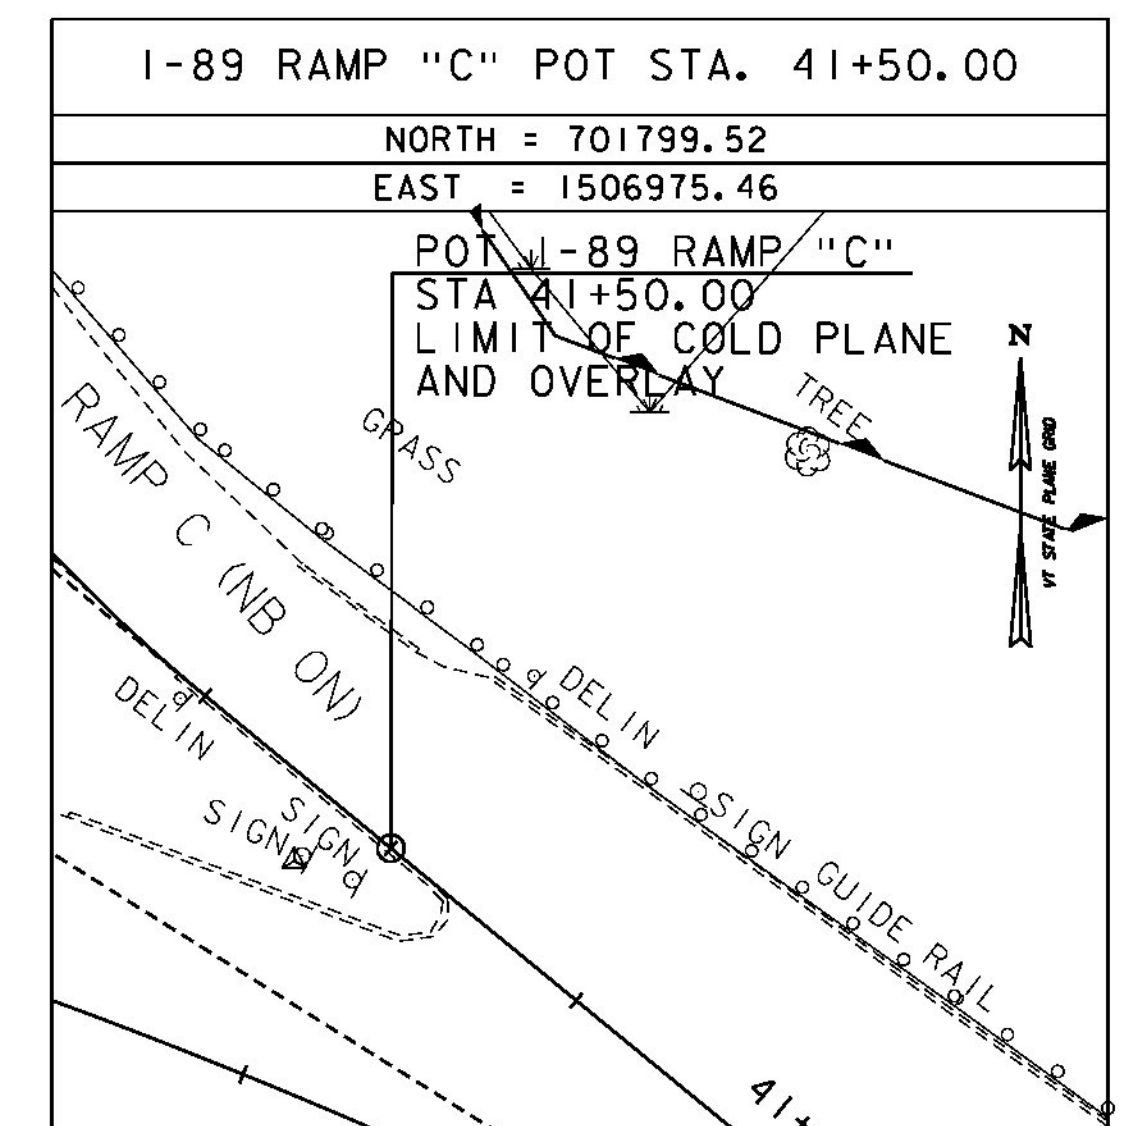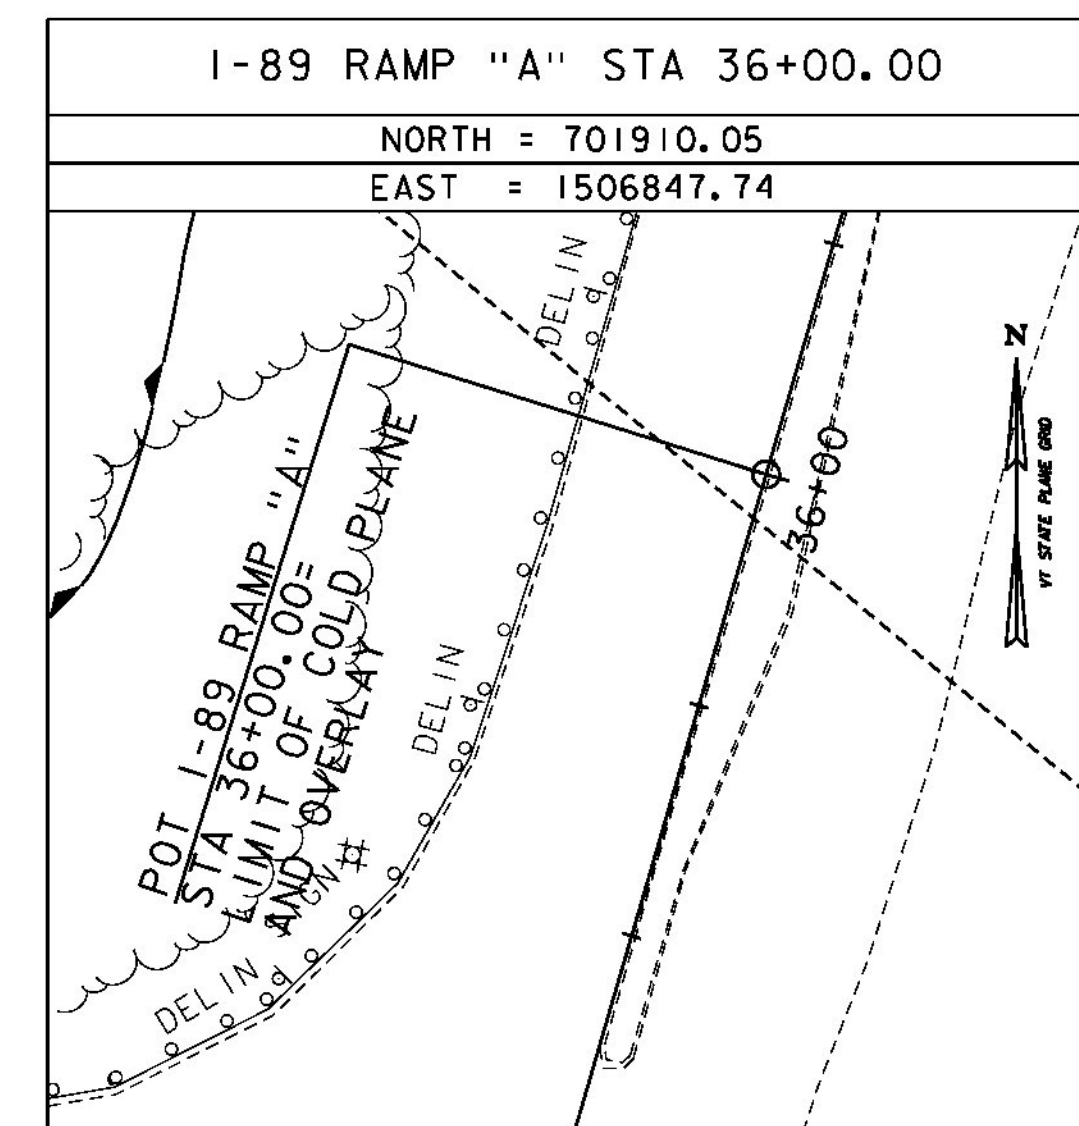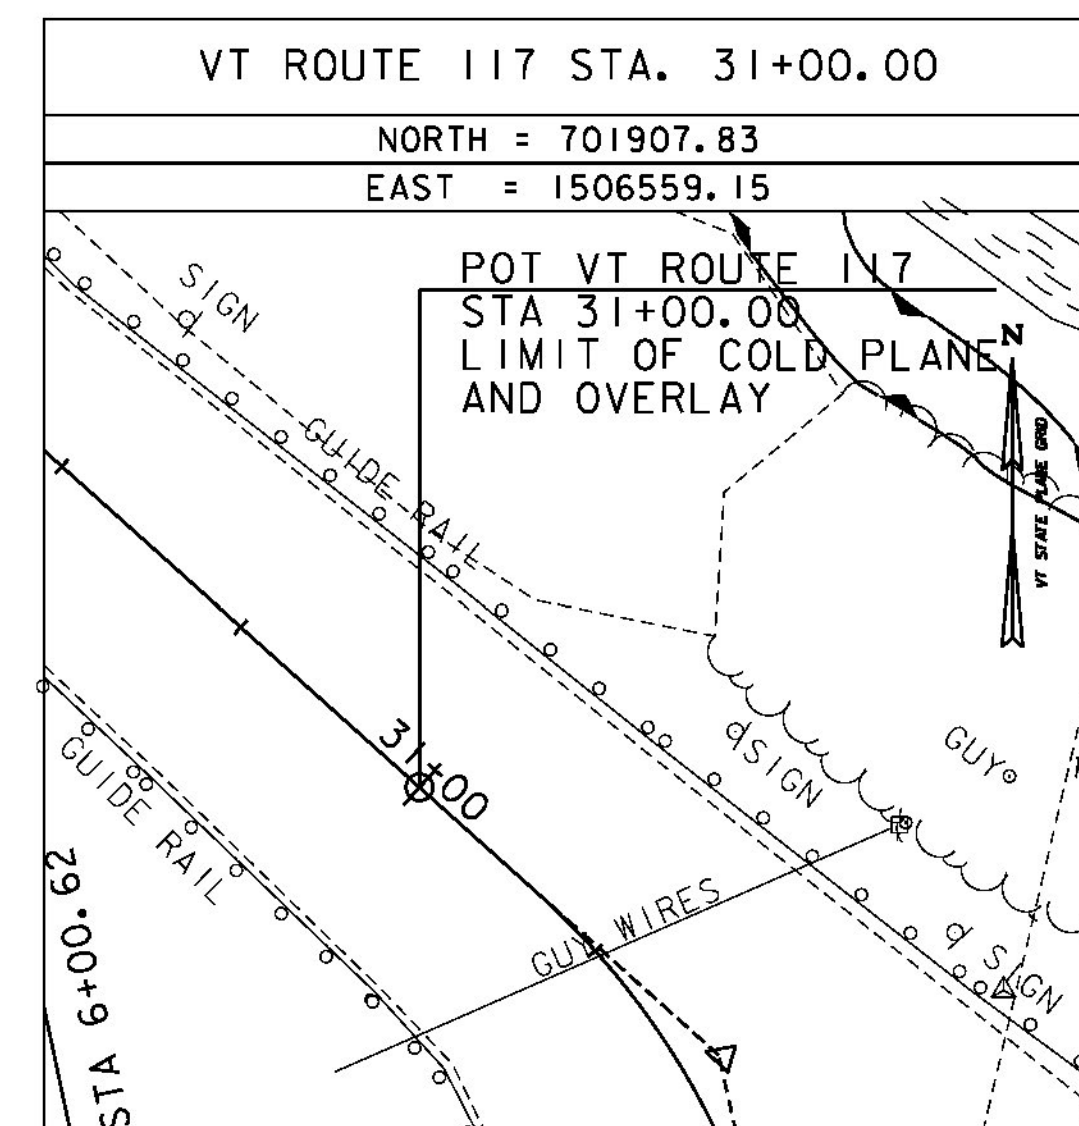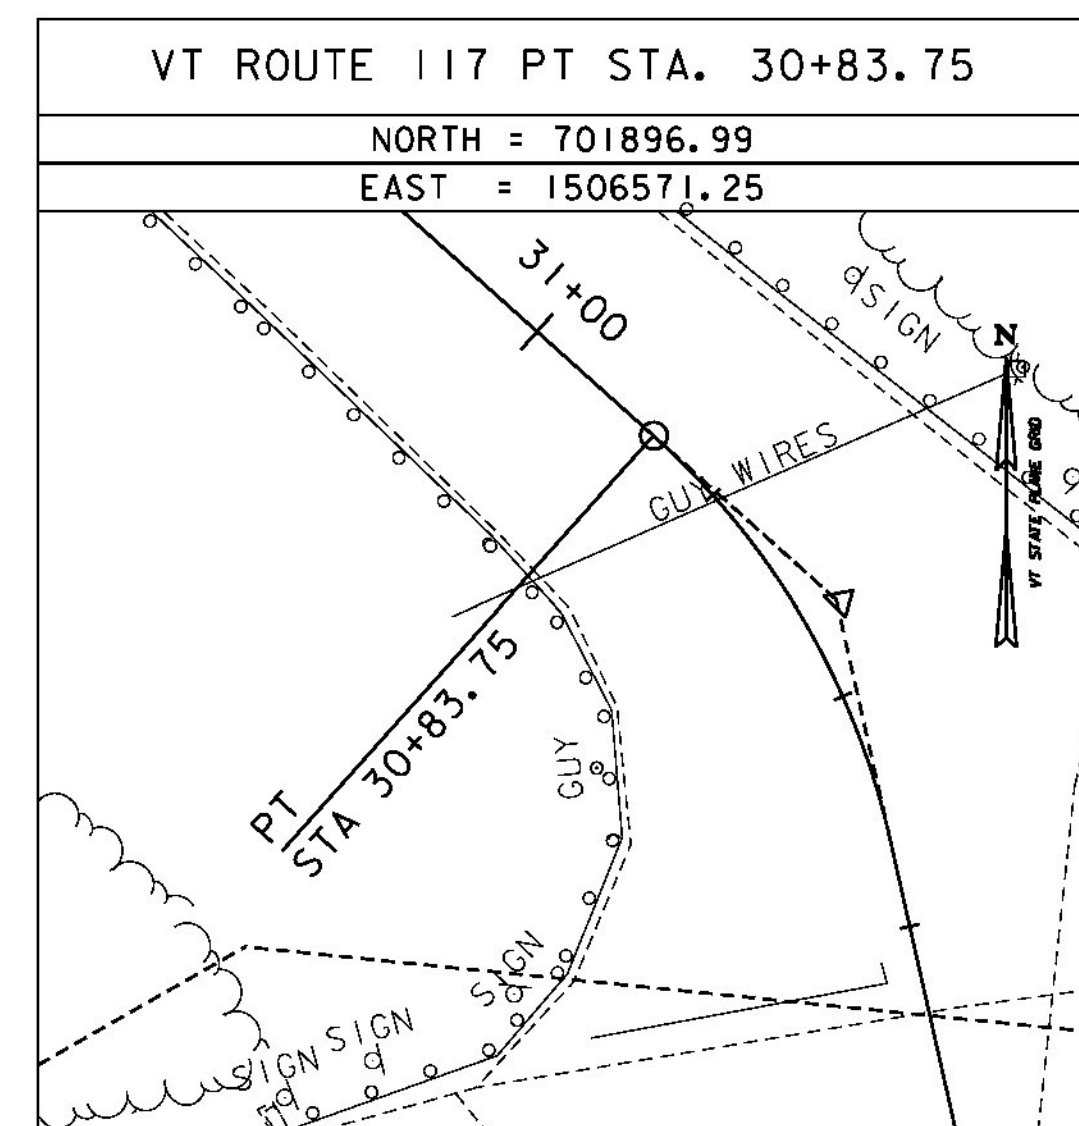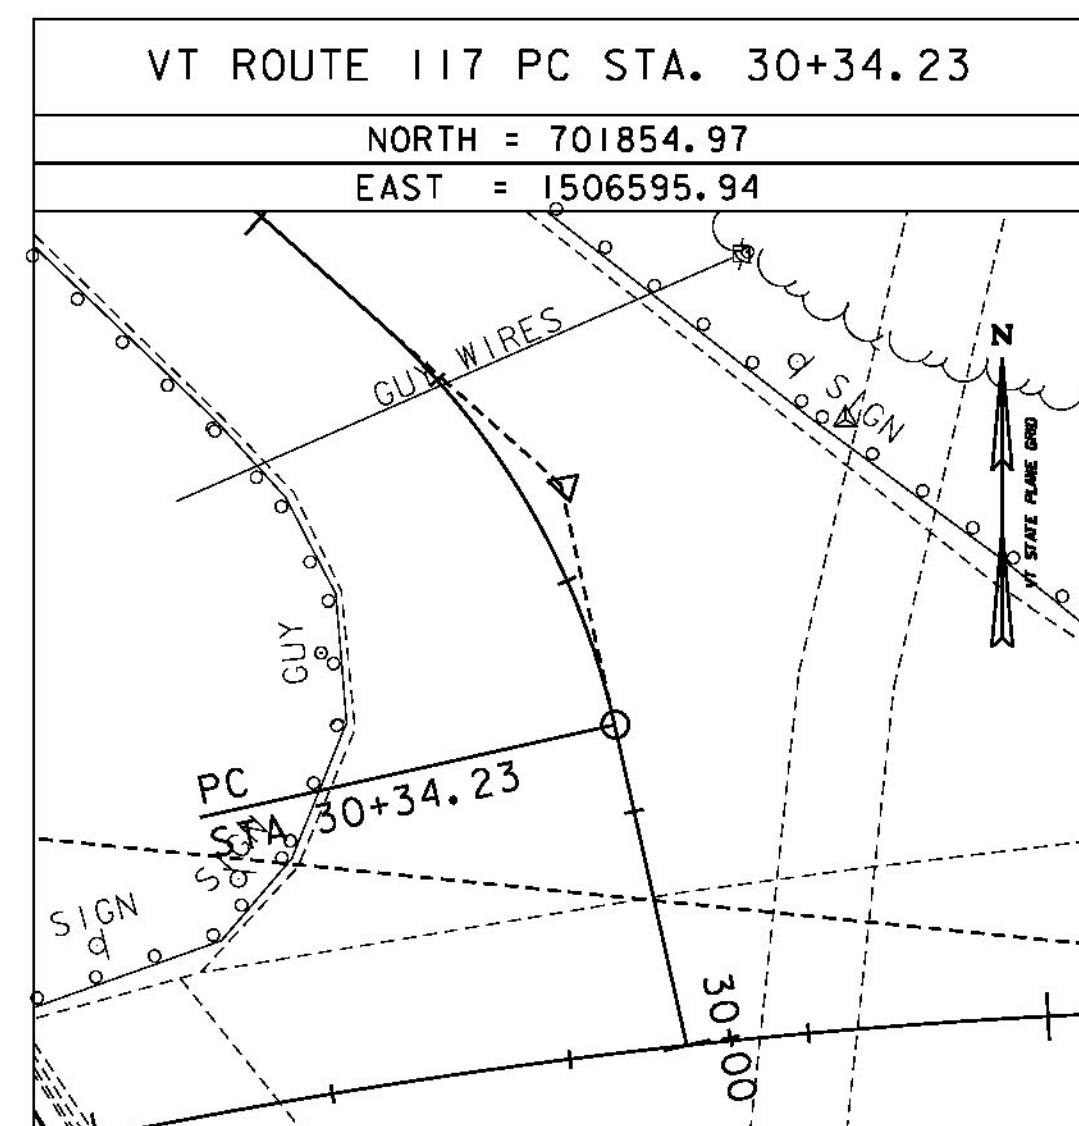

DATUM	
VERTICAL	NAVD88
HORIZONTAL	NAD83 (1992)
ADJUSTMENT	COMPASS

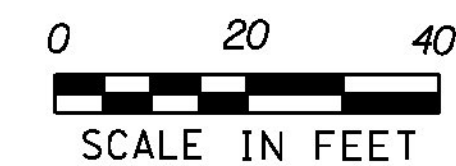

PROJECT NAME:	RICHMOND
PROJECT NUMBER:	STP 0284 (17)
FILE NAME:	z97ci86+1.dgn
PROJECT LEADER:	ERIK ATKINS
DESIGNED BY:	T. BIGELOW
TIE SHEET 2	
PLOT DATE:	4/29/2013
DRAWN BY:	A. ACHARYA
CHECKED BY:	E. ATKINS
SHEET	43 OF 133