

MATCHLINE STA. 10+00
CURB TIE AND LAYOUT SHEET 1


MATCHLINE STA. 15+00
CURB TIE AND LAYOUT SHEET 3

US ROUTE 2
CURVE DATA
 $\Delta = 26^\circ 18' 55.99''$
 $D = 9^\circ 32' 57.47''$
 $R = 600.00$
 $T = 140.26$
 $L = 275.58$
 $E = 16.18$
 BANK = NA

US ROUTE 2
CURVE DATA
 $\Delta = 2^\circ 13' 25.16''$ RT
 $D = 2^\circ 51' 53.24''$
 $R = 2000.00$
 $T = 38.82$
 $L = 77.62$
 $E = 0.38$
 BANK = NA

CURVE TABLE

LABEL	RADIUS (ft)	LENGTH (ft)
C5	500.00	147.85

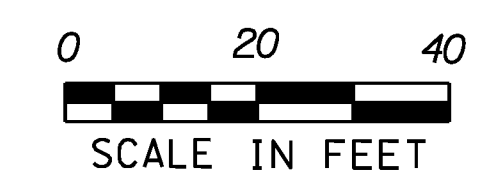

PROJECT NAME:	RICHMOND	PLOT DATE:	4/29/2013
PROJECT NUMBER:	STP 0284 (17)	DRAWN BY:	N. BOSAN
FILE NAME:	z97c186curbbdr.dgn	CHECKED BY:	E. ATKINS
PROJECT LEADER:	ERIK ATKINS	SHEET	46 OF 133
DESIGNED BY:	T. BIGELOW		
CURB TIE AND LAYOUT SHEET 2			