




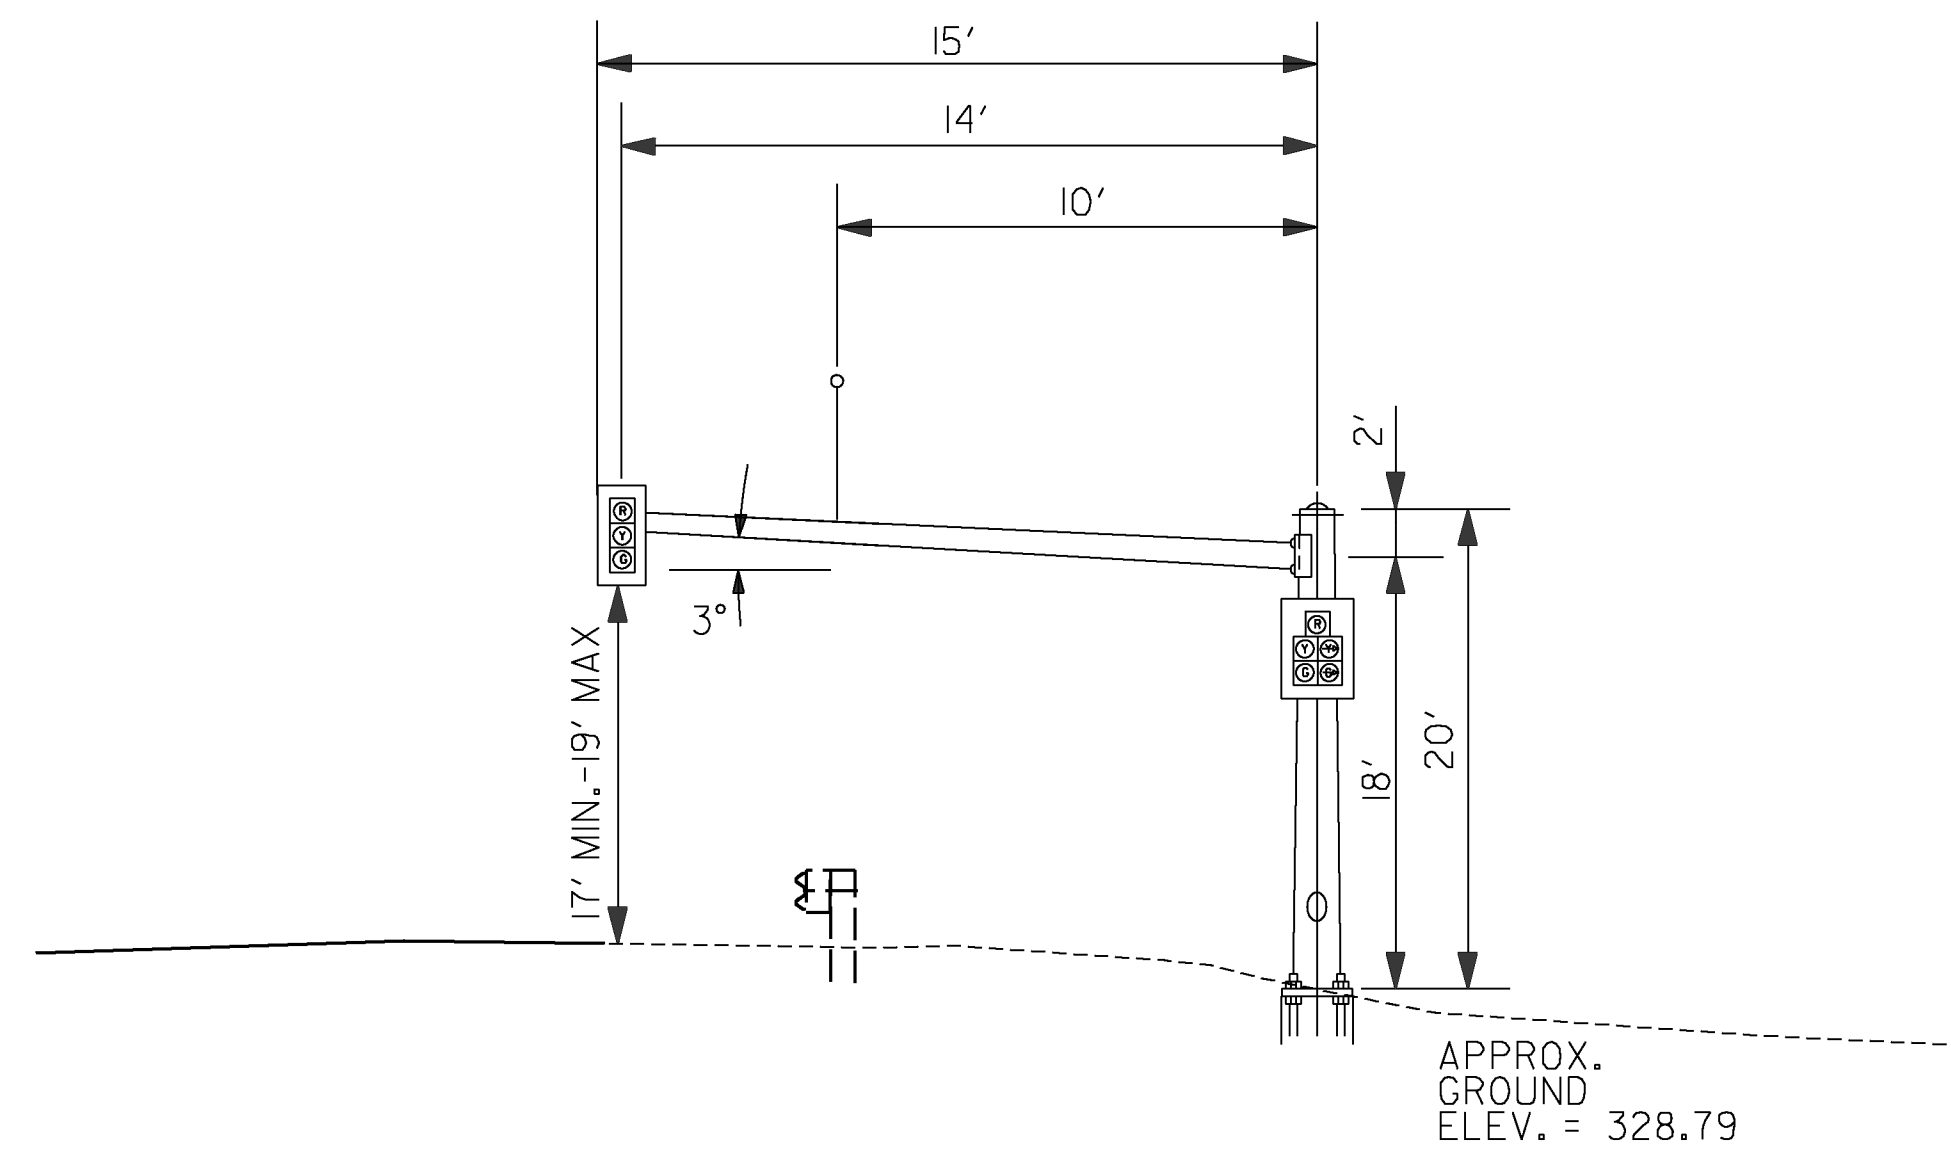


MP1A
N.T.S.

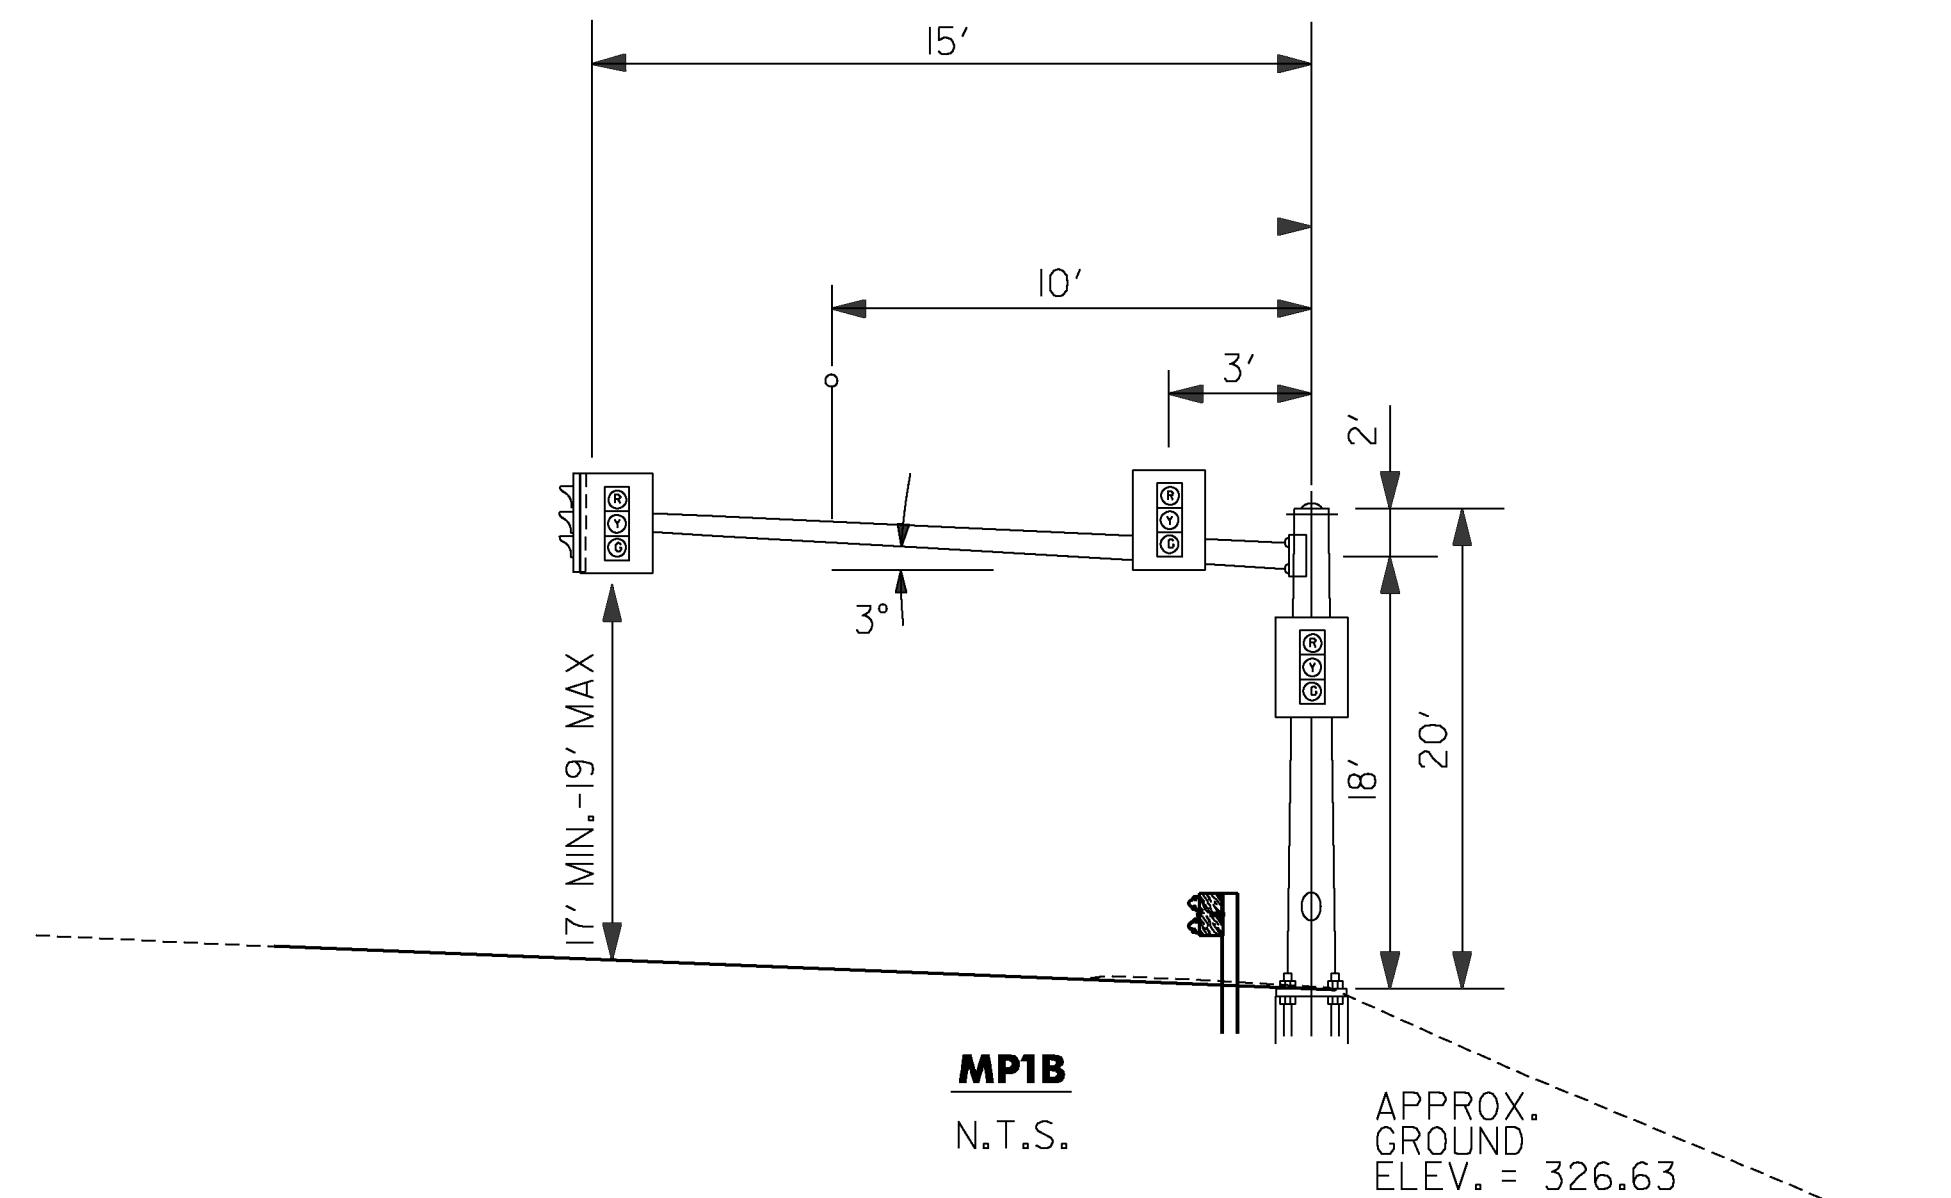


MP1B
N.T.S.

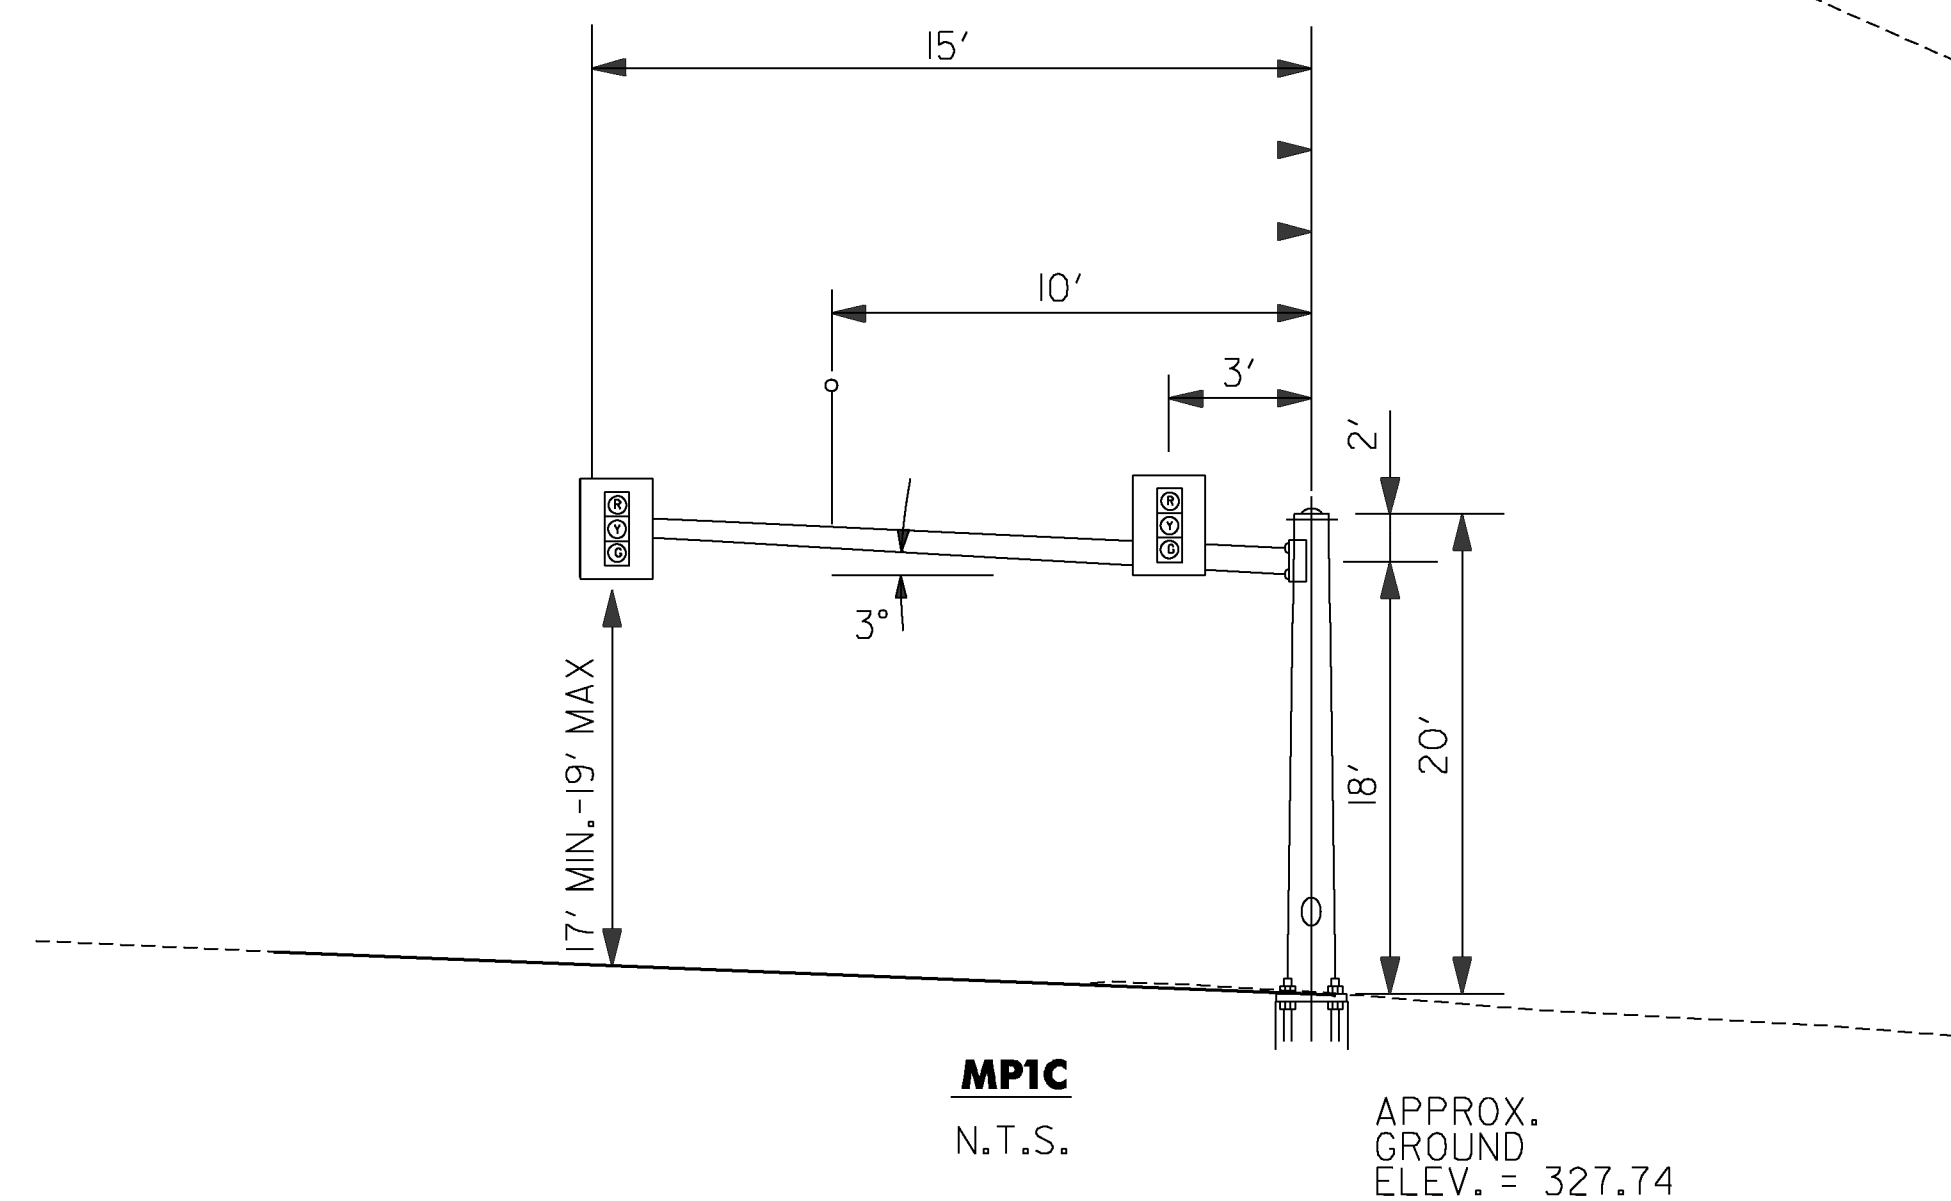


MP1C
N.T.S.

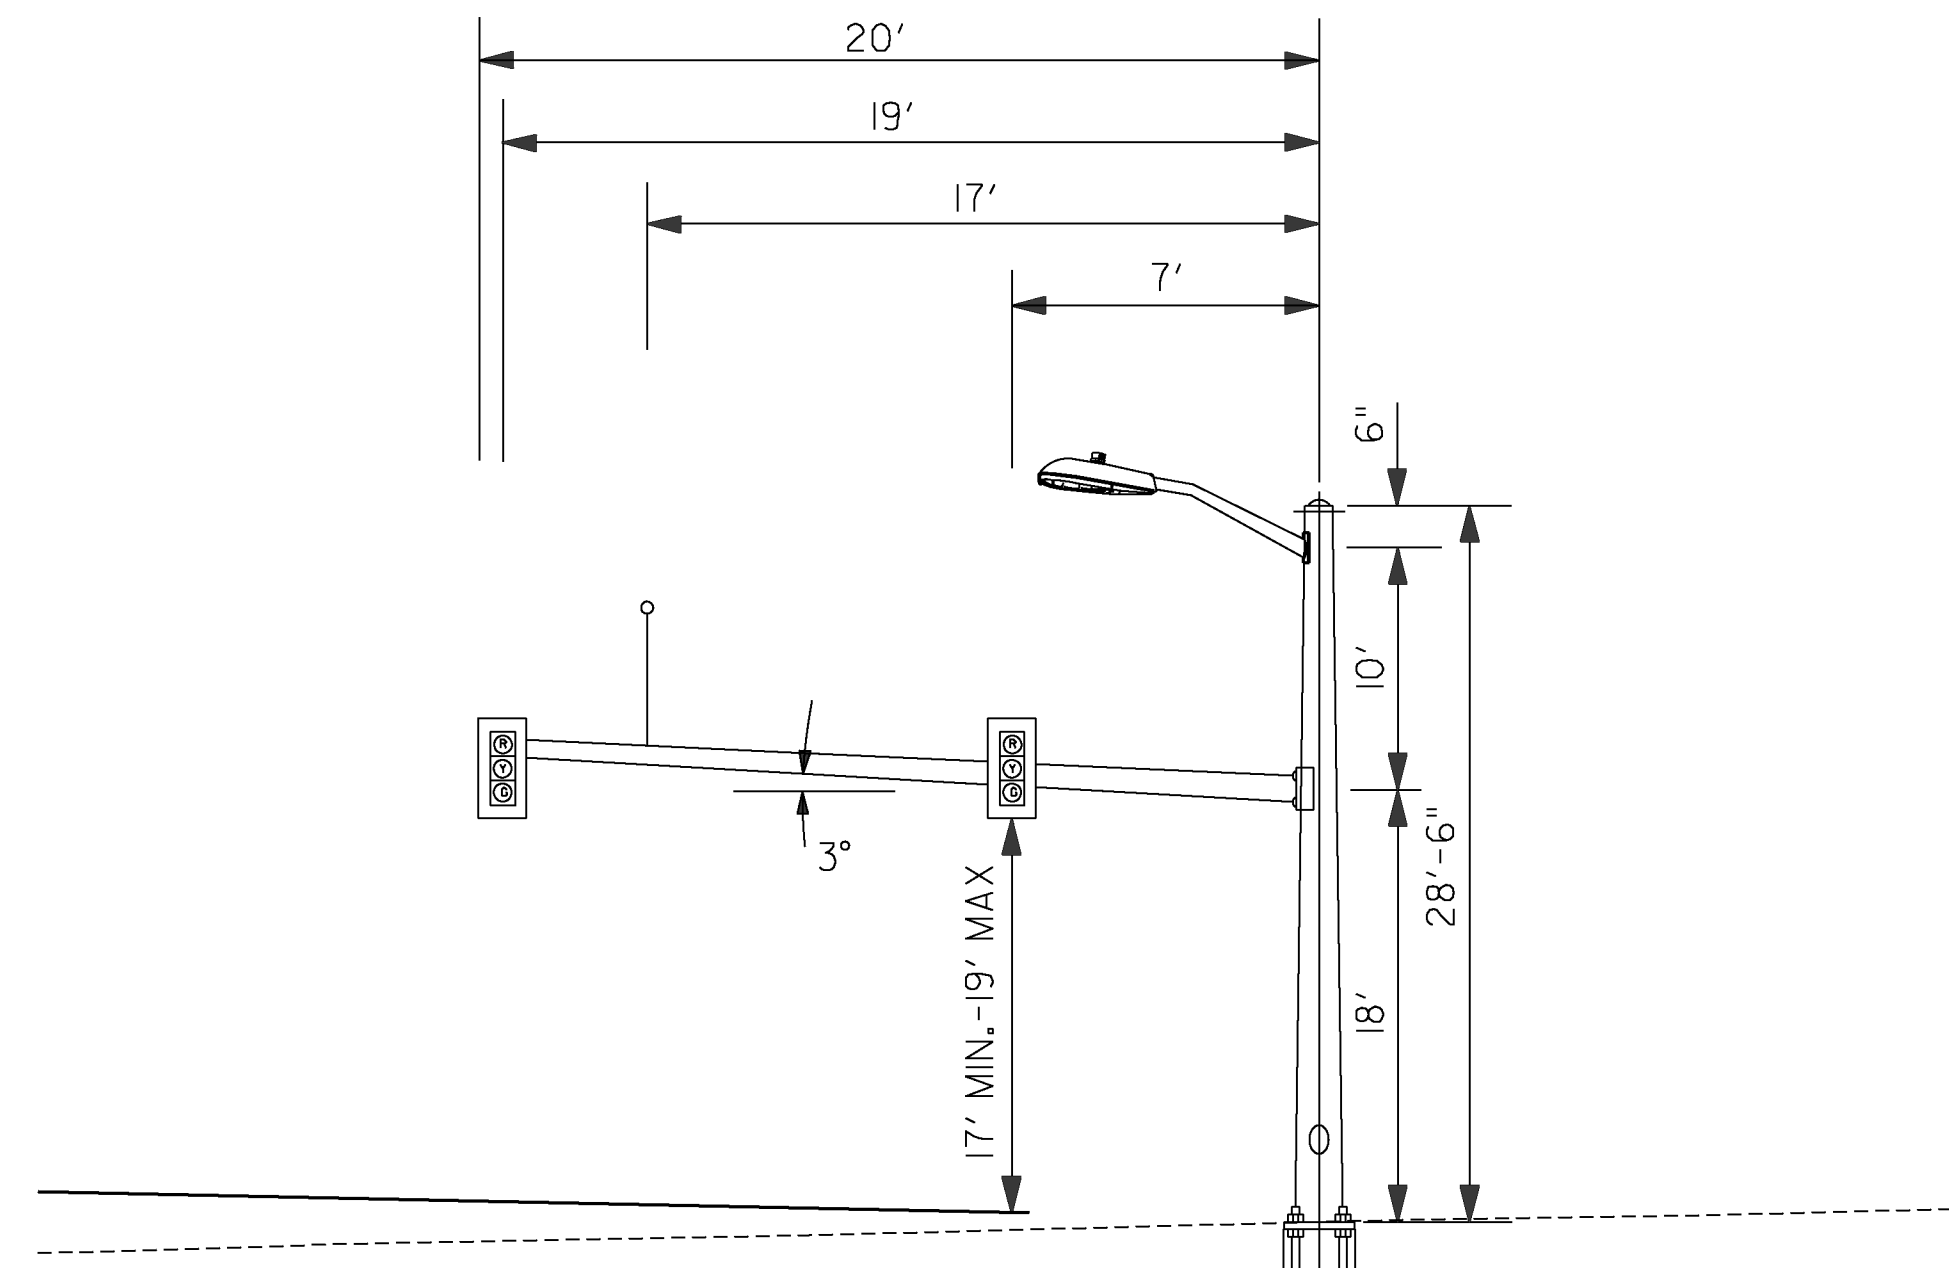


MP2A
N.T.S.

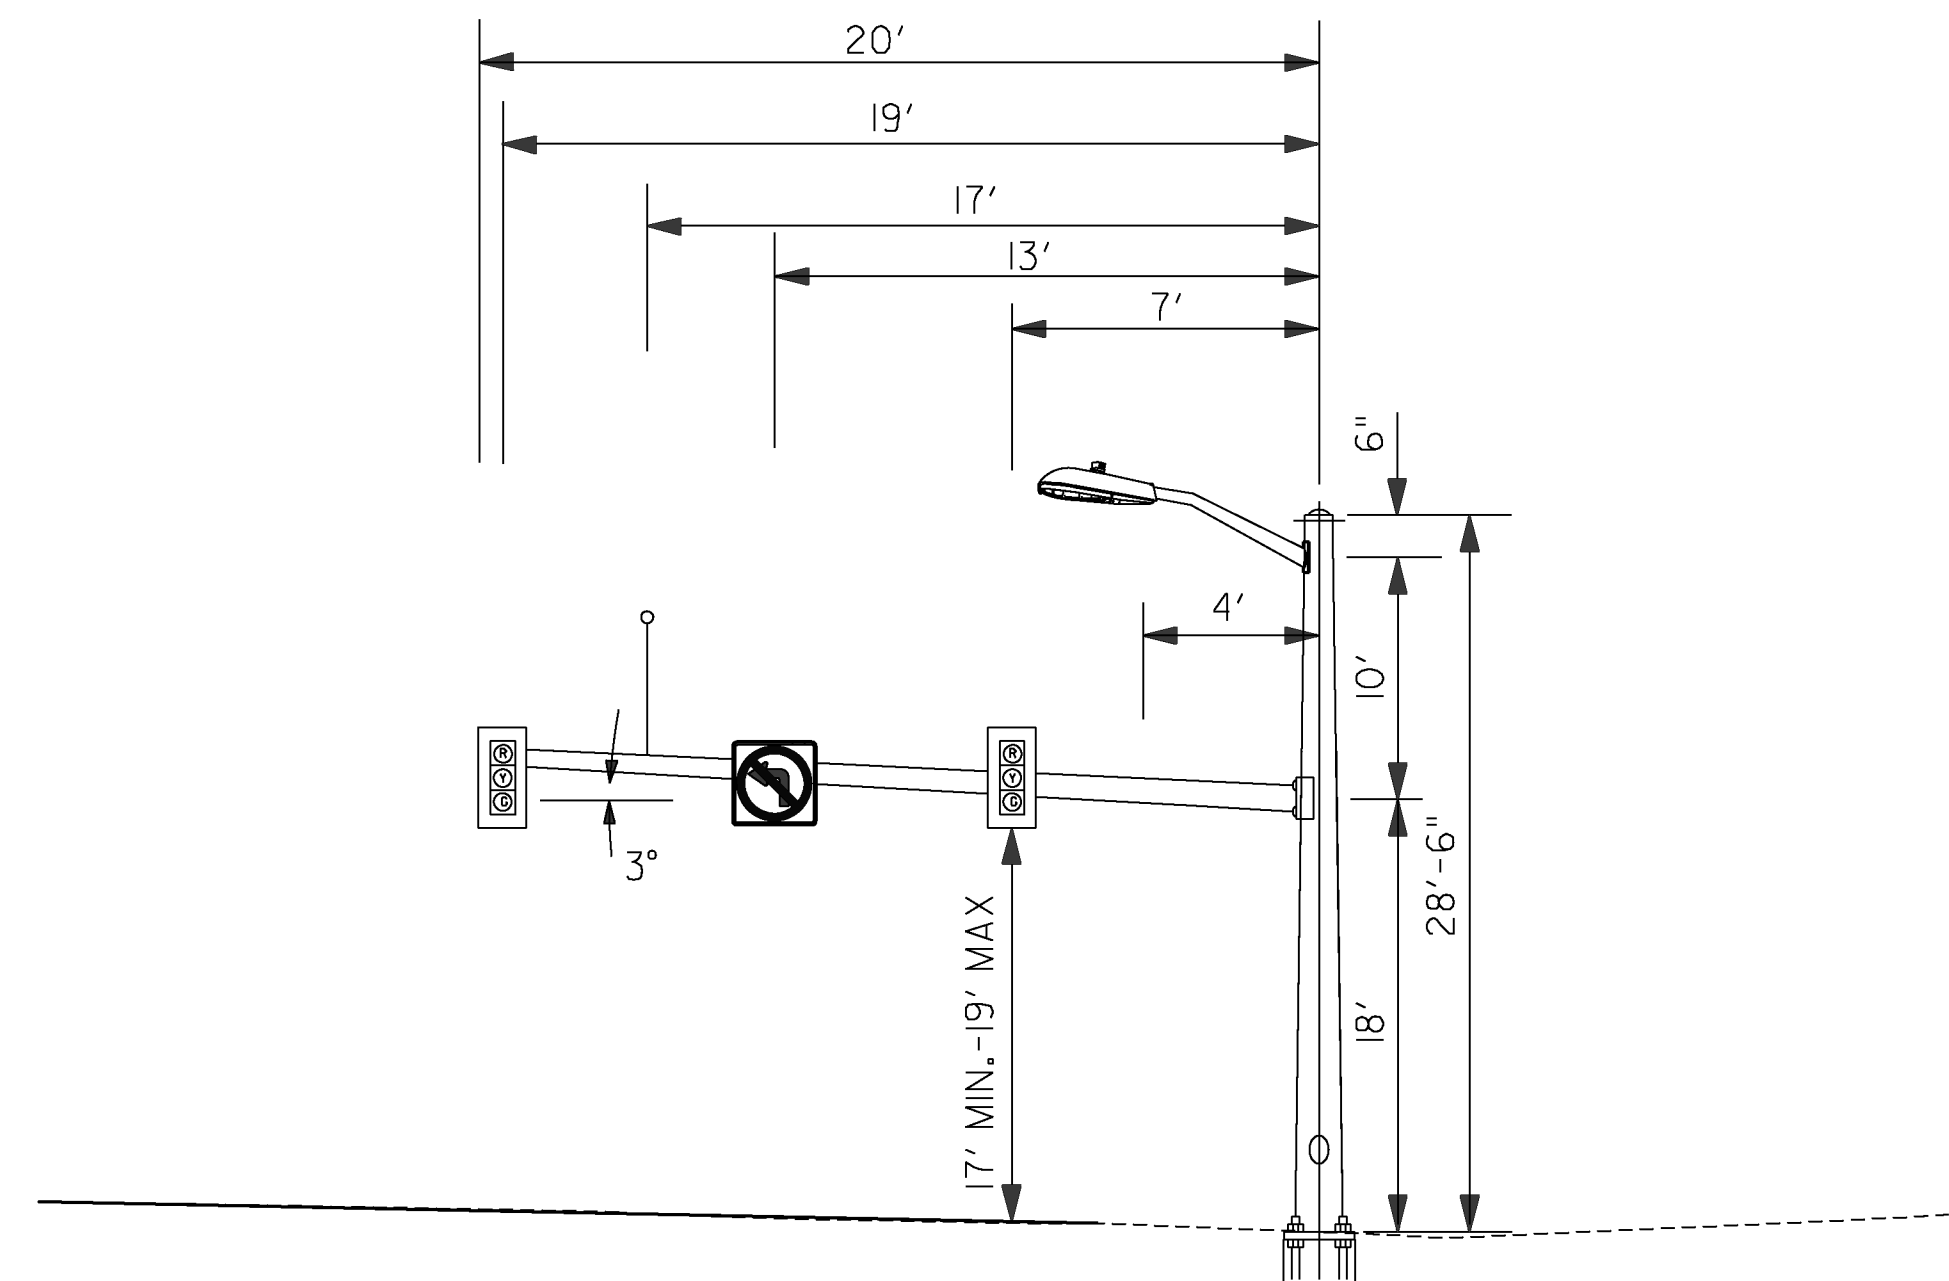

MP2B
N.T.S.

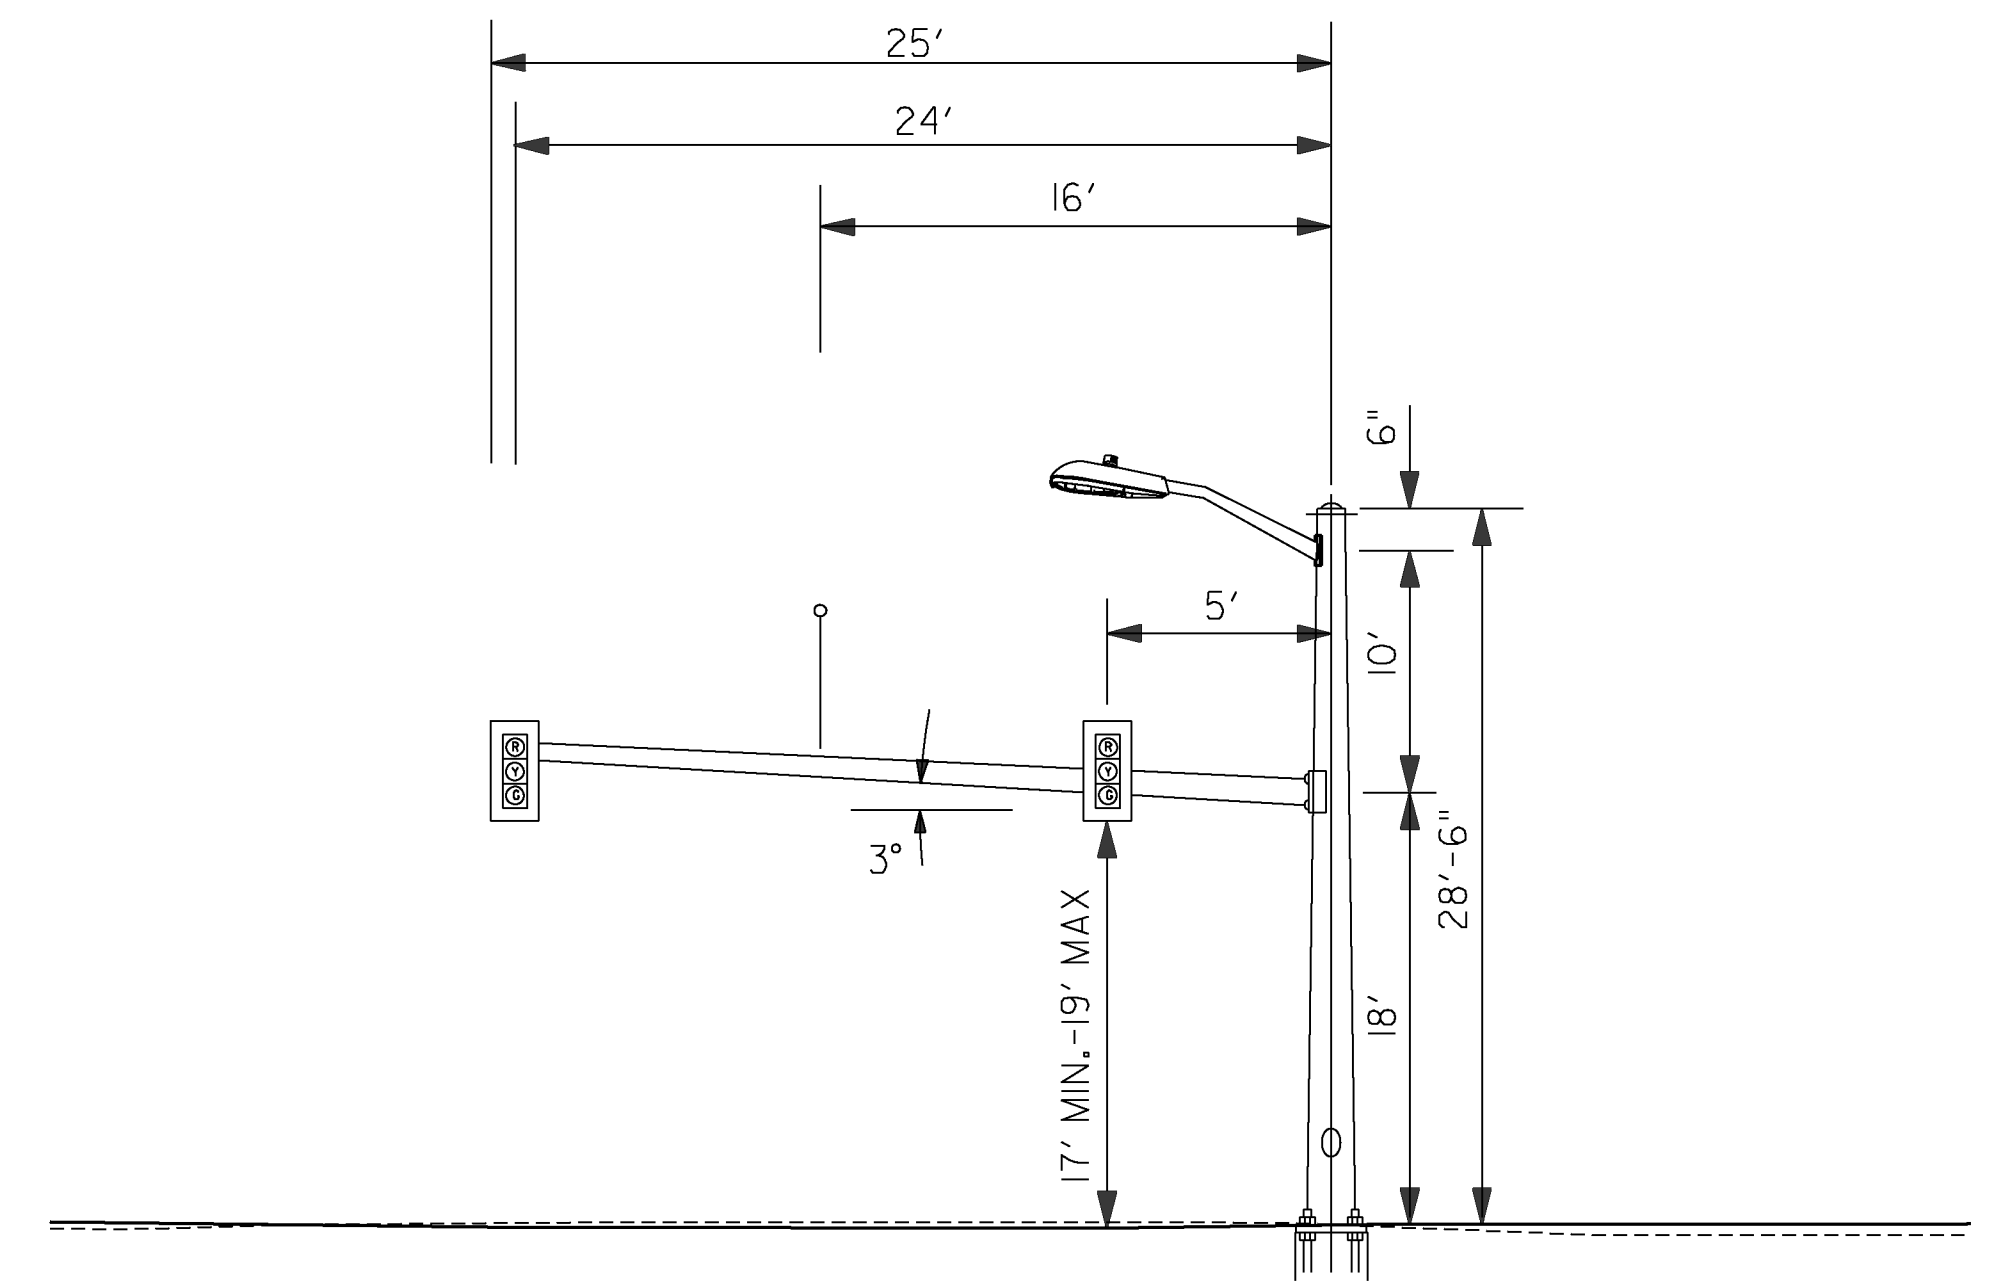

MP2C
N.T.S.

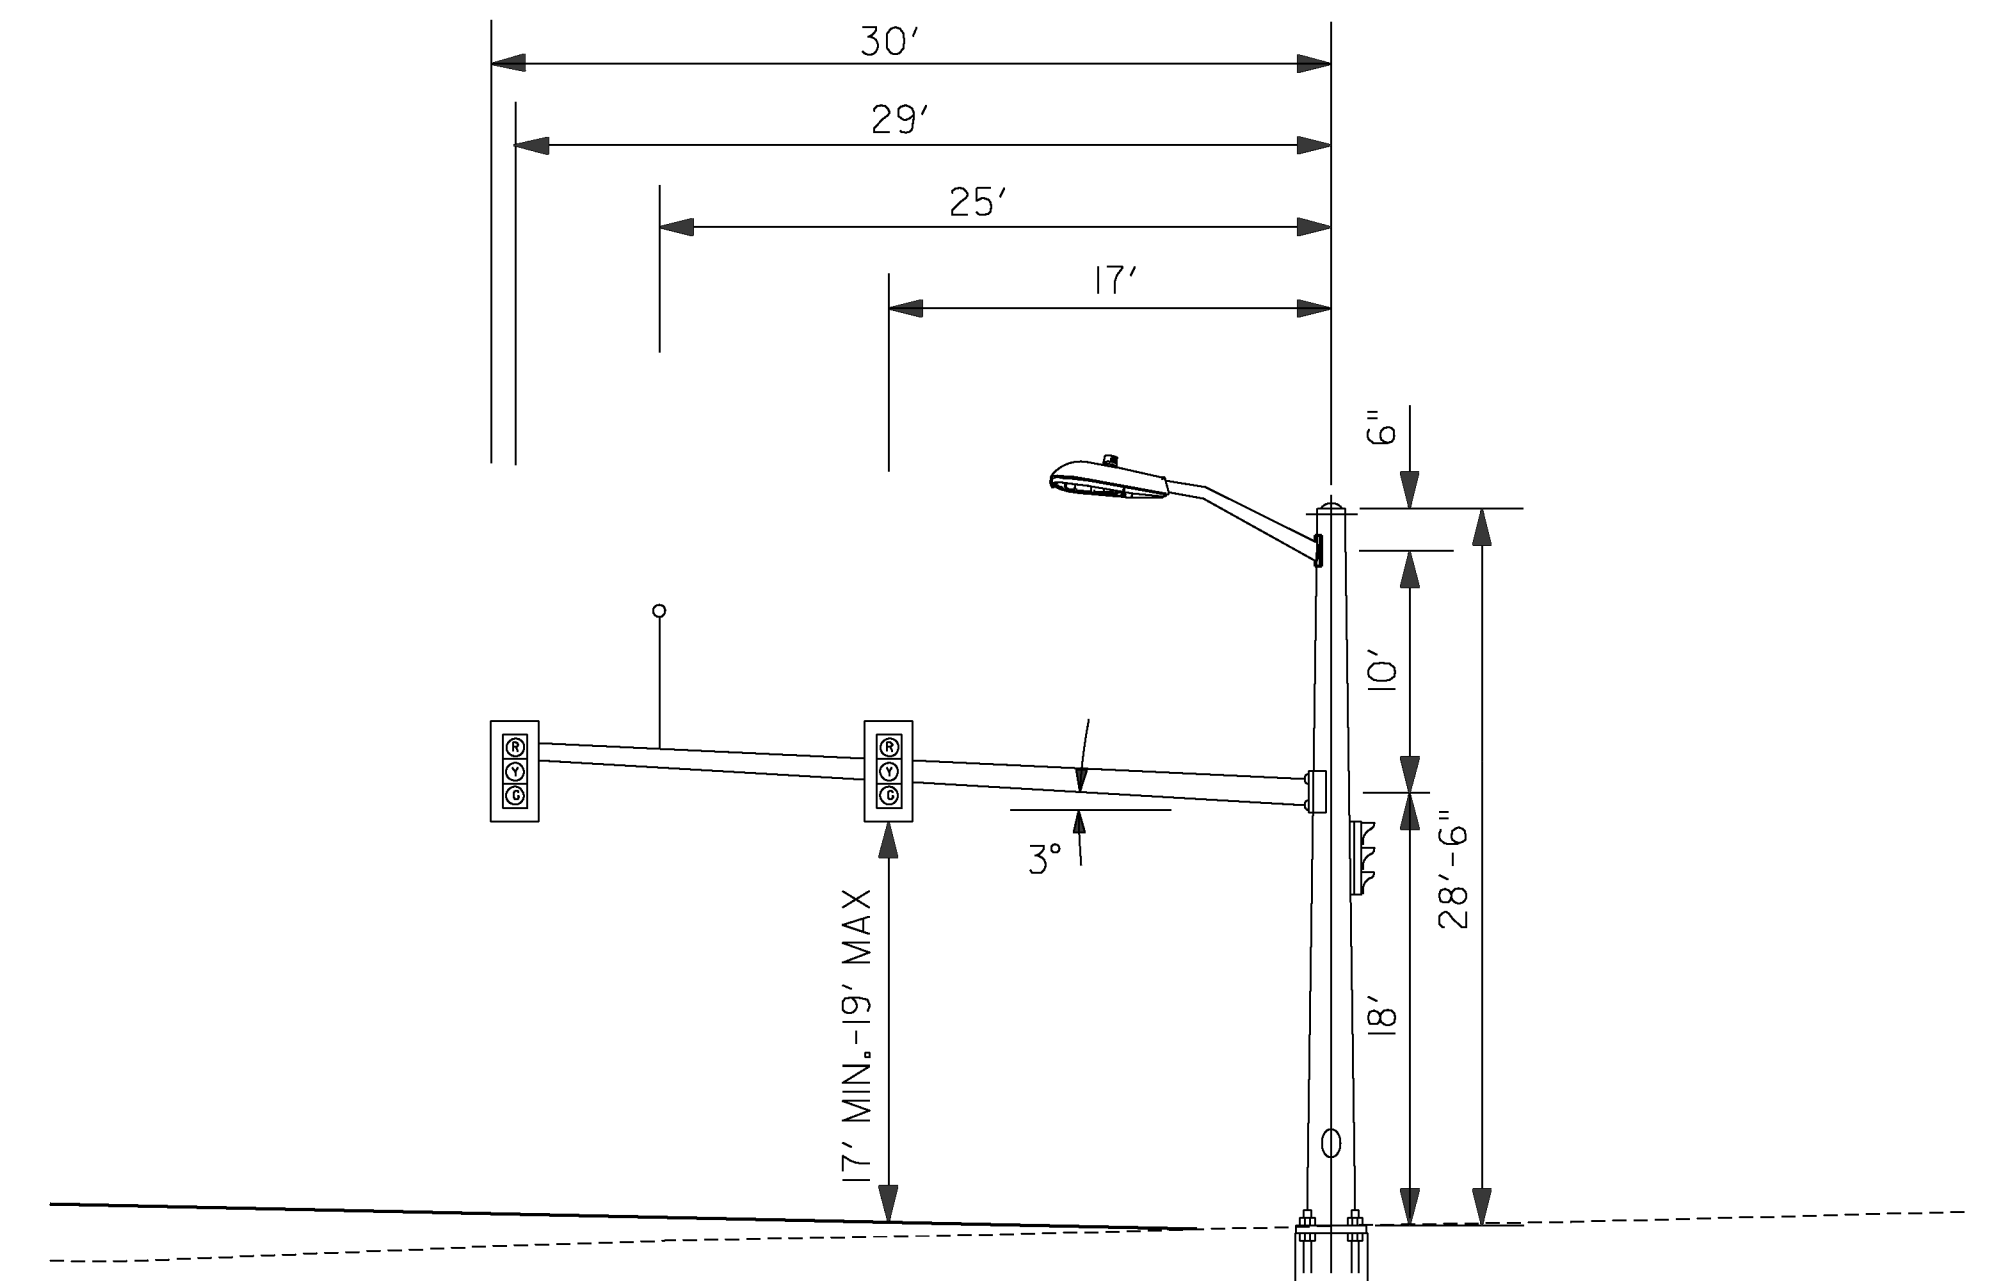

MP2D
N.T.S.

PROJECT NAME: RICHMOND
PROJECT NUMBER: STP 0284 (I7)

FILE NAME: z97cl86trfbd2.dgn
PROJECT LEADER: JEFFREY MAXTUTIS
DESIGNED BY: J.SOBEL
TRAFFIC SIGNAL DETAIL SHEET 3

PLOT DATE: 5/2/2013
DRAWN BY: Y.CAO/LALMY
CHECKED BY: D.FLYNN
SHEET 73 OF 133