




19+50

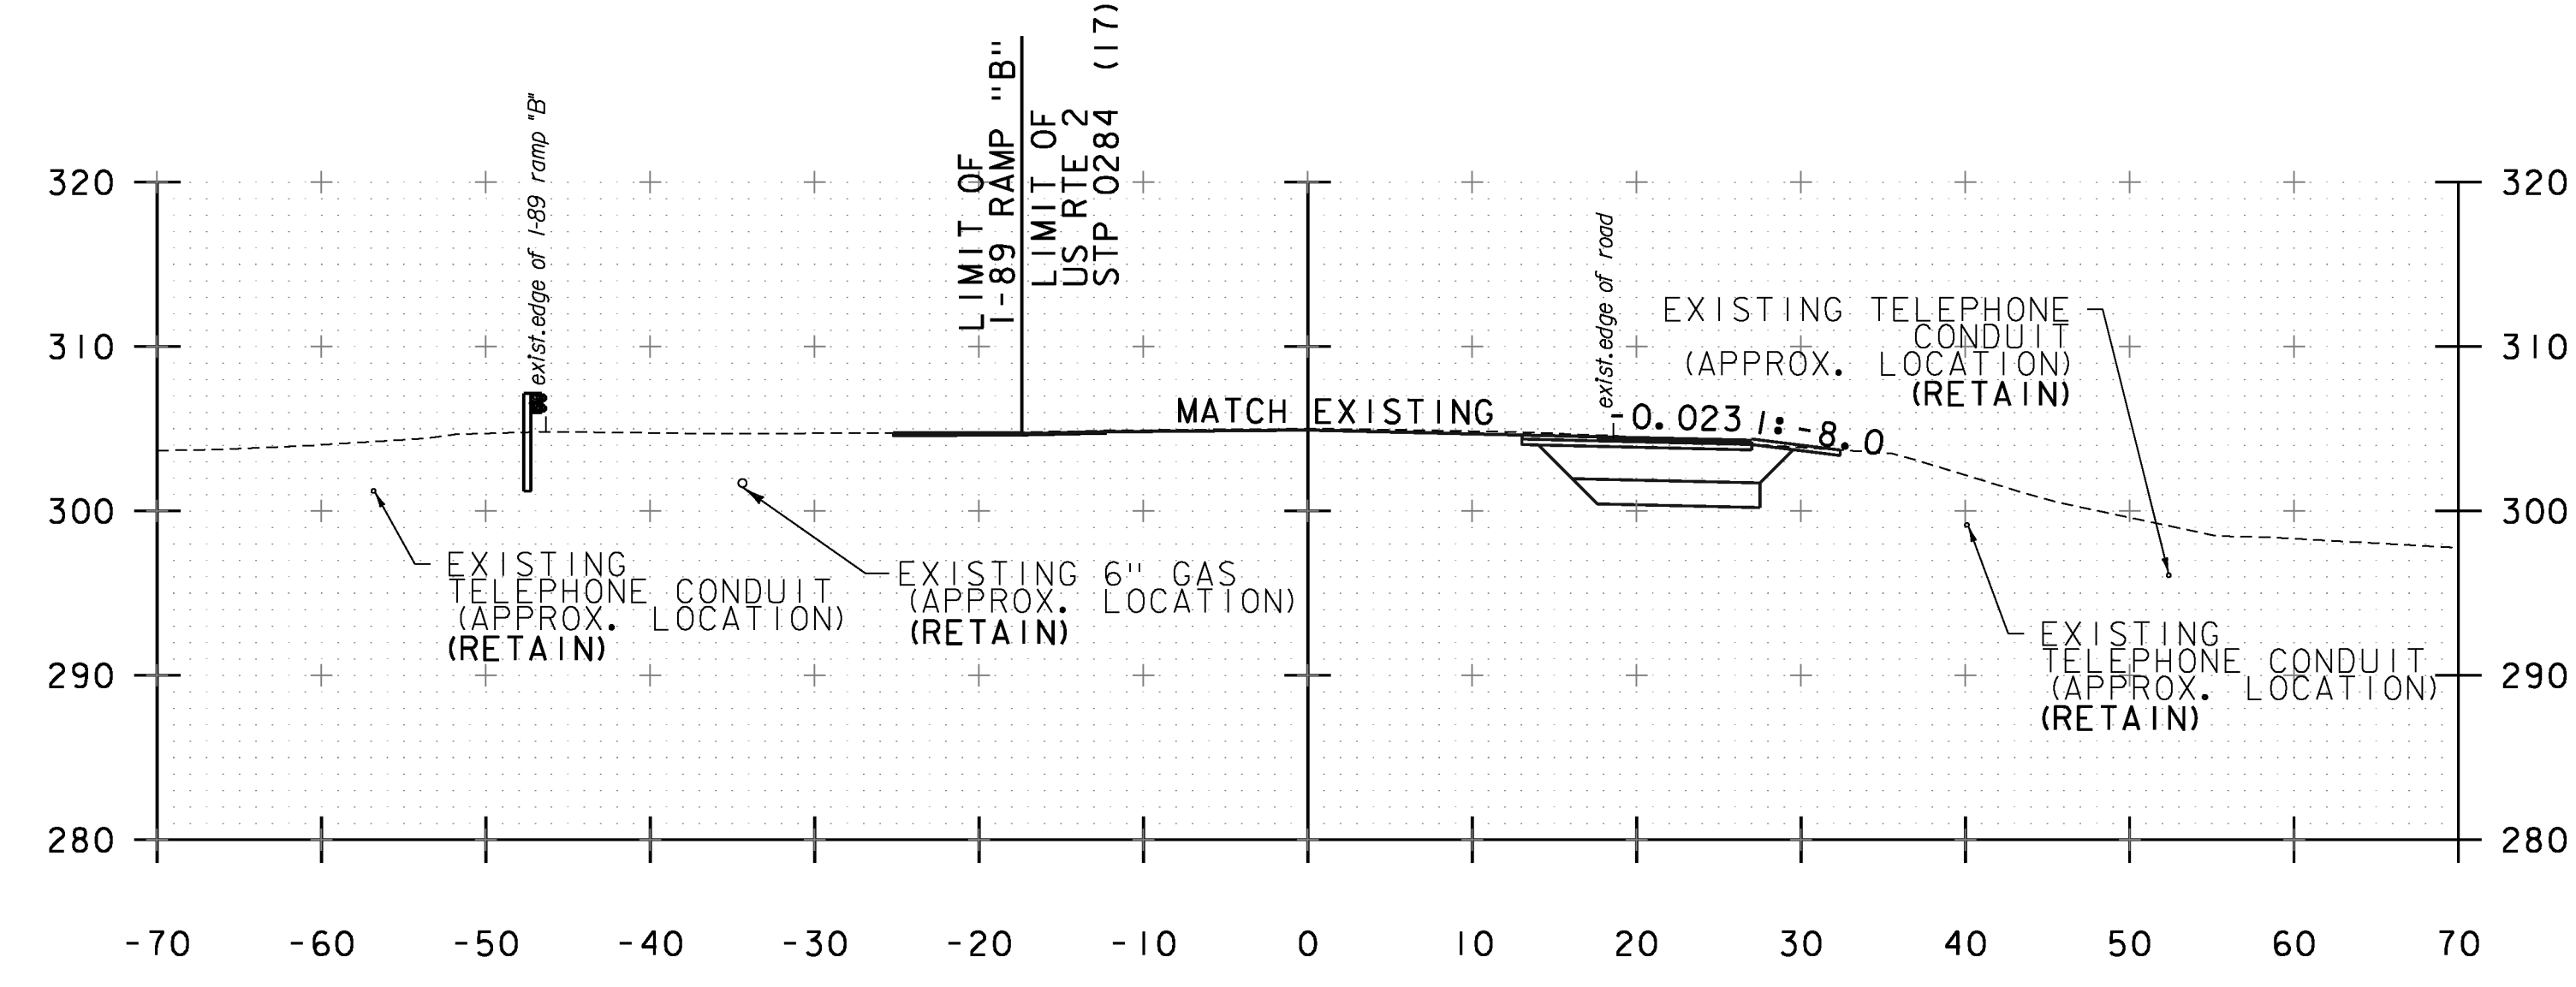


21+00

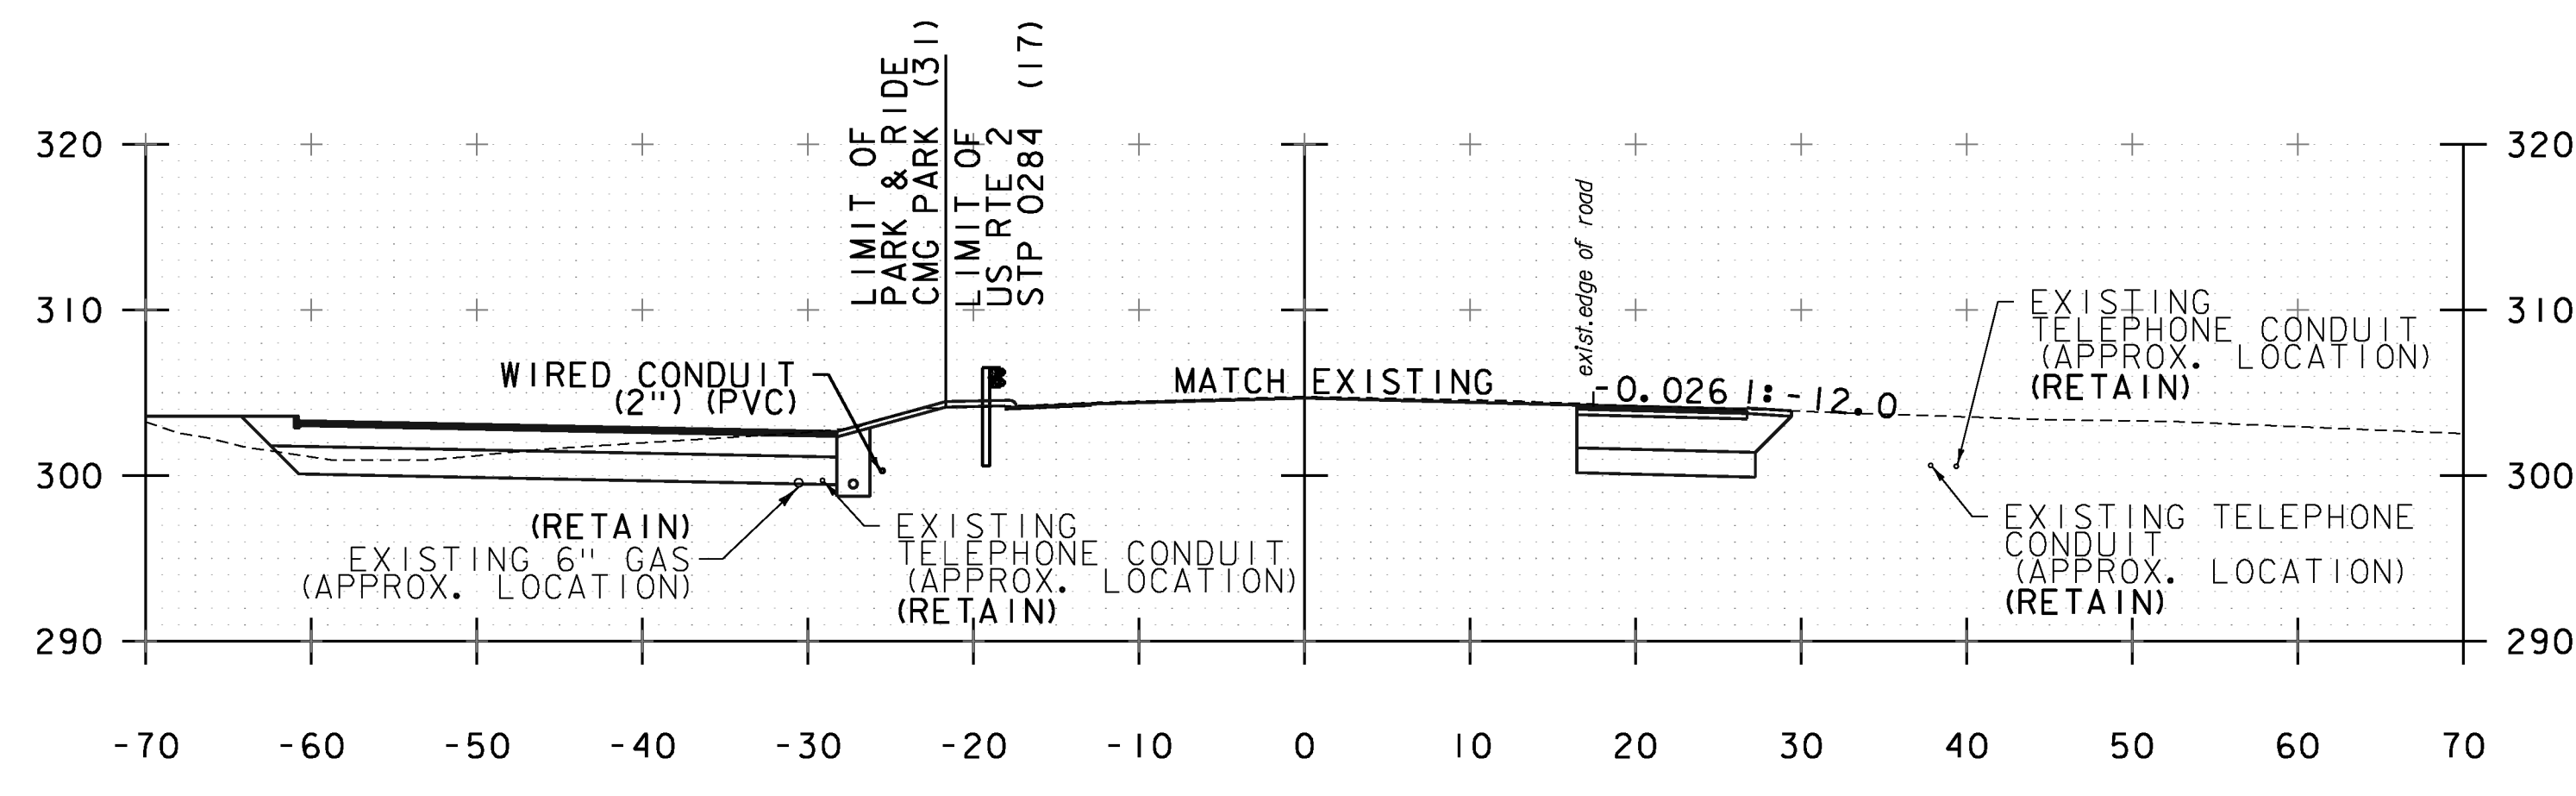


19+00

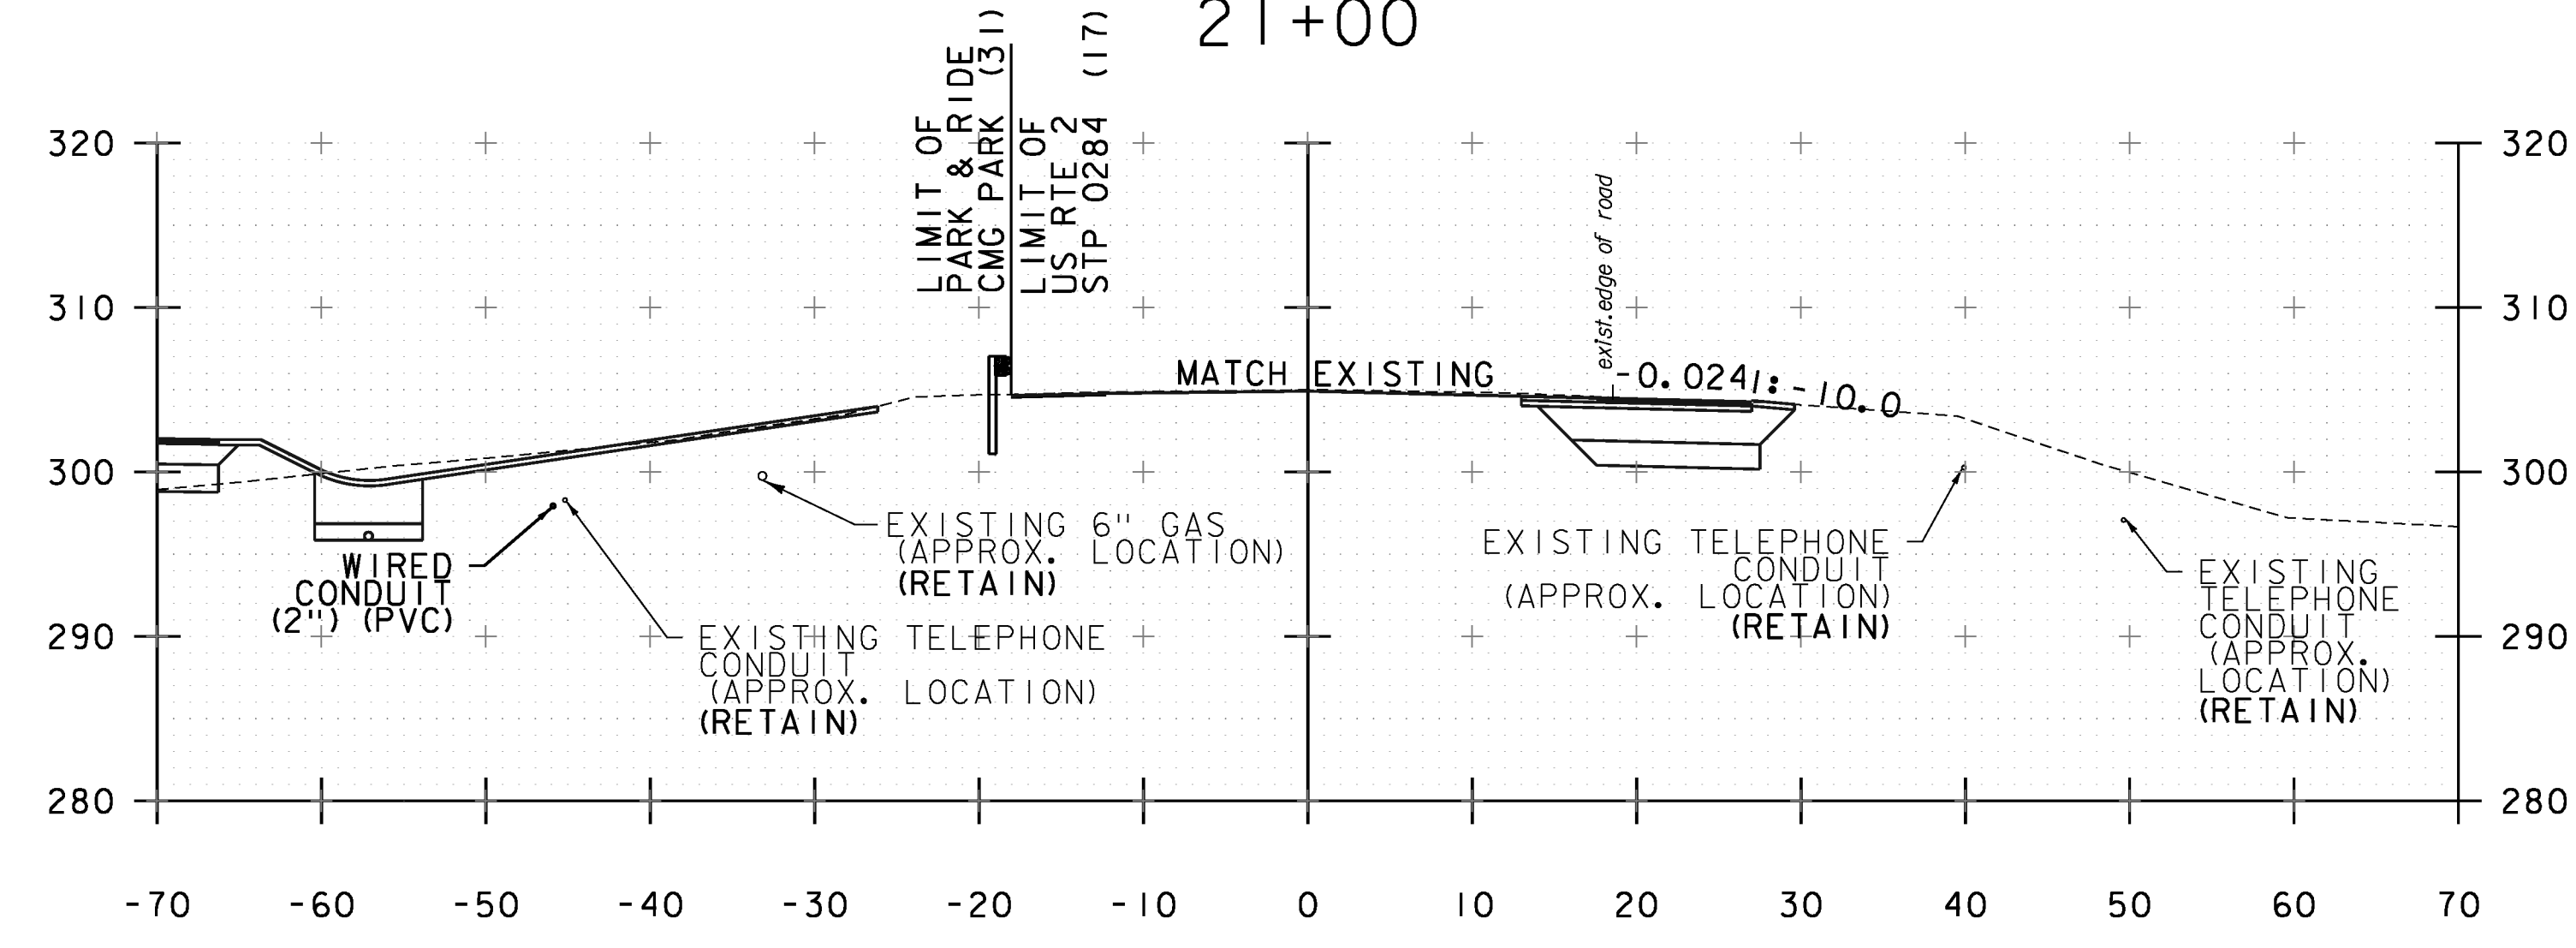

20+50

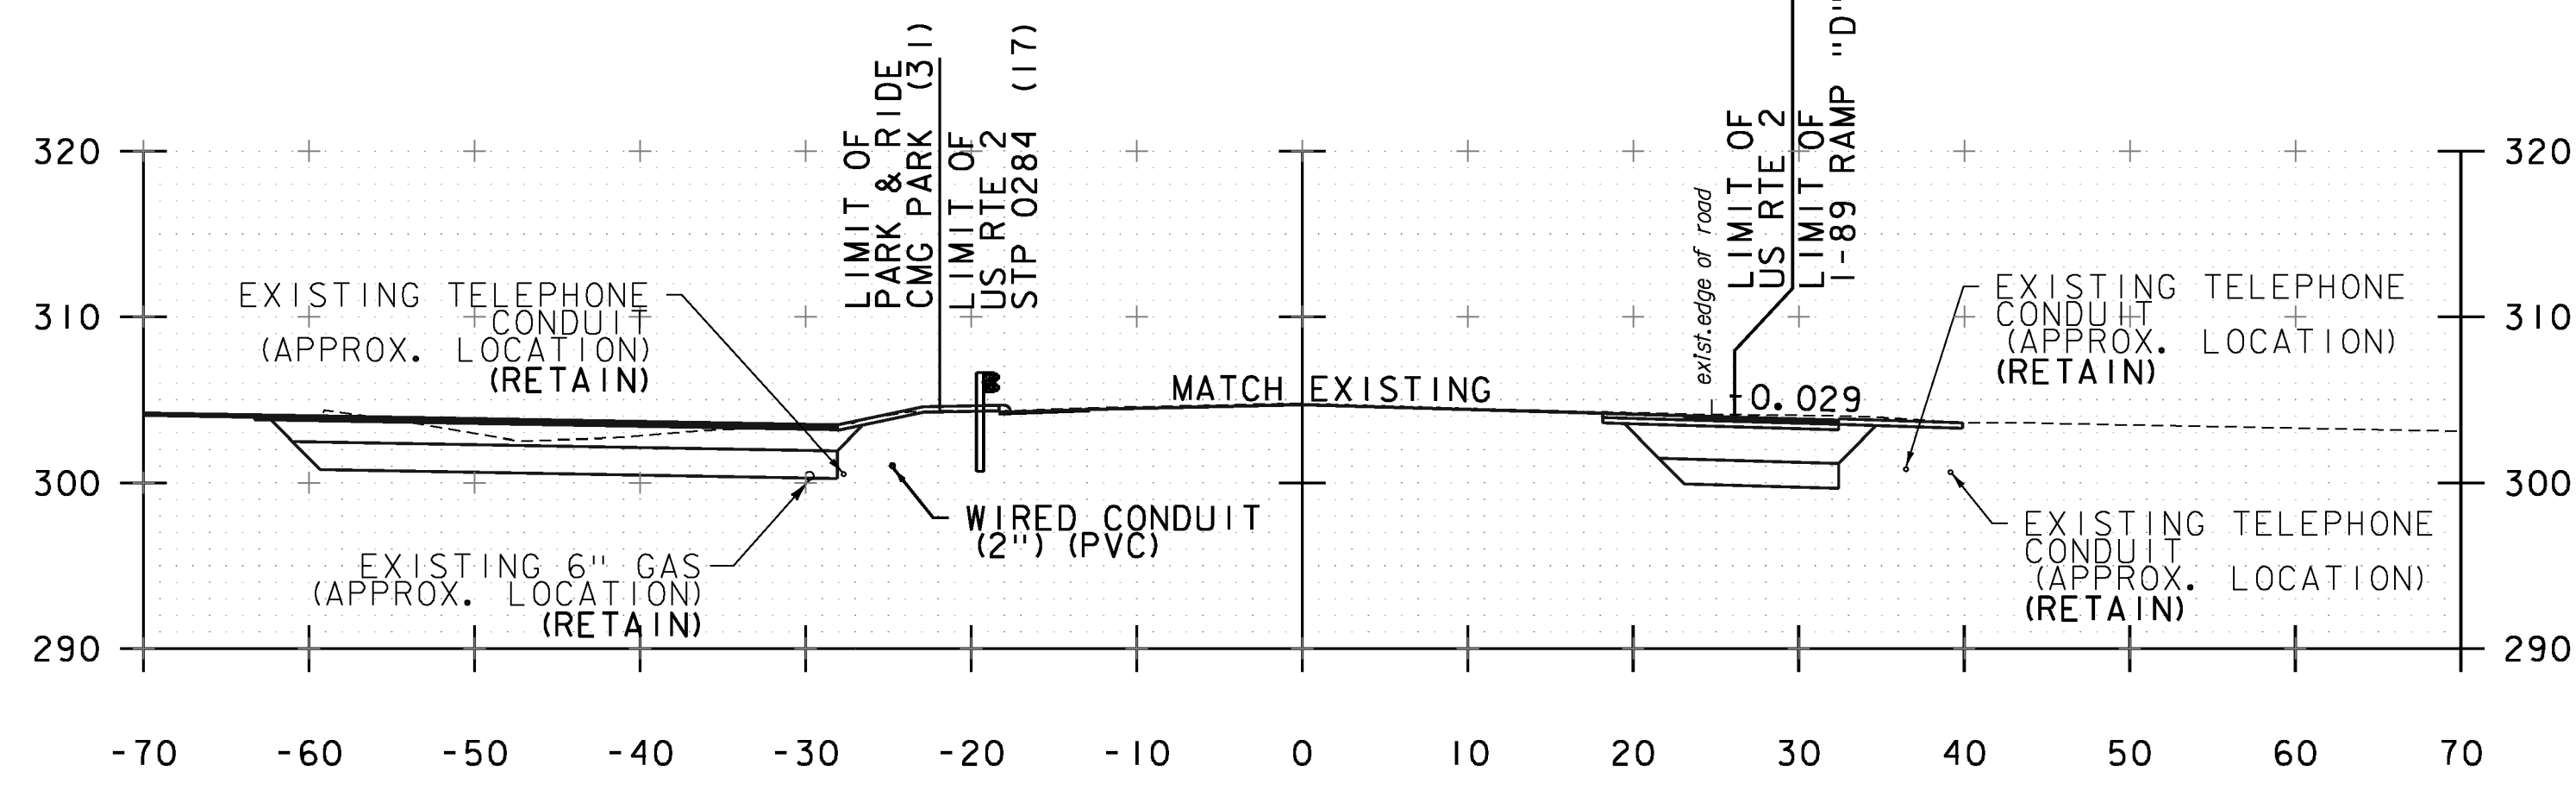

18+50

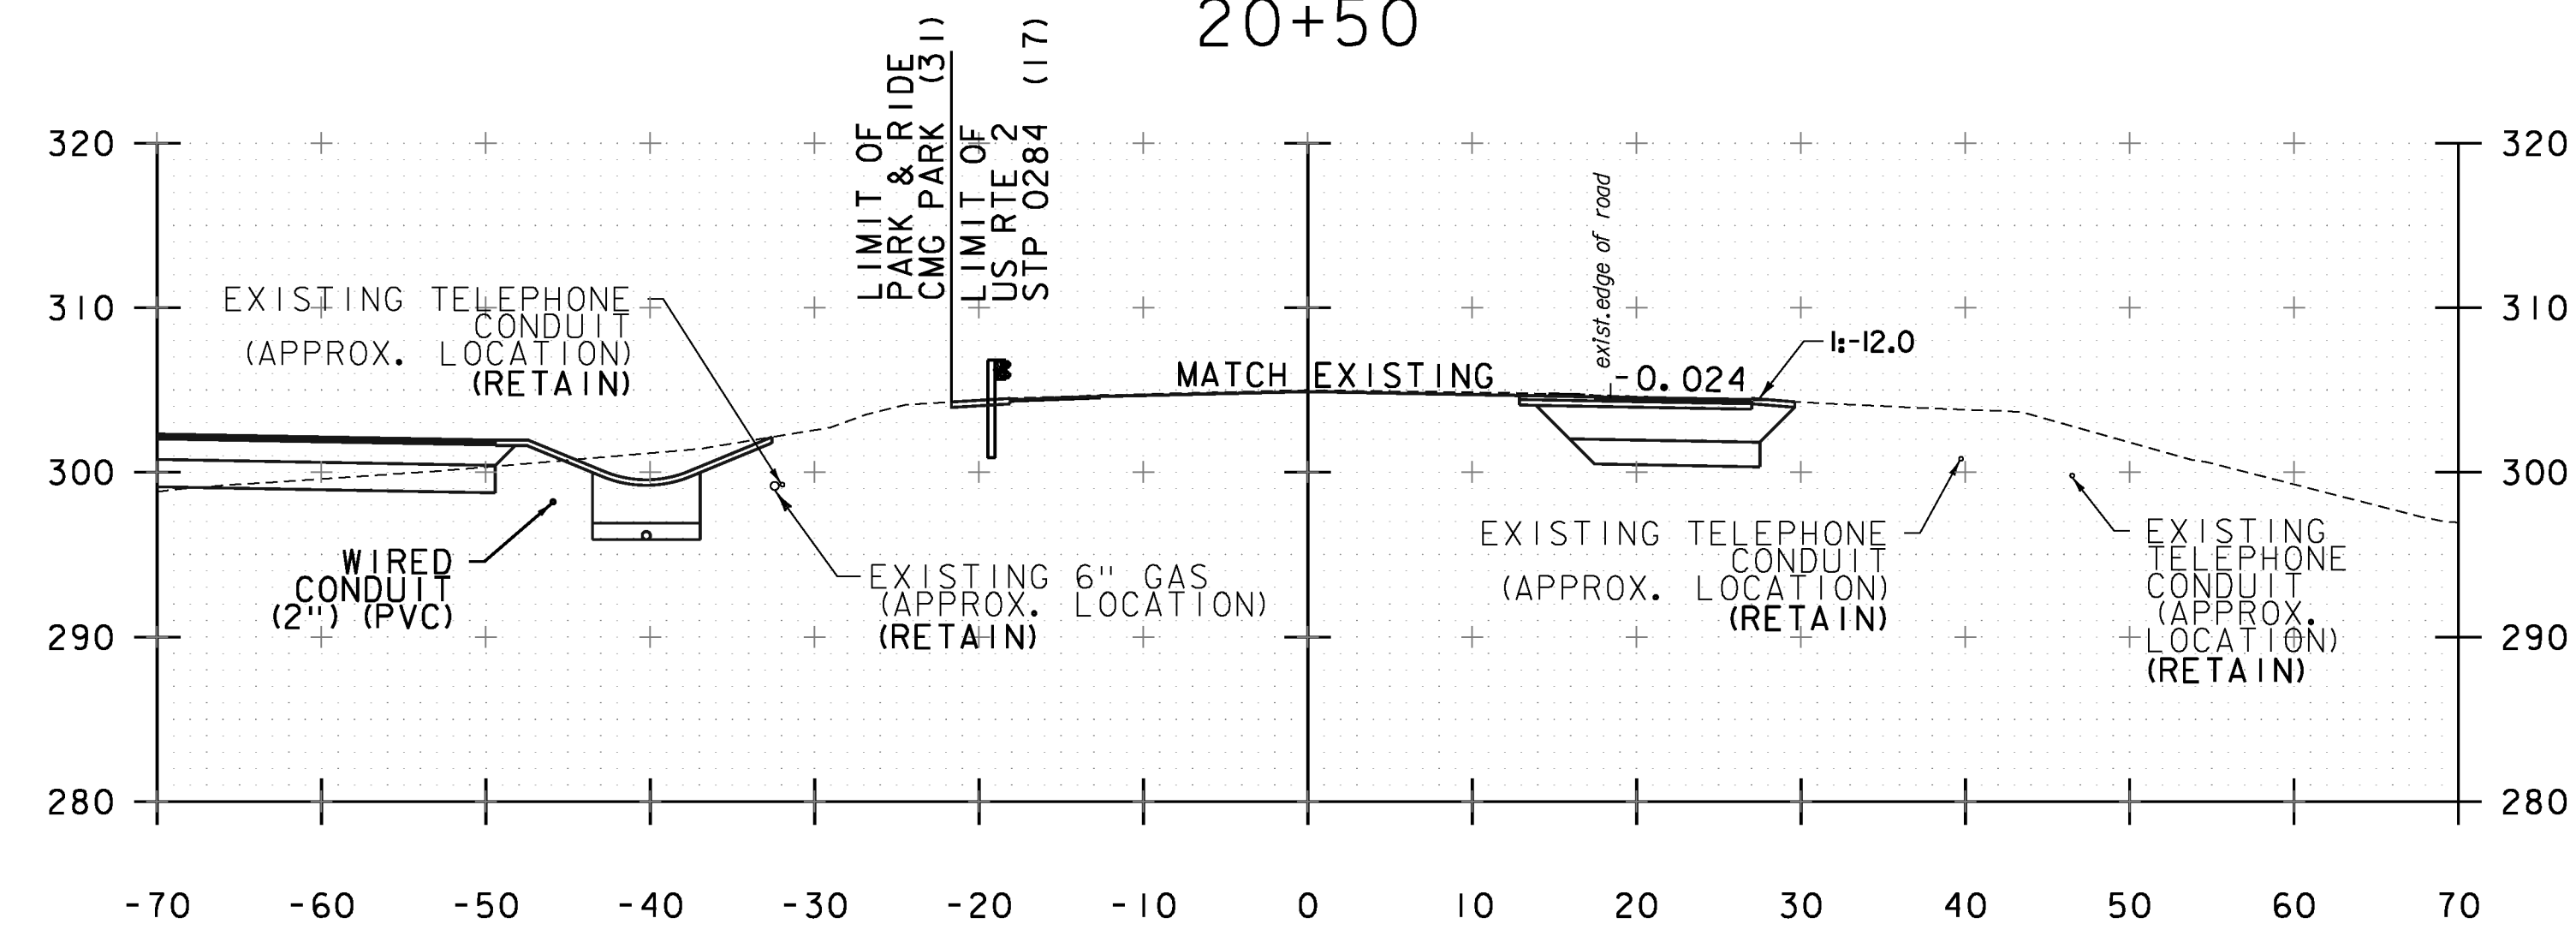

20+00

NOTE: REFER TO SHEET 90 OF 133 FOR CROSS SECTIONS AT THE PROPOSED MAST ARM POLES.

STA. 18+50 TO STA. 21+00

PROJECT NAME:	RICHMOND	PLOT DATE:	4/26/2013
PROJECT NUMBER:	STP 0284 (17)	DESIGNED BY:	T. BIGELOW
FILE NAME:	z97cl86xsl.dgn	CHECKED BY:	E. ATKINS
PROJECT LEADER:	ERIK ATKINS	SHEET	87 OF 133
US ROUTE 2 CROSS SECTIONS SHEET 7			