




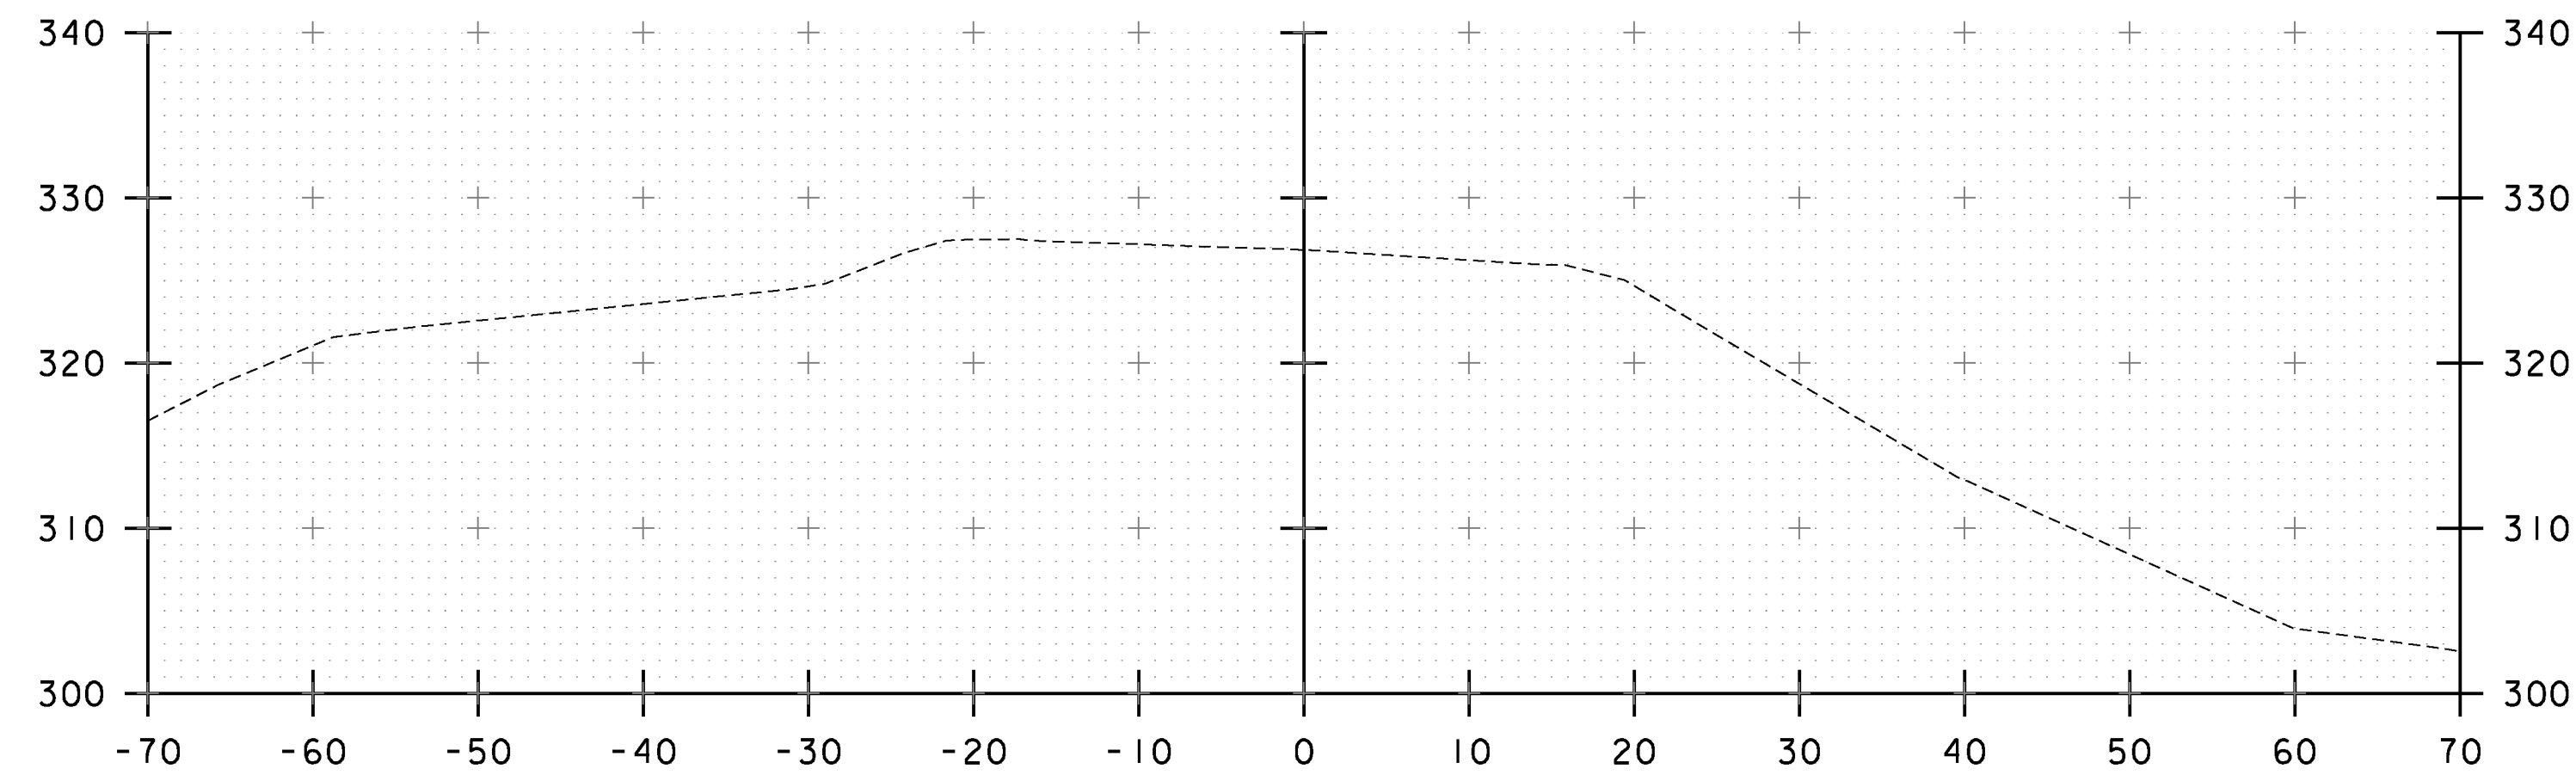


VT 117 STA. 31+50

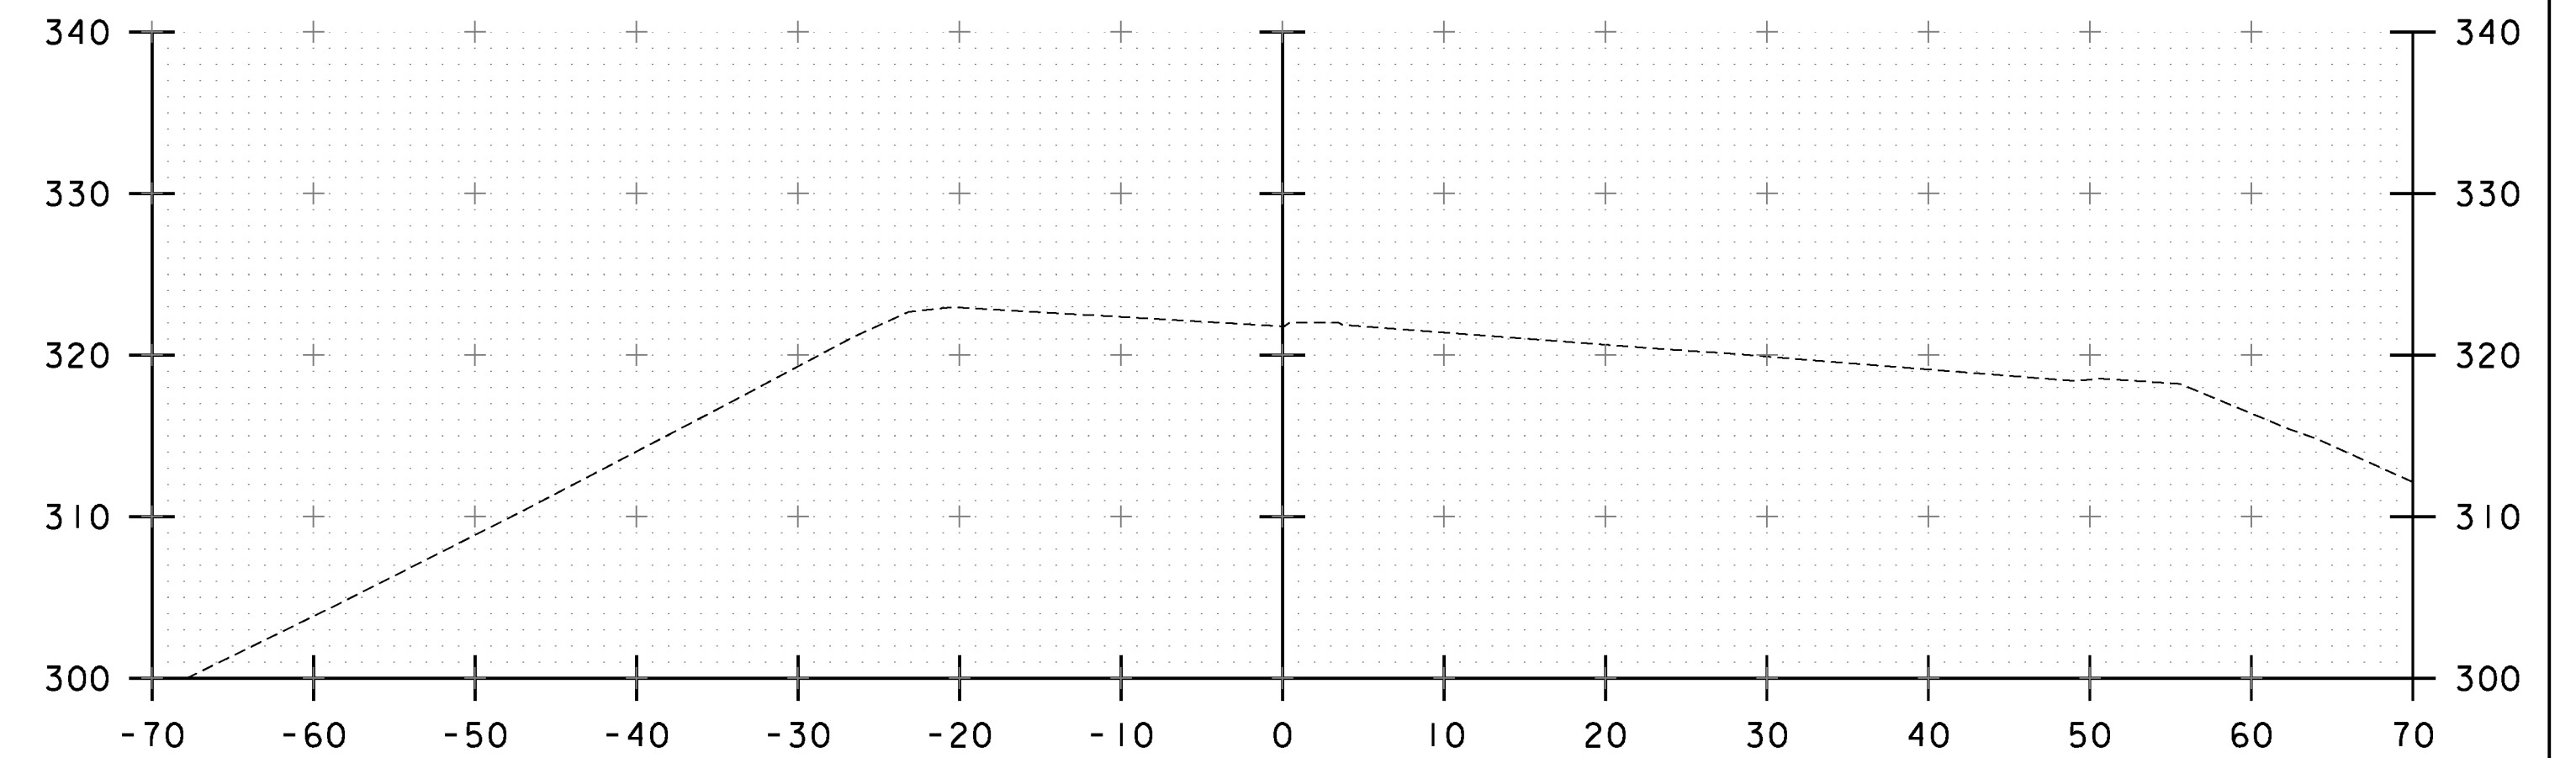


I-89 RAMP "A" STA. 36+50

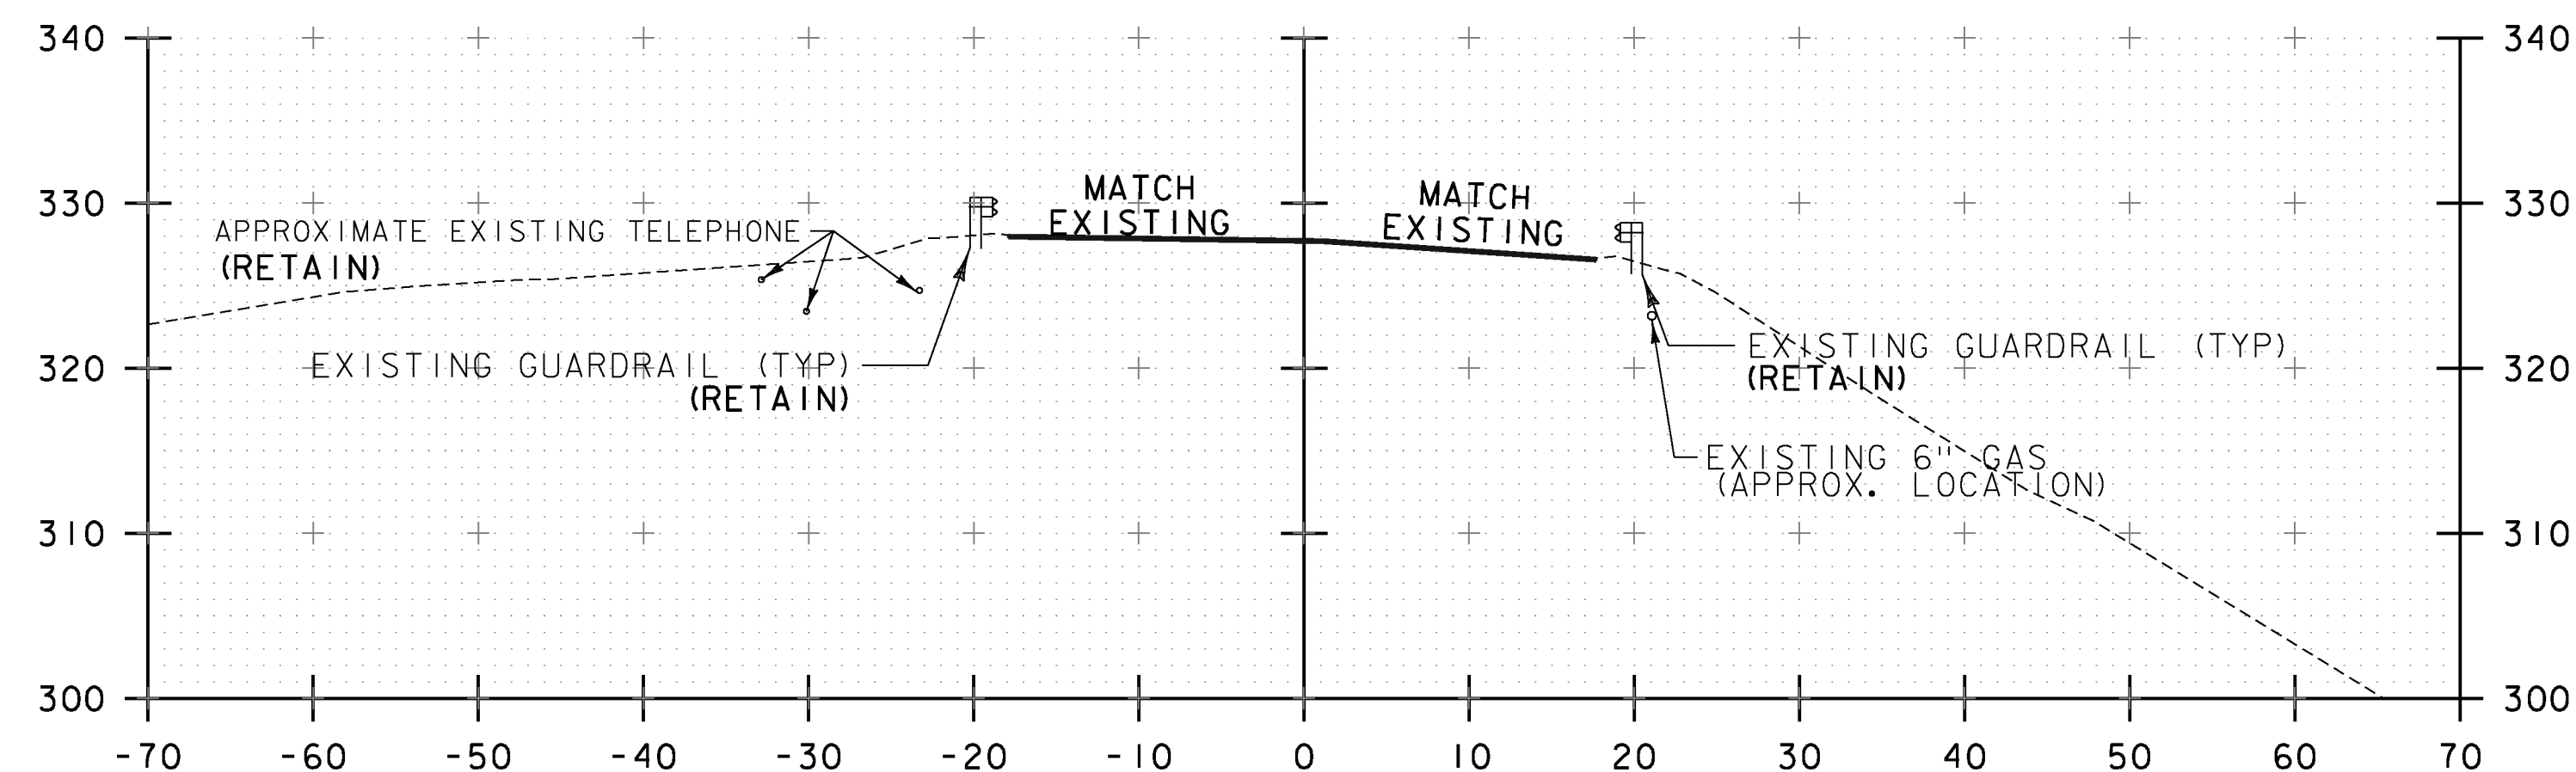


VT 117 STA. 31+00
MATCH EXISTING BCP

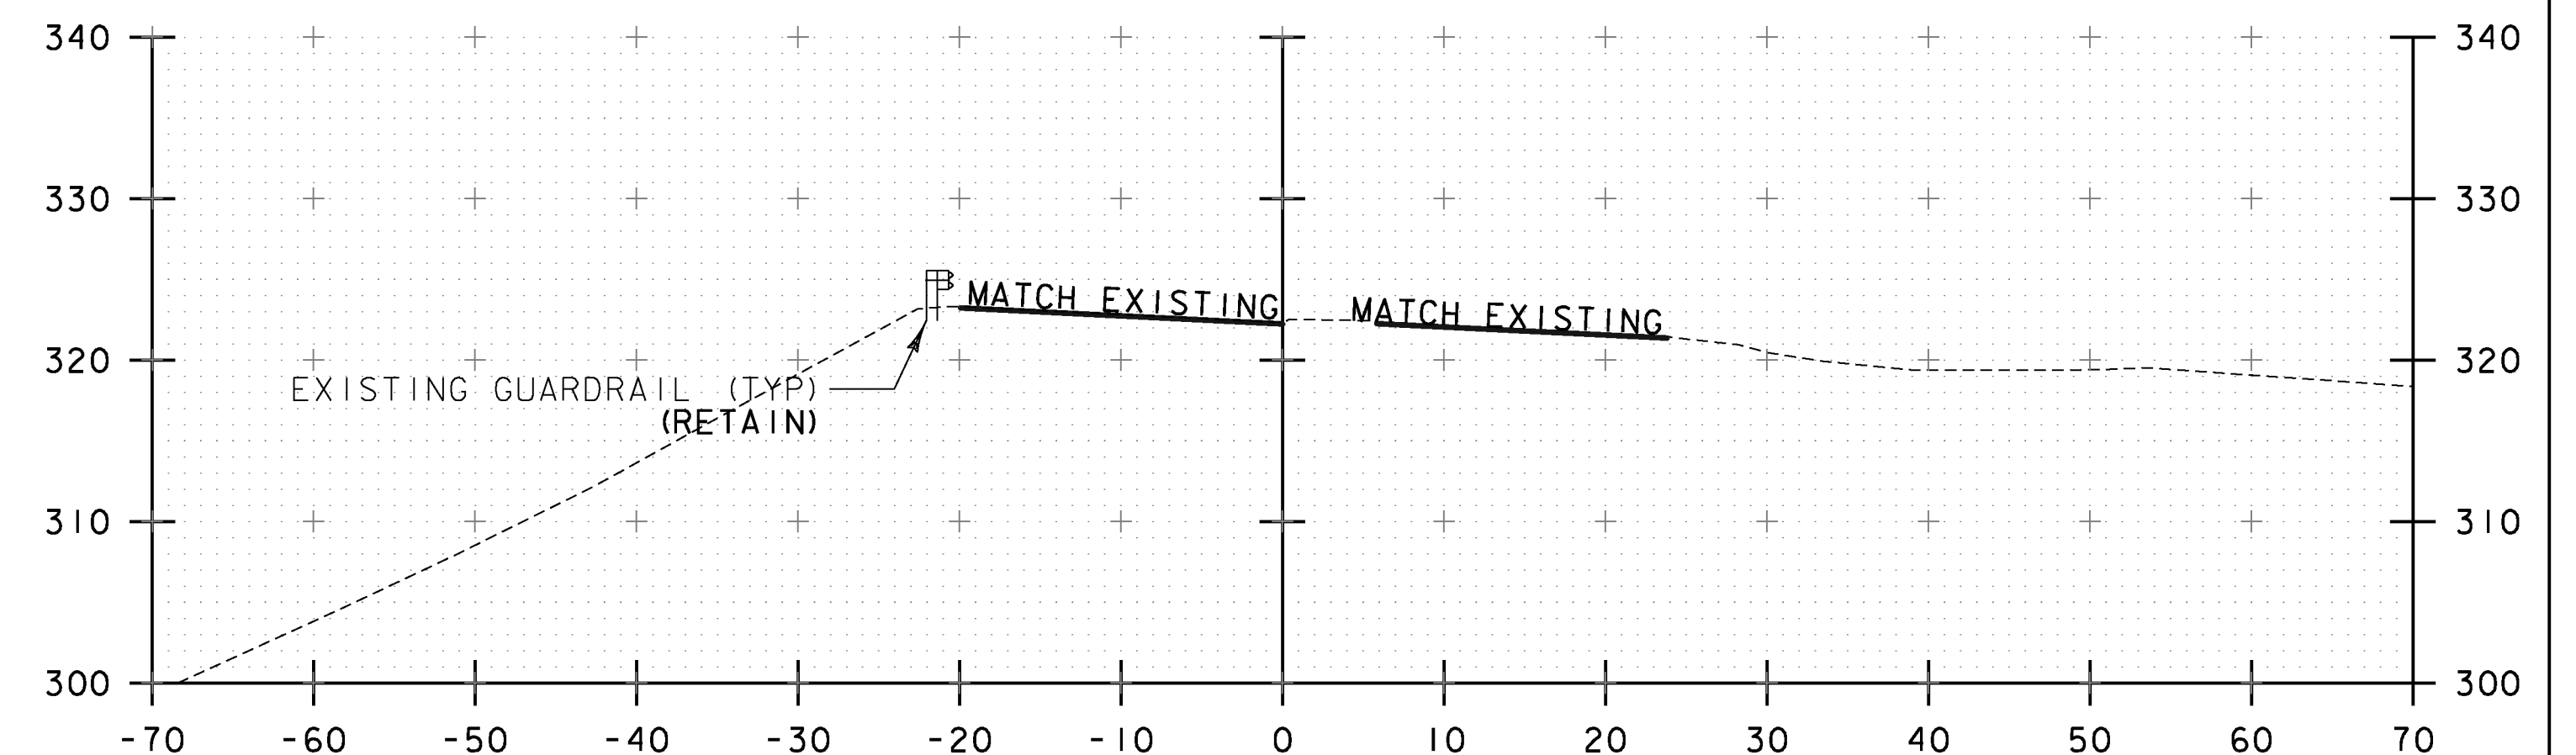

I-89 RAMP "A" STA. 36+00
MATCH EXISTING BCP

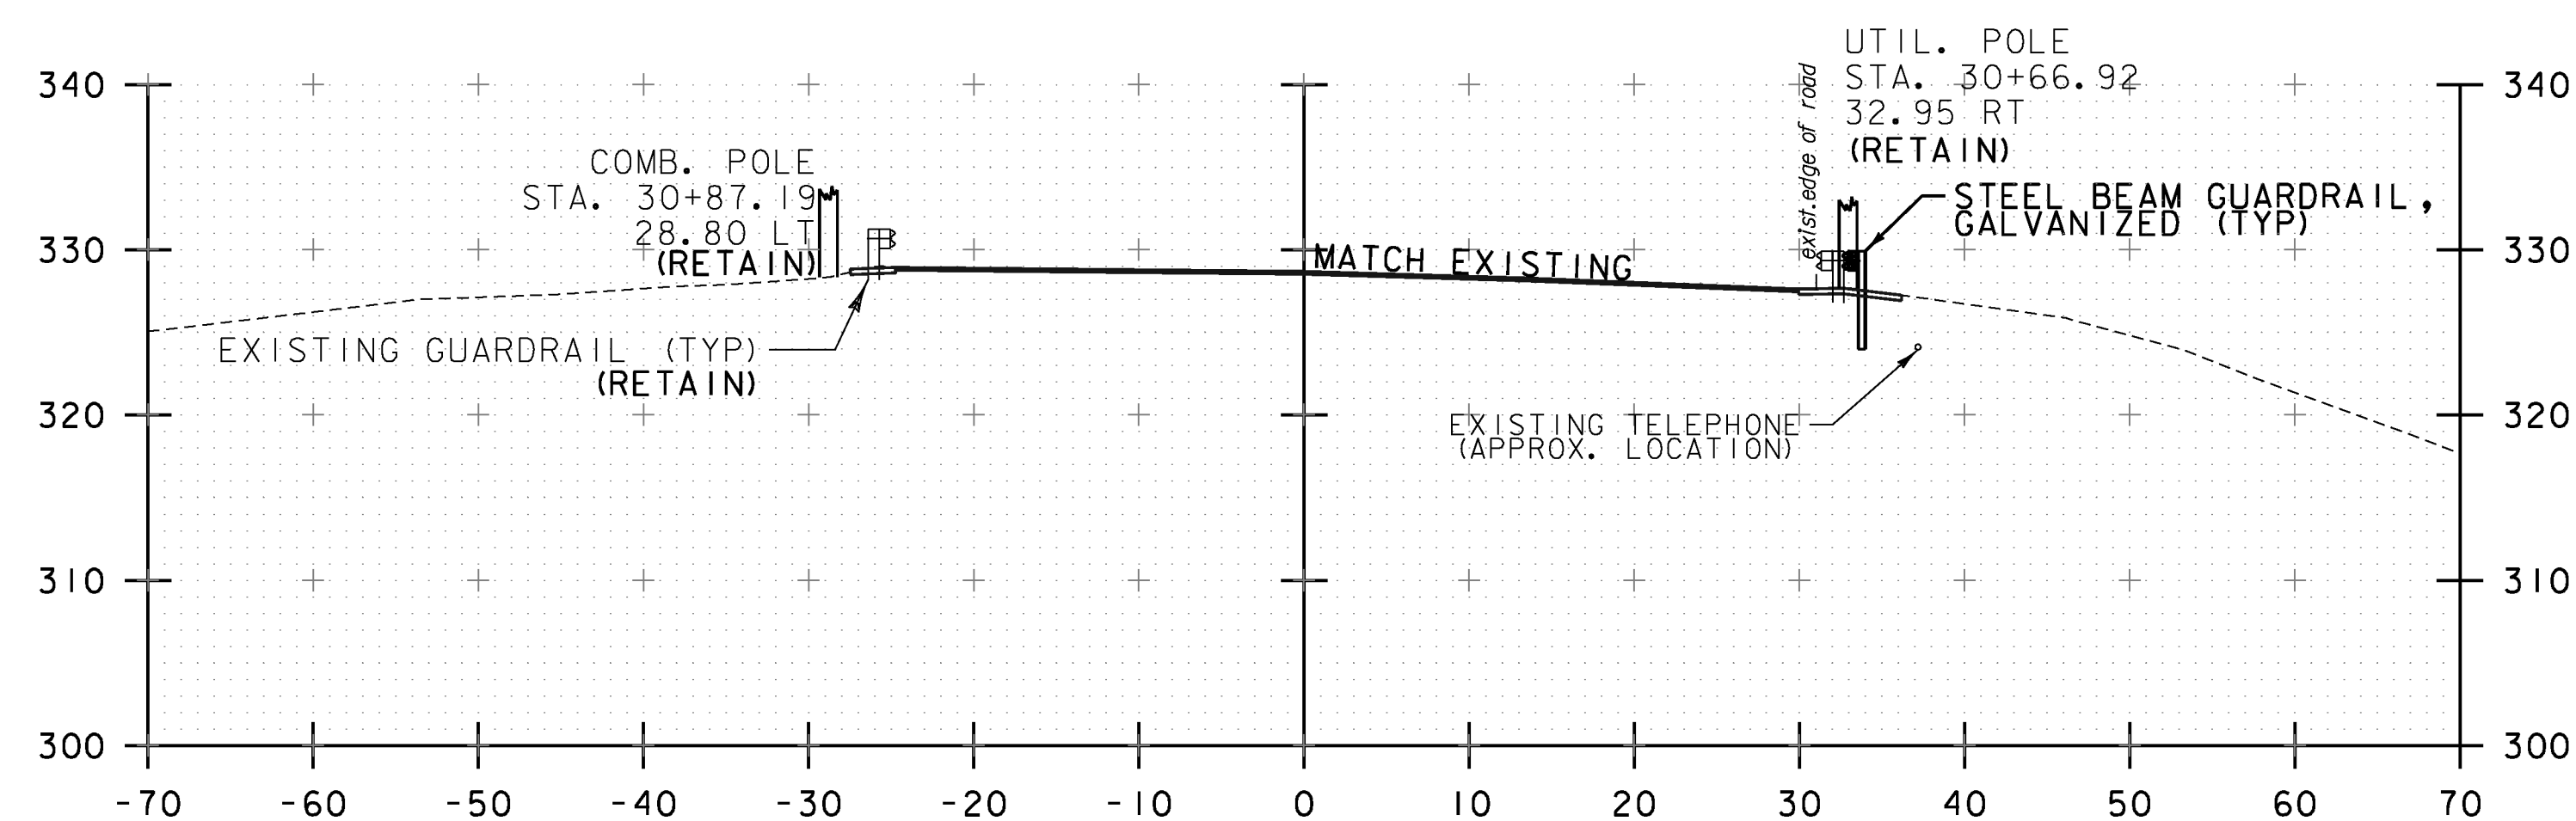

VT 117 STA. 30+50

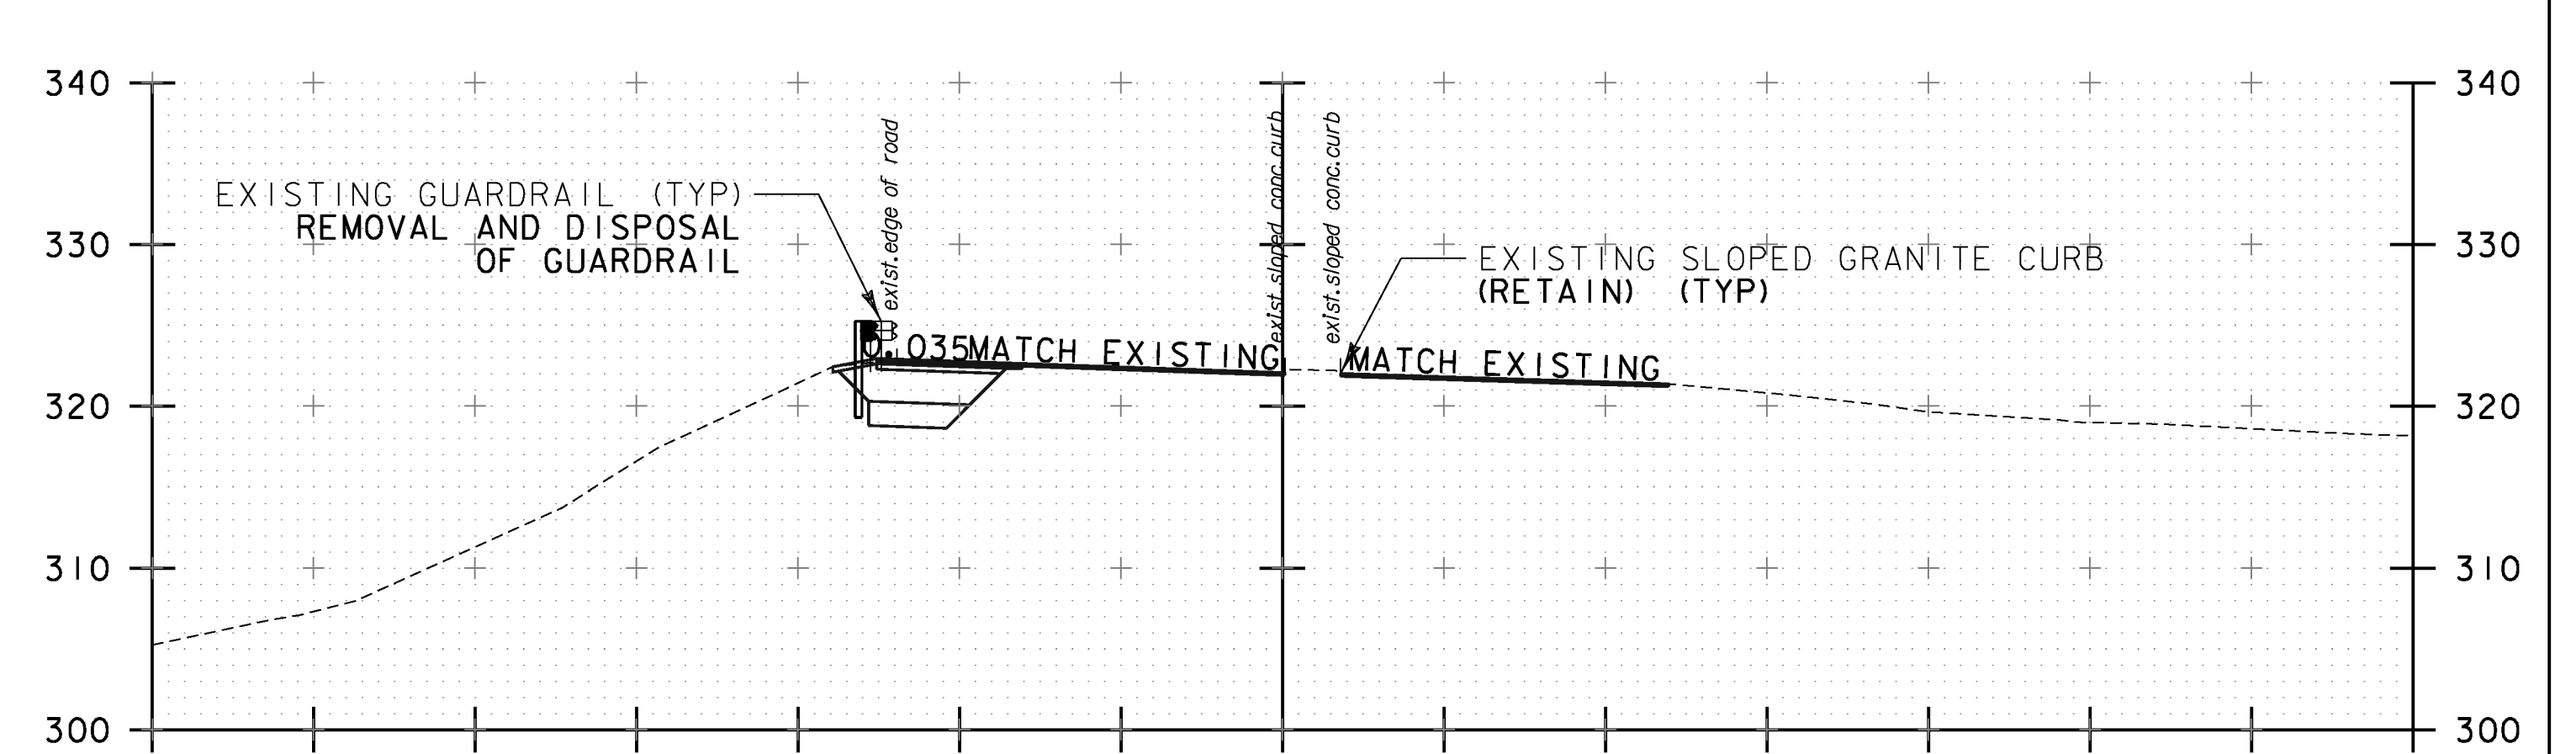

I-89 RAMP "A" STA. 35+50

VT 117 STA. 30+50 TO VT 117 STA. 31+50

I-89 RAMP "A" STA. 35+50 TO I-89 RAMP "A" STA. 36+50

PROJECT NAME:	RICHMOND
PROJECT NUMBER:	STP 0284 (17)
FILE NAME:	z97cl86xsl.dgn
PROJECT LEADER:	ERIK ATKINS
DESIGNED BY:	T. BIGELOW
PLOT DATE:	4/29/2013
DRAWN BY:	S. FORTIER
CHECKED BY:	E. ATKINS
VT RTE 117 & I-89 RAMP "A" CROSS SECTIONS SHEET 91 OF 133	