




I-89 RAMP "D" STA. 53+59

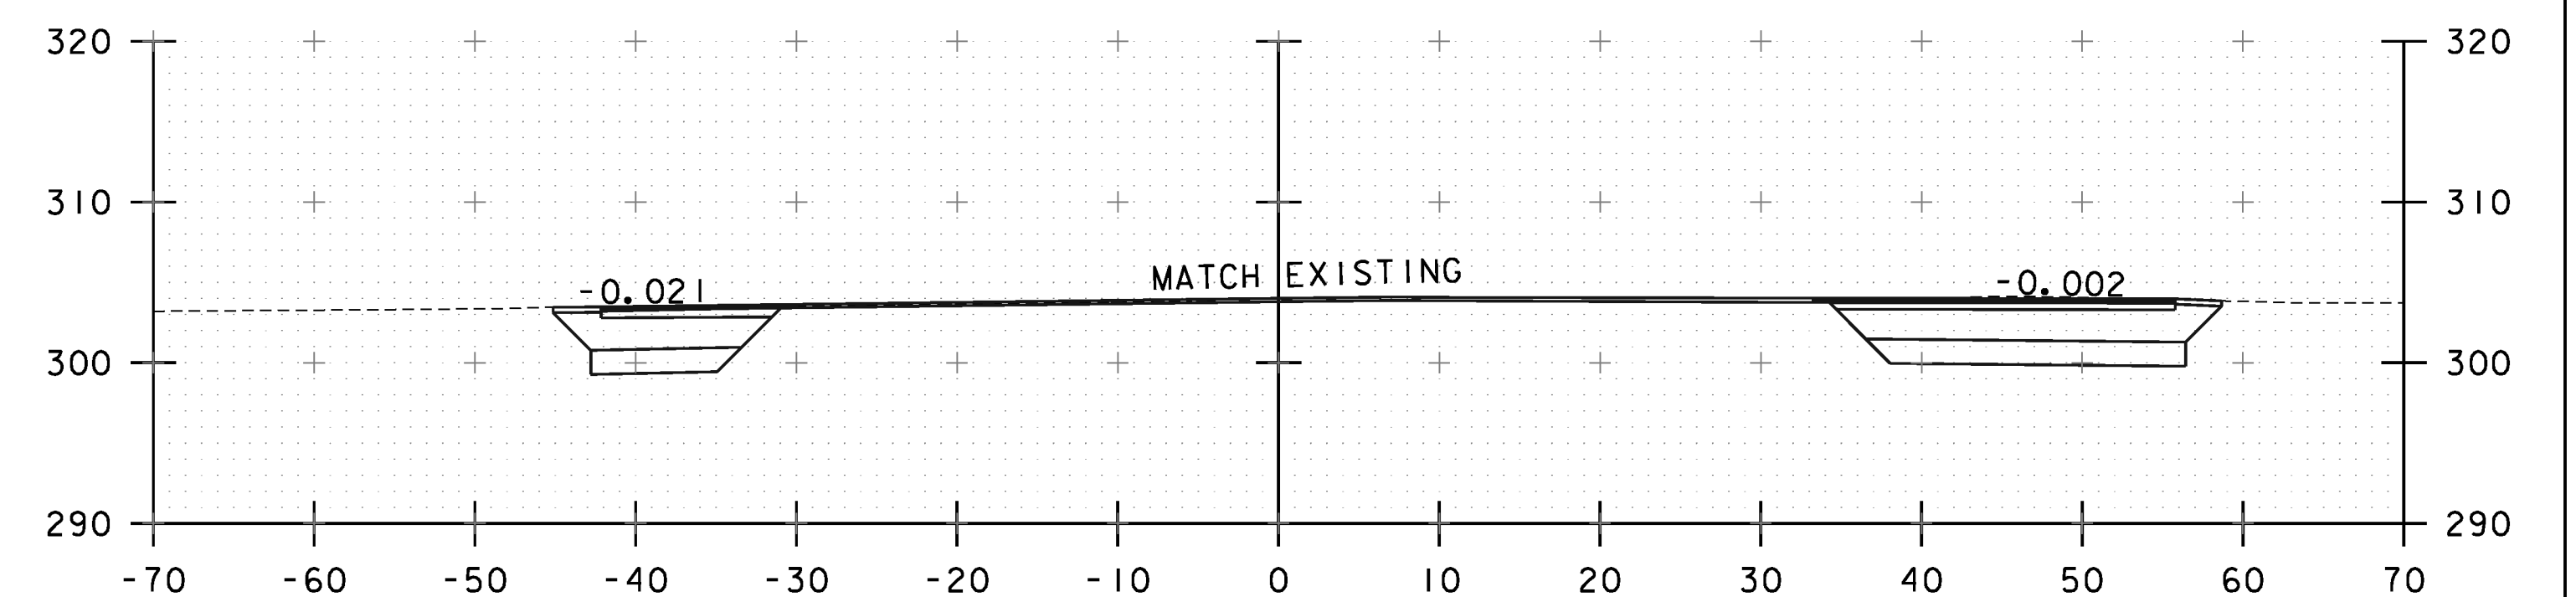

I-89 RAMP "D" STA. PT 54+23.50

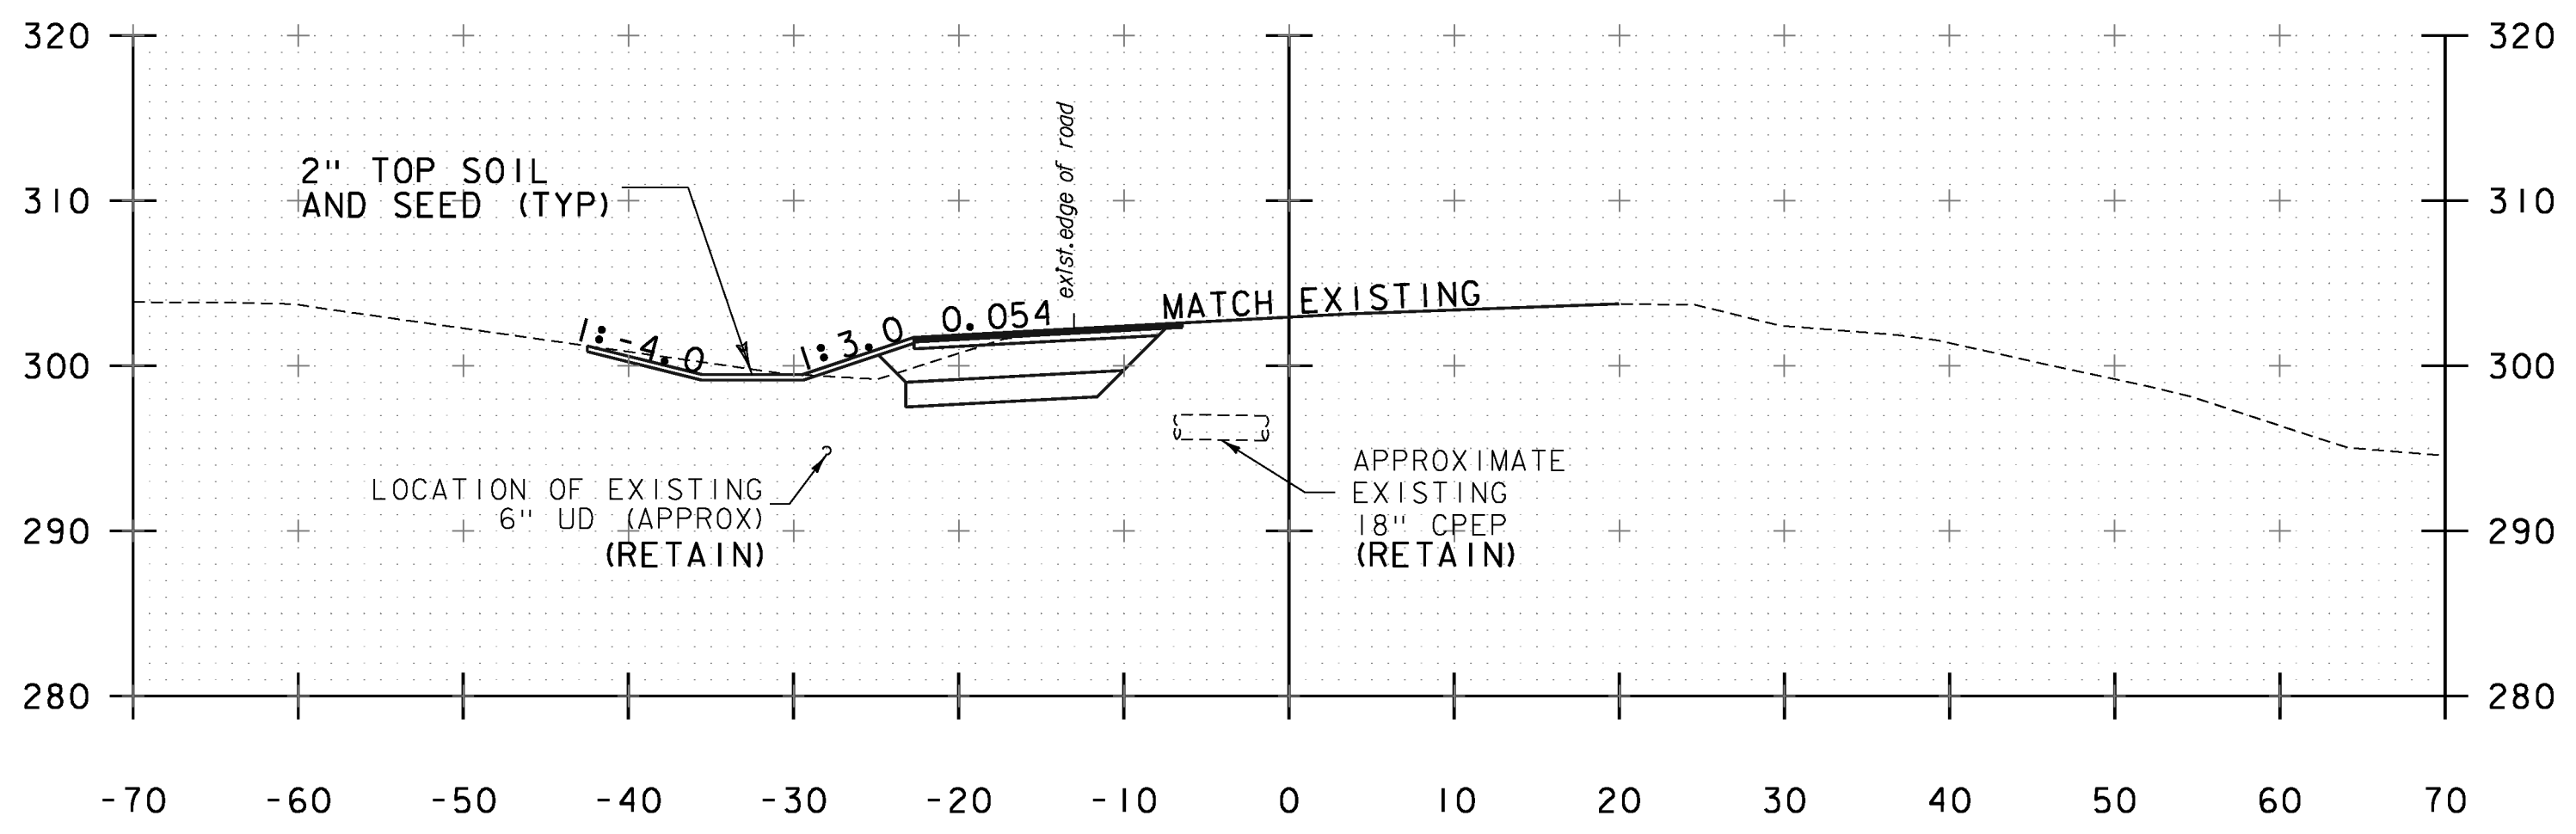

I-89 RAMP "D" STA. 53+50

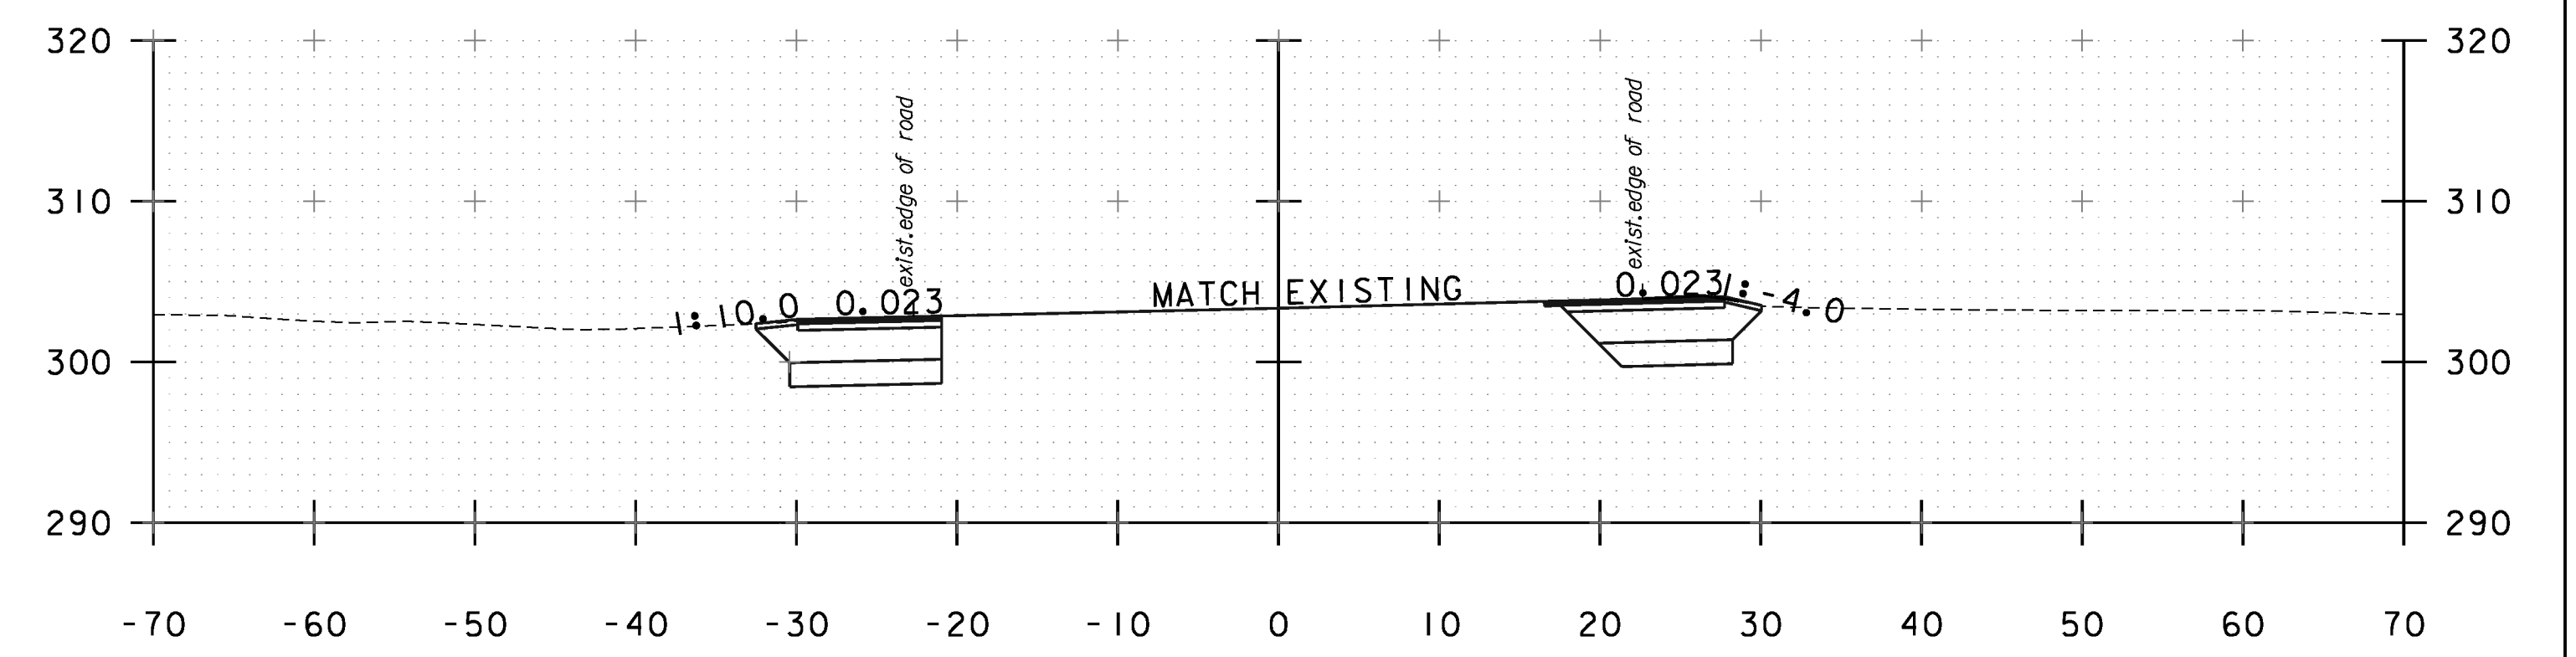

I-89 RAMP "D" STA. 54+00

PROJECT NAME:	RICHMOND
PROJECT NUMBER:	STP 0284 (17)
FILE NAME:	z97ci86xsl.dgn
PROJECT LEADER:	ERIK ATKINS
DESIGNED BY:	T. BIGELOW
I-89 RAMP "D" CROSS SECTIONS SHEET 2	
PLOT DATE:	4/29/2013
DRAWN BY:	S. FORTIER
CHECKED BY:	E. ATKINS
SHEET	93 OF 133