



TYPICAL SECTIONS

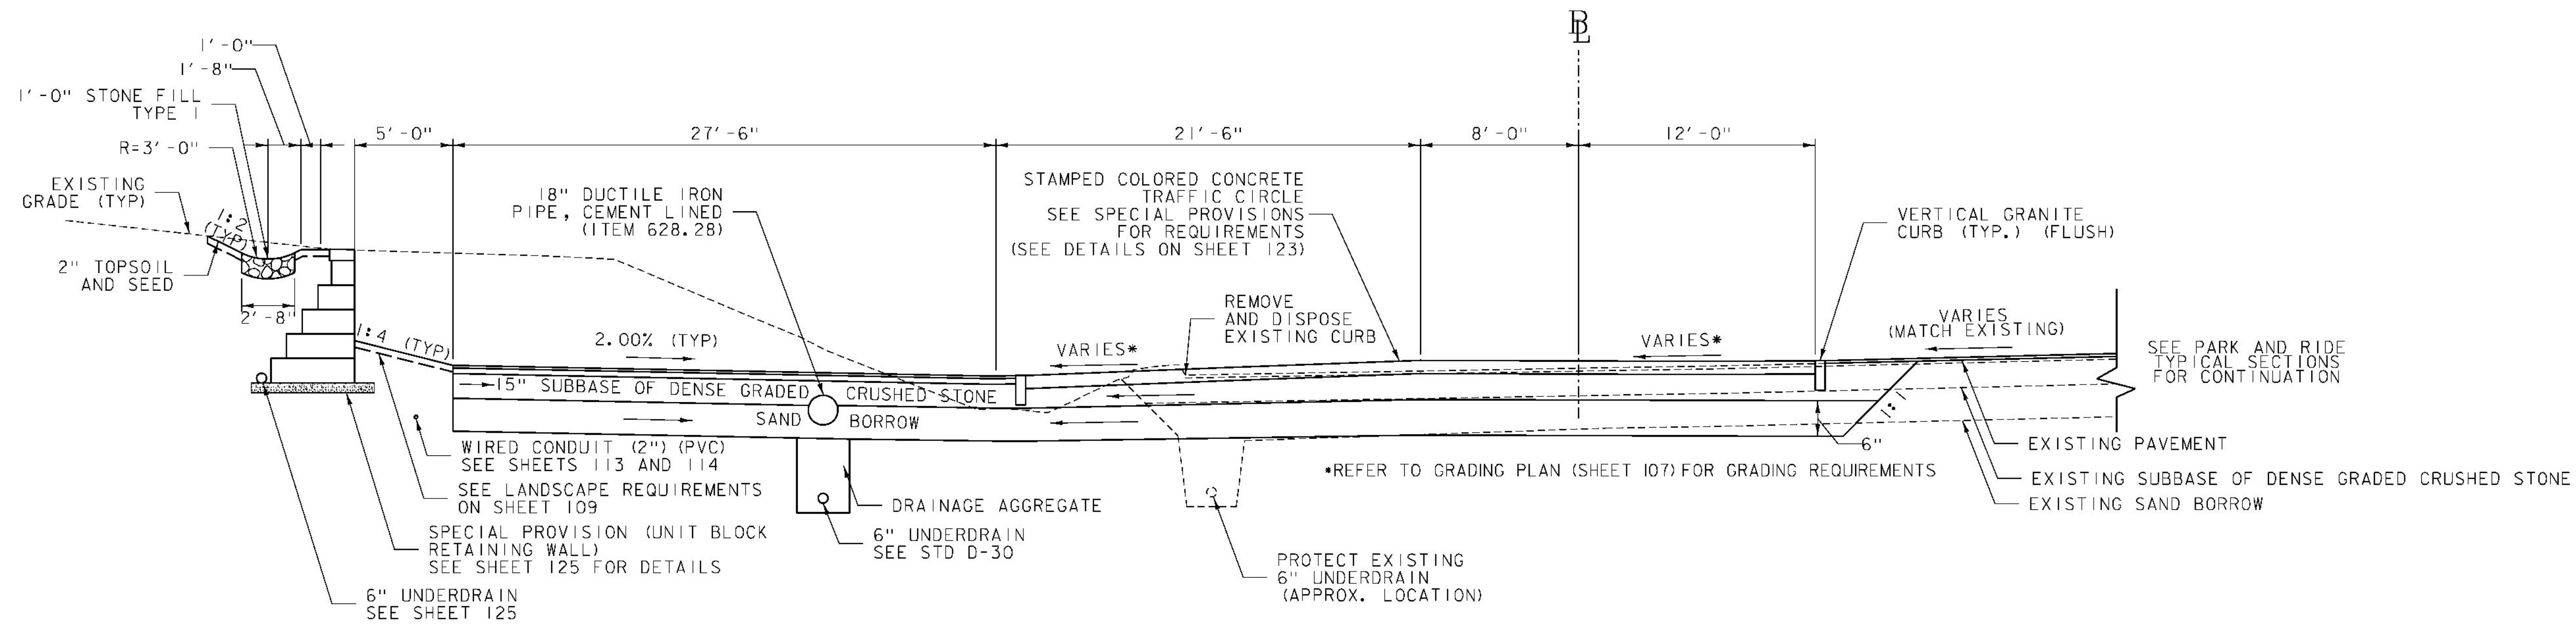

PARK AND RIDE TRAFFIC CIRCLE SECTION
 NOT TO SCALE

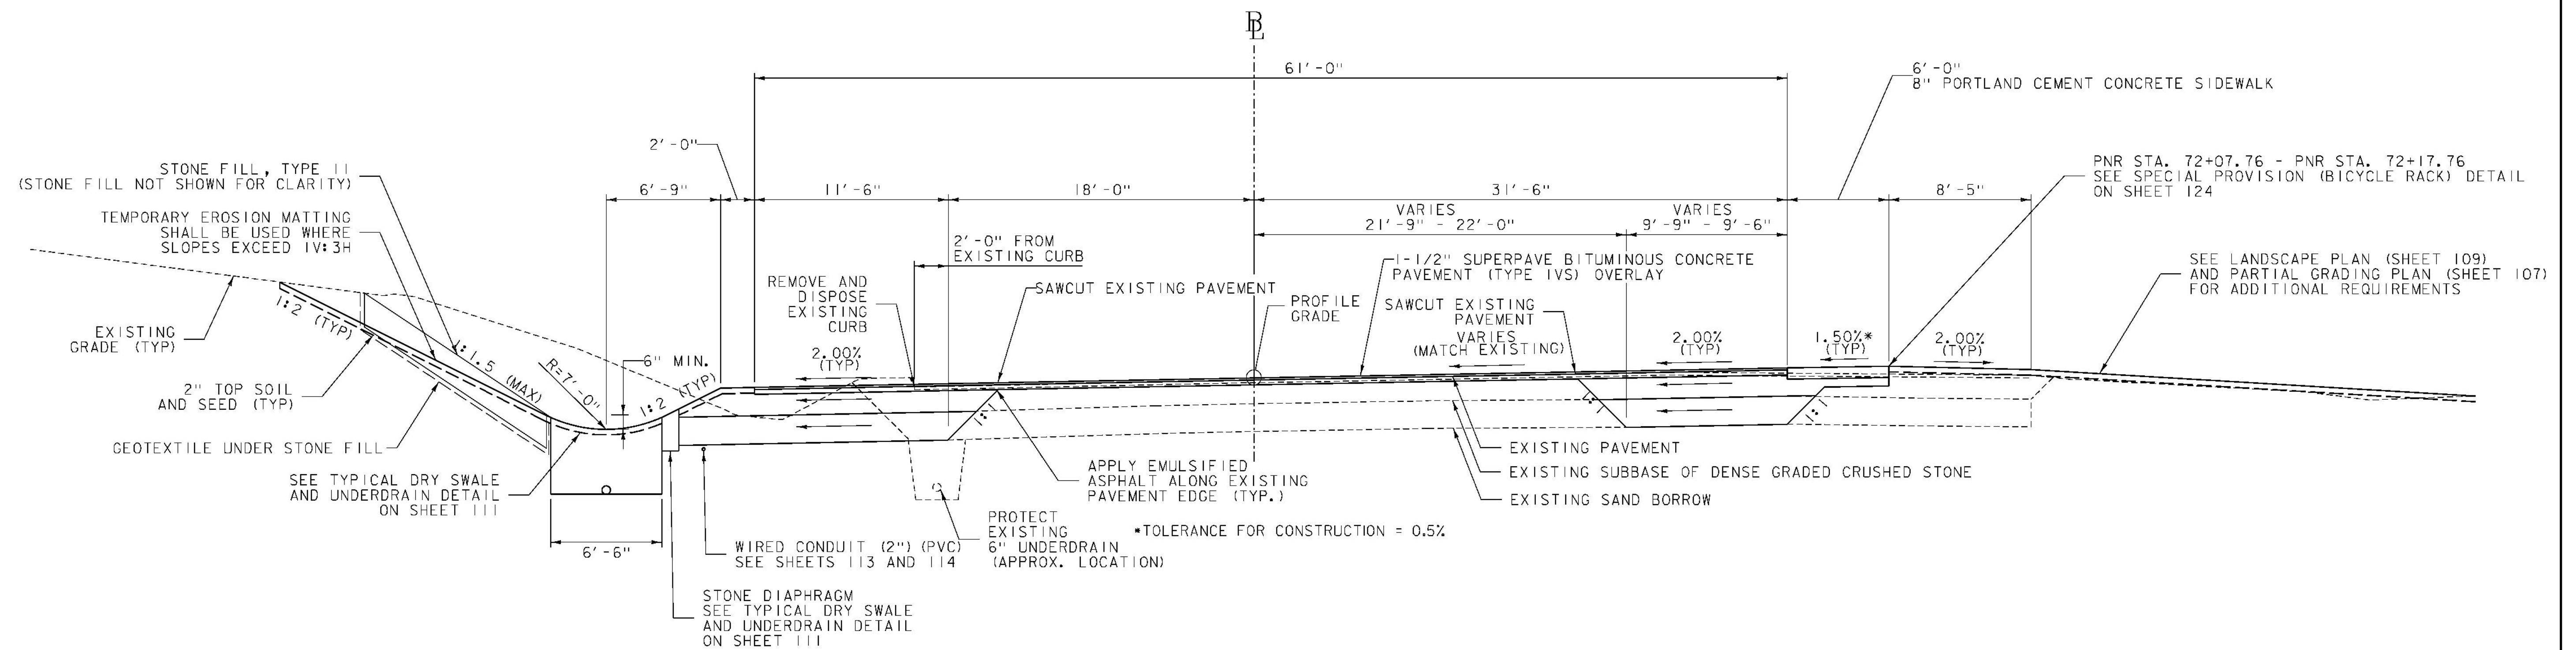

PARK AND RIDE SECTION
 STA. 71+62.82 - 72+28.02
 NOT TO SCALE

PROJECT NAME:	RICHMOND
PROJECT NUMBER:	CMG PARK (3I)
FILE NAME:	z97c186+yp.dgn
PROJECT LEADER:	ERIK ATKINS
DESIGNED BY:	T. BIGELOW
PLOT DATE:	5/2/2013
DRAWN BY:	S. FORTIER
CHECKED BY:	E. ATKINS
PARK AND RIDE TYPICAL SECTIONS SHEET 2 SHEET 96 OF 133	