
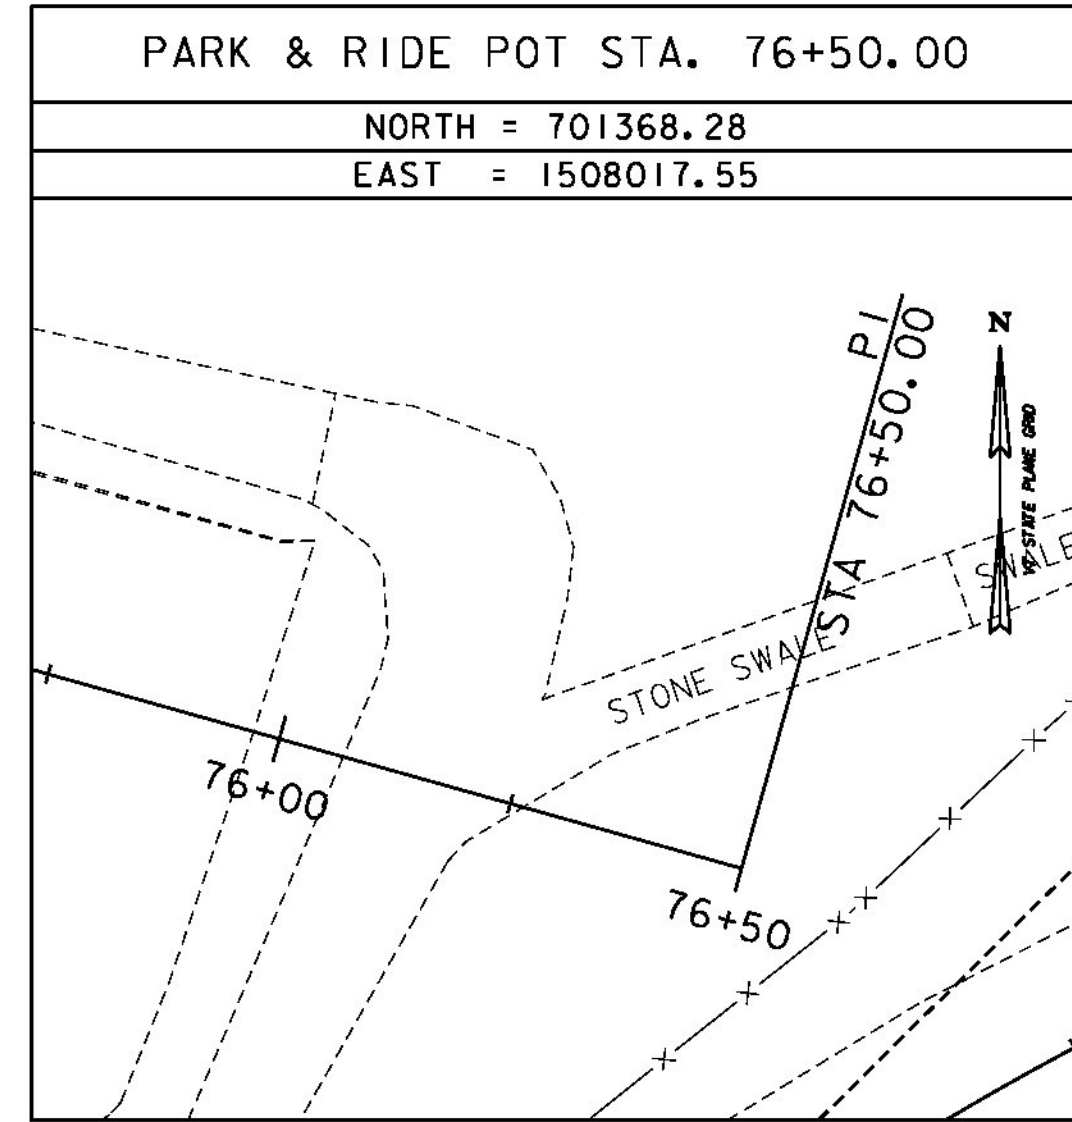


ALIGNMENT TIES

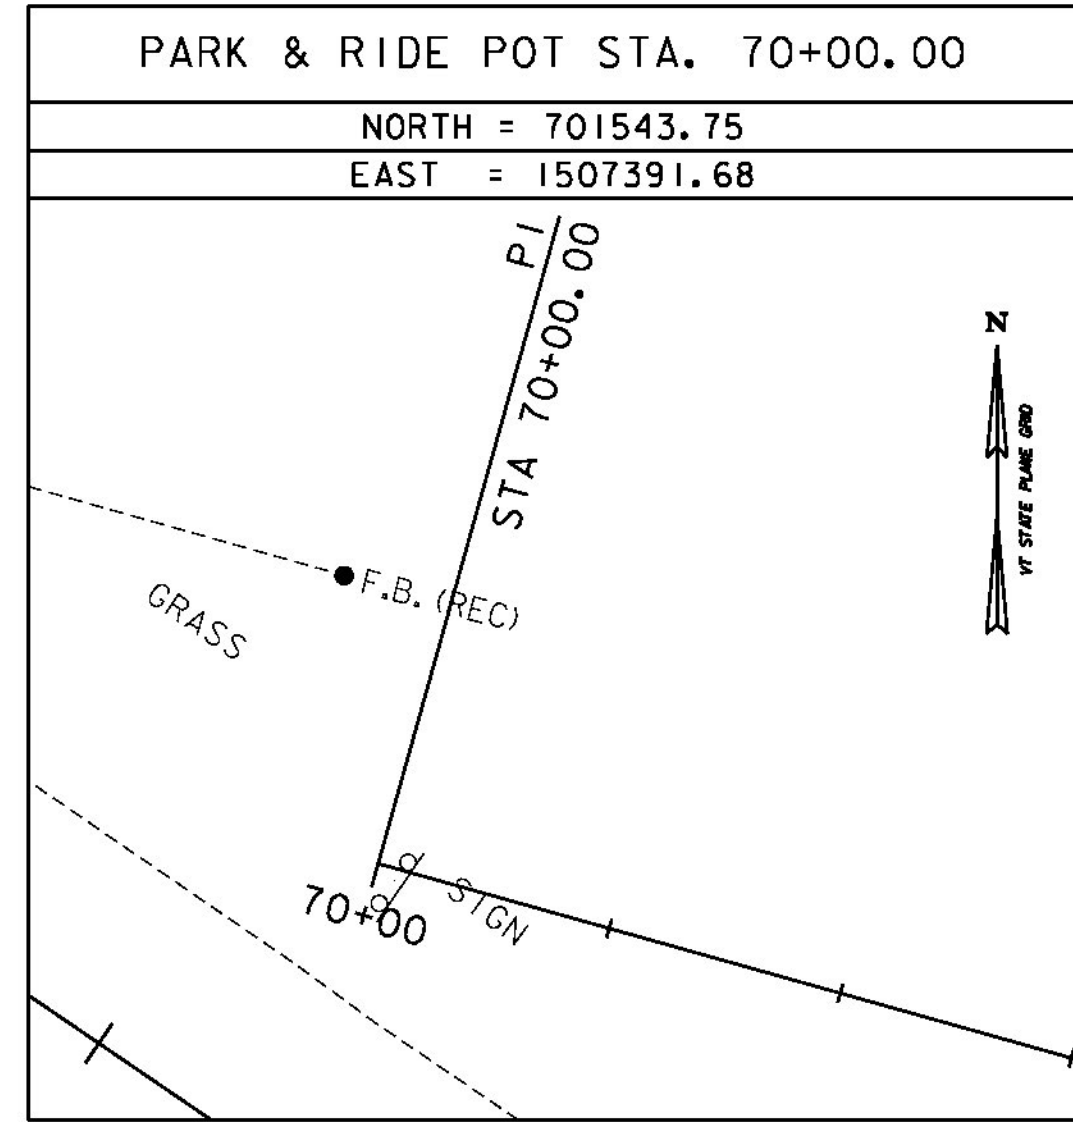

NORTH =

EAST =

NORTH =

EAST =

NORTH =

EAST =

ALIGNMENT TIES

NORTH =

EAST =

NORTH =

EAST =

ALIGNMENT TIES

NORTH =

EAST =

NORTH =

EAST =

DATUM	
VERTICAL	NAVD88
HORIZONTAL	NAD83 (1992)
ADJUSTMENT	COMPASS

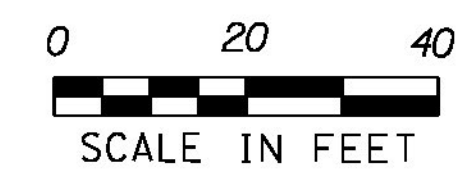

PROJECT NAME: RICHMOND	
PROJECT NUMBER: CMG PARK (3I)	
FILE NAME: z97ci86t1.dgn	PLOT DATE: 4/29/2013
PROJECT LEADER: ERIK ATKINS	DRAWN BY: A. ACHARYA
DESIGNED BY: T. BIGELOW	CHECKED BY: E. ATKINS
TIE SHEET 4	SHEET 103 OF 133