


TRAFFIC SIGN SUMMARY SHEET 3

MILEMARKER, STATION, OR SIGN NUMBER	SIGN LEGEND	SIGN DIMENSIONS		NEW & SALVAGED SIGNS				EXIST POST RETAINED	NO. OF POSTS	NEW SIGN POSTS														REMARKS	SIGN DETAIL								
		EA	WIDTH (in)	HEIGHT (in)	"A"	"B"	SALV SIGN			SALV TIS	FLANGED CHANNEL lb/ft			SQUARE STEEL (in)			TUBULAR ALUMINUM (in)			TUBULAR STEEL (in)			W-SHAPE STEEL		S.H.S.*	DETAIL ON SHEET NUMBER	STD. SHEET NUMBER						
											1.12	2.0	3.0	1.75	2.0	2.5	3.0	4.0	4.0 MOD	3.0	3.5	4.0	5.0					FTG. SIZE	WEIGHT	POST SIZE			
OPTION ITEMS																																	
PARK AND RIDE																																	
STATION 75+57, RT PARK & RIDE	R6-1R, ONE WAY	1	36	12	3.00				1																					INSTALL NEW SIGN ON NEW POST			E-142
STATION 75+76, RT PARK & RIDE	R7-2a, NO PARKING NOV 1 TO MAR 31	1	12	18	1.50				1																					INSTALL NEW SIGN ON NEW POST	X		
	R7-20IP, TOW-AWAY ZONE (PLAQUE)	1	12	6	0.50																									INSTALL NEW SIGN ON NEW POST (SUB-MOUNT WITH THE PREVIOUS SIGN)	X		
STATION 76+07, RT PARK & RIDE	R7-1, NO PARKING ANYTIME	1	12	18	1.50				1																					INSTALL NEW SIGN ON NEW POST	X		
	R7-20IP, TOW-AWAY ZONE (PLAQUE)	1	12	6	0.50																									INSTALL NEW SIGN ON NEW POST (SUB-MOUNT WITH THE PREVIOUS SIGN)	X		
STATION 76+08, RT PARK & RIDE	R7-2aR, NO PARKING NOV 1 TO MAR 31	1	12	18	1.50				1																					INSTALL NEW SIGN ON NEW POST	X		
	R7-20IP, TOW-AWAY ZONE (PLAQUE)	1	12	6	0.50																									INSTALL NEW SIGN ON NEW POST (SUB-MOUNT WITH THE PREVIOUS SIGN)	X		
TOTALS					SF 11.00 9.00	SF	EA.	SF		FT	FT	FT	FT	FT	FT	EA	LB	LB	LB	EA.	LB	EA.	EA.	LB									
STATION 72+20, RT PARK & RIDE	R7-1, NO PARKING ANYTIME	1	12	18	1.50				1						13.0 X																		
	R7-20IP, TOW-AWAY ZONE (PLAQUE)	1	12	6	0.50																												
SHEET 117 TOTALS					18.75 13.75																												
SHEET 118 TOTALS					25.25		6																										
SHEET 119 TOTALS					11.00 9.00										61.25 48.25																		
GRAND TOTALS					55.0 48.0		10 13								297.00 284.00																		

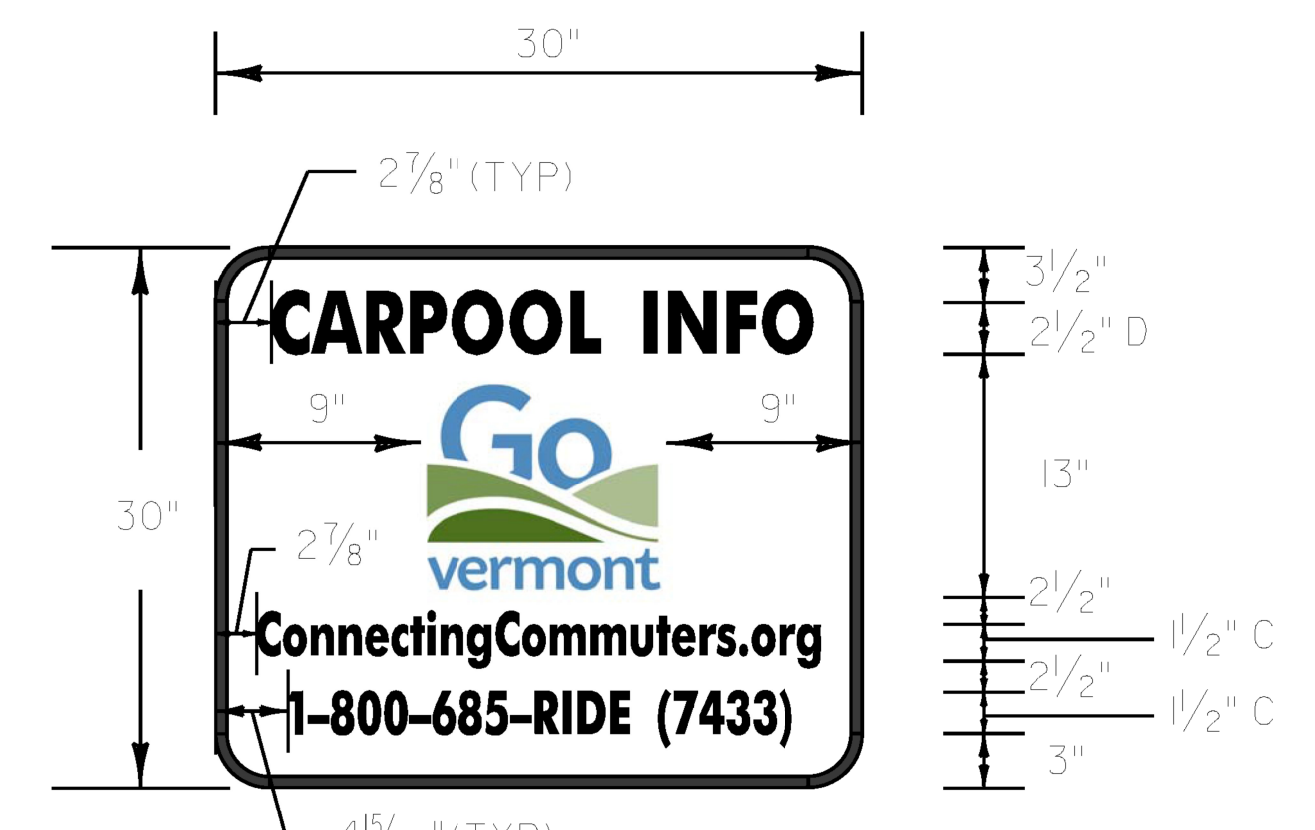

WHITE BORDER AND TEXT (RETROREFLECTIVE)
(MINIMUM TYPE IX) WITH BLUE BACKGROUND
(RETROREFLECTIVE) (MINIMUM TYPE III)
SEE VTRANS STANDARD E-131 FOR MATERIALS

SIGN DETAIL
NOT TO SCALE

KEY	DATE	BY	REVISION
	11/10/2015	VTRANS	SIGN SUMMARY UPDATE

PROJECT NAME: RICHMOND
PROJECT NUMBER: CMG PARK (3I)
FILE NAME: z97cl86tss.dgn PLOT DATE: 4/29/2013
PROJECT LEADER: JEFFREY MAXTUTIS DRAWN BY: Y.CAO/LALMY
DESIGNED BY: J.SOBEL CHECKED BY: D.FLYNN
TRAFFIC SIGN SUMMARY SHEET 3 SHEET 119 OF 133

FINAL POST LENGTHS ARE TO BE DETERMINED IN THE FIELD. POST SIZES ARE COMPUTED BASED ON INFORMATION FURNISHED ON THE VTRANS STANDARD SHEETS AND THE "SIGN POST DESIGN GUIDELINE".
*STANDARD HIGHWAY SIGNS