




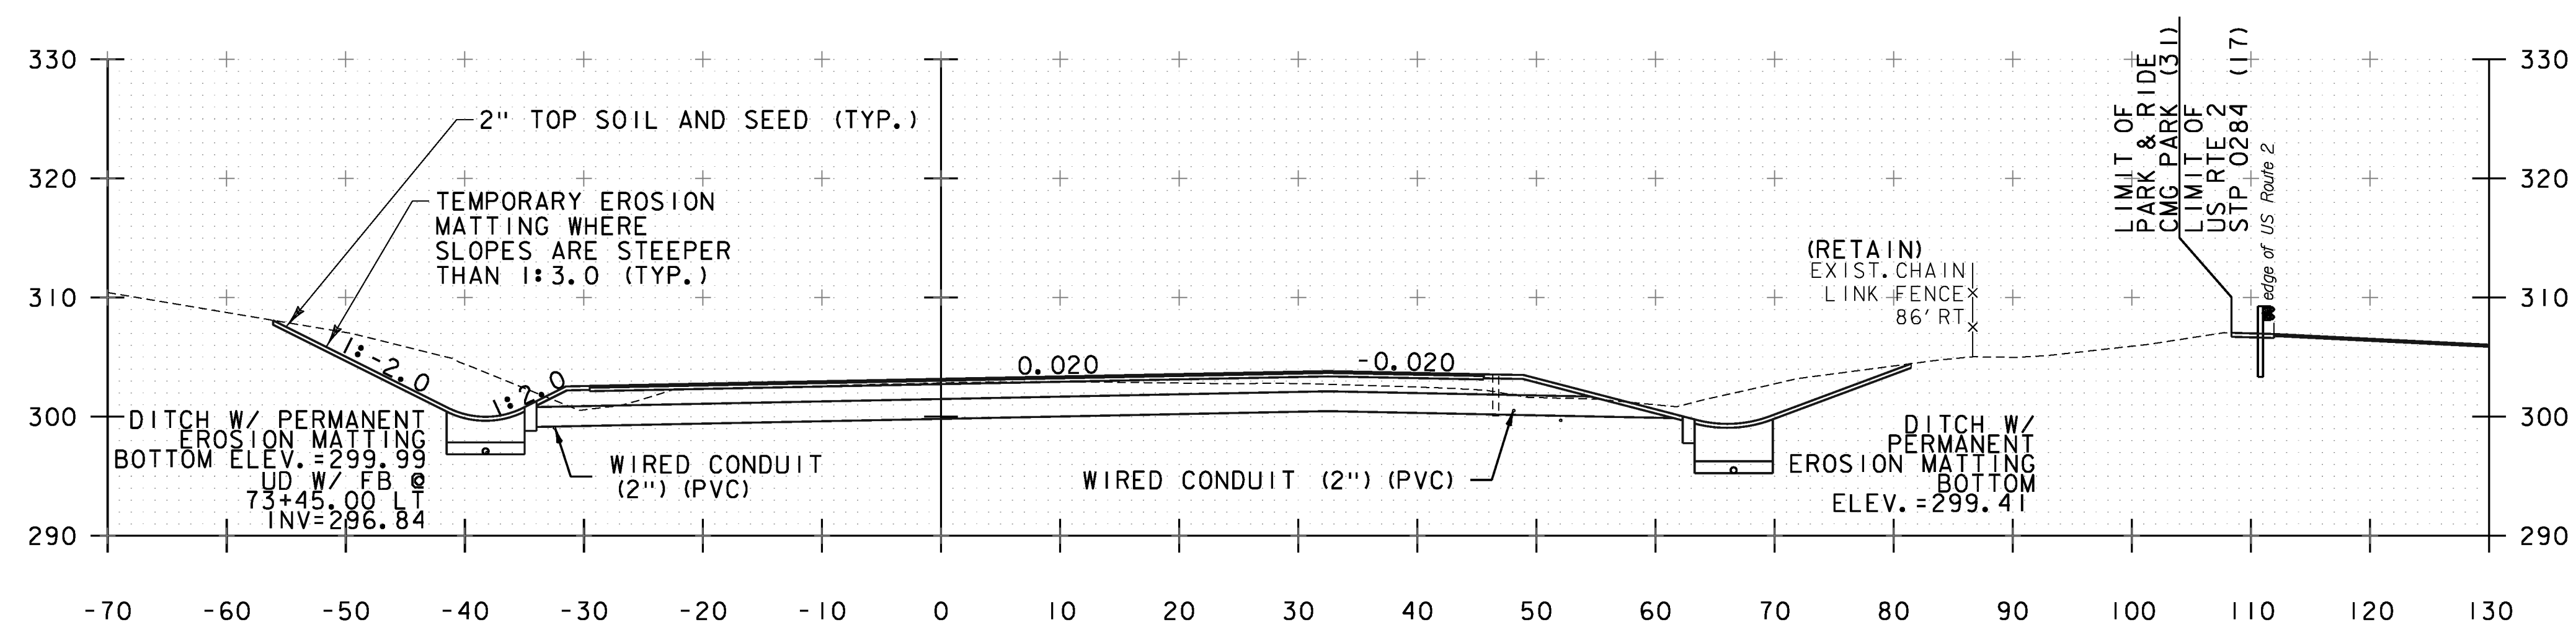

76+00

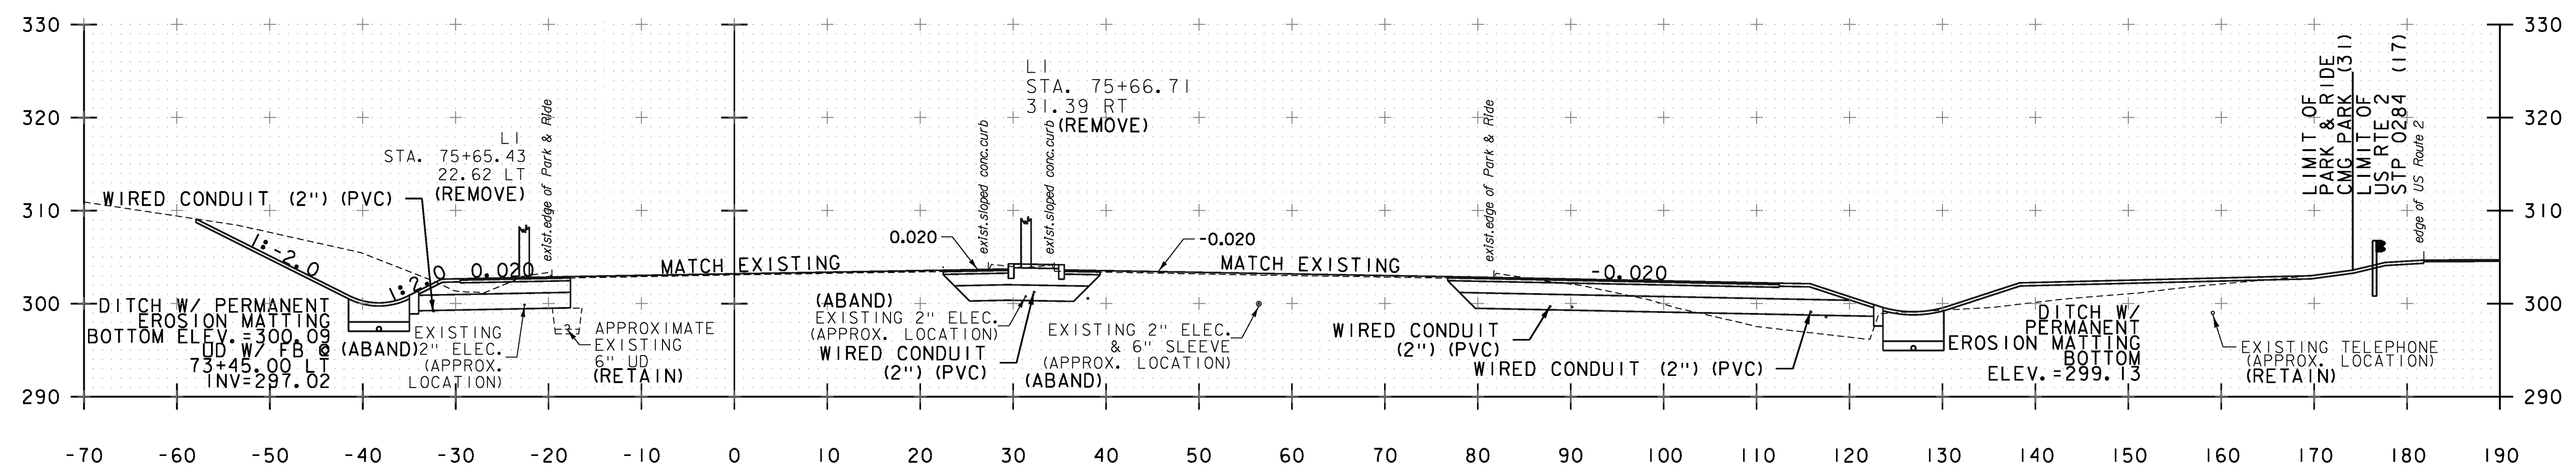

75+50

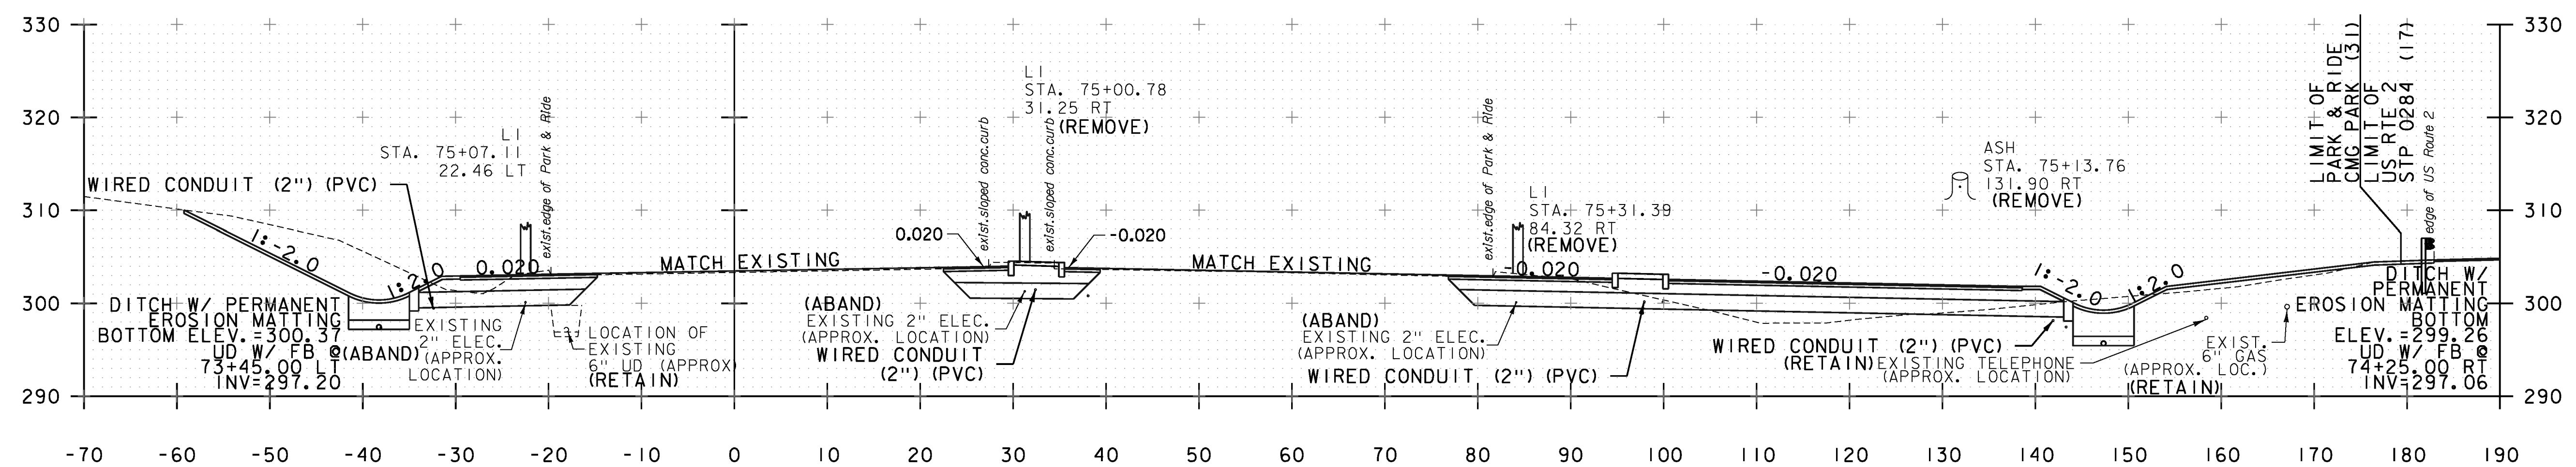

75+00

PROJECT NAME: RICHMOND
PROJECT NUMBER: CMG PARK (31)

FILE NAME: z97ci86xsl.dgn PLOT DATE: 4/29/2013
PROJECT LEADER: ERIK ATKINS DRAWN BY: S. FORTIER
DESIGNED BY: T. BIGELOW CHECKED BY: E. ATKINS
PARK & RIDE CROSS SECTIONS SHEET 5 SHEET 133 OF 133

STA. 75+00 TO STA. 76+00