




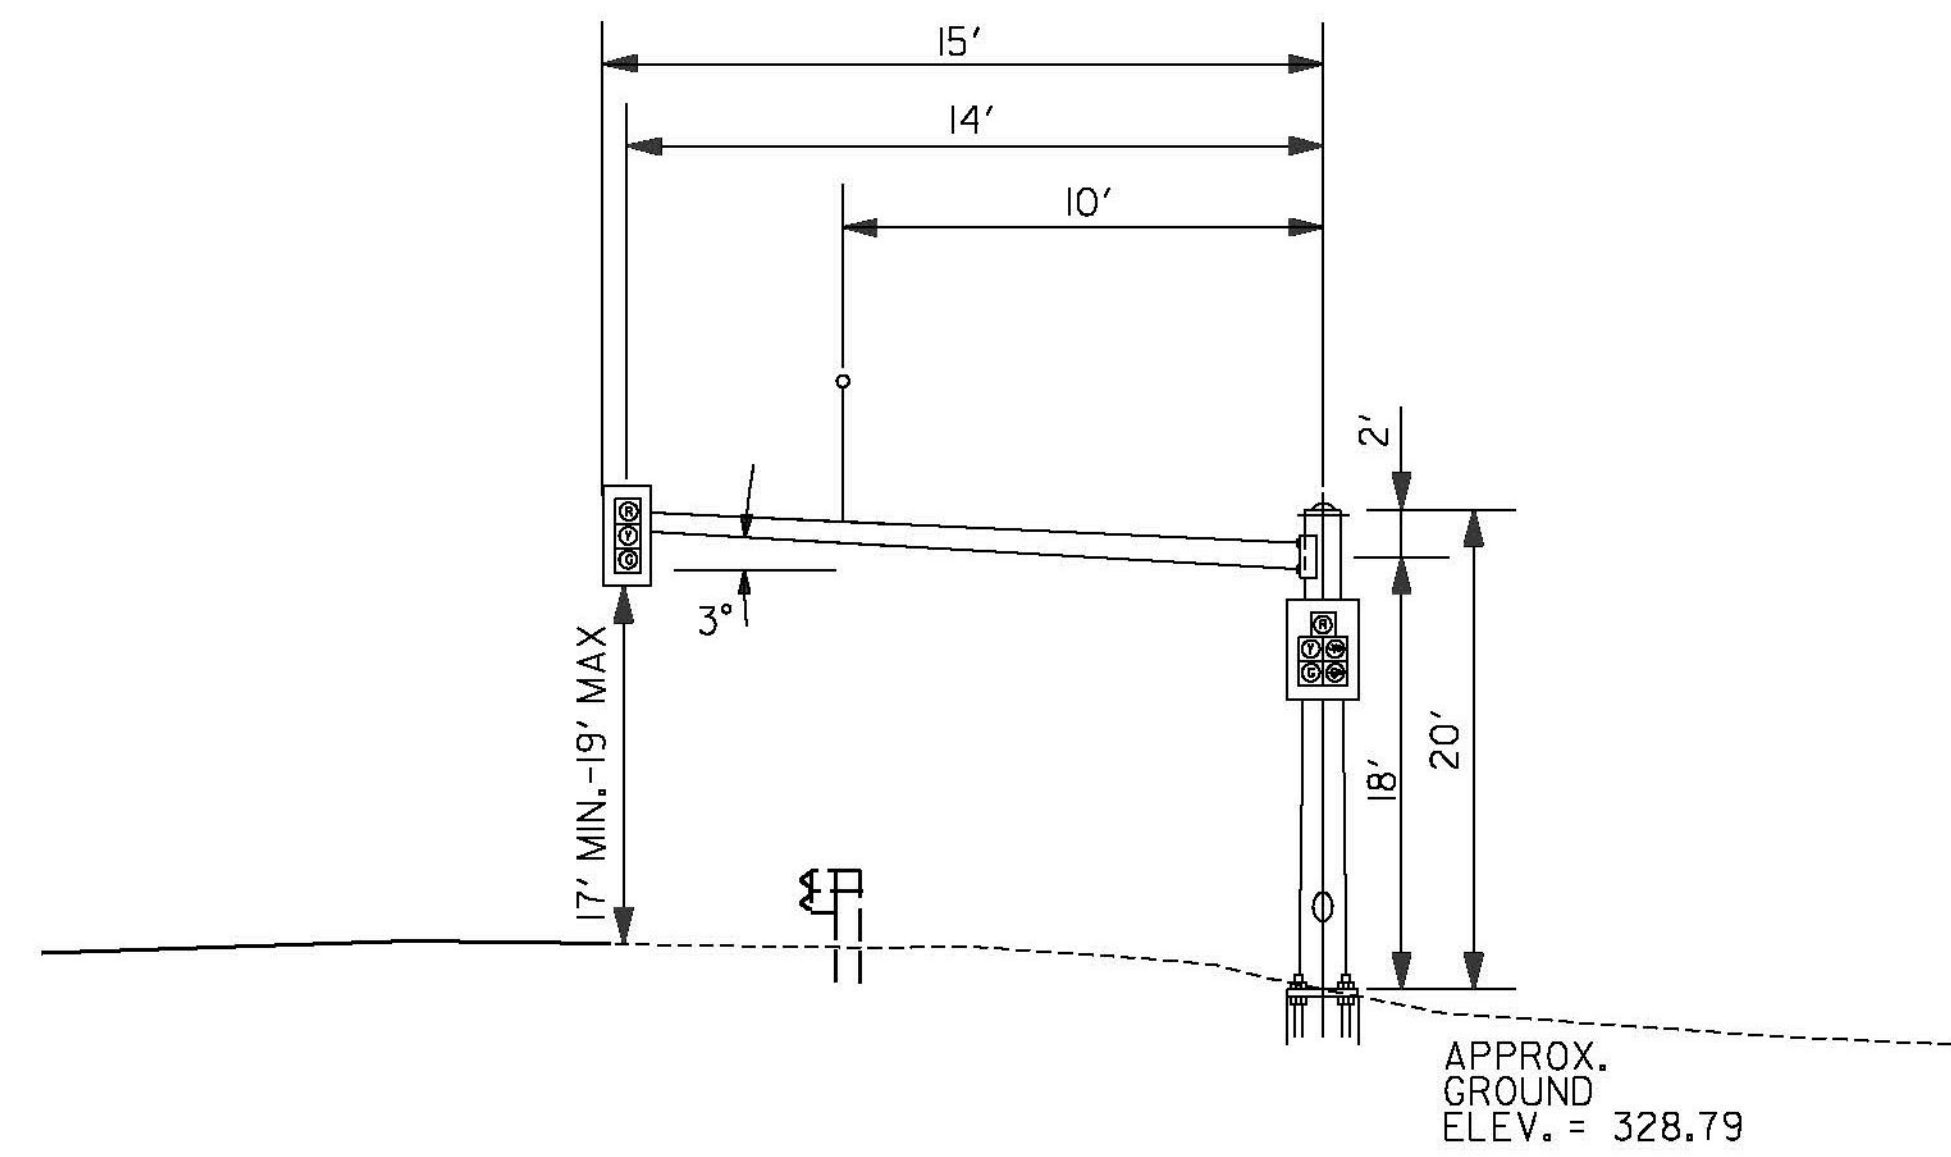


MP1A
N.T.S.

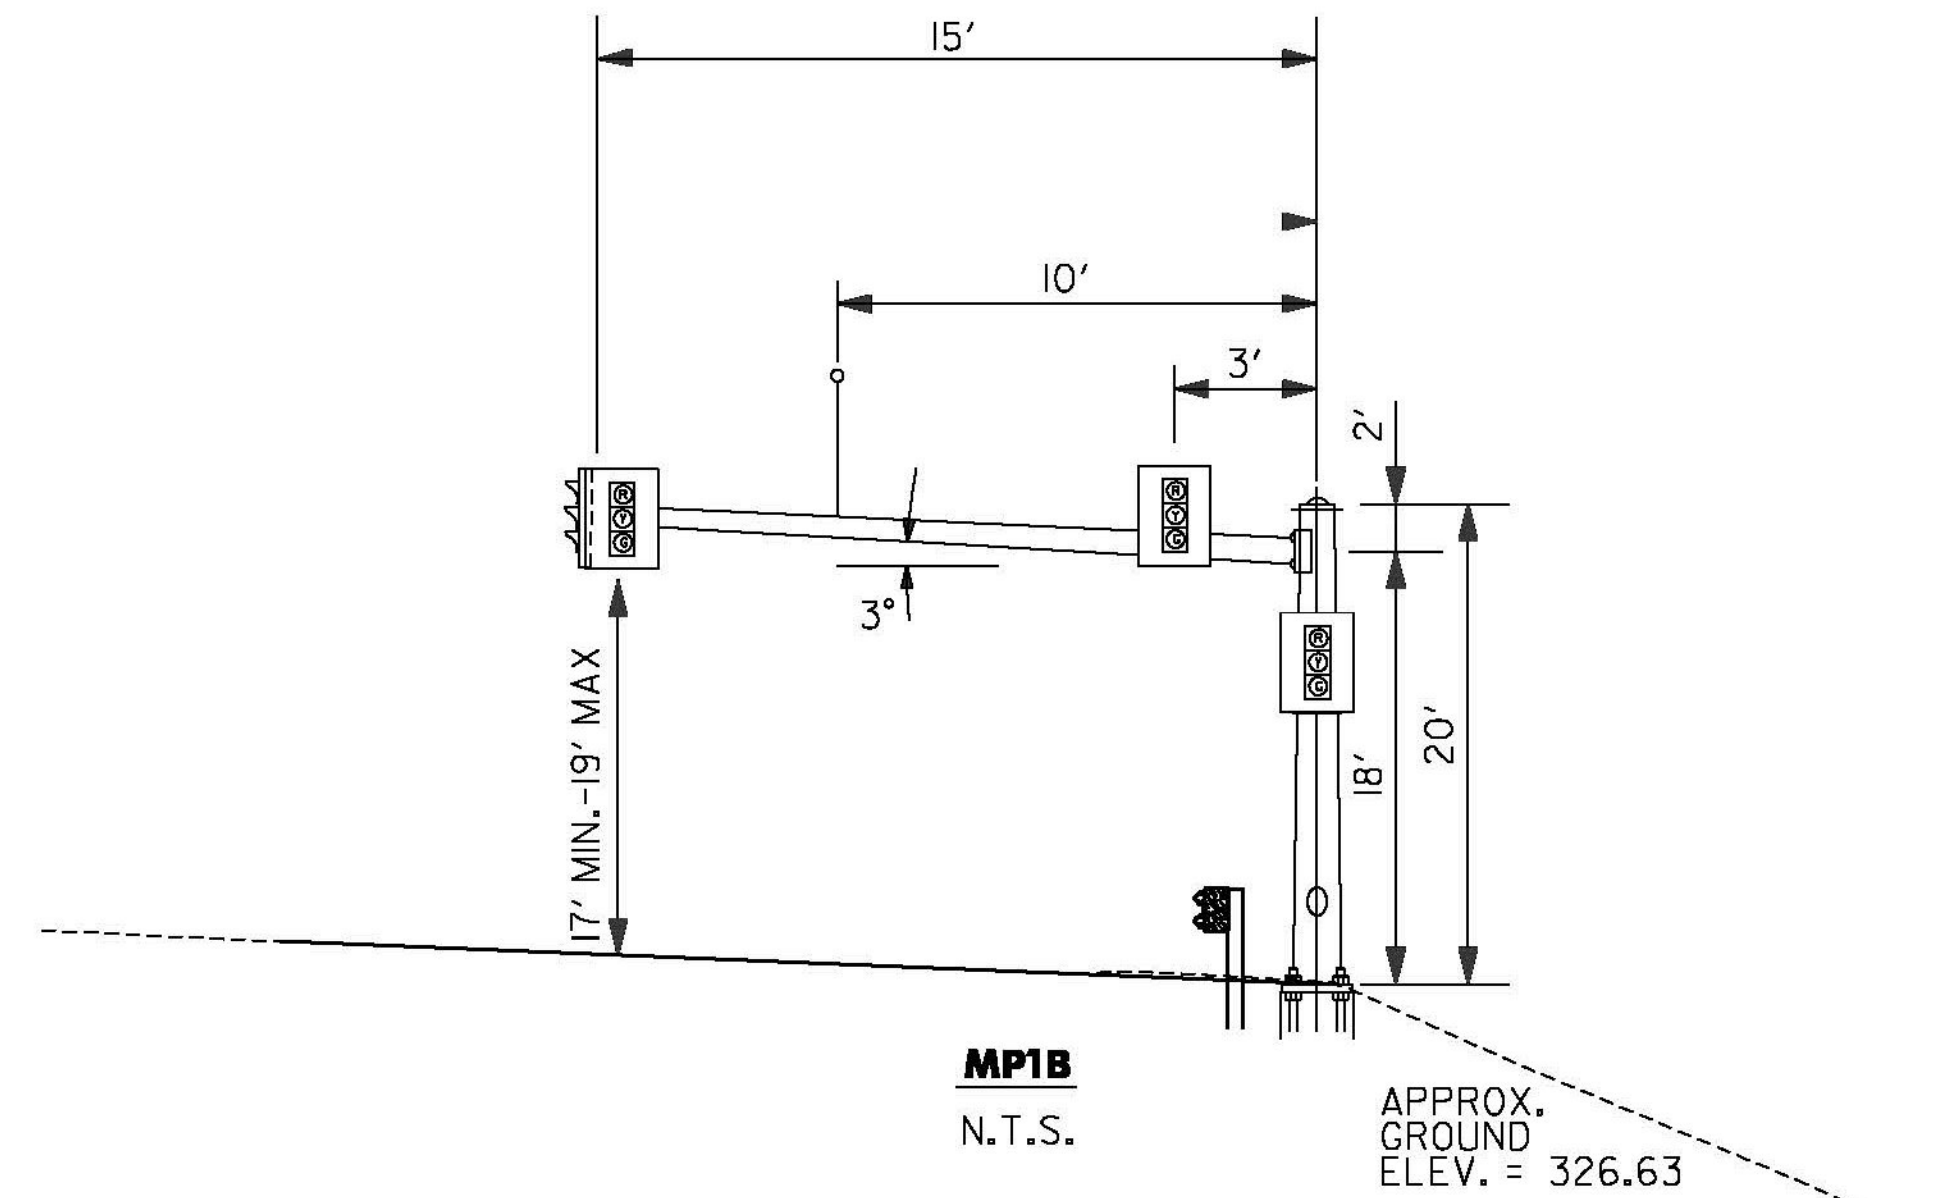


MP1B
N.T.S.

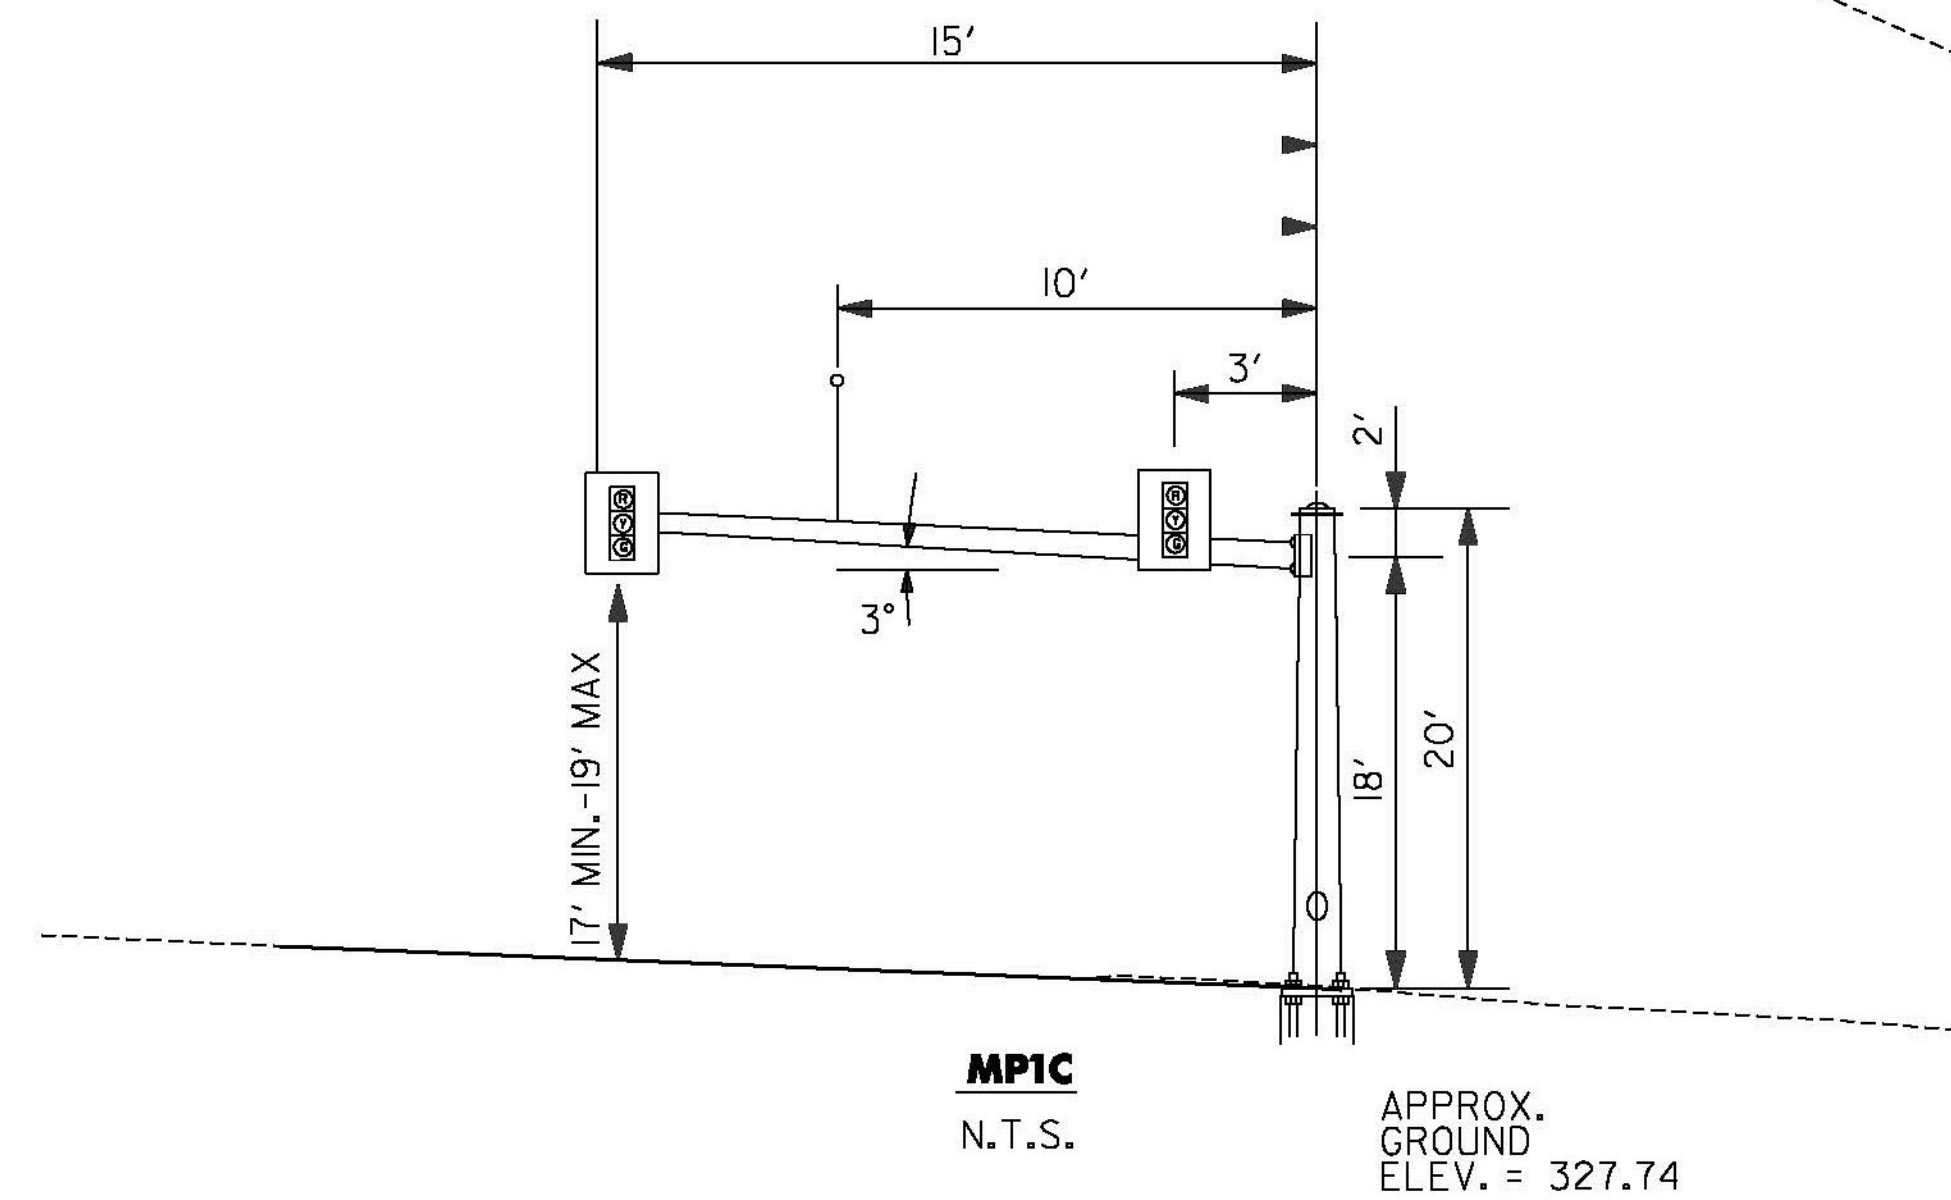


MP1C
N.T.S.

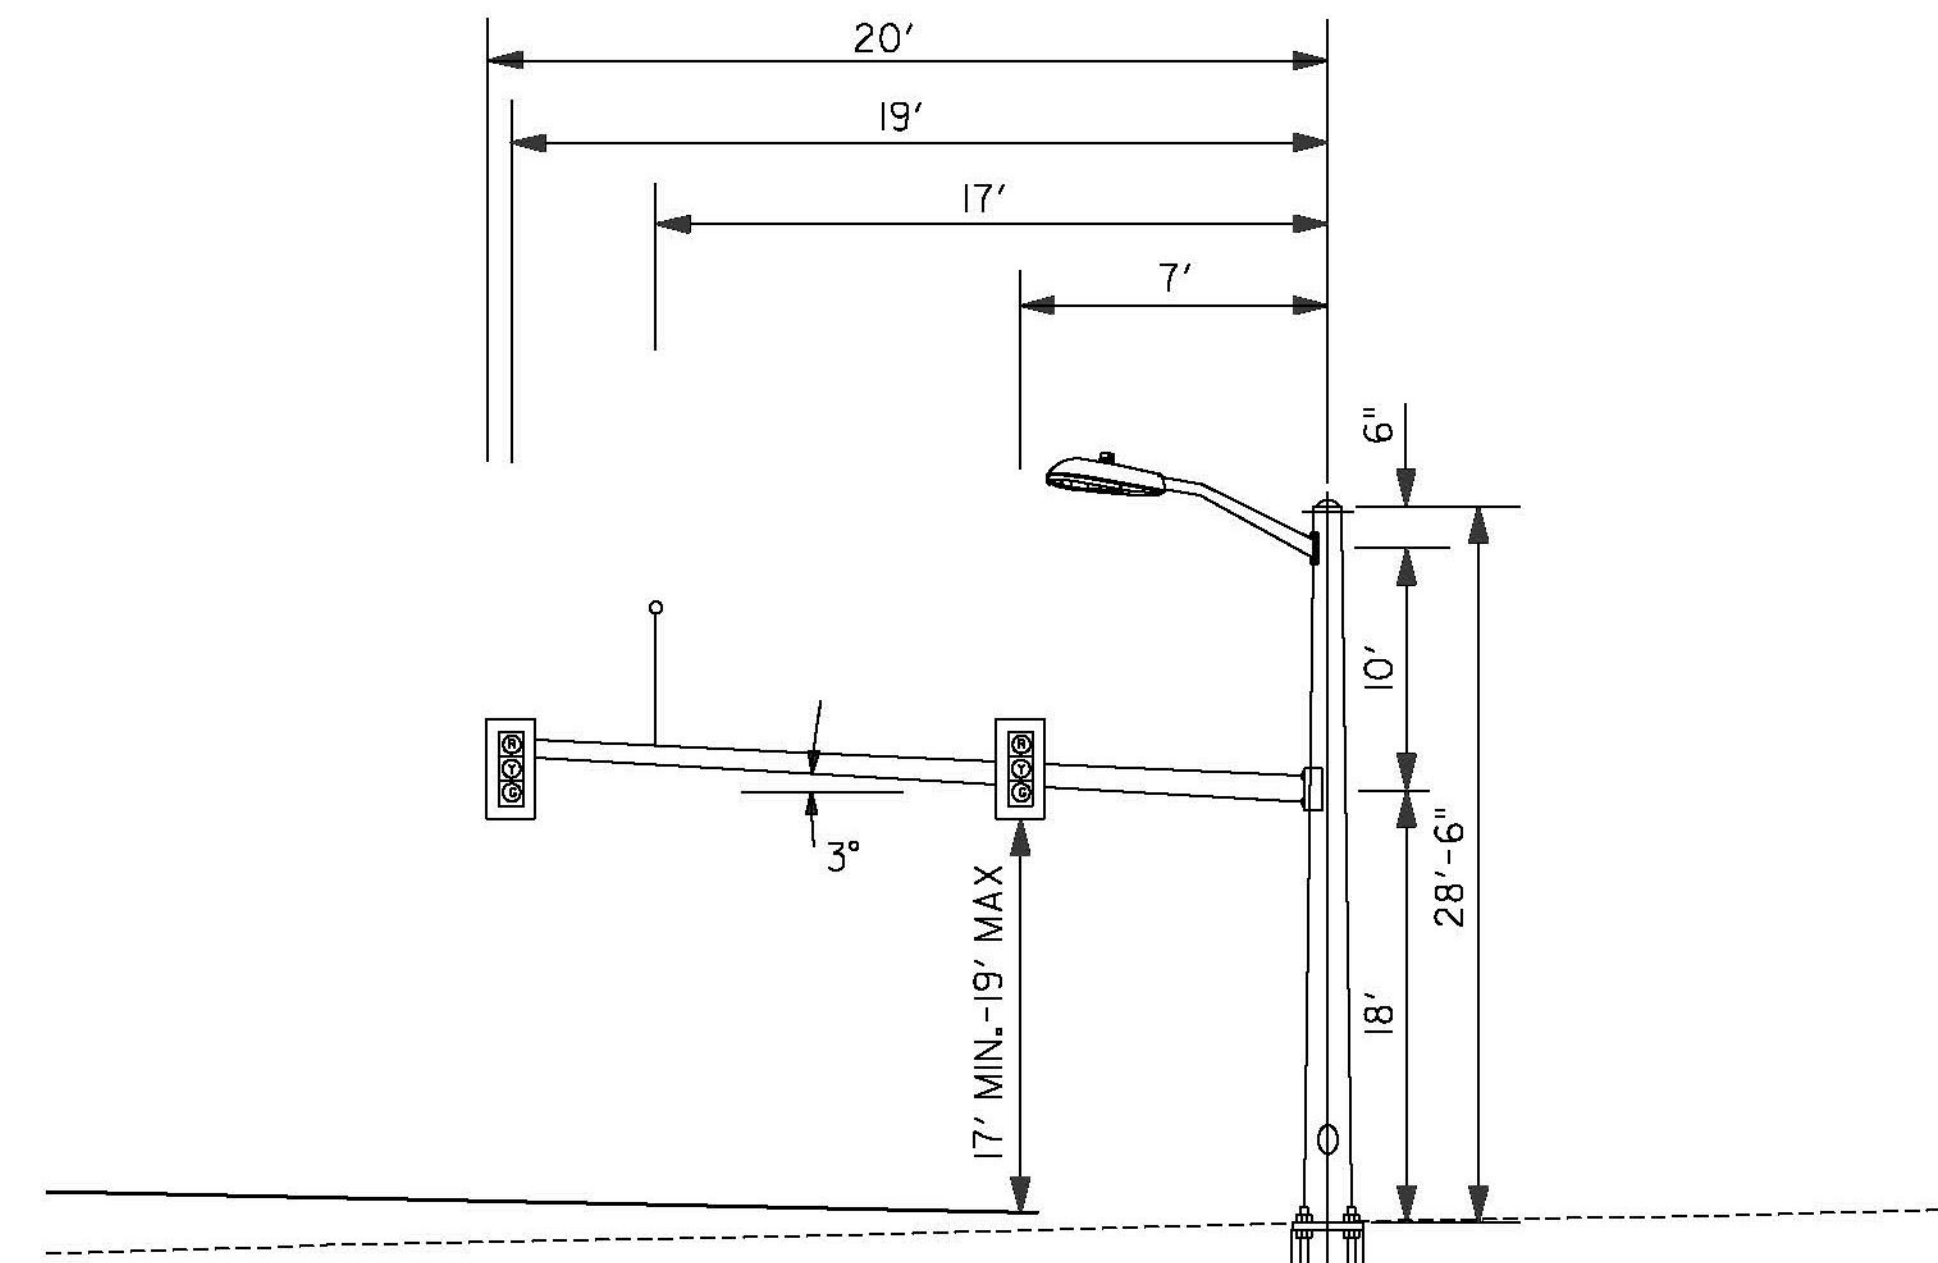


MP2A
N.T.S.

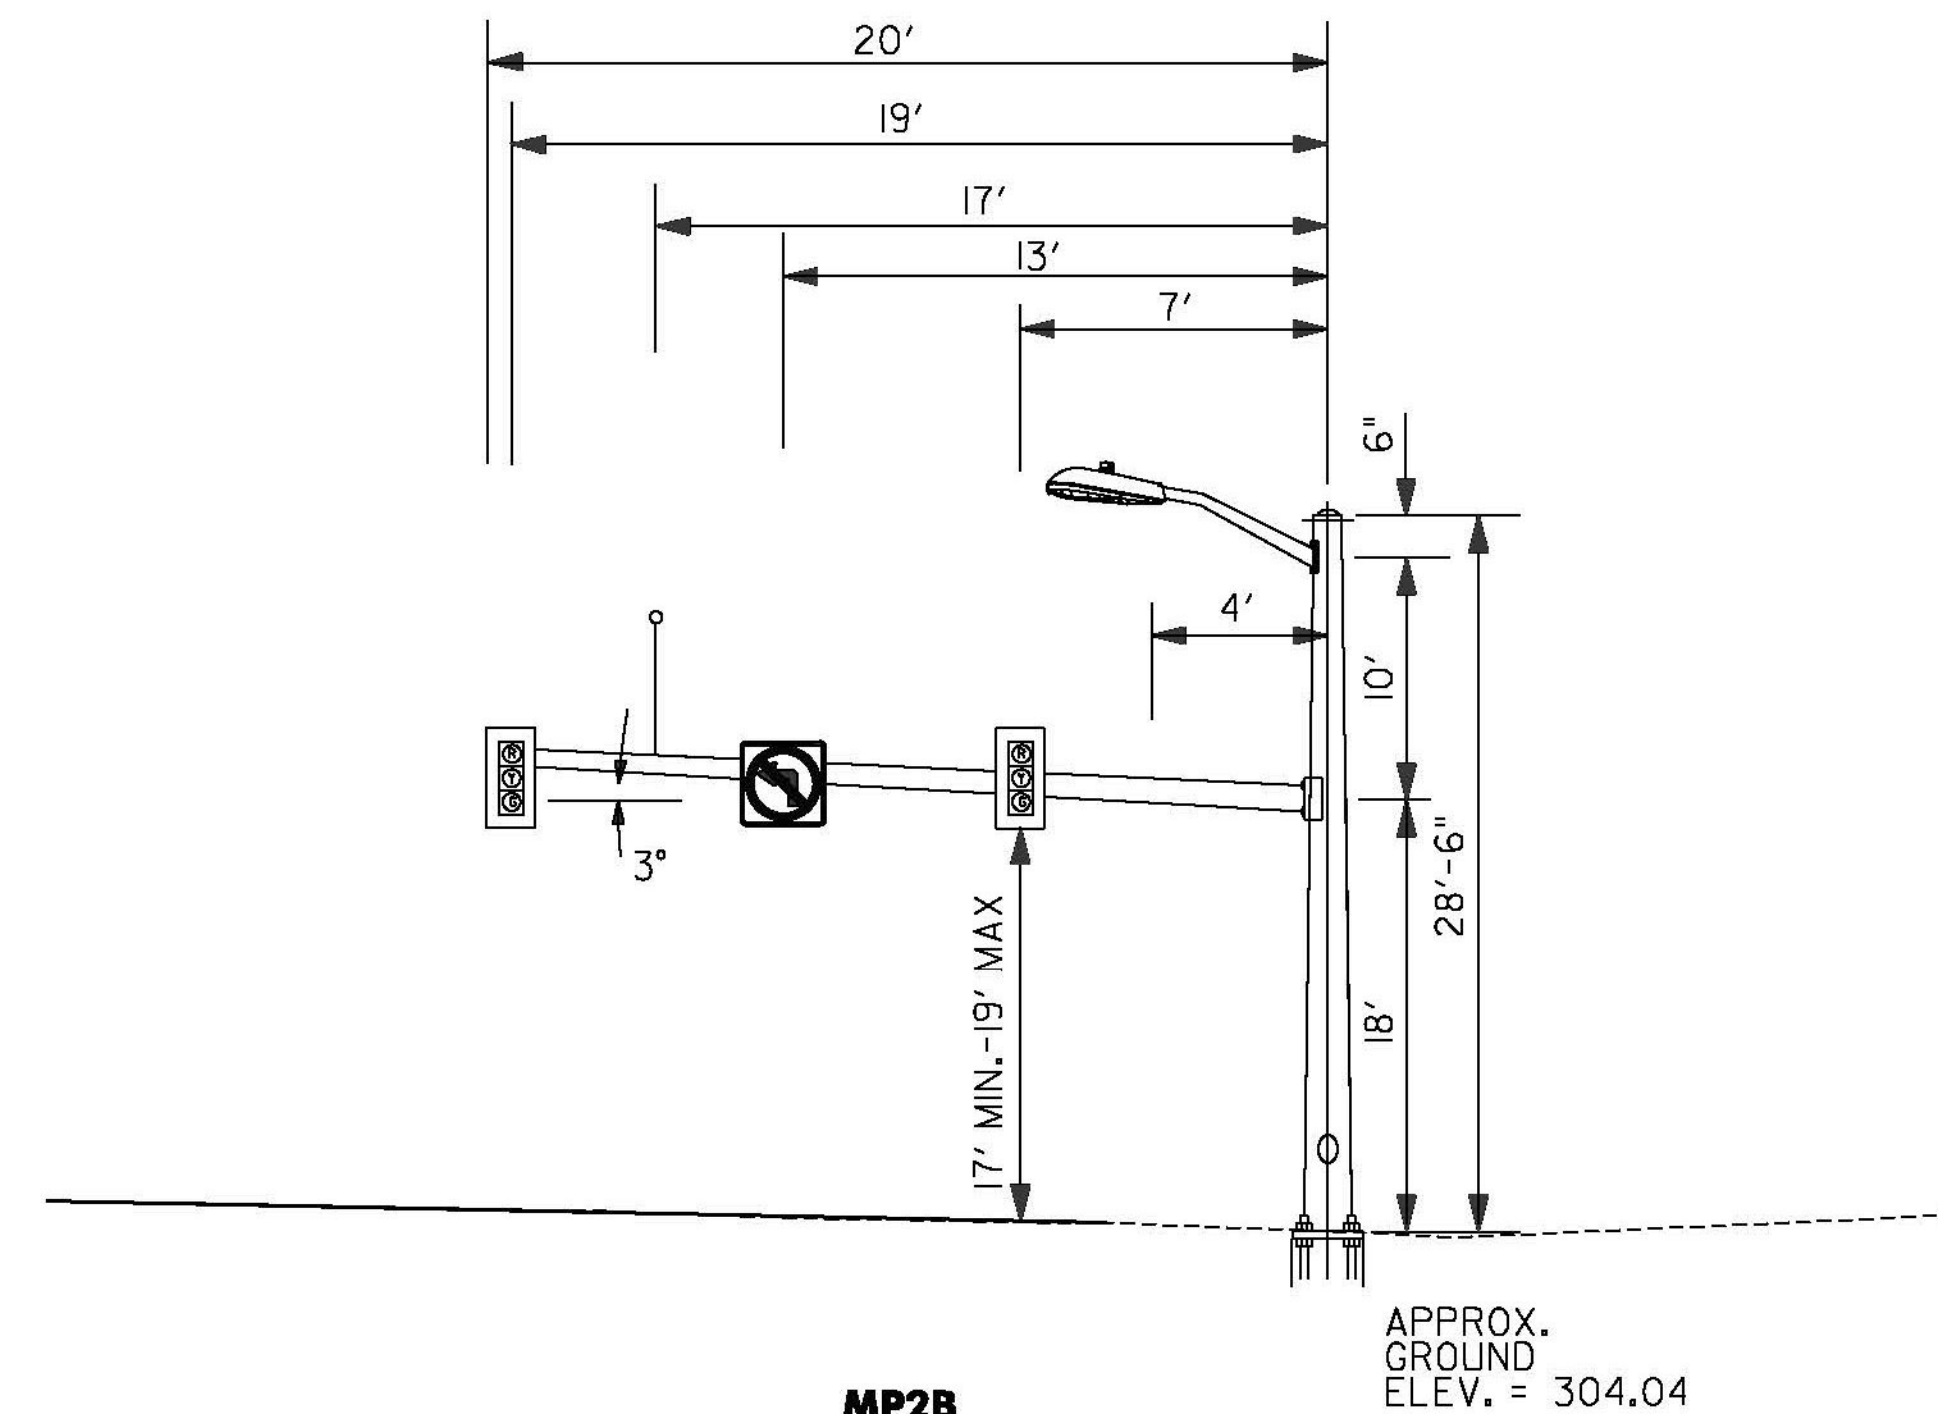

MP2B
N.T.S.

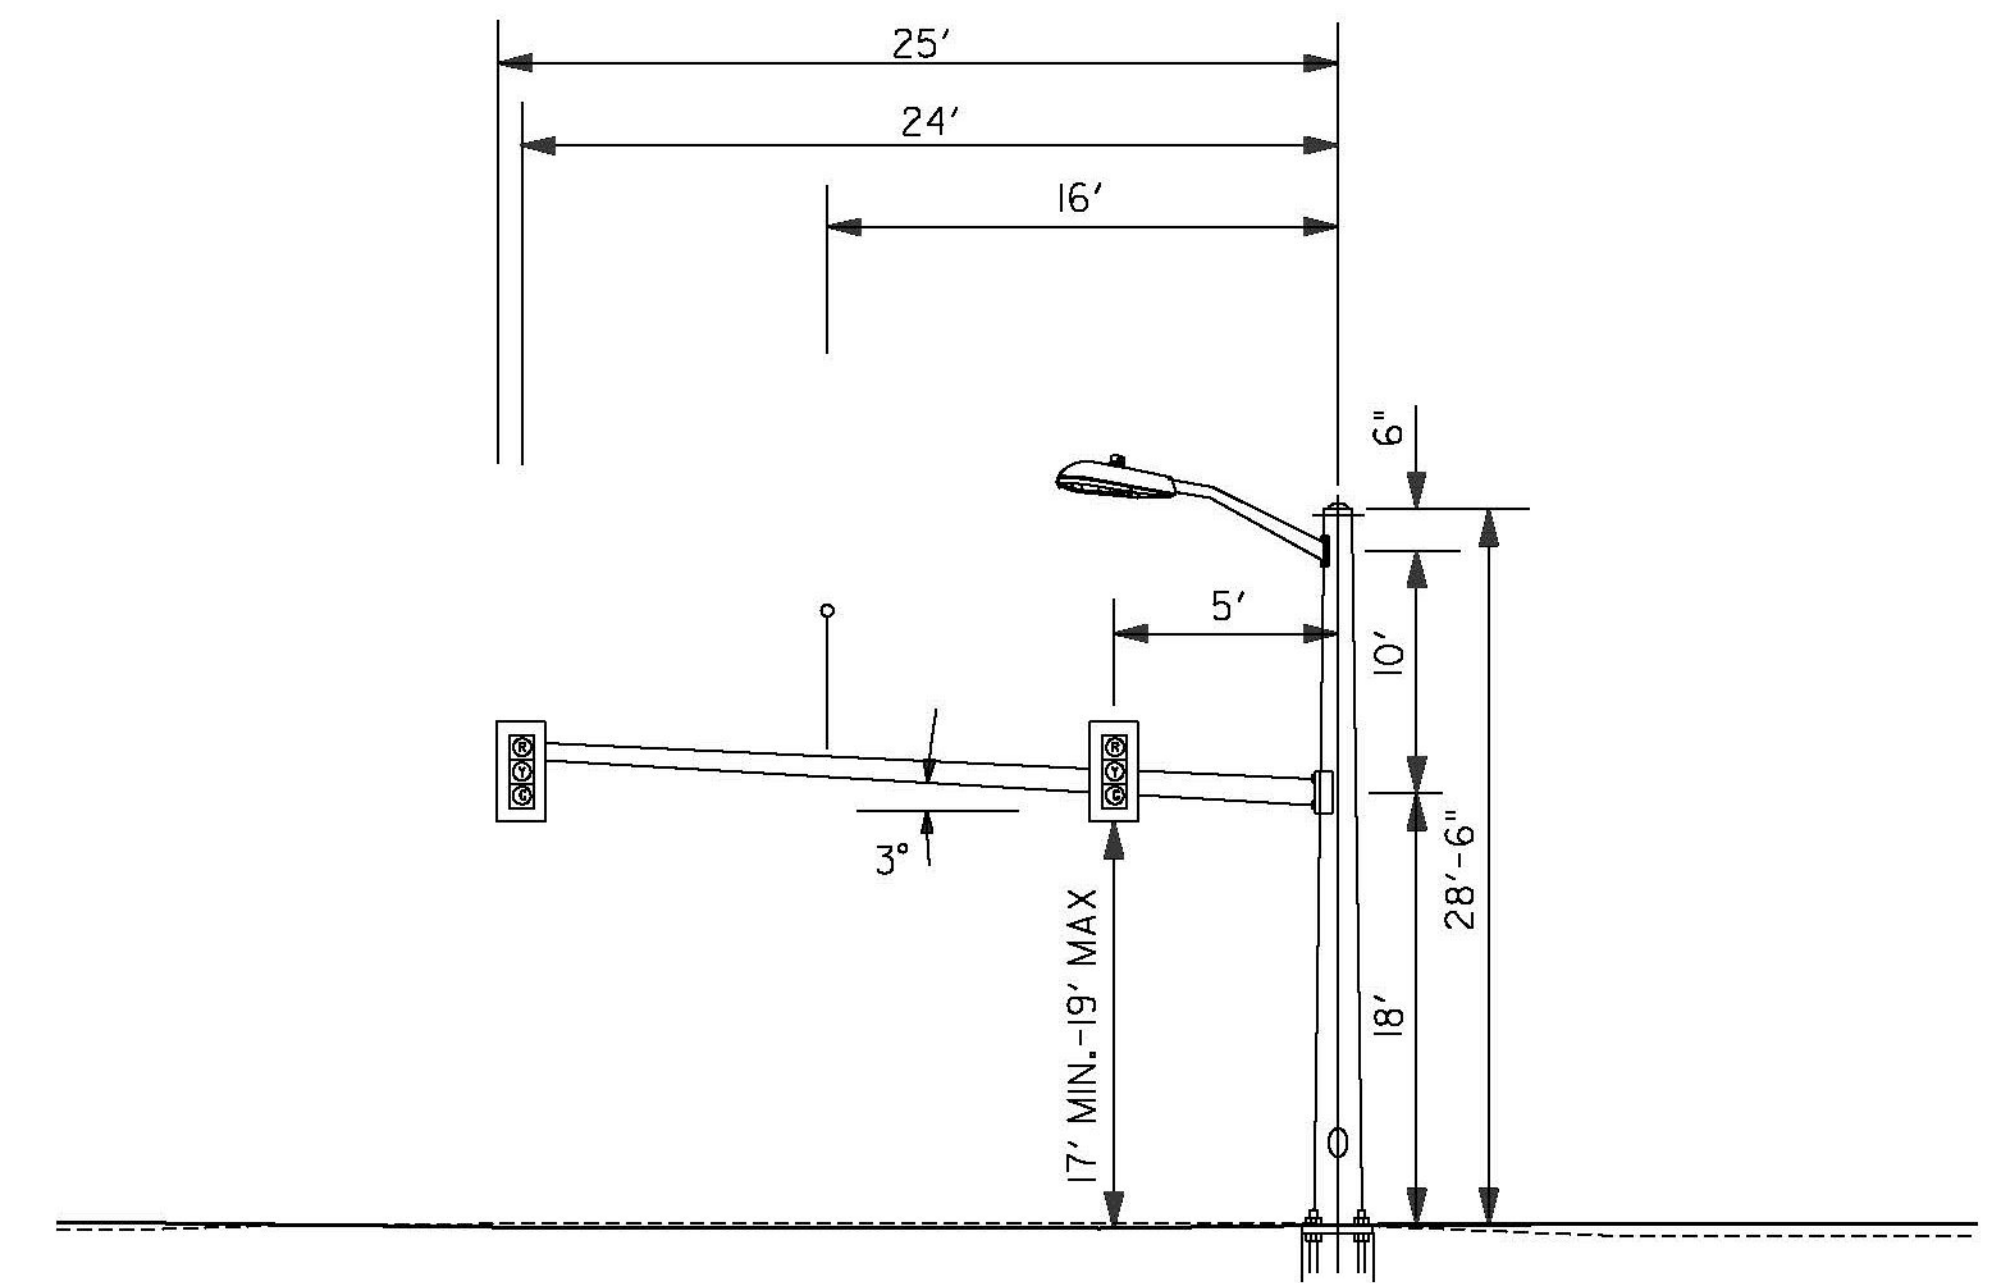

MP2C
N.T.S.

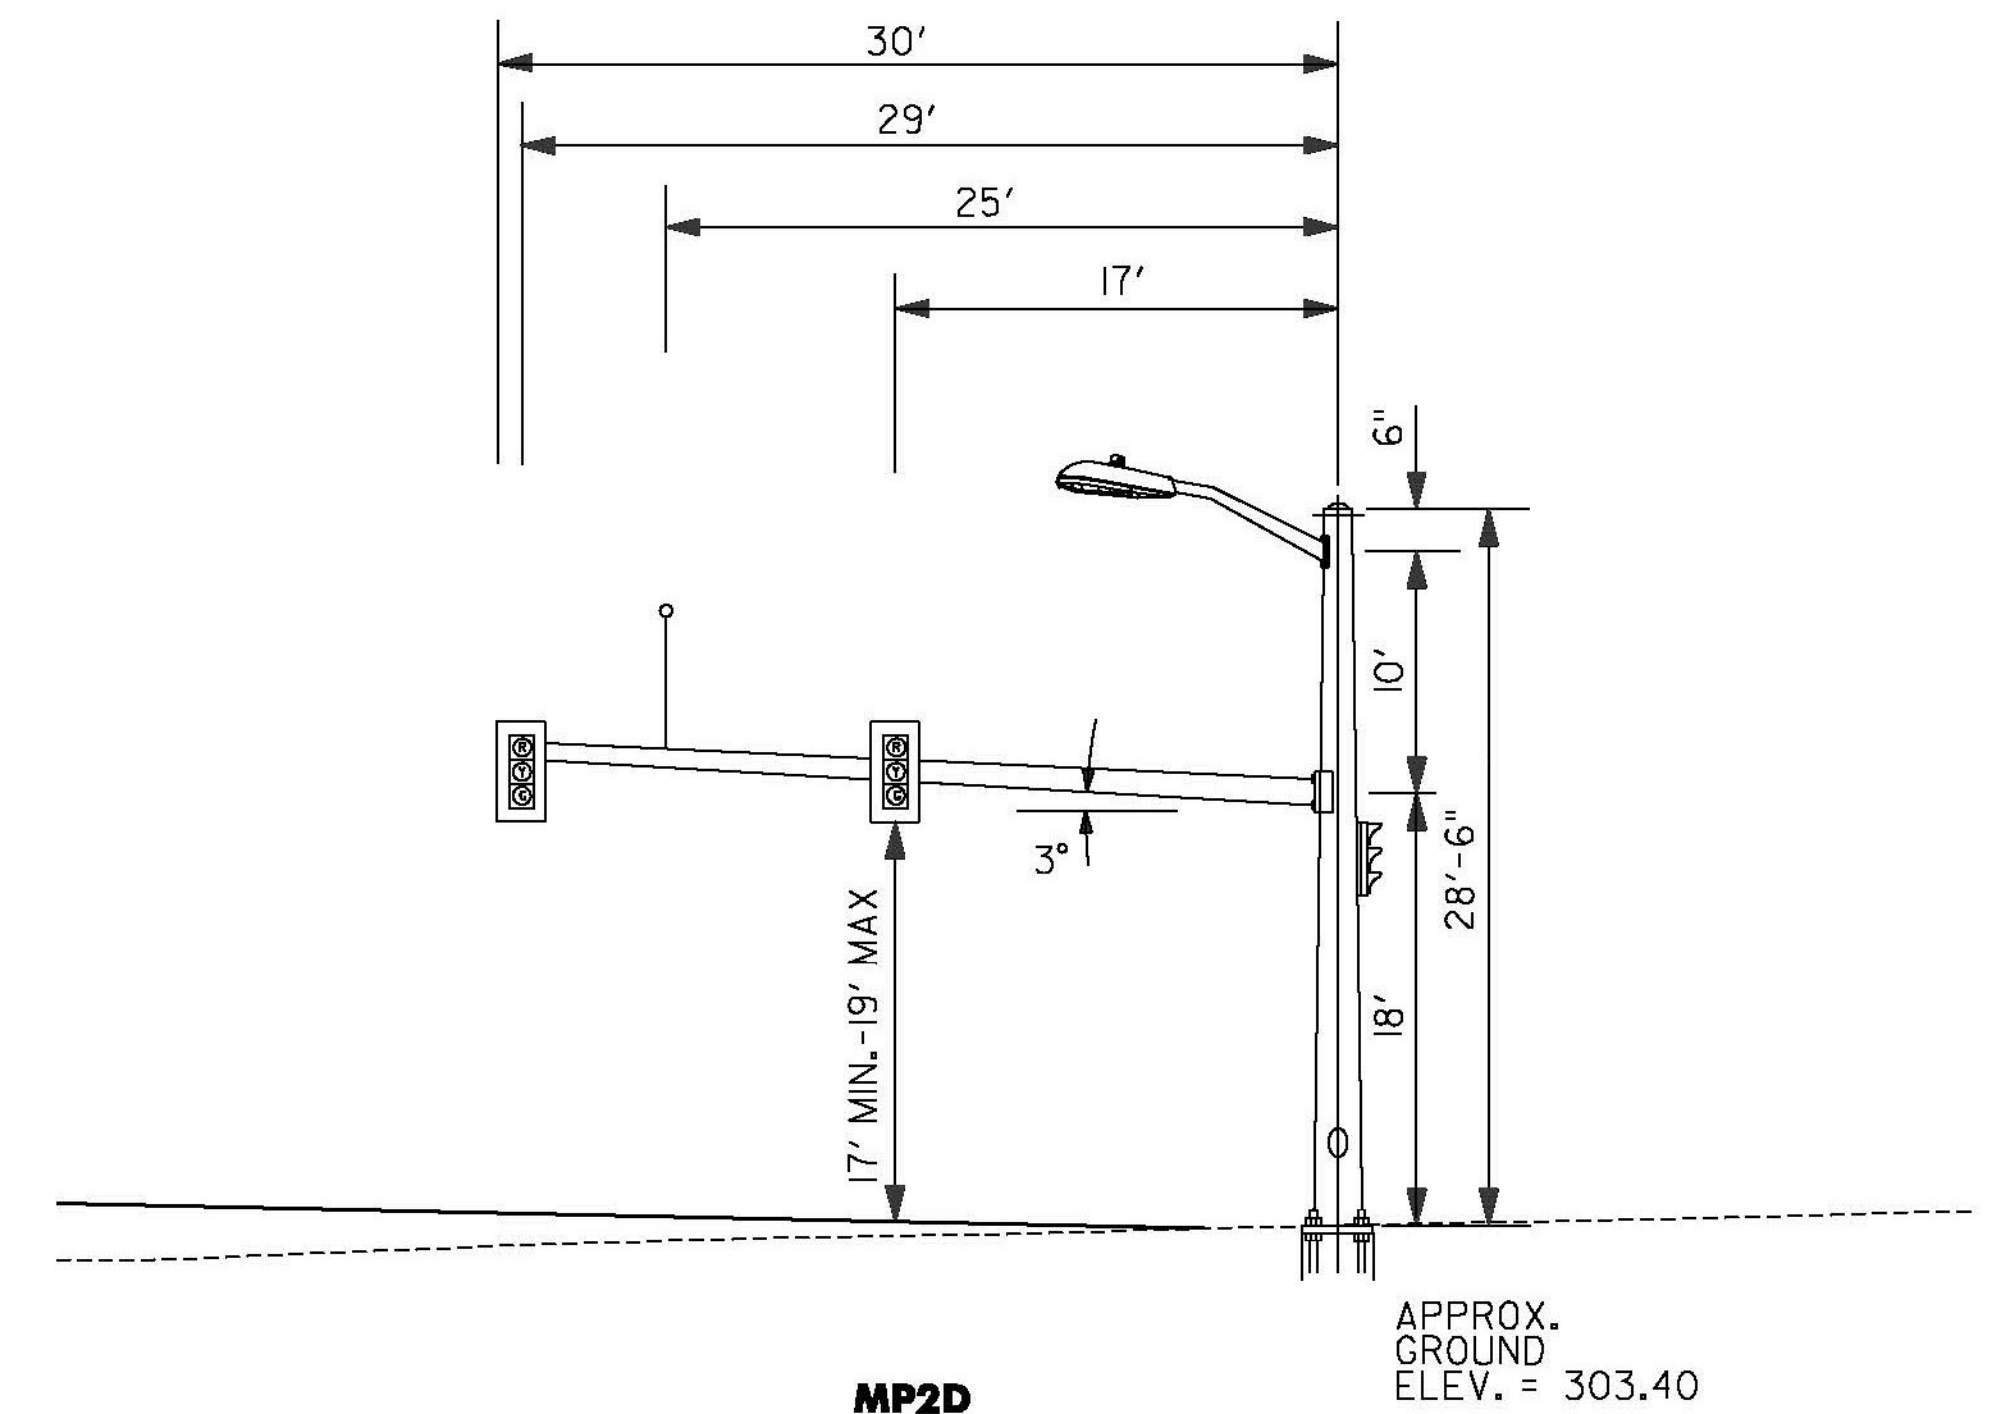

MP2D
N.T.S.

PROJECT NAME: RICHMOND
PROJECT NUMBER: STP 0284 (17)

FILE NAME: z97cl86trfbd2.dgn	PLOT DATE: 5/2/2013
PROJECT LEADER: JEFFREY MAXTUTIS	DRAWN BY: Y.CAO/LALMY
DESIGNED BY: J.SOBEL	CHECKED BY: D.FLYNN
TRAFFIC SIGNAL DETAIL SHEET 3	SHEET 73 OF 133