

**SEED**  
 US RTE 2 10+00 RT - 10+48 RT  
 US RTE 2 13+83 RT - 15+00 RT  
 US RTE 2 14+09 LT - 15+00 RT


**HAY MULCH**  
 US RTE 2 10+00 RT - 10+48 RT  
 US RTE 2 13+83 RT - 15+00 RT  
 US RTE 2 14+09 LT - 15+00 RT

**BARRIER FENCE**  
 I-89 RAMP "C" 40+86 RT - 41+50 RT

**SEED, WINTER RYE**  
 US RTE 2 10+00 RT - 10+48 RT  
 US RTE 2 13+83 RT - 15+00 RT  
 US RTE 2 14+09 LT - 15+00 RT

**TOP SOIL**  
 US RTE 2 10+00 RT - 10+48 RT  
 US RTE 2 13+83 RT - 15+00 RT  
 US RTE 2 14+09 LT - 15+00 RT

**PROJECT DEMARICATION FENCE**  
 US RTE 2 10+00 RT - 10+15 RT  
 I-89 RAMP "C" 40+86 RT - US RTE 2 10+15 LT

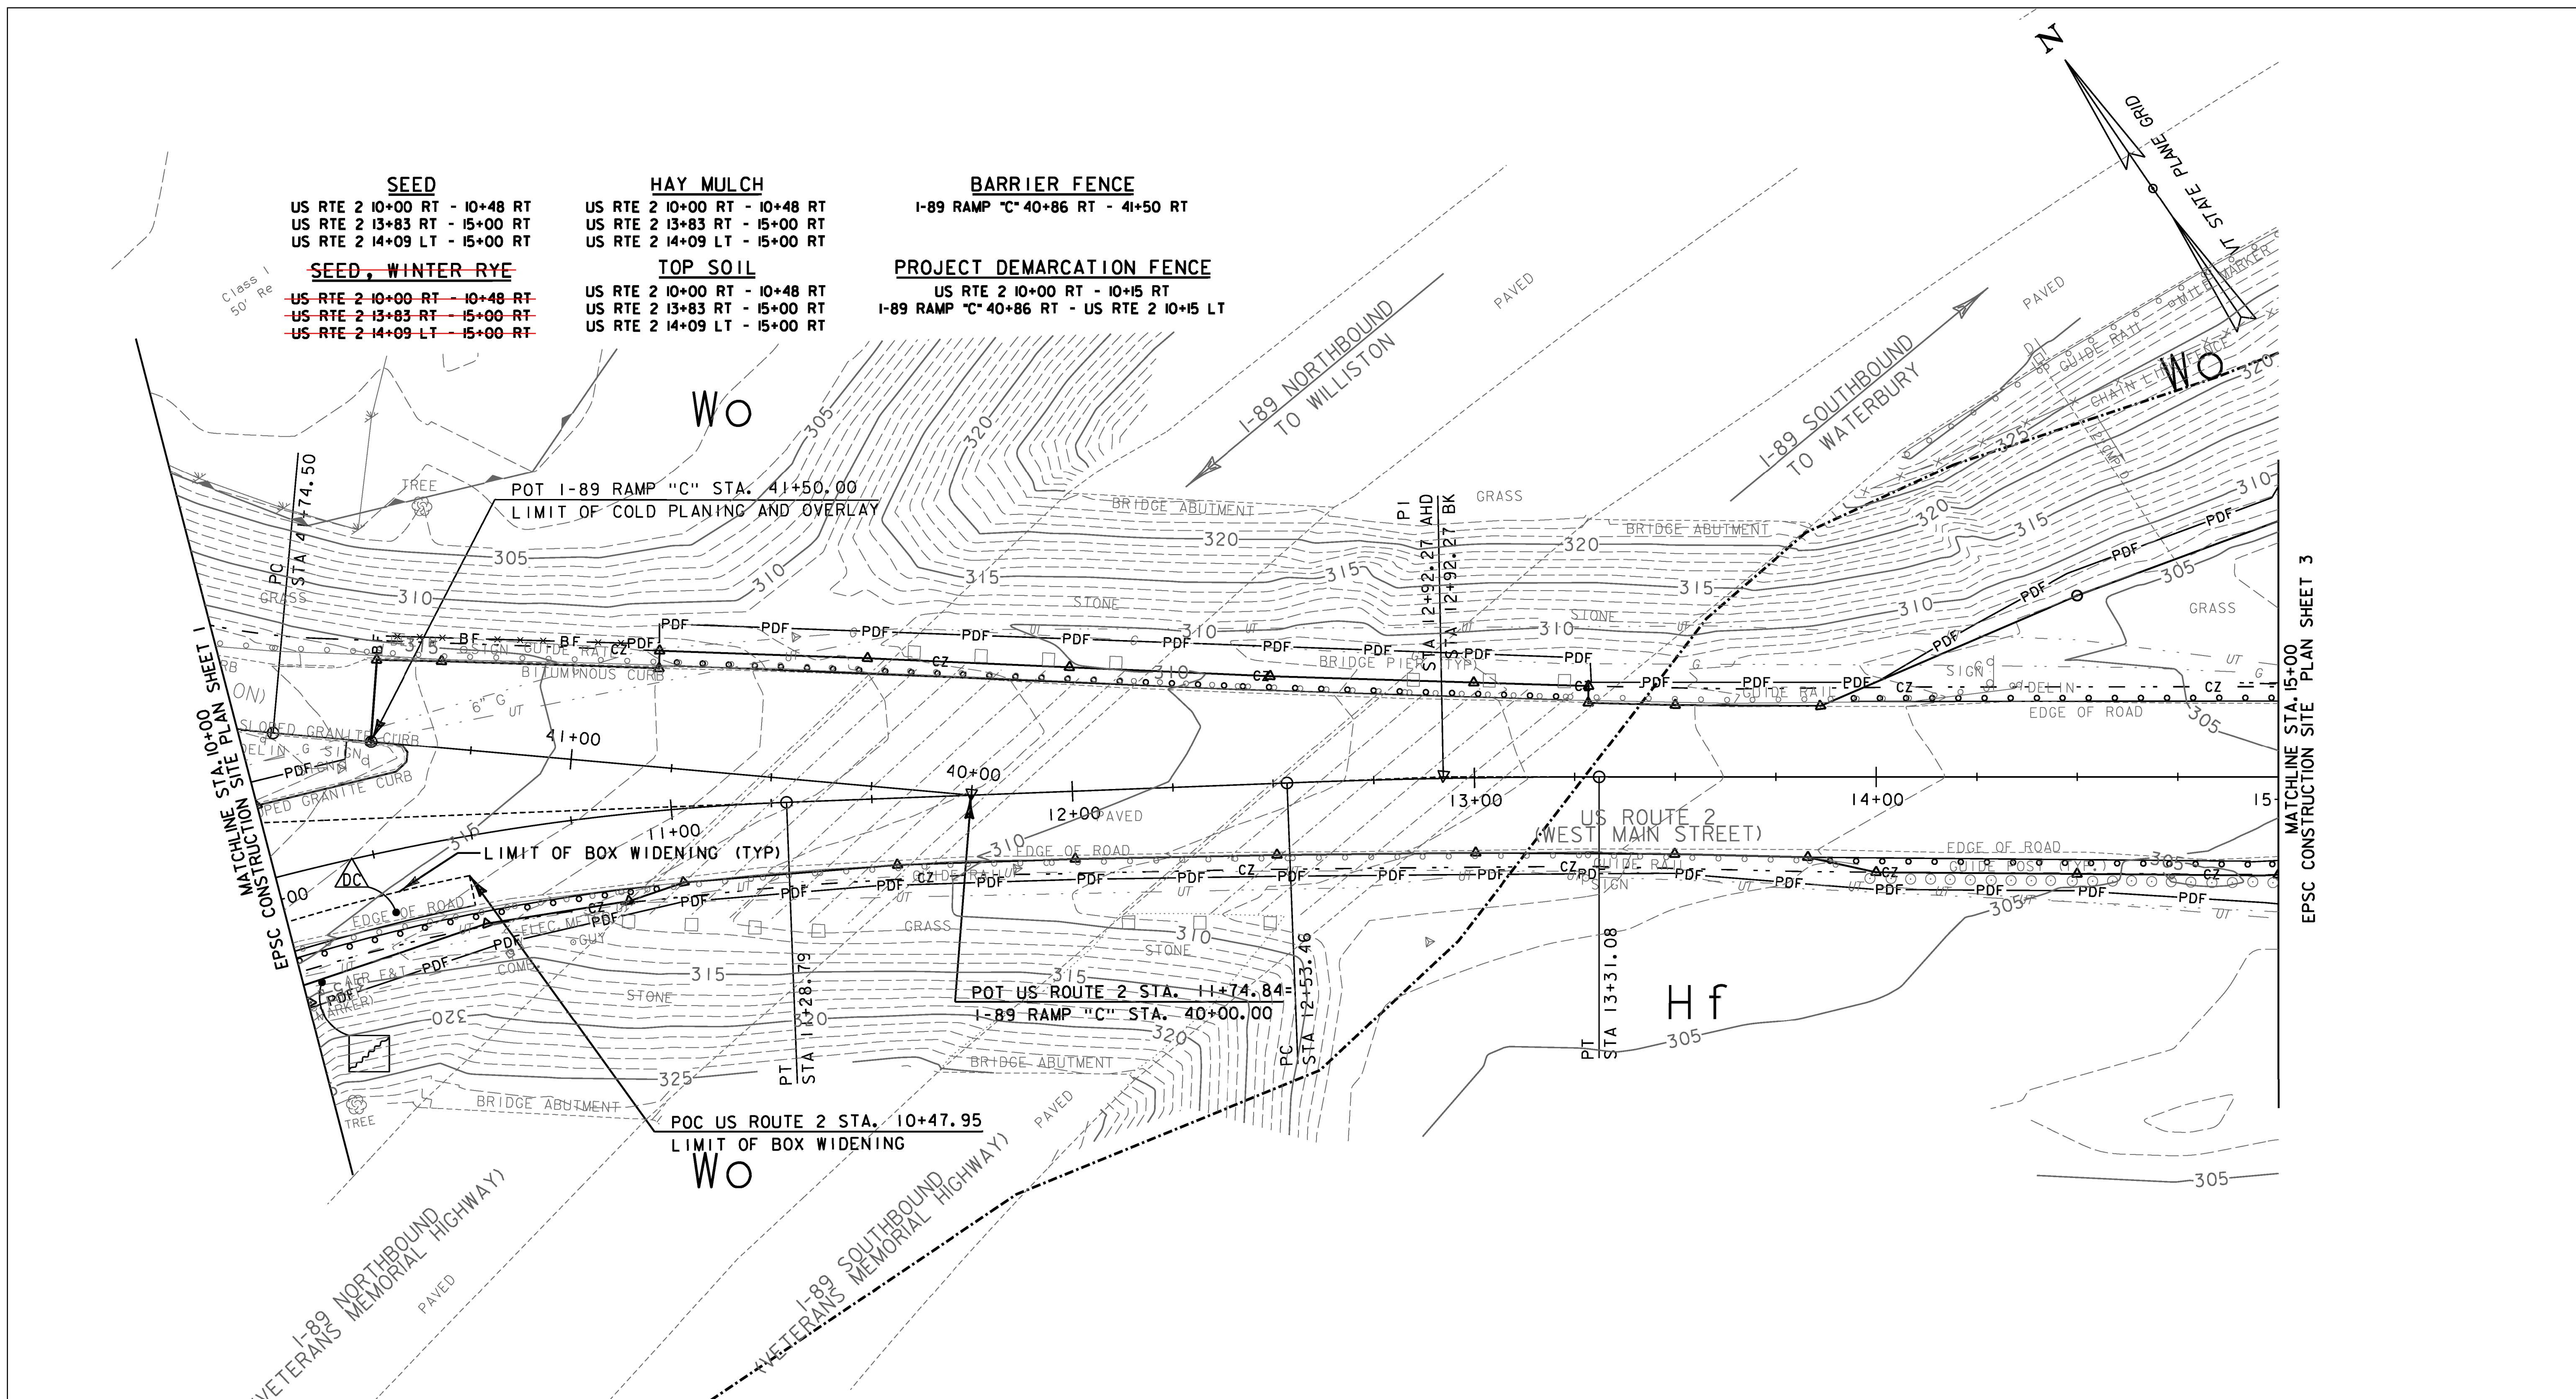

**LEGEND**

--- 300 ---	5' INTERVAL PROPOSED CONTOUR		SURFACE ROUGHENING		PIPE INLET PROTECTION
--- 1' ---	1' INTERVAL PROPOSED CONTOUR		SILT FENCE		FILTER FABRIC DROP INLET PROTECTION
--- 300 ---	5' INTERVAL EXISTING CONTOUR		SILT FENCE WOVEN WIRE		BF - BARRIER FENCE
--- 1' ---	1' INTERVAL EXISTING CONTOUR		ROLLED EROSION CONTROL PRODUCT, DITCH/SIDESLOPE		PDF - PROJECT DEMARICATION FENCE
---	EXIST. PROPERTY/ROW LINE		STABILIZED CONSTRUCTION ENTRANCE (SEE TRAFFIC MANAGEMENT PLANS)		DUST CONTROL
○-△	LIMIT OF WORK (LIMIT OF DISTURBANCE)				

NOTE:  
 SEE EPSC NARRATIVE FOR ADDITIONAL REQUIREMENTS.



PROJECT NAME:	RICHMOND	PLOT DATE:	4/29/2013
PROJECT NUMBER:	STP 0284 (17)	DRAWN BY:	A. ACHARYA
FILE NAME:	z97cl86eccsbdr.dgn	CHECKED BY:	E. ATKINS
PROJECT LEADER:	ERIK ATKINS	SHEET	19 OF 133
DESIGNED BY:	T. BIGELOW		
EPSC CONSTRUCTION SITE PLAN SHEET 2			