


**GEOTEXTILE FOR SILT FENCE,
WOVEN WIRE REINFORCED**
US RTE 2 20+00 RT - 21+05 RT
SEED
US RTE 2 20+00 RT - 22+89 RT
SEED, WINTER RYE
~~US RTE 2 20+00 RT - 22+89 RT~~
HAY MULCH
US RTE 2 20+00 RT - 22+89 RT

TOP SOIL
US RTE 2 20+00 RT - 22+89 RT
BARRIER FENCE
US RTE 2 20+00 - 21+05 RT
US RTE 2 22+13 LT - 24+50 LT
PROJECT DEMARCATION FENCE
US RTE 2 20+00 - 21+50 LT
US RTE 2 21+05 - 24+50 RT


MATCHLINE STA. 20+00
EPSC CONSTRUCTION SITE PLAN SHEET 3

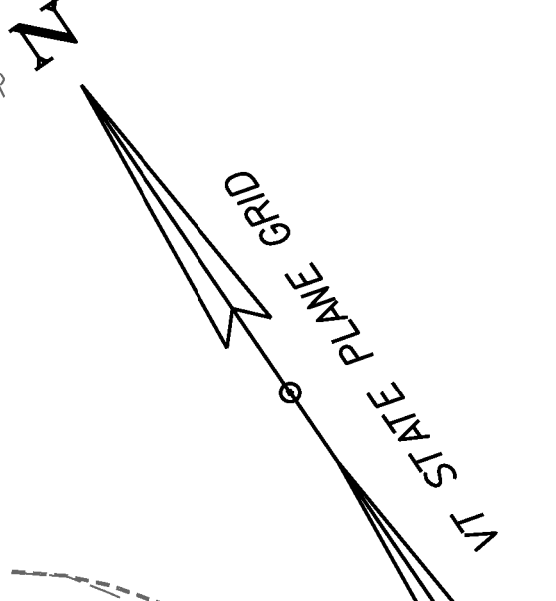

LEGEND

-----	SOIL TYPE BOUNDARY		SURFACE ROUGHENING		PIPE INLET PROTECTION
—300—	5' INTERVAL PROPOSED CONTOUR		SILT FENCE		FILTER FABRIC DROP INLET PROTECTION
- - - - -	1' INTERVAL PROPOSED CONTOUR		SILT FENCE WOVEN WIRE		-BF- BF- BARRIER FENCE
—300—	5' INTERVAL EXISTING CONTOUR		ROLLED EROSION CONTROL PRODUCT, DITCH/SIDESLOPE		-PDF- PDF- PROJECT DEMARCATION FENCE
- - - - -	1' INTERVAL EXISTING CONTOUR		STABILIZED CONSTRUCTION ENTRANCE (SEE TRAFFIC MANAGEMENT PLANS)		ΔC DUST CONTROL
—	EXIST. PROPERTY/ROW LINE				
○—△	LIMIT OF WORK (LIMIT OF DISTURBANCE)				

NOTE:
SEE EPSC NARRATIVE FOR ADDITIONAL REQUIREMENTS.

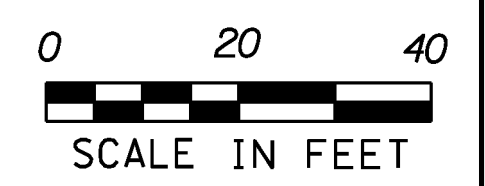

PROJECT NAME: RICHMOND
PROJECT NUMBER: STP 0284 (17)
FILE NAME: z97cl86eccsldr.dgn
PROJECT LEADER: ERIK ATKINS
DESIGNED BY: T.BIGELOW
EPSC CONSTRUCTION SITE PLAN SHEET 4
PLOT DATE: 4/29/2013
DRAWN BY: A. ACHARYA
CHECKED BY: E. ATKINS
SHEET 21 OF 133