

SEED, WINTER RYE  
 PNR 70+05 - 72+70 LT  
 PNR 74+48 - 76+25 LT  
 PNR 75+57 - 76+15 LT  
 PNR 70+50 - 72+19 LT  
 PNR 73+12 - 74+92 RT

SEED  
 PNR 70+00 LT - 76+46 LT  
 PNR 70+00 RT - 76+46 RT

SEED, WINTER RYE  
~~PNR 70+00 LT - 76+46 LT~~  
~~PNR 70+00 RT - 76+46 RT~~

HAY MULCH  
 PNR 70+00 LT - 76+46 LT  
 PNR 70+00 RT - 76+46 RT

TOP SOIL  
 PNR 70+00 LT - 76+46 LT  
 PNR 70+00 RT - 76+46 RT



TEMPORARY EROSION MATTING  
 PNR 70+50 LT - 76+05 LT

PERMANENT EROSION MATTING  
 PNR 70+47 LT - 72+26 LT  
 PNR 73+41 LT - 76+18 LT  
 PNR 74+23 RT - 76+18 RT


INLET PROTECTION DEVICE, TYPE I  
 (STAKED FABRIC)  
 PNR 75+56 RT

INLET PROTECTION DEVICE, TYPE I  
 (PIPE INLET PROTECTION)  
 PNR 75+56 RT

PROJECT DEMARCATION FENCE  
 PNR 70+00 LT - 76+50 RT

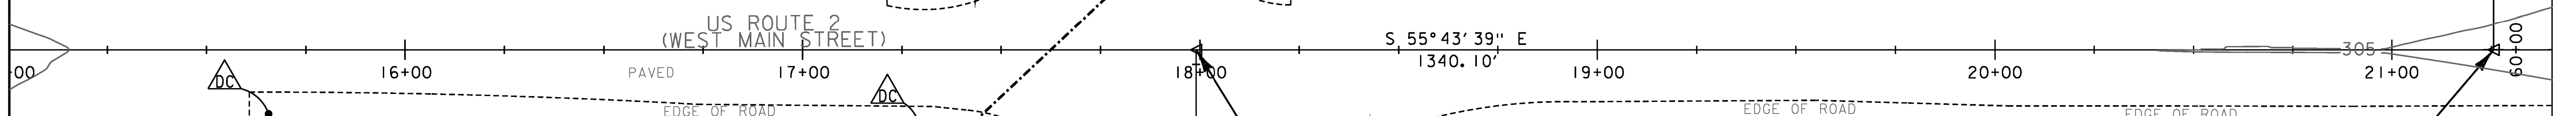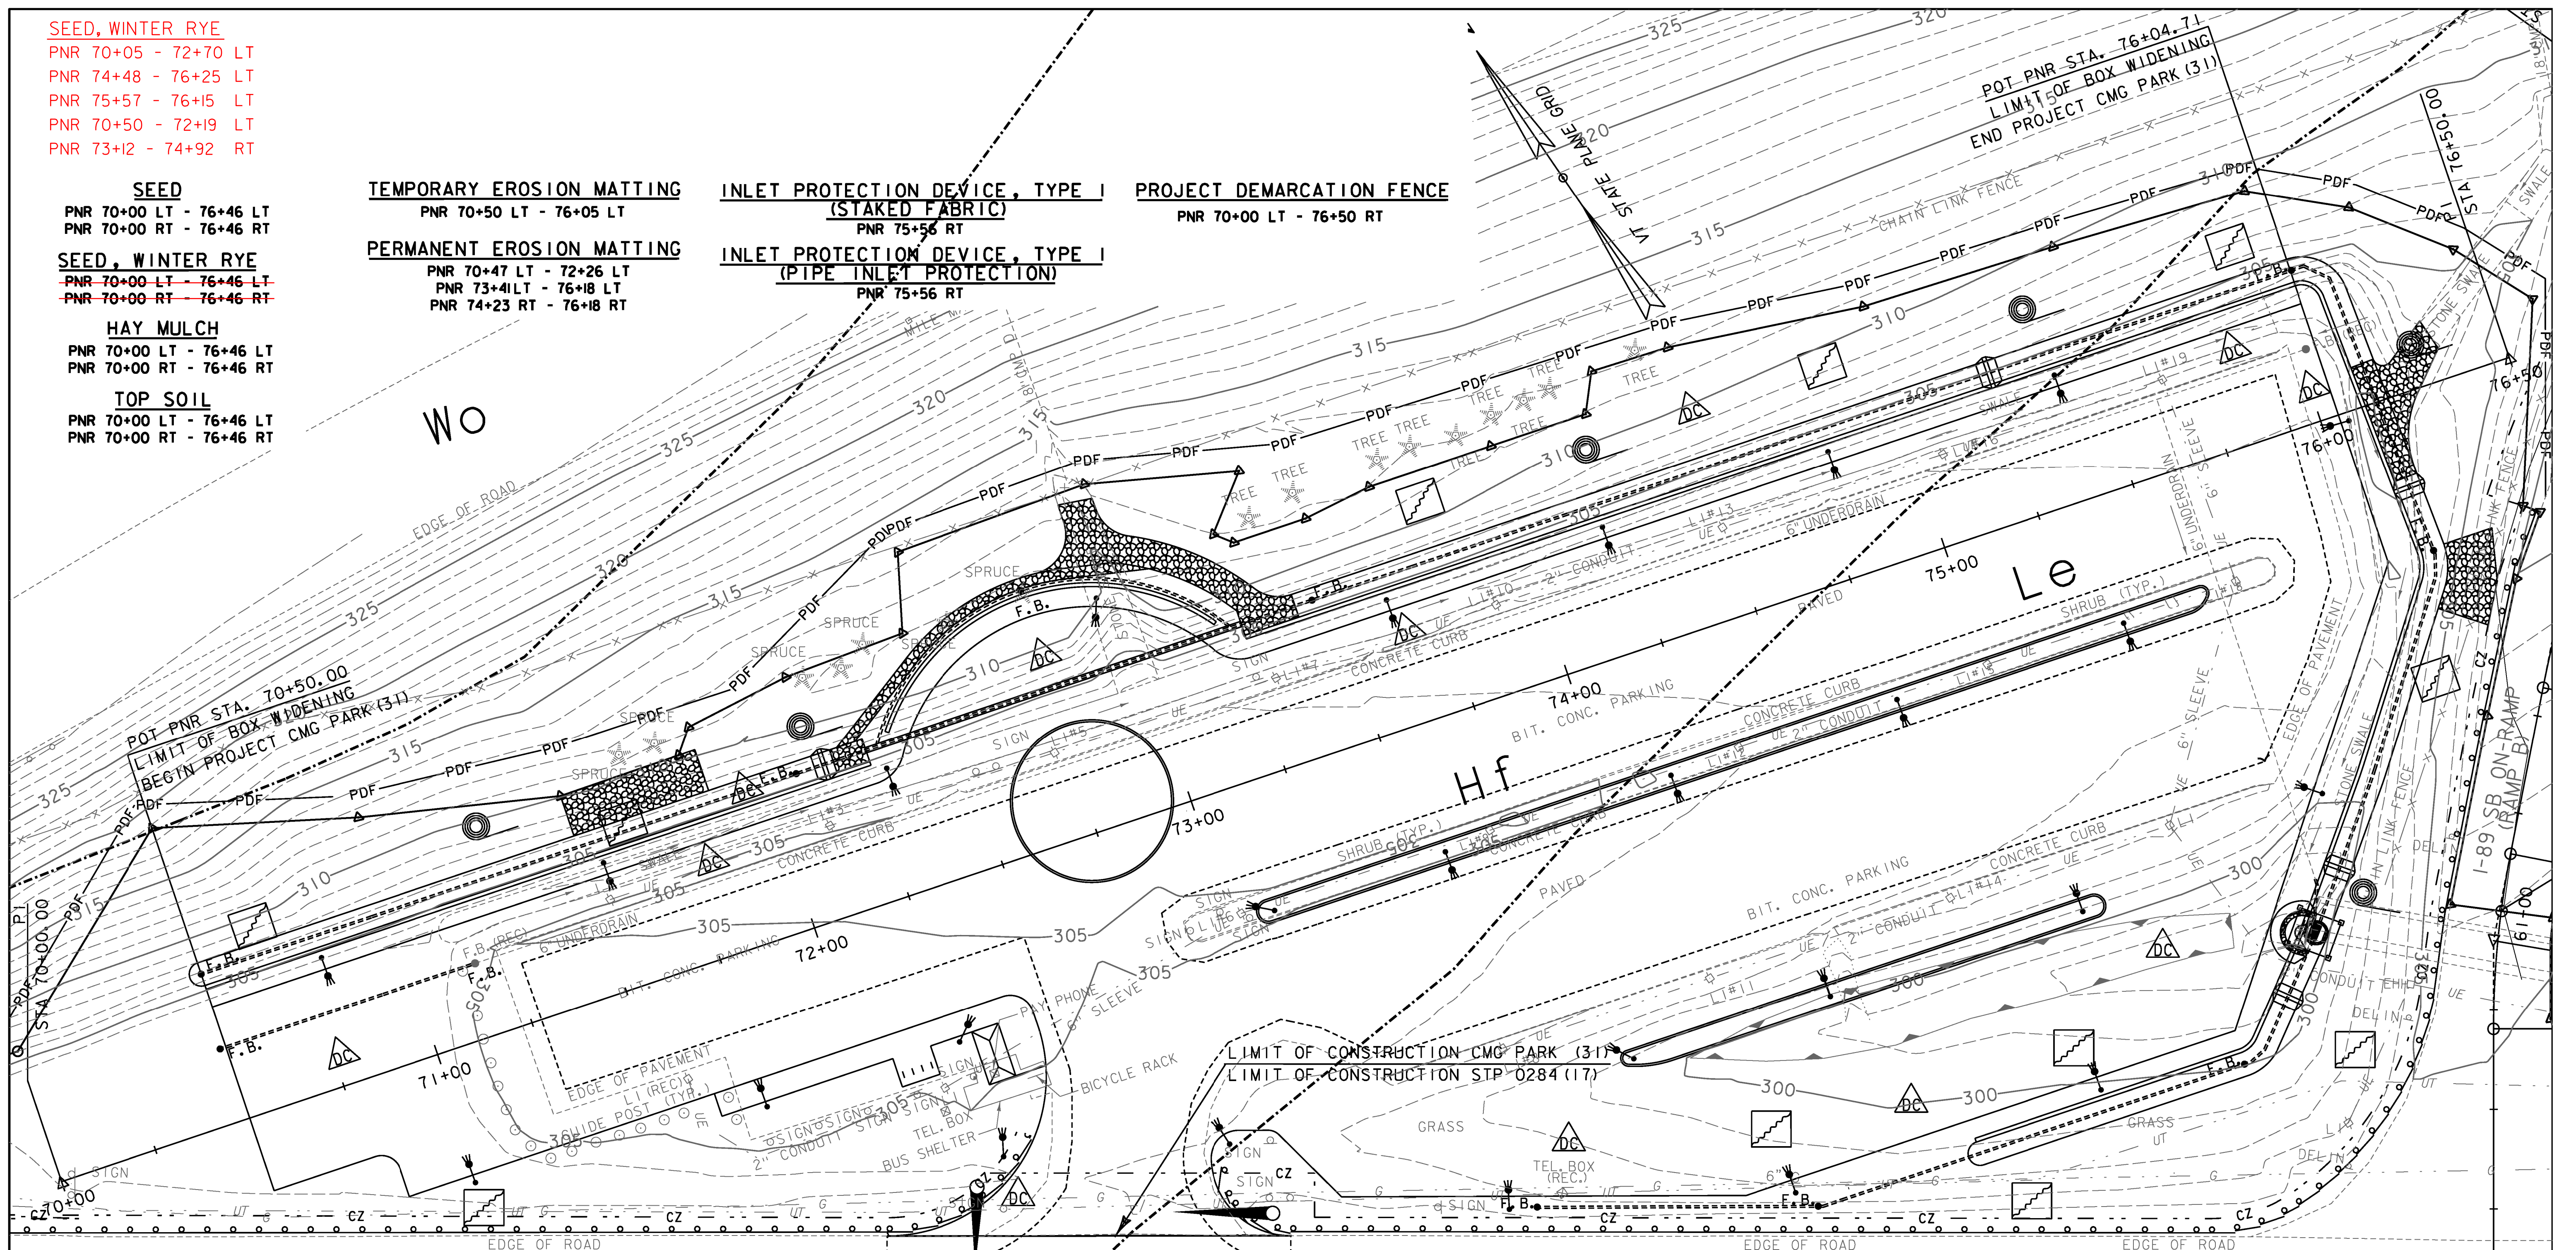

NOTE:  
 SEE EPSC NARRATIVE FOR ADDITIONAL REQUIREMENTS.

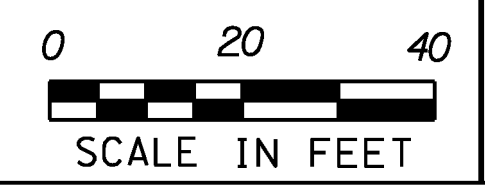

PROJECT NAME: RICHMOND  
 PROJECT NUMBER: CMG PARK (31)  
 FILE NAME: z97c186eccsbdr.dgn  
 PROJECT LEADER: ERIK ATKINS  
 DESIGNED BY: T.BIGELOW  
 EPSC CONSTRUCTION SITE PLAN SHEET 5  
 PLOT DATE: 4/29/2013  
 DRAWN BY: A. ACHARYA  
 CHECKED BY: E. ATKINS  
 SHEET 22 OF 133