



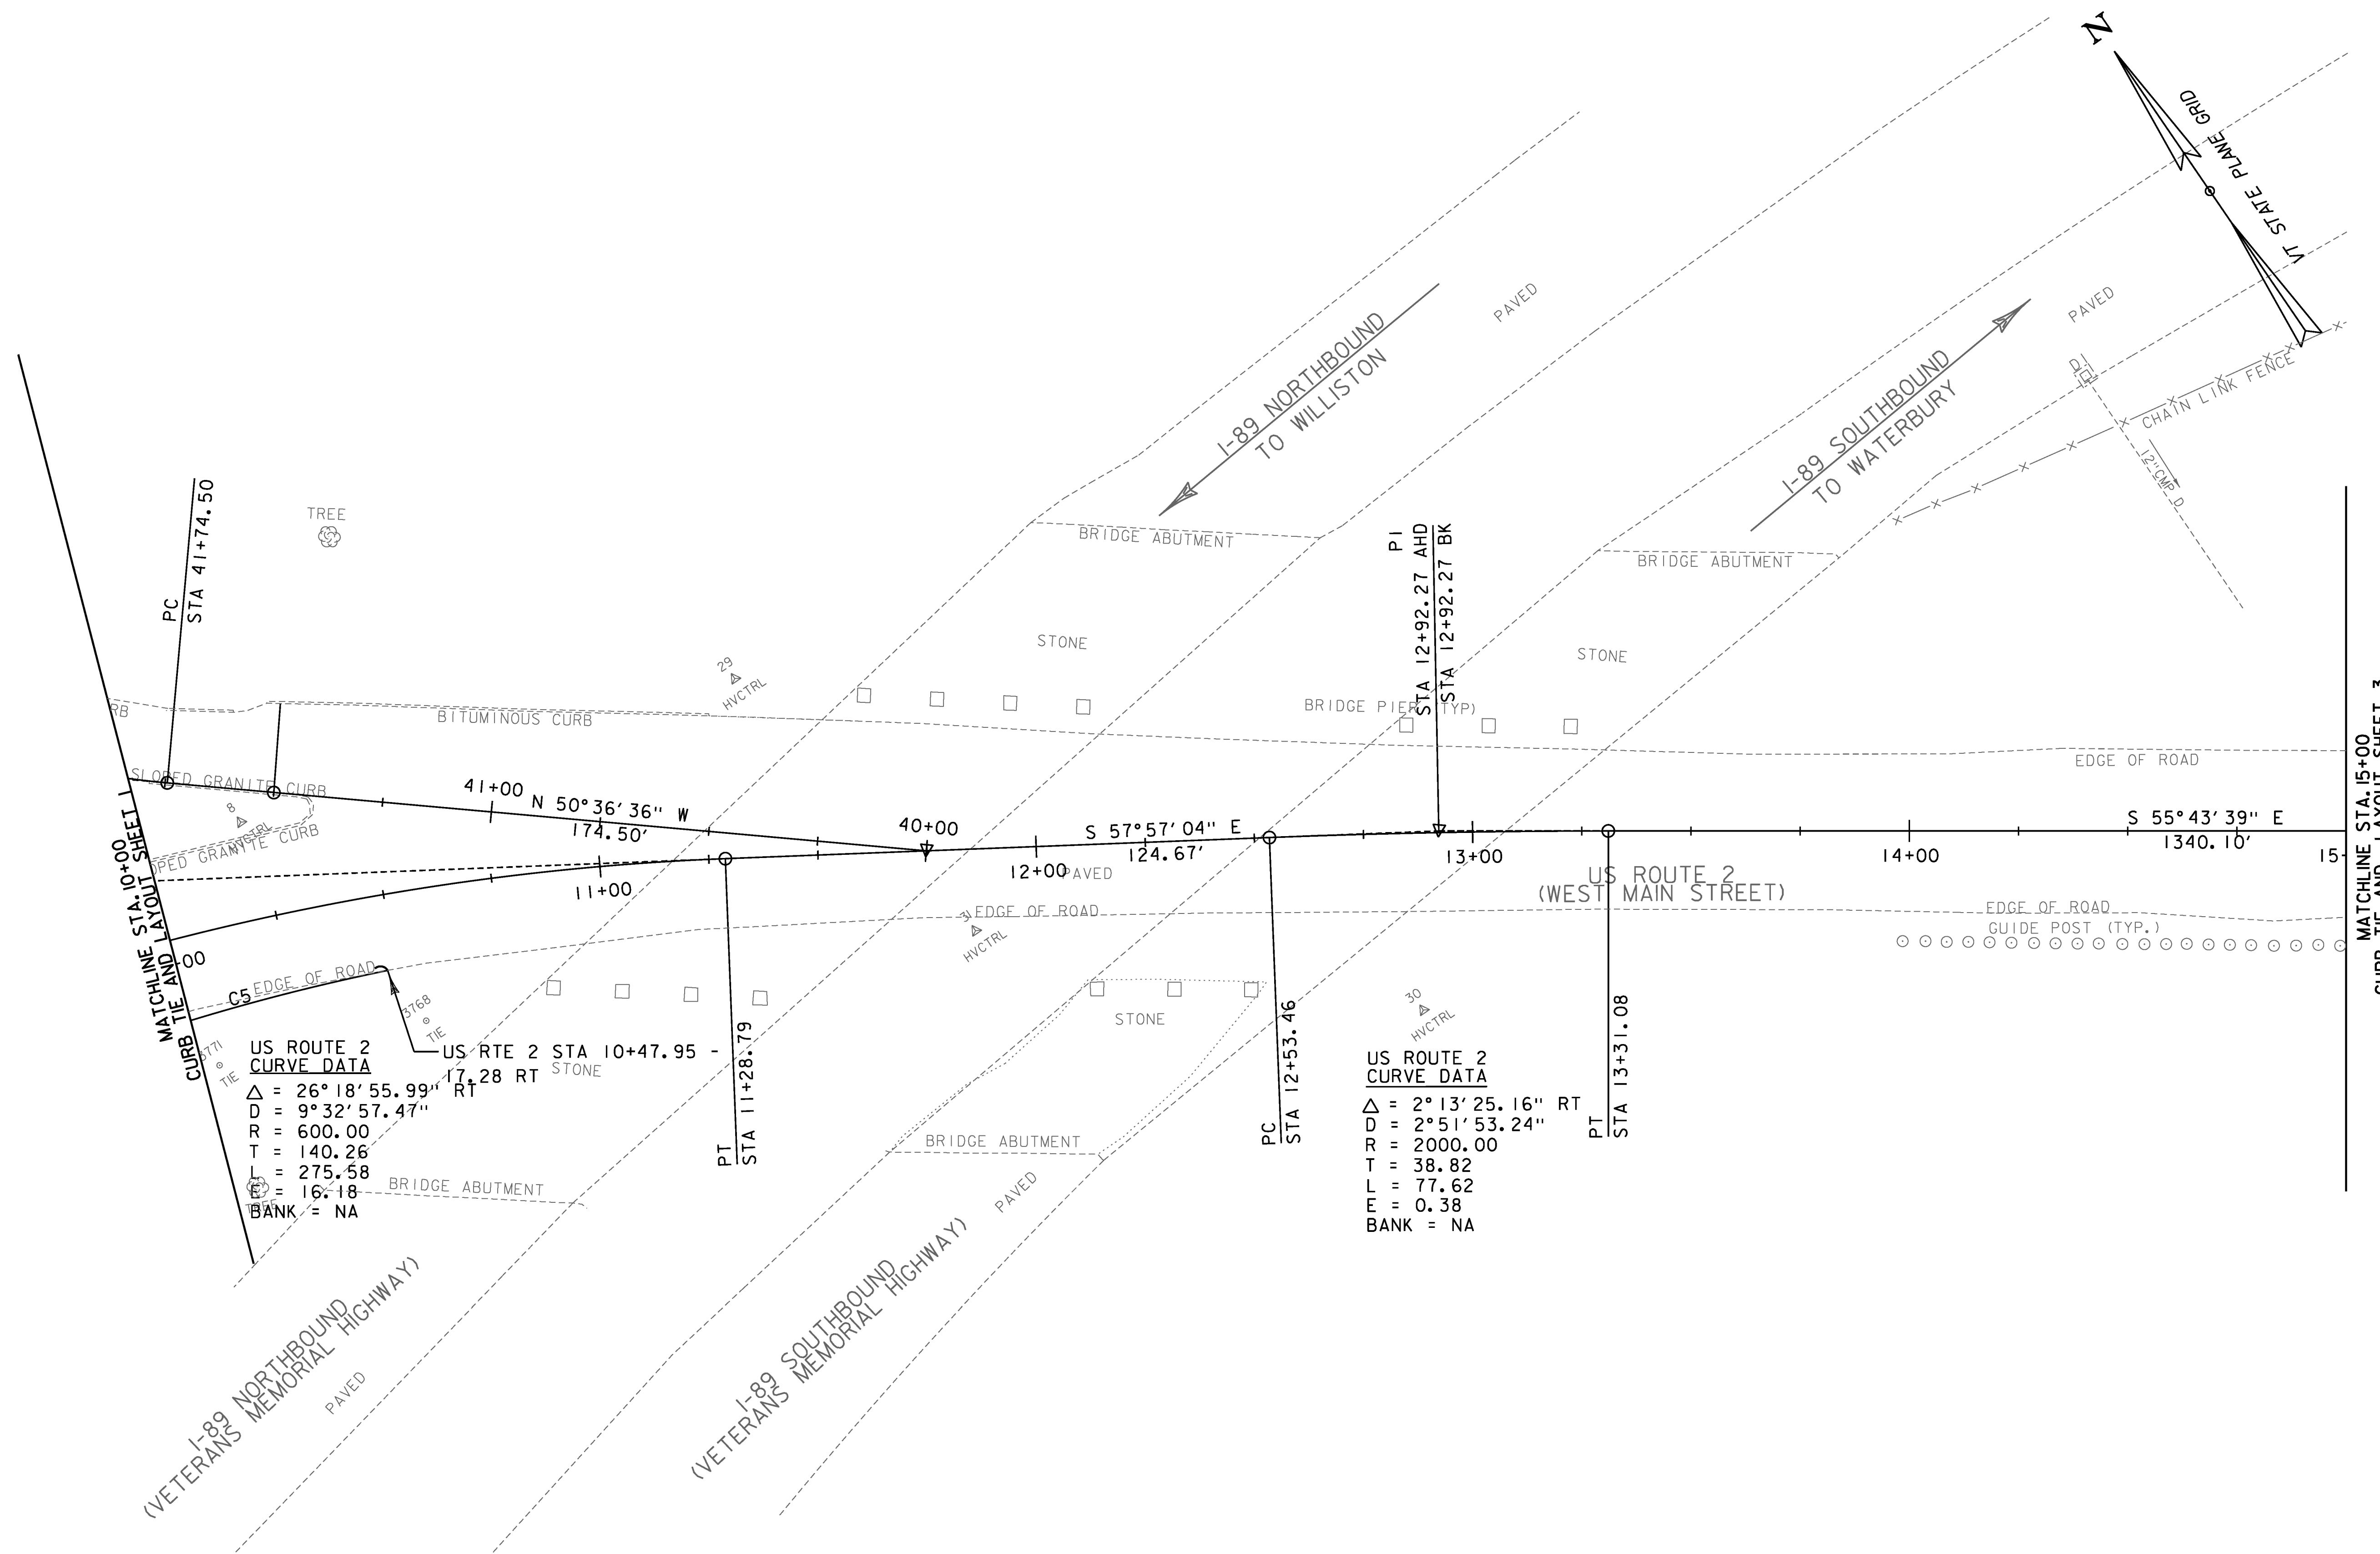

CURVE TABLE		
LABEL	RADIUS (ft)	LENGTH (ft)
C5	500.00	147.85

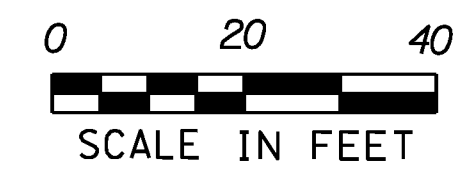

PROJECT NAME: RICHMOND	
PROJECT NUMBER: STP 0284 (17)	
FILE NAME: z97cl86curbbdr.dgn	PLOT DATE: 4/29/2013
PROJECT LEADER: ERIK ATKINS	DRAWN BY: N. BOSAN
DESIGNED BY: T. BIGELOW	CHECKED BY: E. ATKINS
CURB TIE AND LAYOUT SHEET 2	SHEET 46 OF 133