


# TRAFFIC SIGN SUMMARY SHEET 6

MILEMARKER, STATION, OR SIGN NUMBER	SIGN LEGEND	SIGN DIMENSIONS		NEW & SALVAGED SIGNS				EXIST POST RETAIN SALVAGE	NO. OF POSTS	NEW SIGN POSTS												REMARKS	SIGN DETAIL								
		E A	WIDTH (in)	HEIGHT (in)	"A"	"B"	SALV SIGN			SALV TIS	FLANGED CHANNEL lb/ft			SQUARE STEEL (in)			TUBULAR ALUMINUM Ø (in)			TUBULAR STEEL Ø (in)			W-SHAPE STEEL			S.H.S.*	DETAIL ON SHEET NUMBER	STD. SHEET NUMBER			
											1.12	2.0	3.0	1.75	2.0	2.5	3.0	4.0	4.0 MOD	3.0	3.5		4.0	5.0	FTG. SIZE				WEIGHT	POST SIZE	
																									1.88						2.42
					SF	SF	EA.	SF			FT			FT			LB			EA.	LB										
	<b>SHEET 60 TOTALS</b>				13.16		9							65.5						2	283.50 <del>348.75</del>										
	<b>SHEET 61 TOTALS</b>						17							64.40 <del>91.85</del>																	
	<b>SHEET 62 TOTALS</b>				24.00		14							72.13 <del>74.0</del>																	
	<b>SHEET 63 TOTALS</b>				28.5		10							109.25 <del>108.25</del>																	
	<b>SHEET 64 TOTALS</b>				42.88		1							62.0 <del>55.0</del>																	
	<b>GRAND TOTALS</b>				108.54		51							373.28 <del>394.6</del>						2	283.50 <del>348.75</del>										

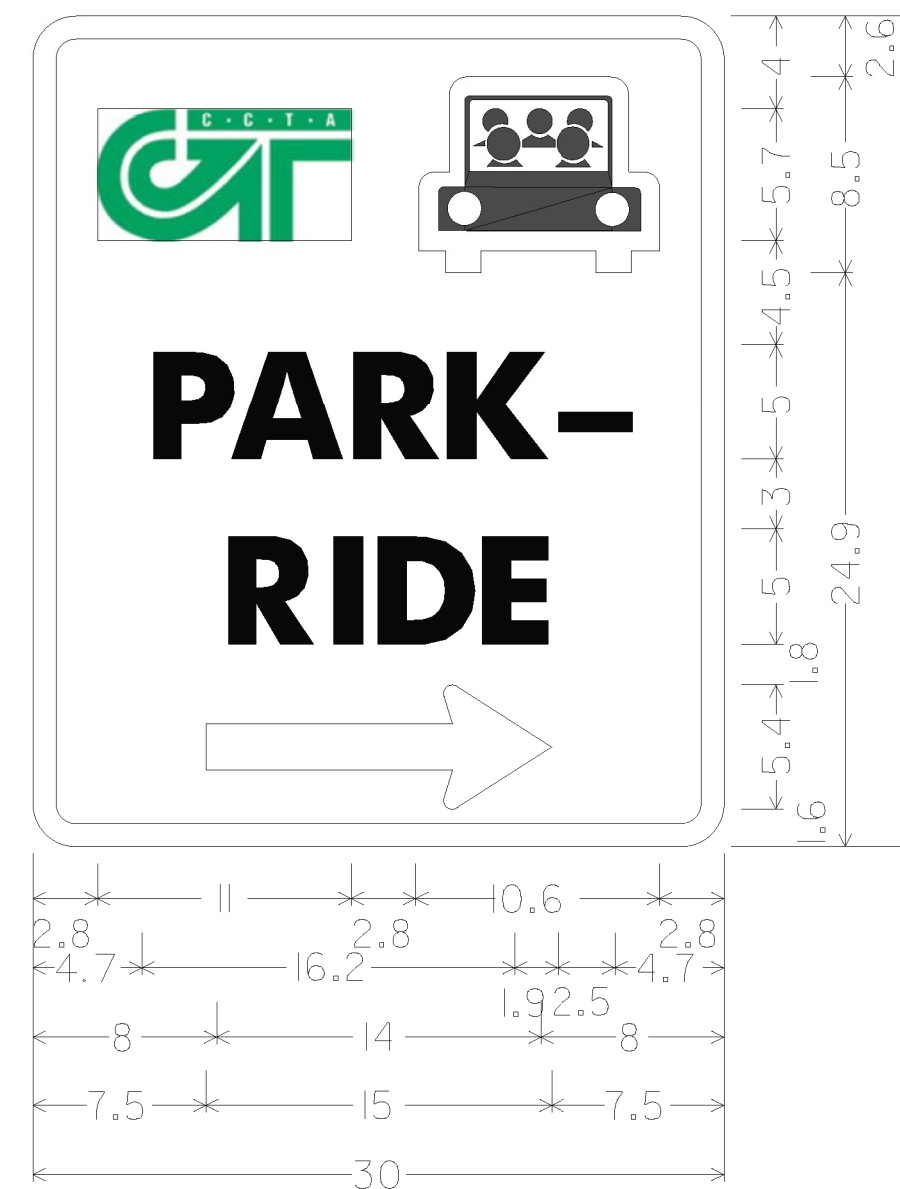

D4-2;  
1.9" RADIUS, 1.0" BORDER, WHITE ON GREEN;  
SYMBOL RA074;  
[PARK -] D 60] SPACING;  
[RIDE] D;  
STANDARD ARROW CUSTOM 15.0" X 5.4" O;

SIGN DETAIL  
NOT TO SCALE

FINAL POST LENGTHS ARE TO BE DETERMINED IN THE FIELD. POST SIZES ARE COMPUTED BASED ON INFORMATION FURNISHED ON THE VTRANS STANDARD SHEETS AND THE "SIGN POST DESIGN GUIDELINE".

\*STANDARD HIGHWAY SIGNS

KEY	DATE	BY	REVISION
△	11/12/2015	VTRANS	SIGN SUMMARY UPDATE

PROJECT NAME:	RICHMOND	PLOT DATE:	4/29/2013
PROJECT NUMBER:	STP 0284 (17)	DRAWN BY:	Y.CAO/LALMY
FILE NAME:	z97cl86tss.dgn	CHECKED BY:	D.FLYNN
PROJECT LEADER:	JEFFREY MAXTUTIS	SHEET	65 OF 133
DESIGNED BY:	J.SOBEL		
TRAFFIC SIGN SUMMARY SHEET 6			