




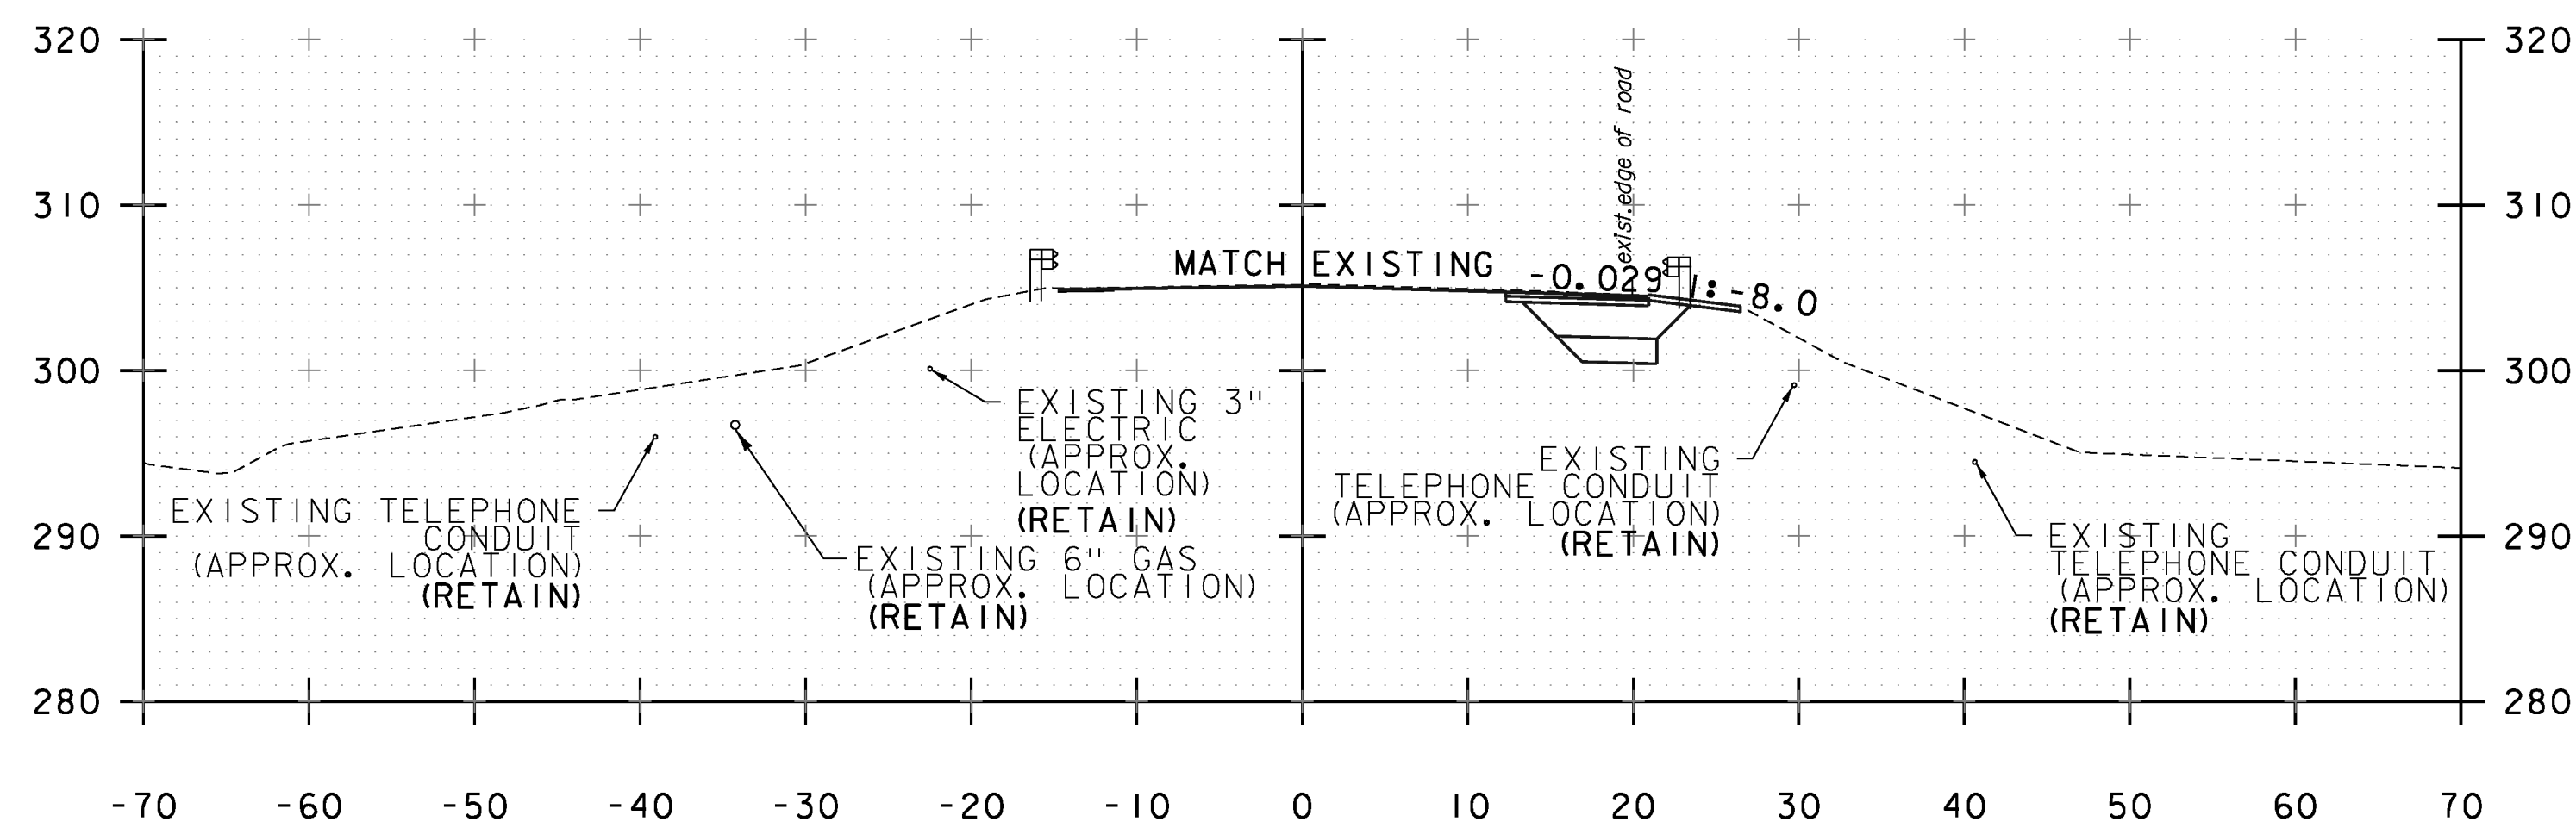


22+50

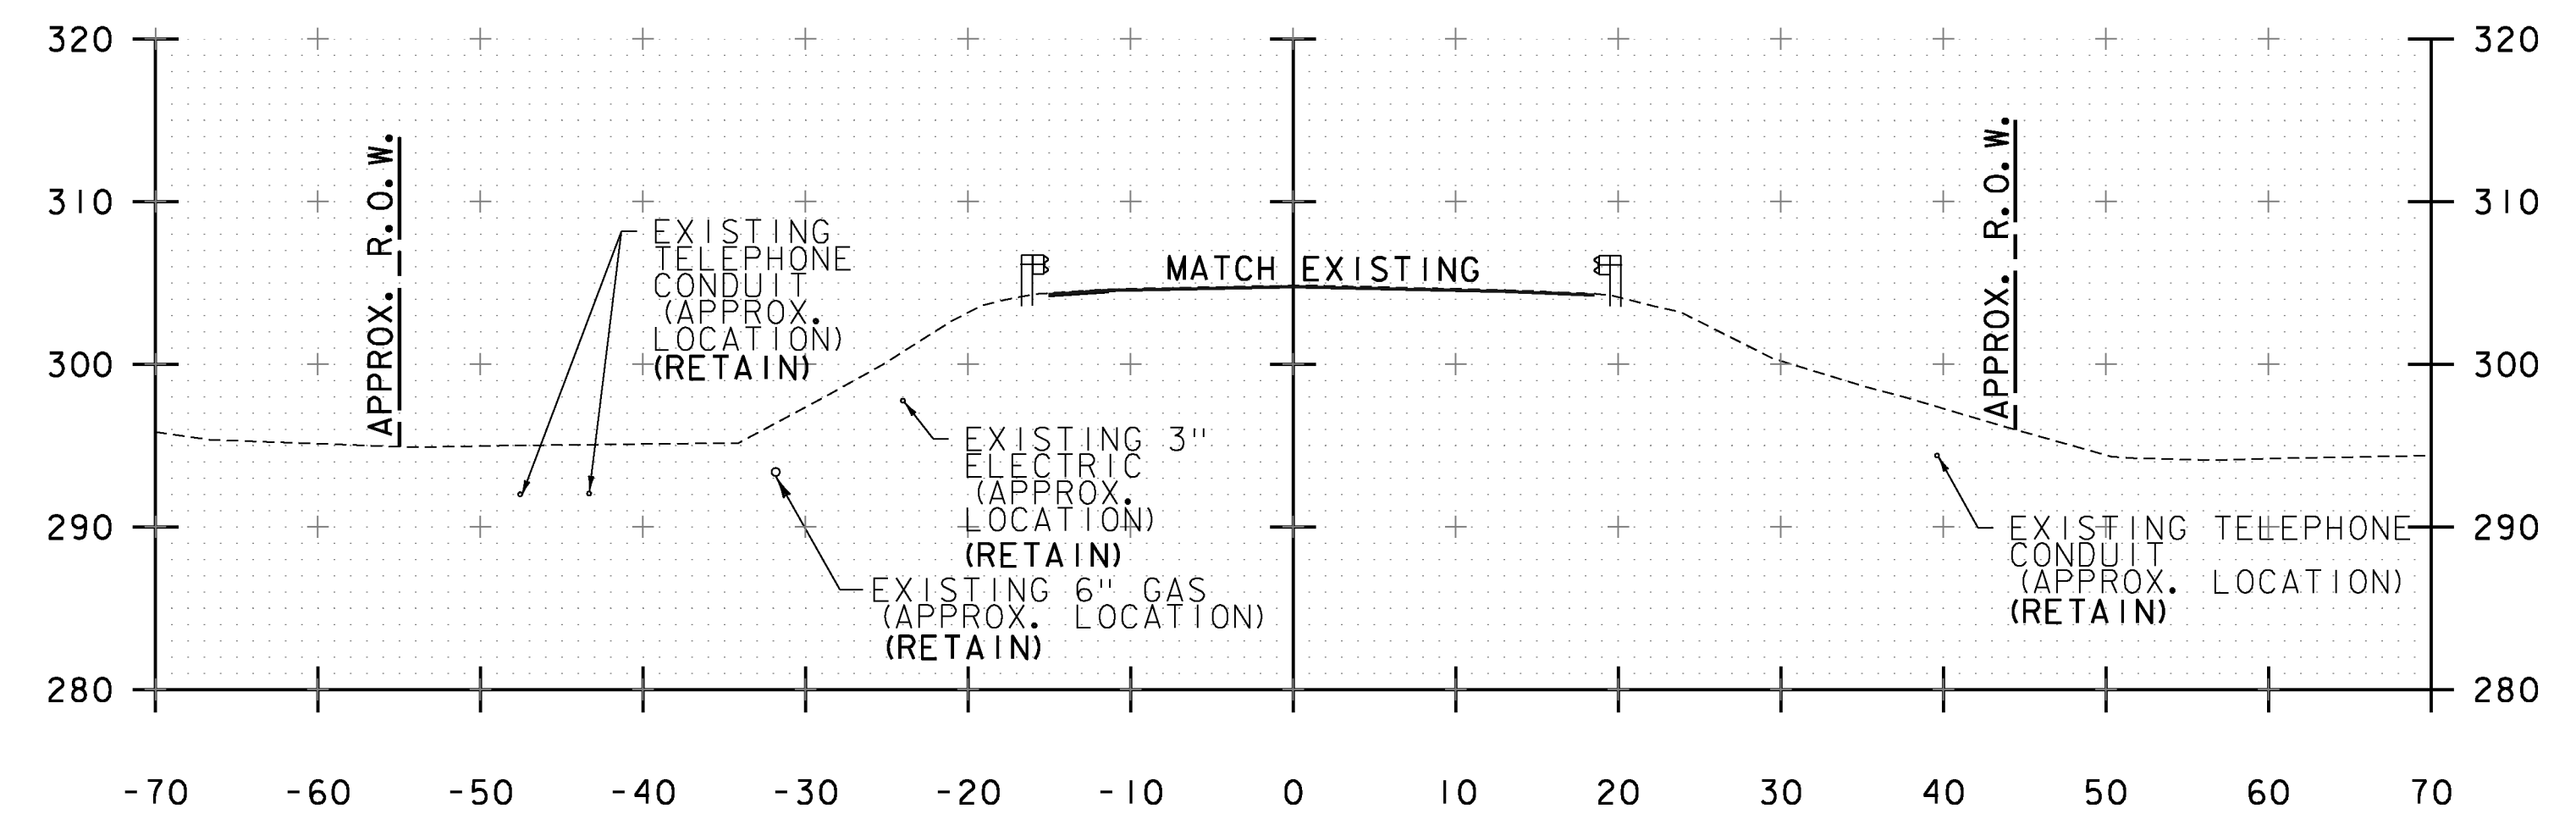


24+00

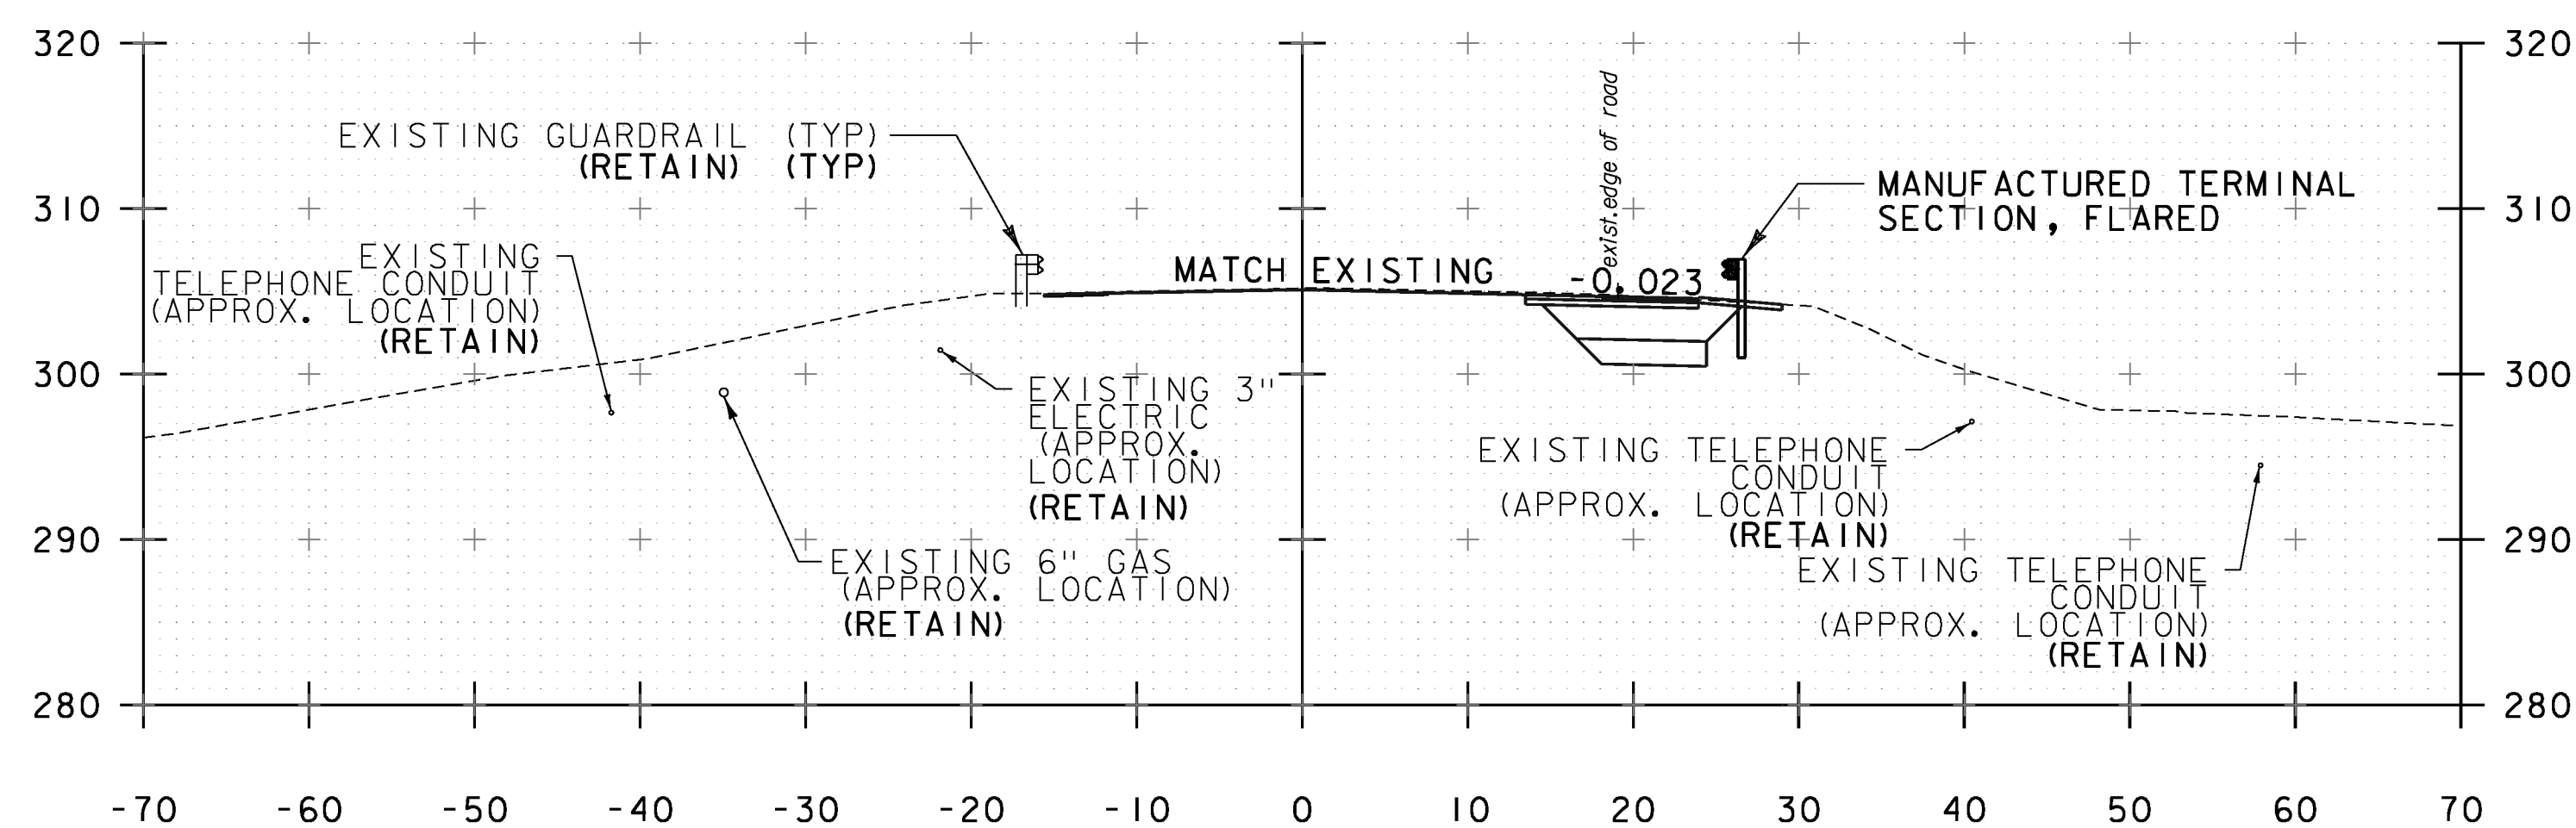


22+00

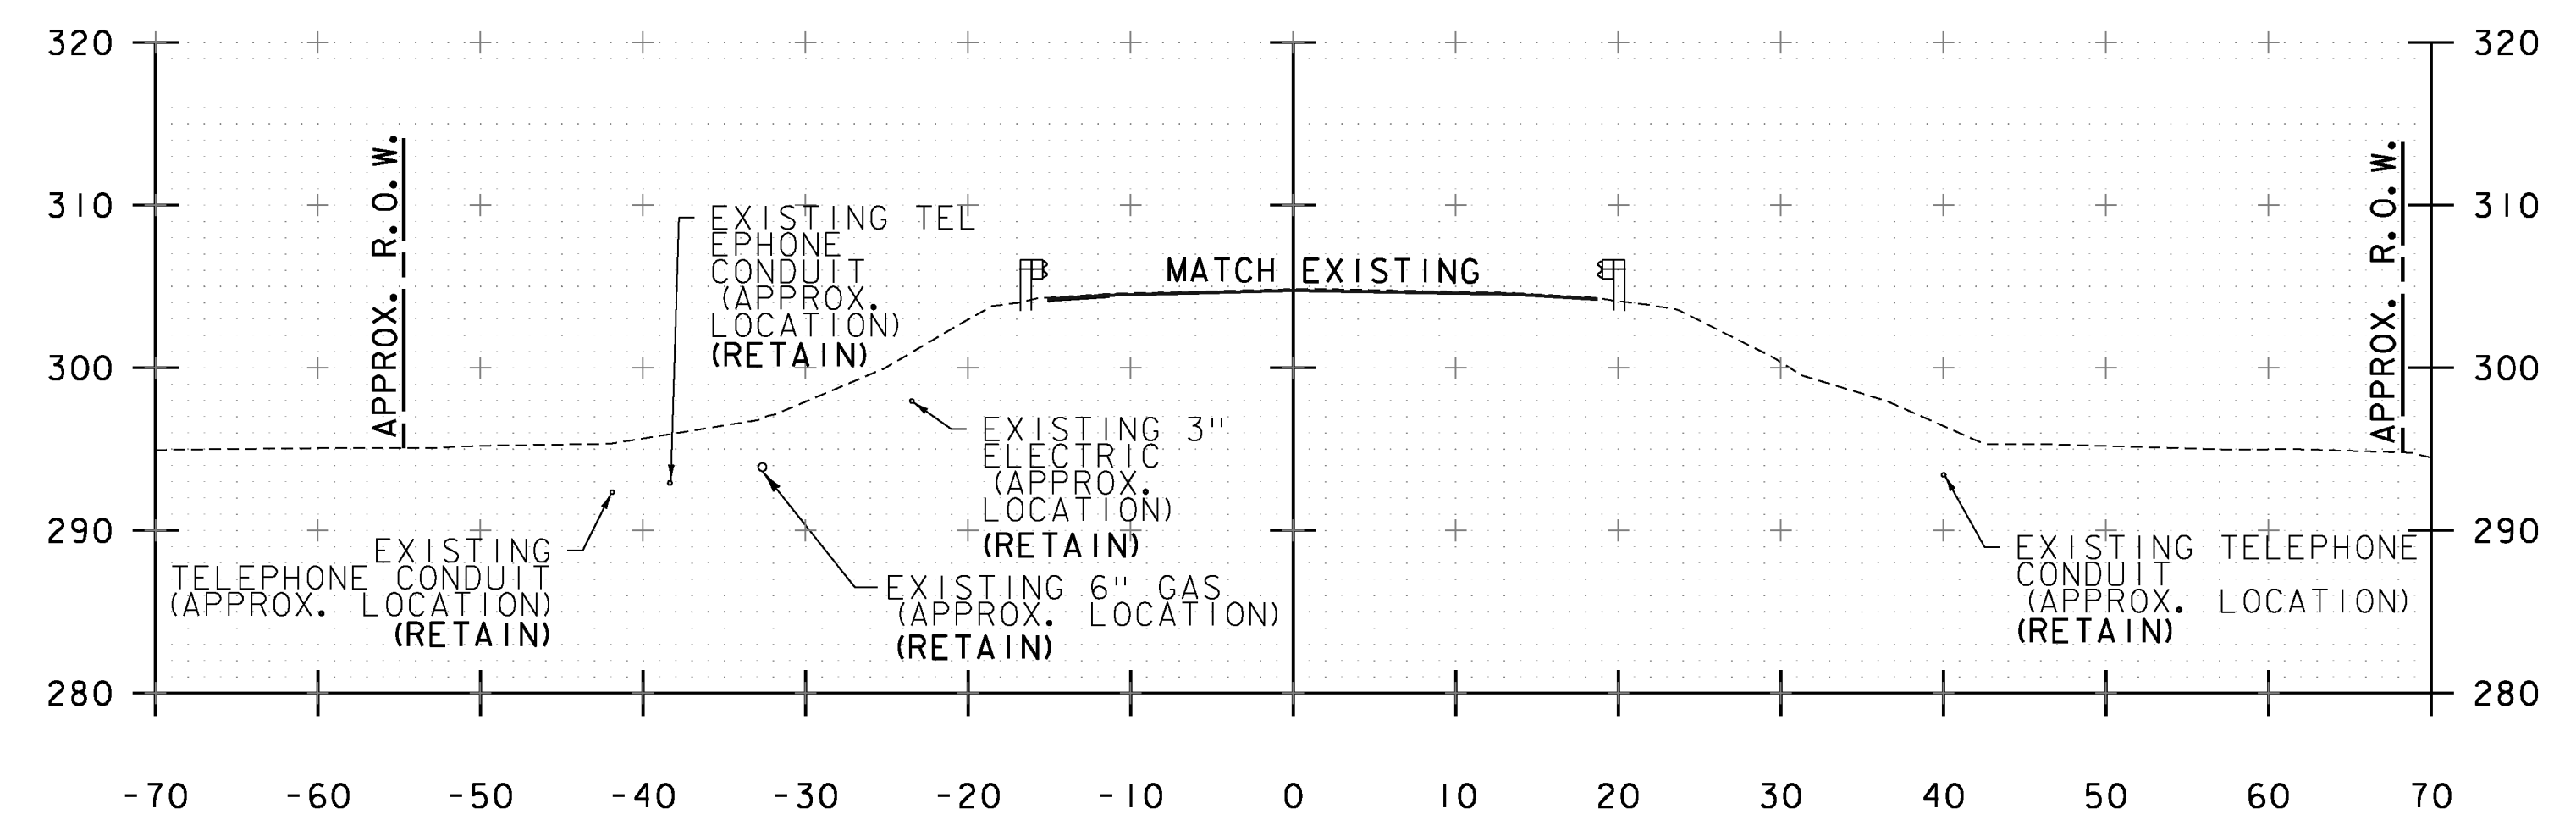

23+50

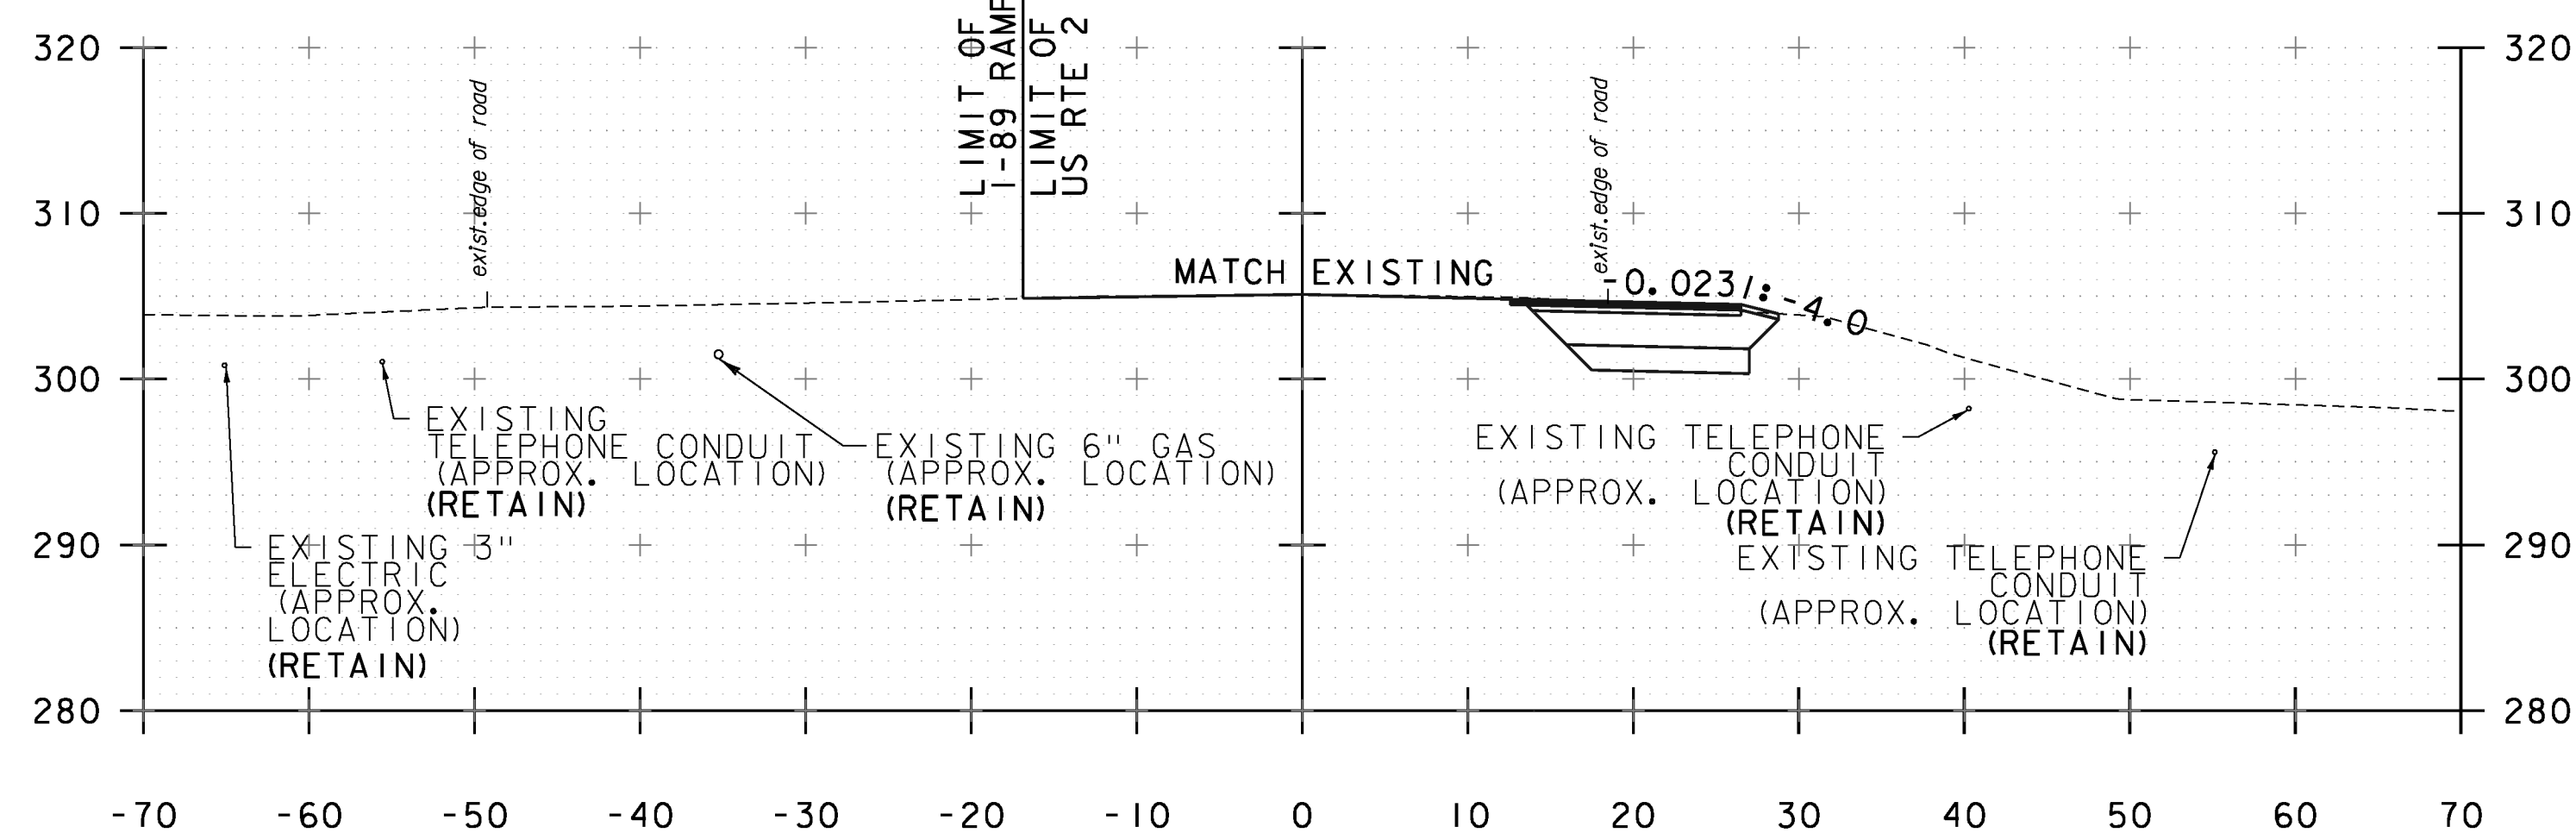

21+50

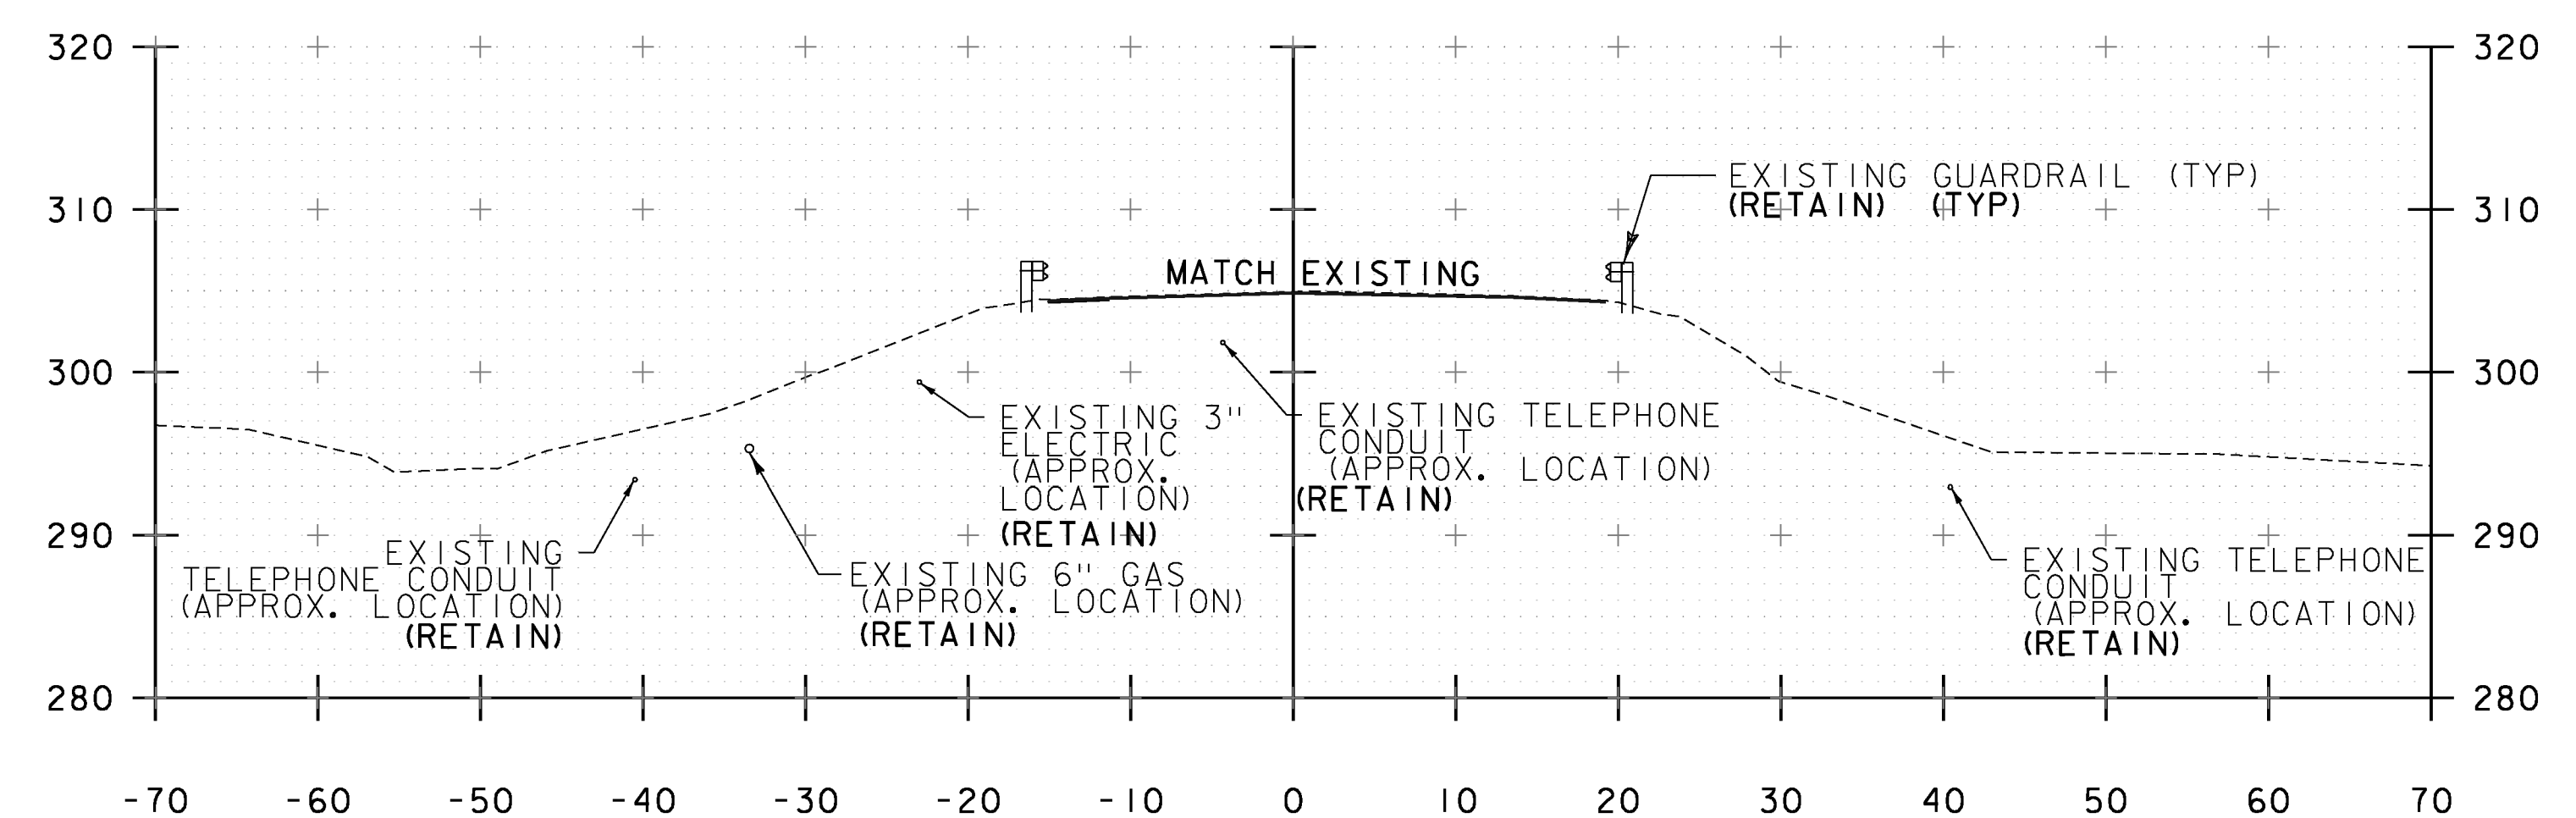

23+00

PROJECT NAME: RICHMOND	
PROJECT NUMBER: STP 0284 (I7)	
FILE NAME: z97cl86xsl.dgn	PLOT DATE: 4/26/2013
PROJECT LEADER: ERIK ATKINS	DRAWN BY: S. FORTIER
DESIGNED BY: T. BIGELOW	CHECKED BY: E. ATKINS
US ROUTE 2 CROSS SECTIONS SHEET 8	SHEET 88 OF 133

NOTE:
REFER TO SHEET 90 OF 133 FOR CROSS SECTIONS AT THE PROPOSED MAST ARM POLES.

STA. 21+50 TO STA. 24+00