
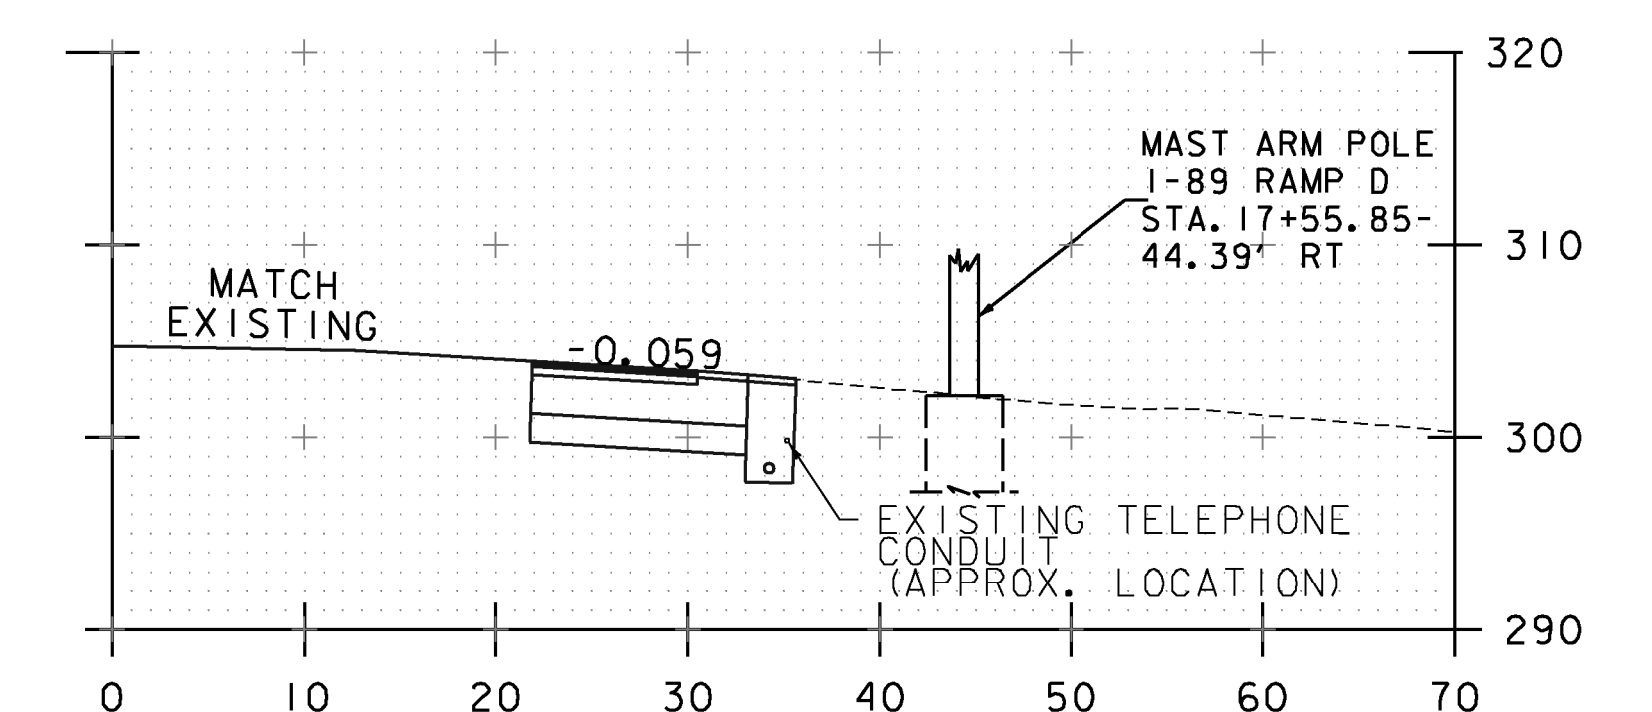
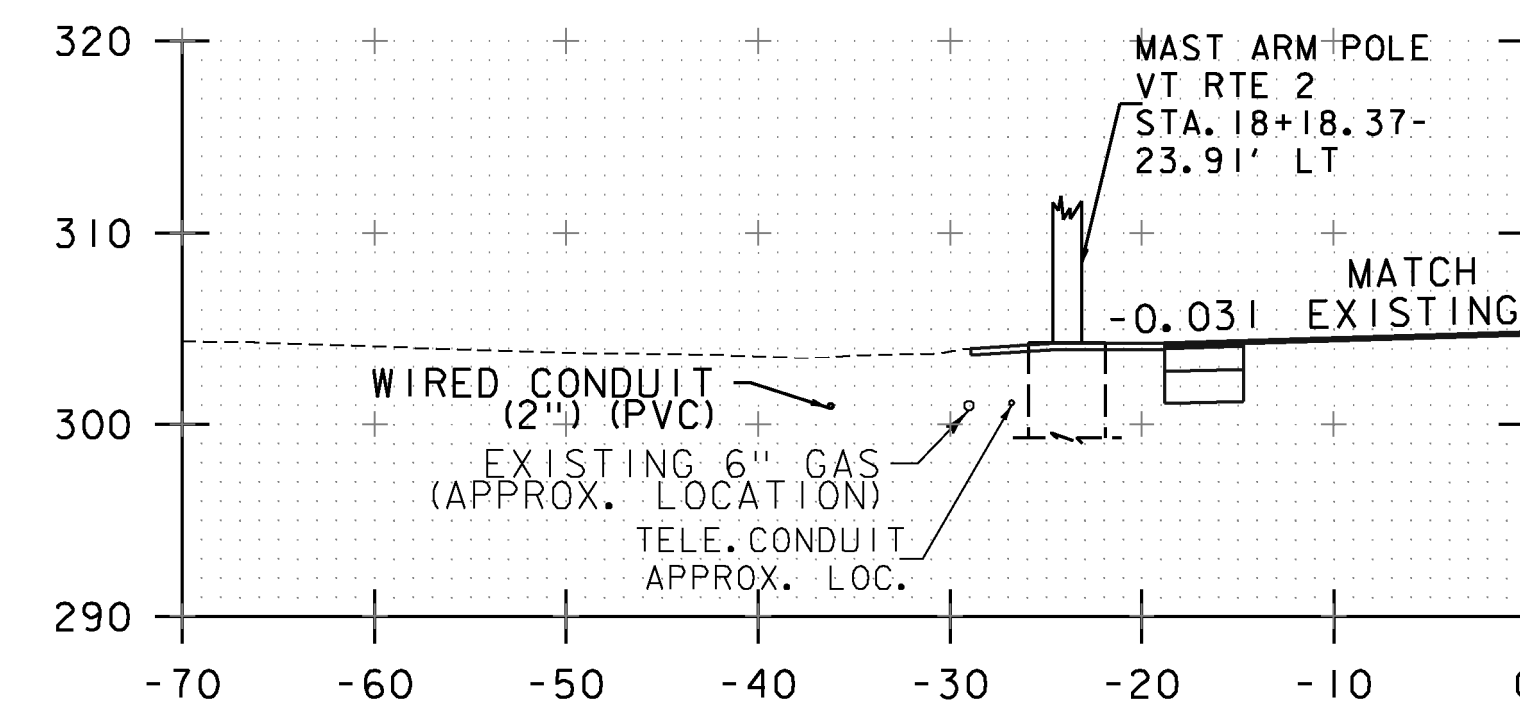
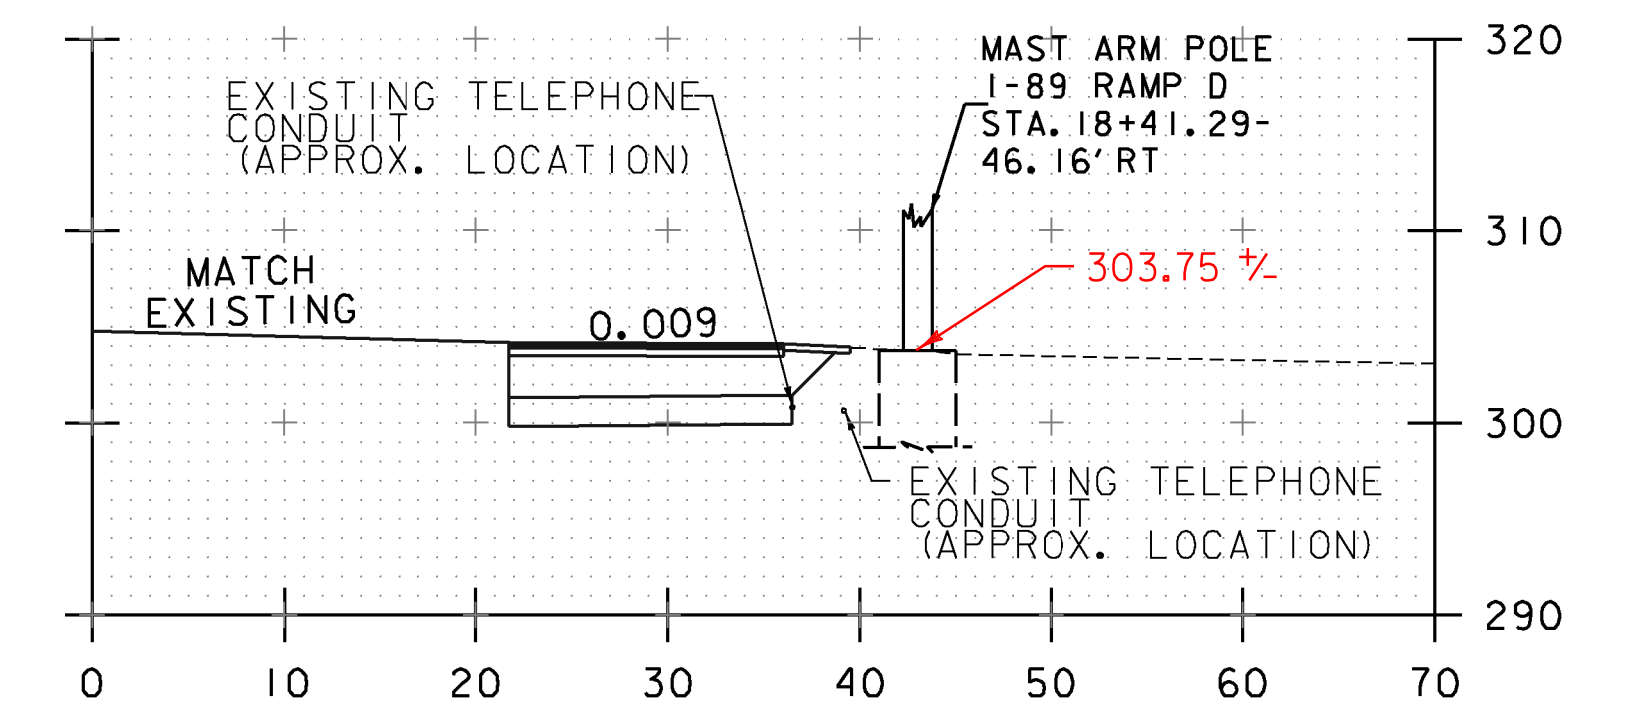
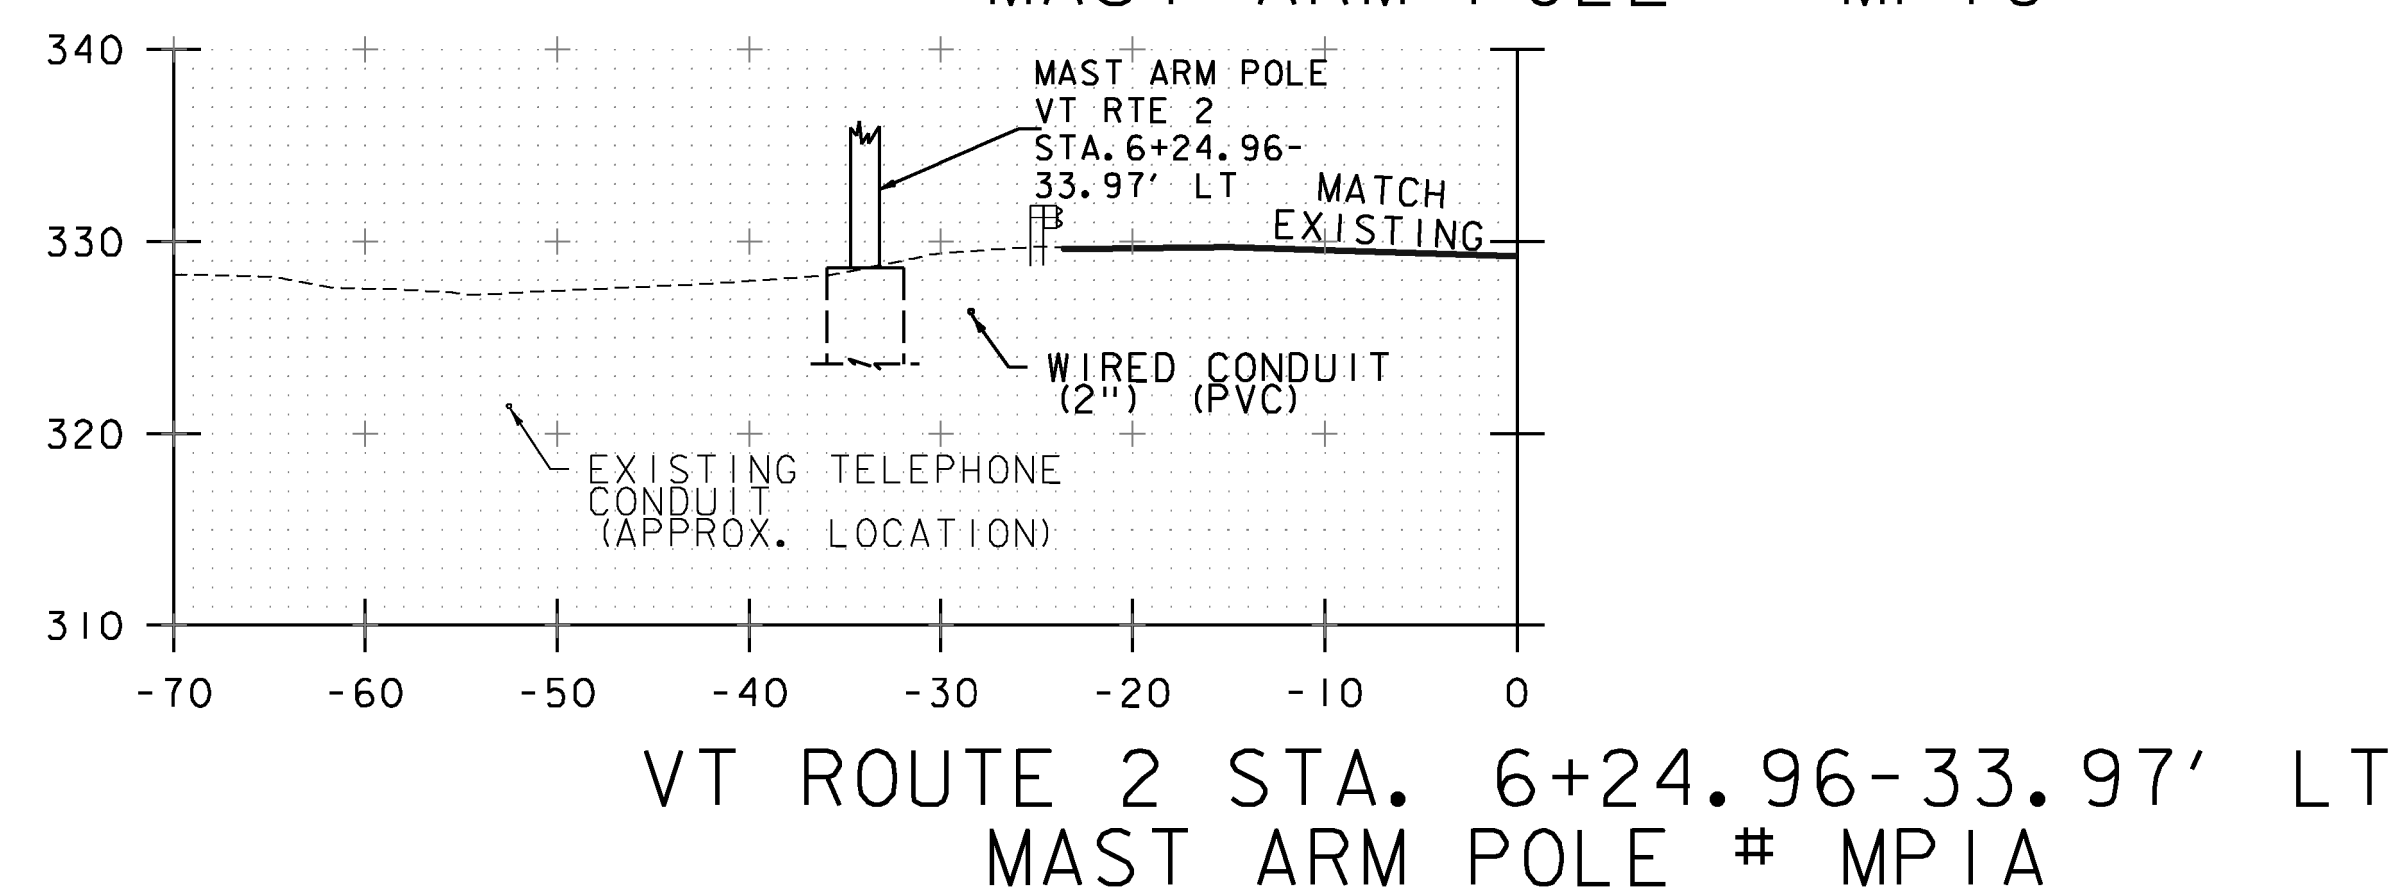
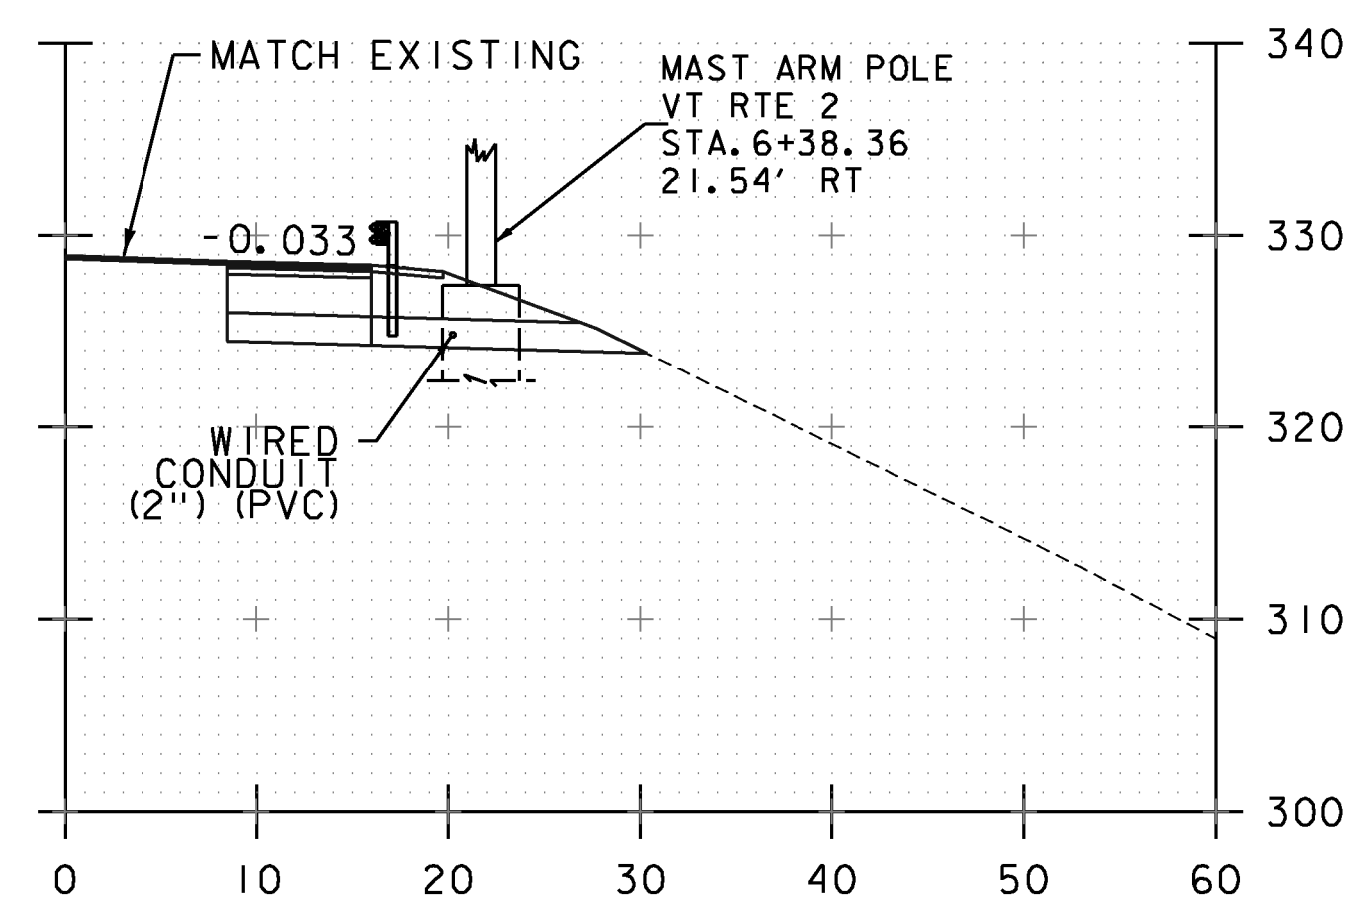
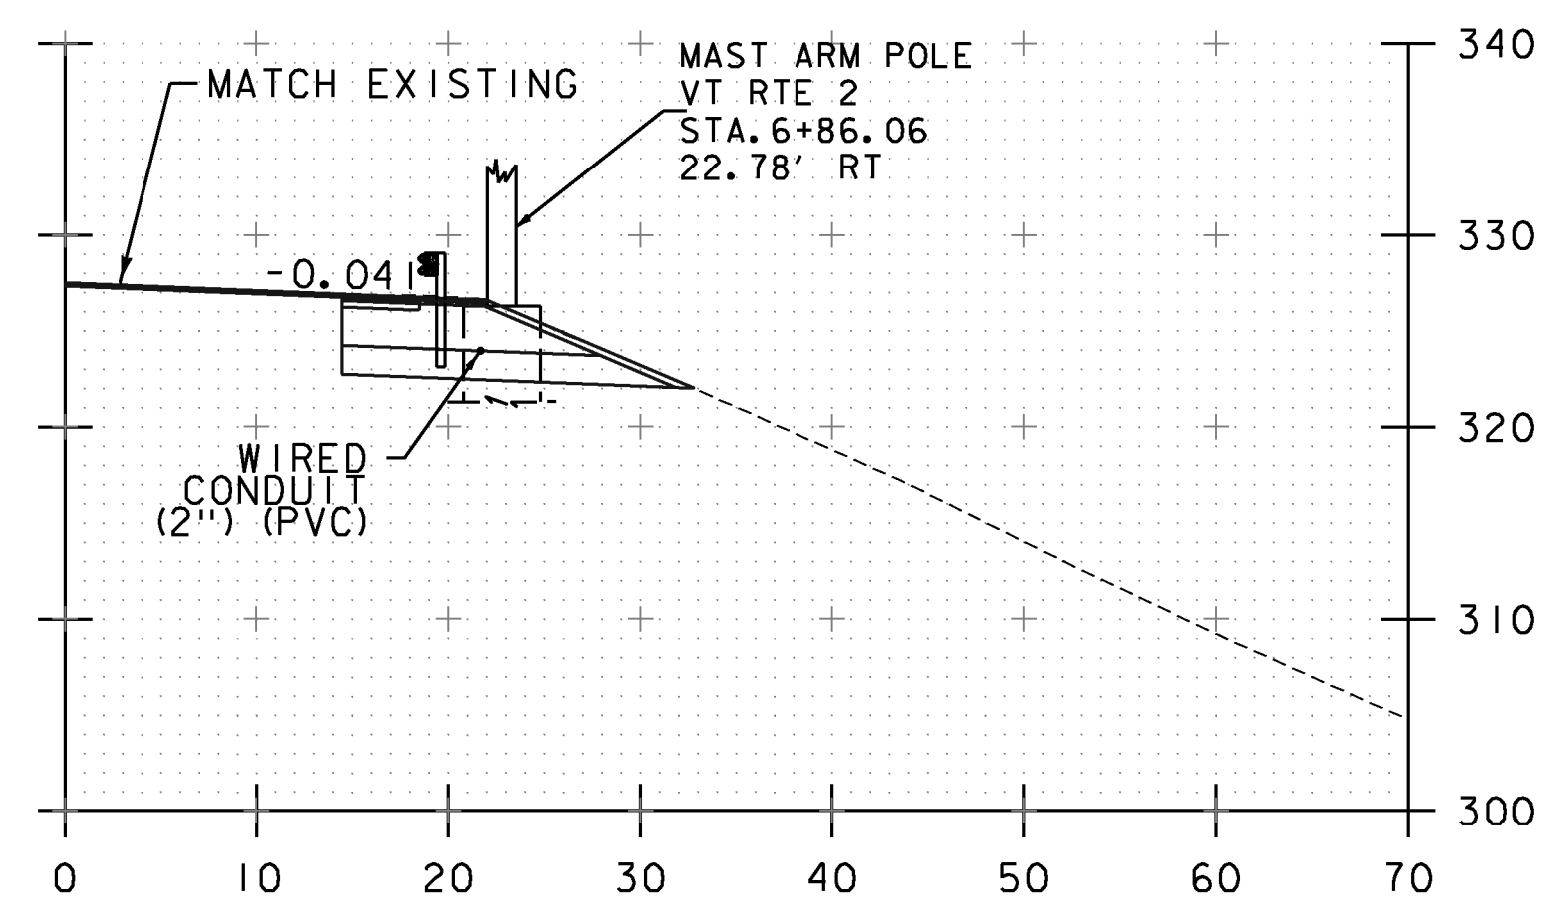


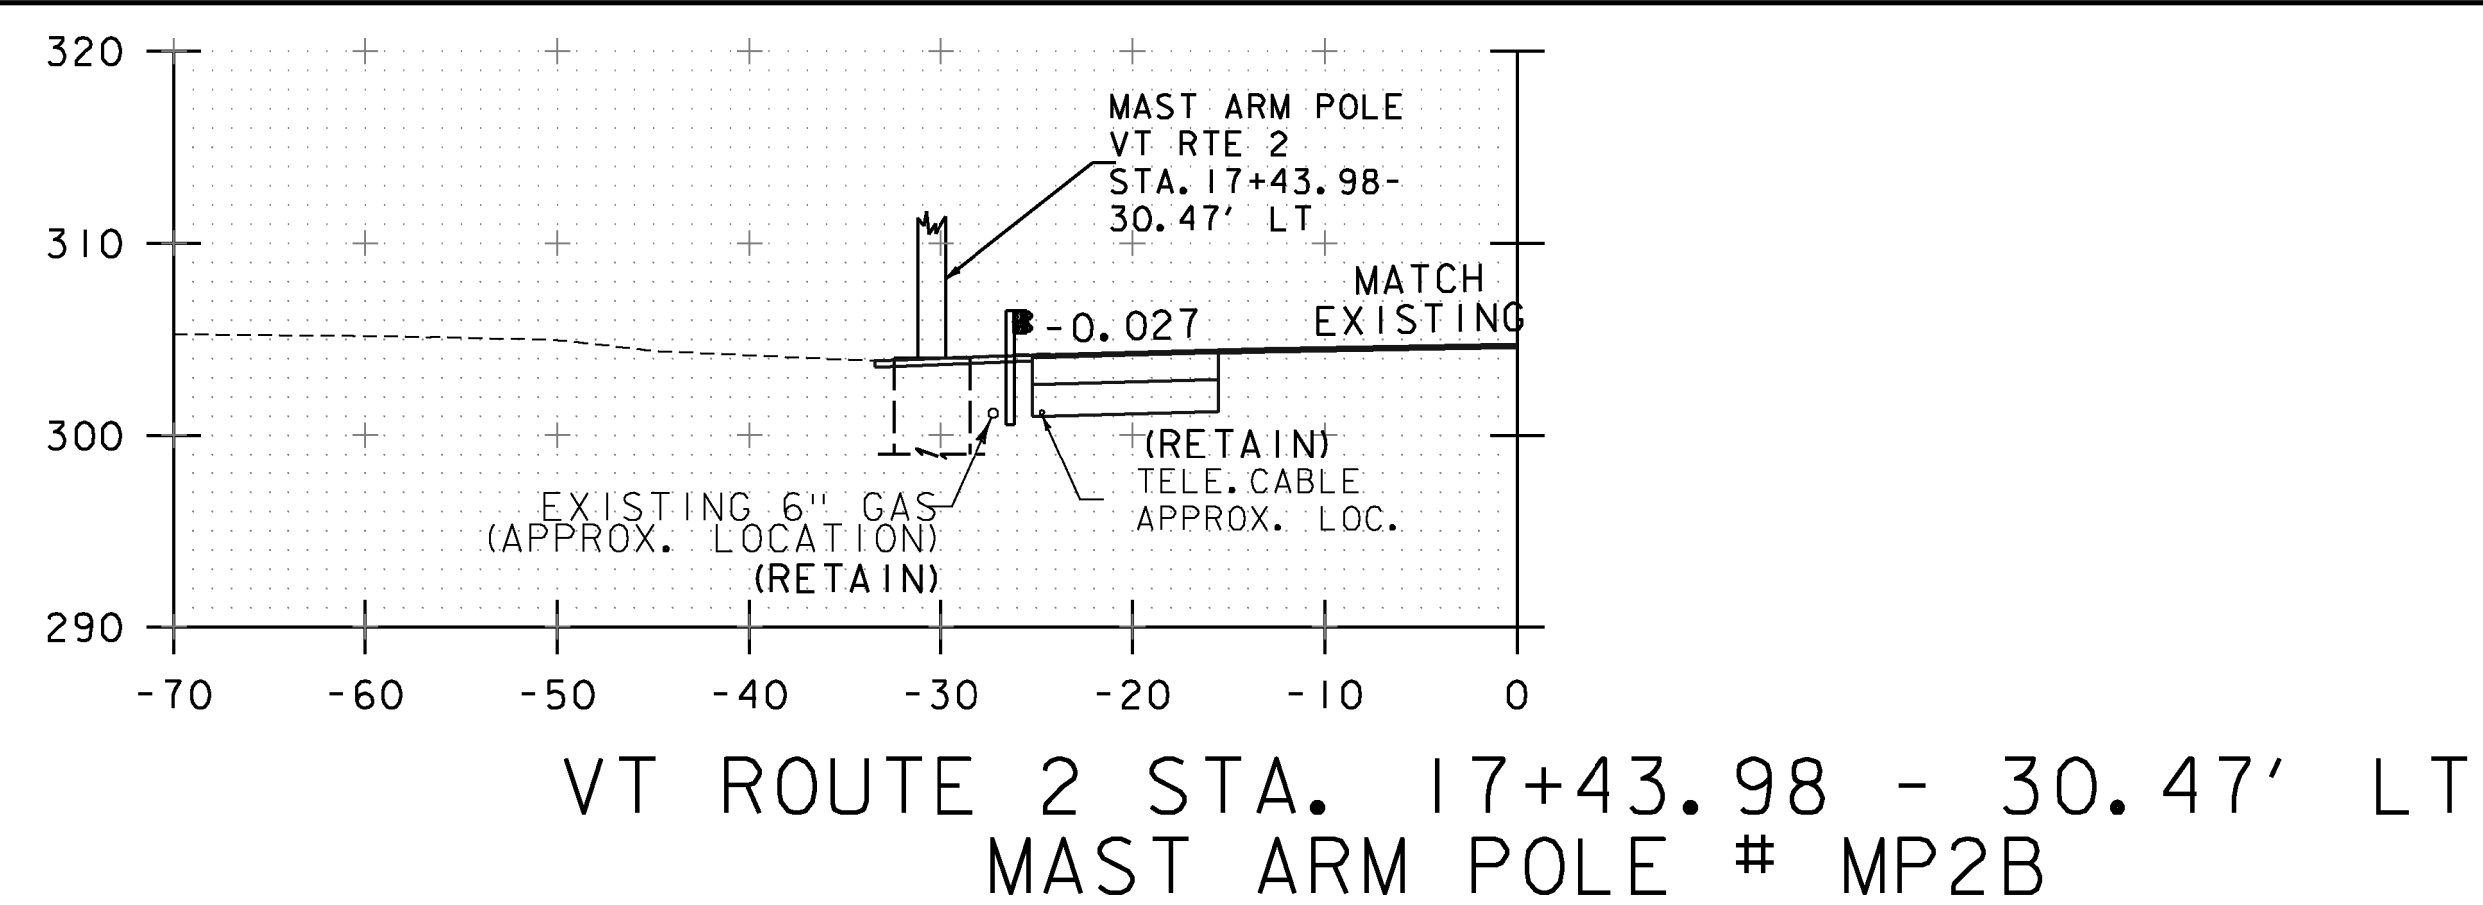

PROJECT NAME: RICHMOND
PROJECT NUMBER: STP 0284 (I7)

FILE NAME: z97cl86xsl.dgn
PROJECT LEADER: ERIK ATKINS
DESIGNED BY: T. BIGELOW
US ROUTE 2 CROSS SECTIONS SHEET 10

PLOT DATE: 4/30/2013
DRAWN BY: S. FORTIER
CHECKED BY: E. ATKINS
SHEET 90 OF 133