




VT 117 STA. 31+50

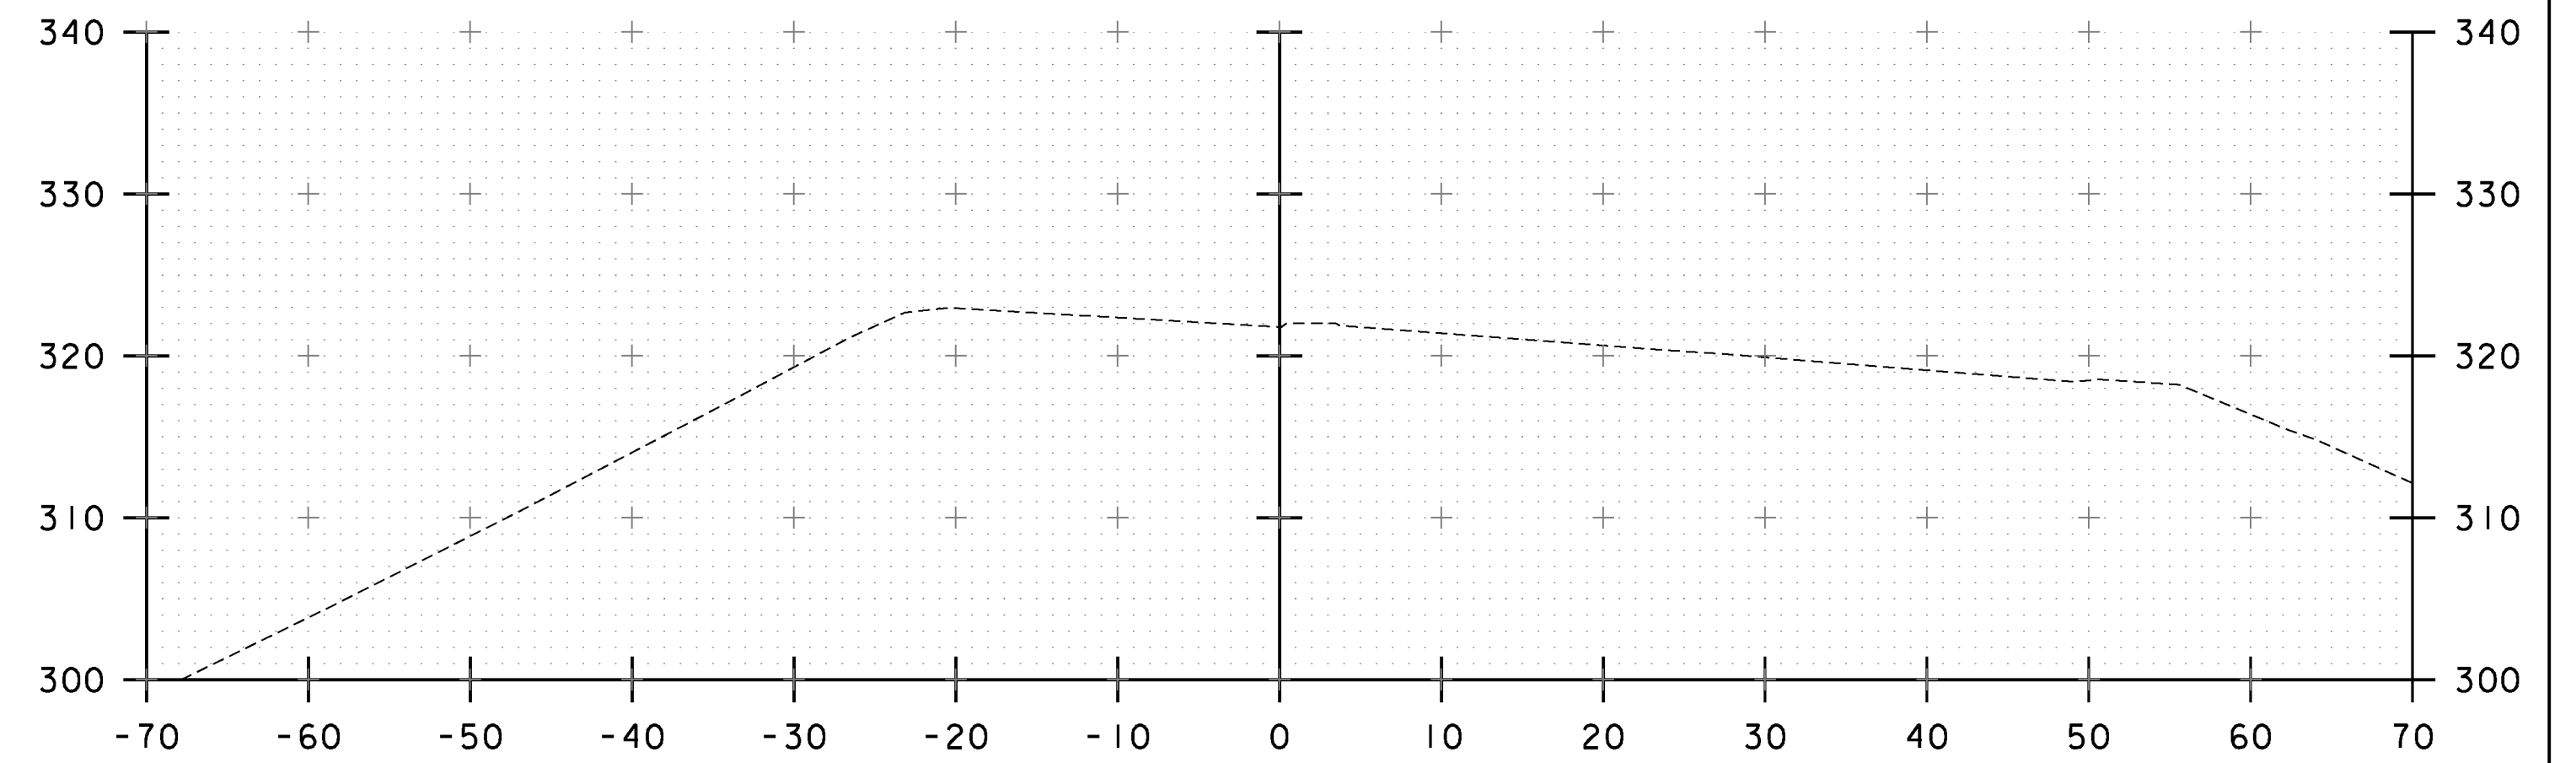


I-89 RAMP "A" STA. 36+50

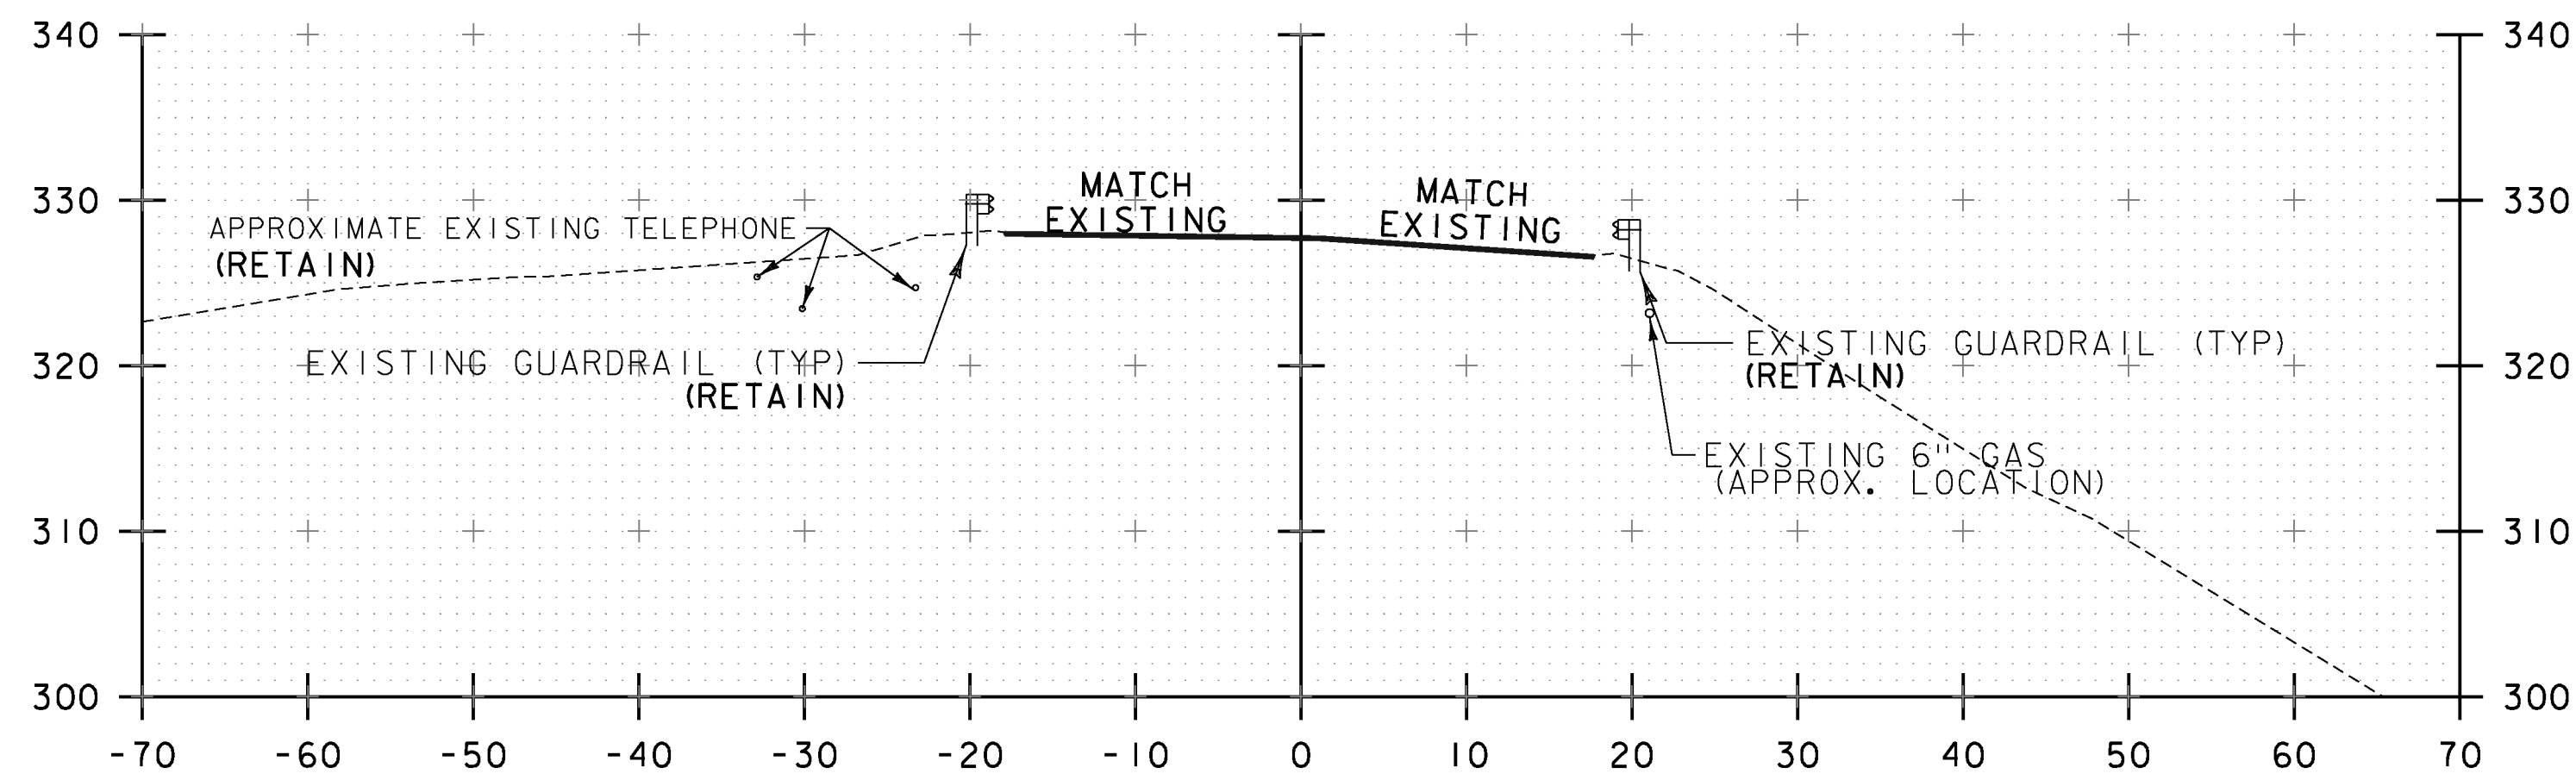


VT 117 STA. 31+00
MATCH EXISTING BCP

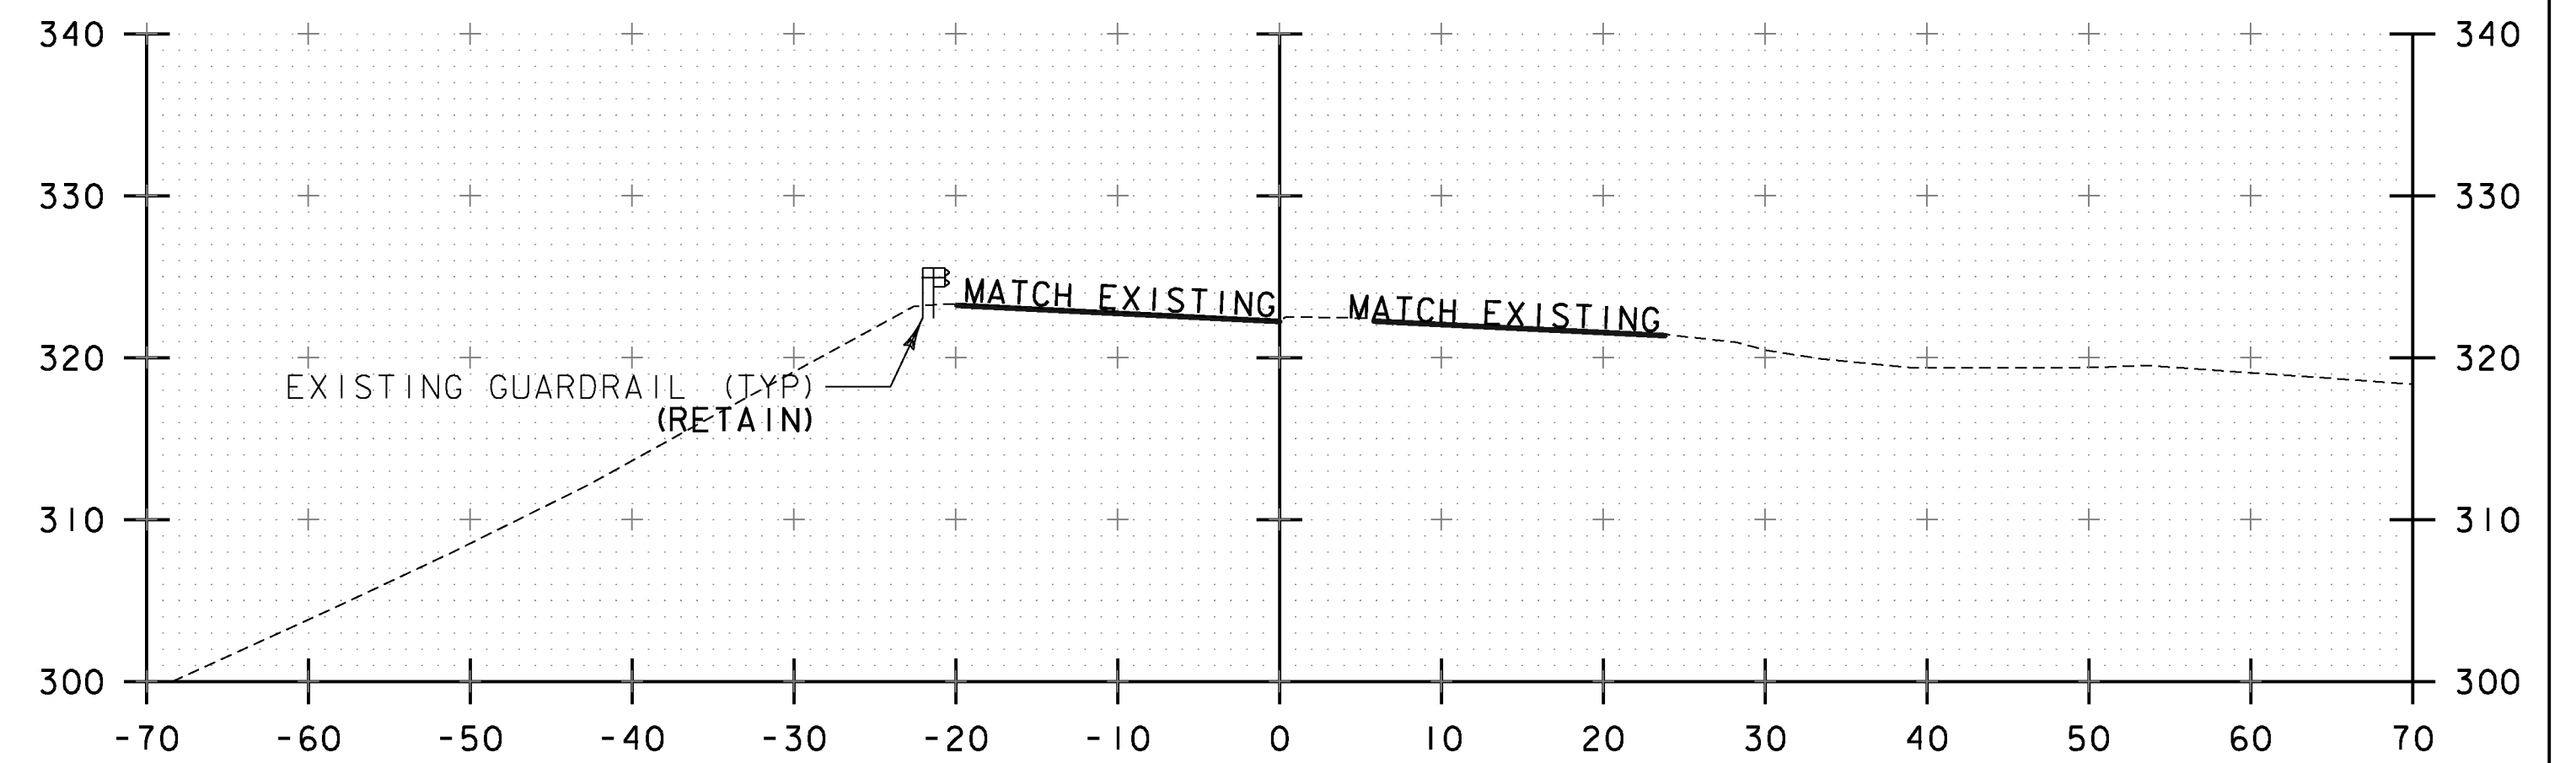

I-89 RAMP "A" STA. 36+00
MATCH EXISTING BCP

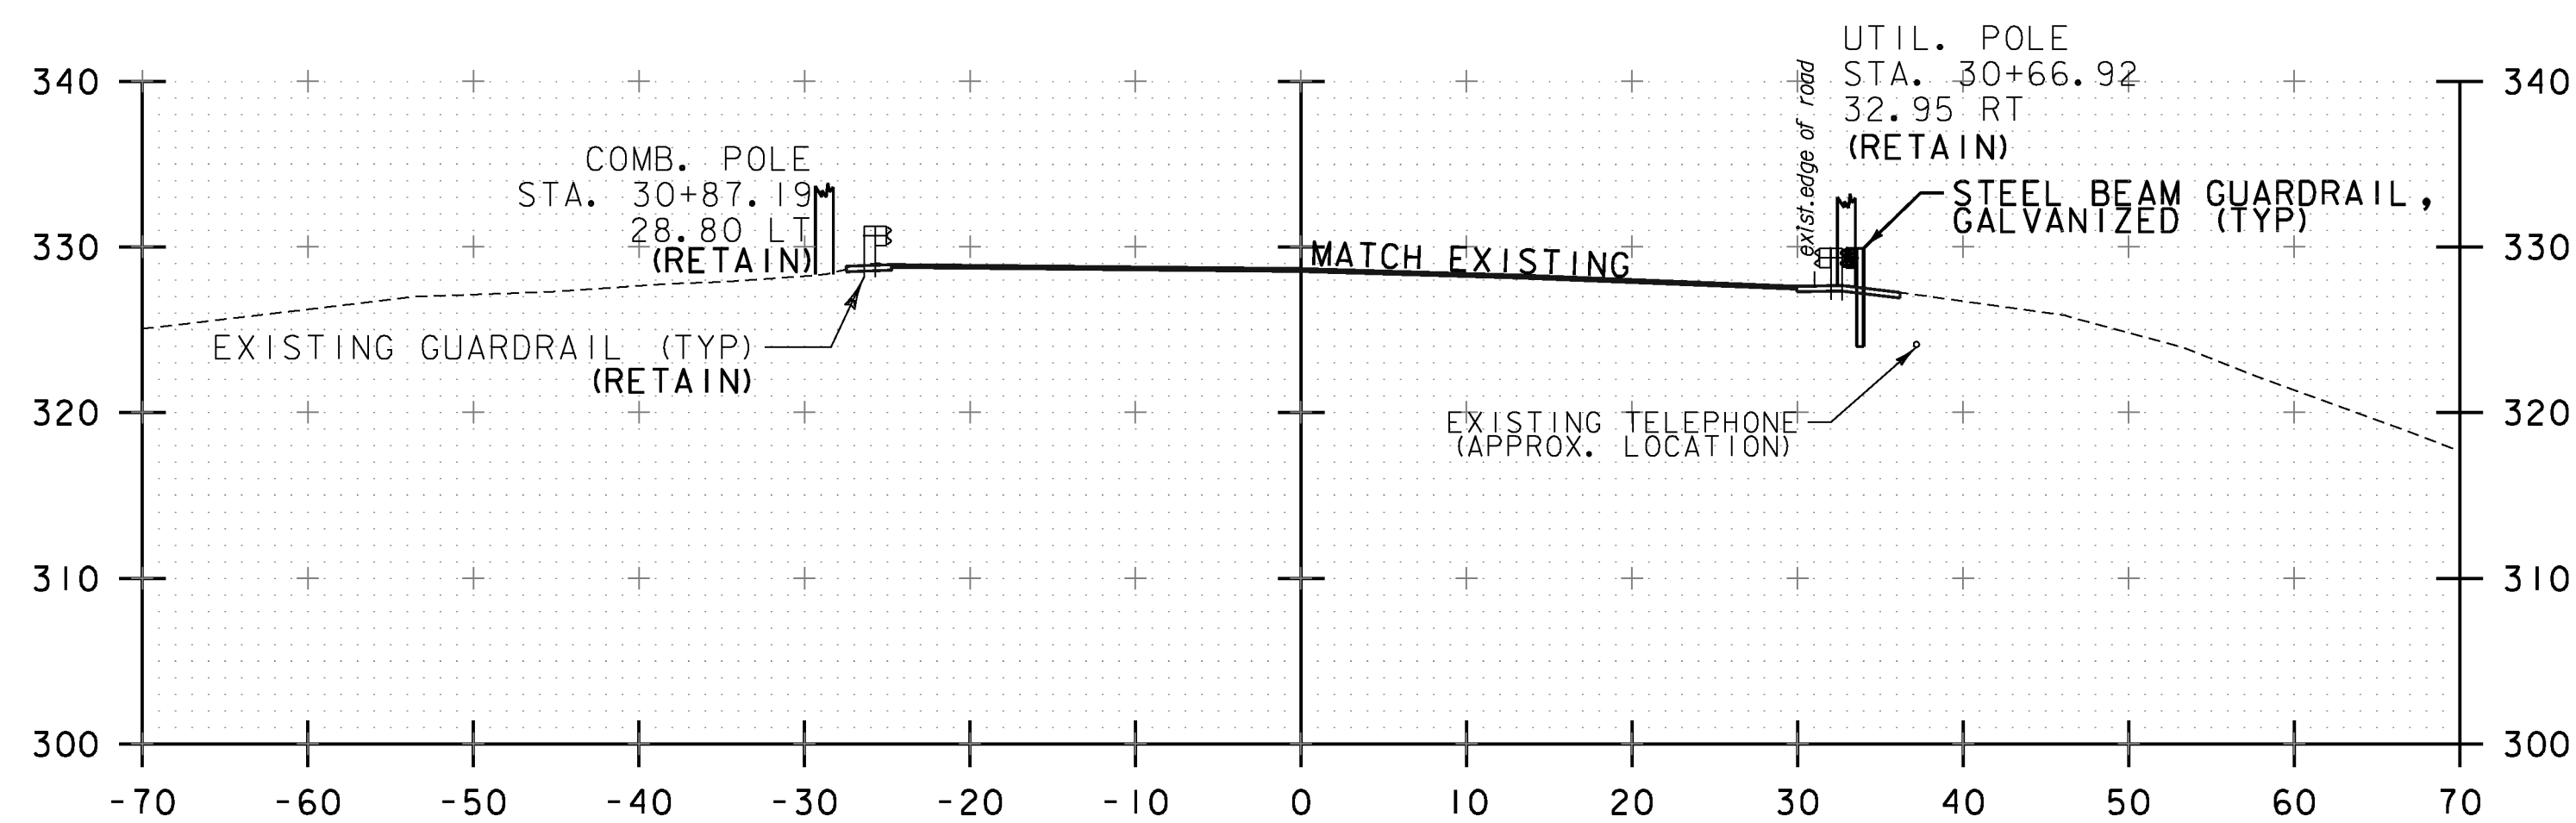

VT 117 STA. 30+50

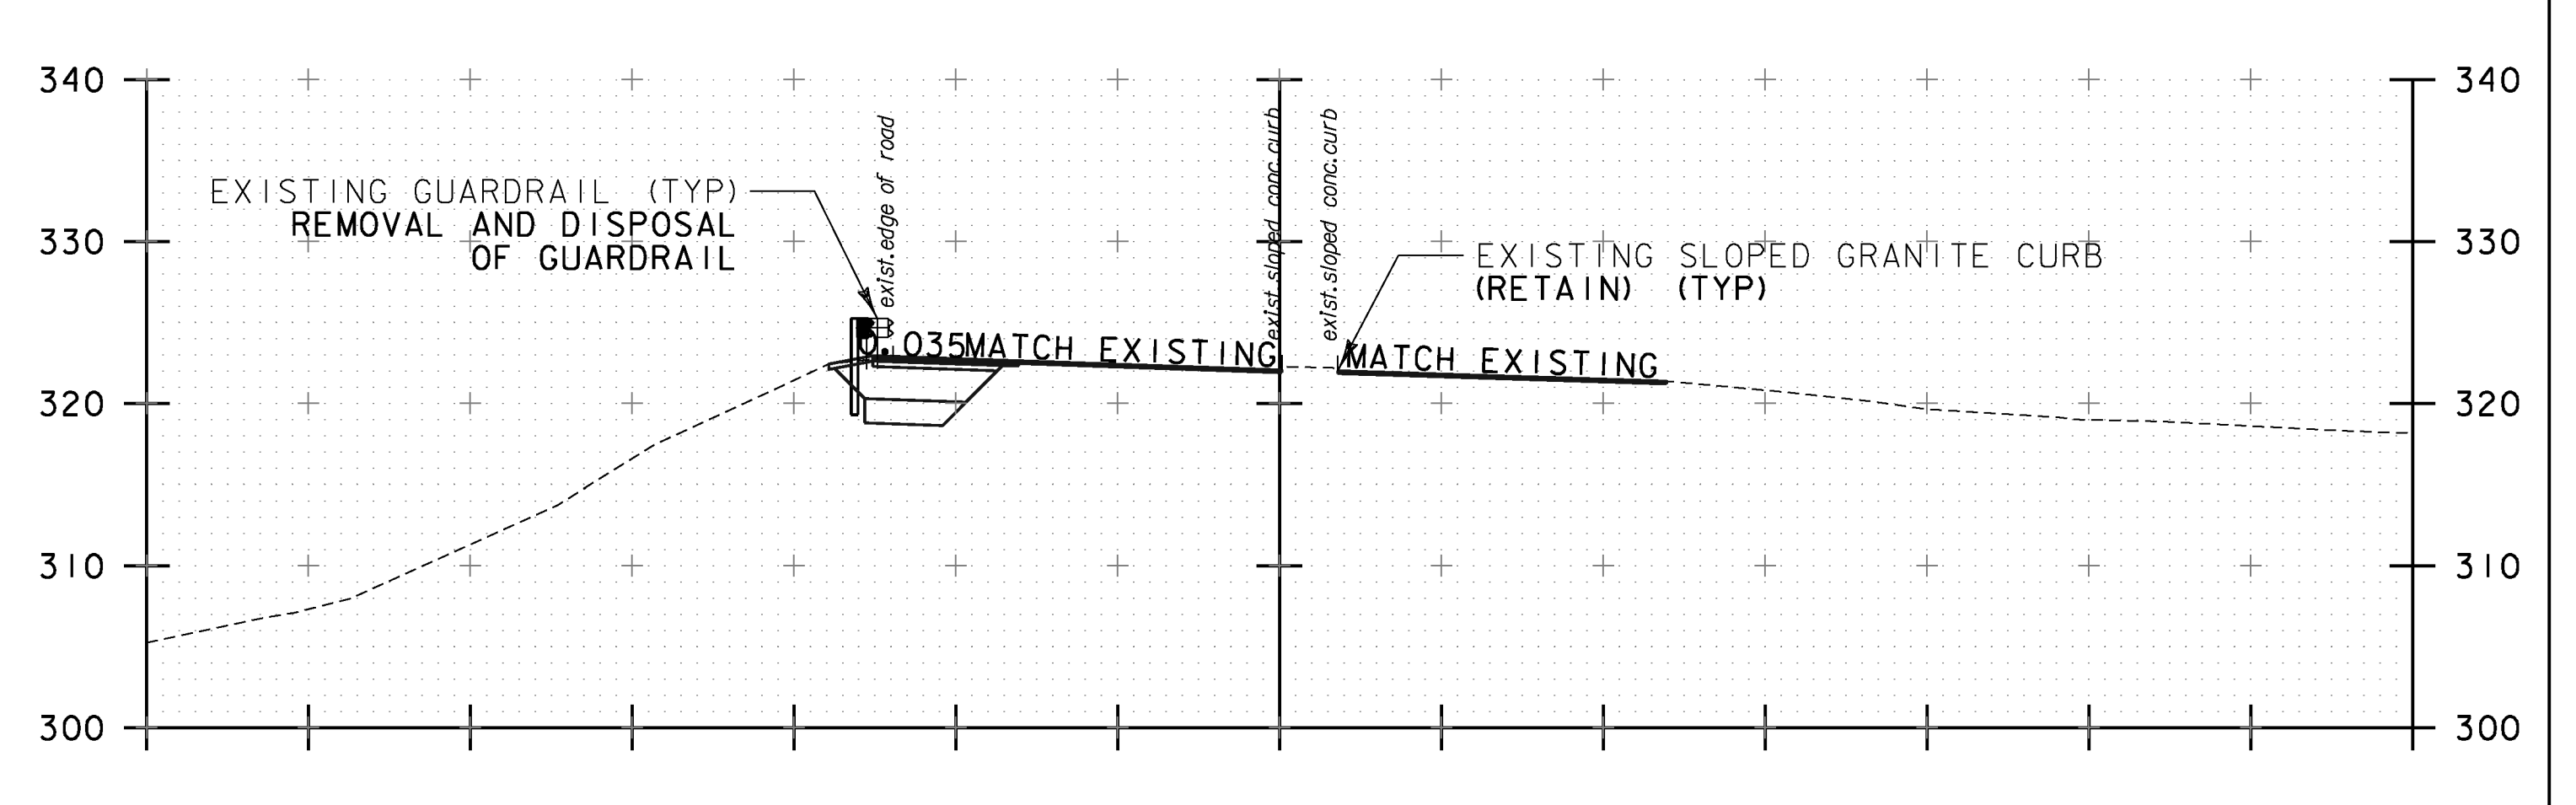

I-89 RAMP "A" STA. 35+50

VT 117 STA. 30+50 TO VT 117 STA. 31+50

I-89 RAMP "A" STA. 35+50 TO I-89 RAMP "A" STA. 36+50

PROJECT NAME: RICHMOND	PLOT DATE: 4/29/2013
PROJECT NUMBER: STP 0284 (17)	DRAWN BY: S. FORTIER
FILE NAME: z97cl86xsl.dgn	CHECKED BY: E. ATKINS
PROJECT LEADER: ERIK ATKINS	91 OF 133
DESIGNED BY: T. BIGELOW	