
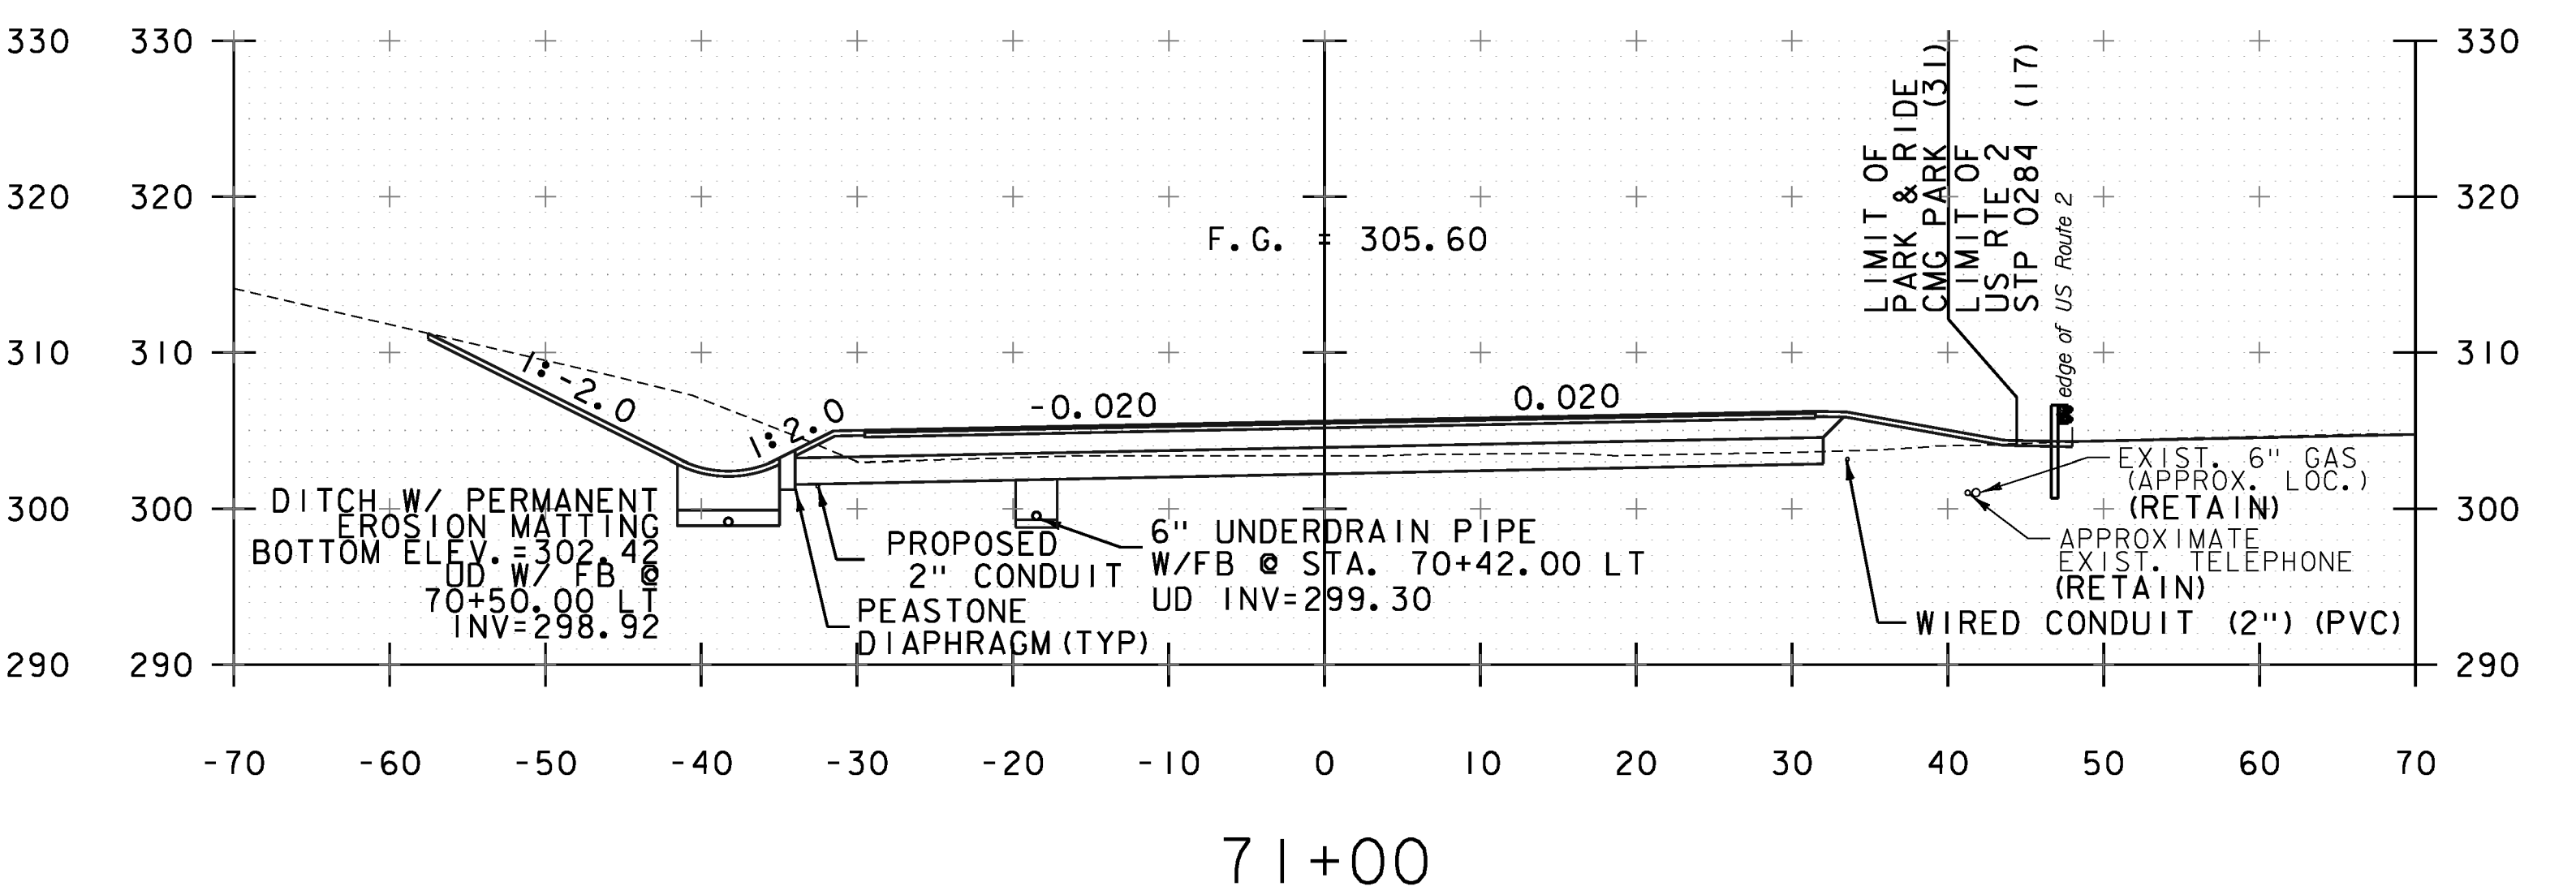
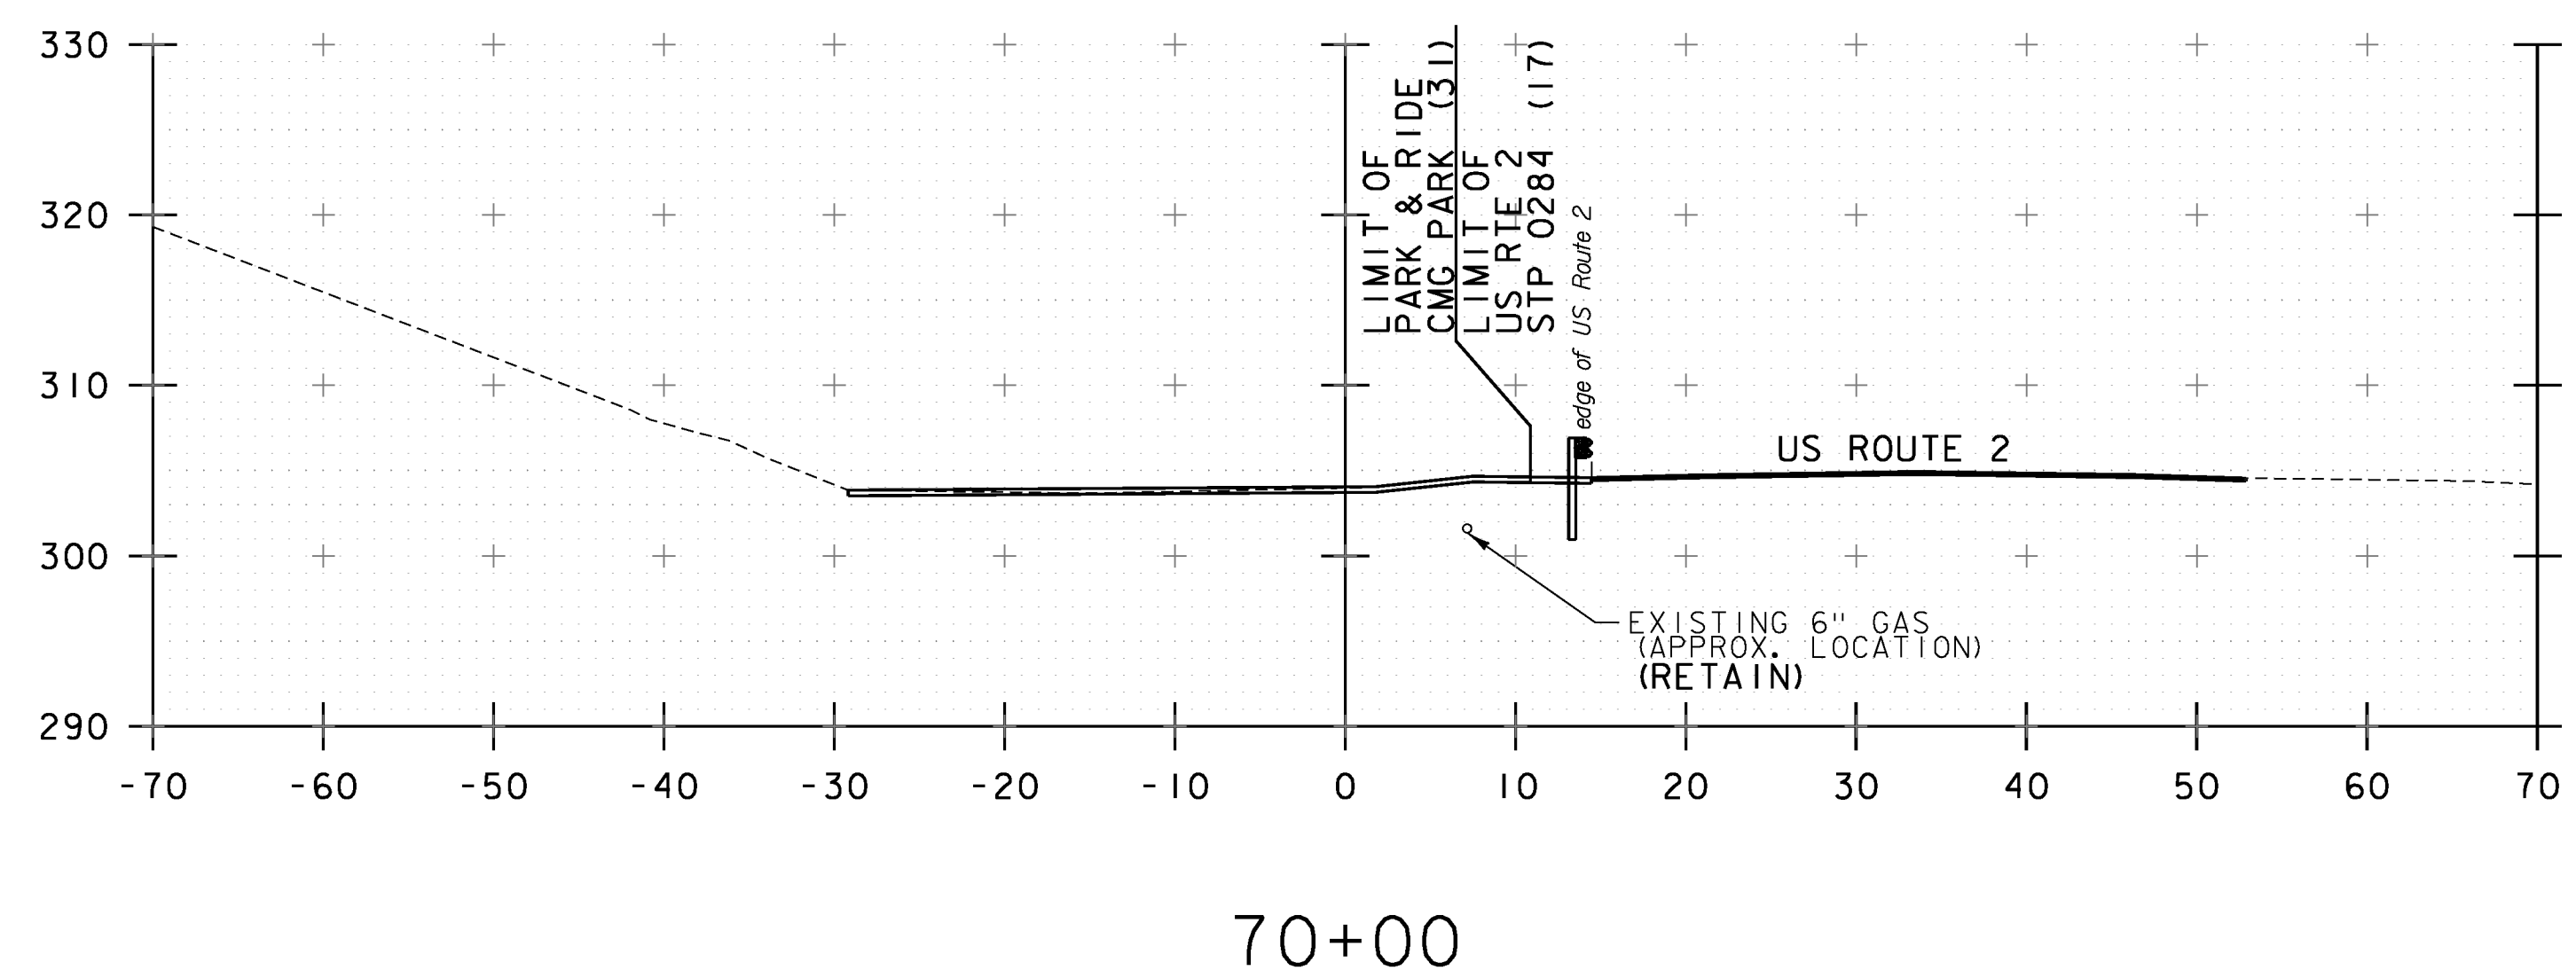
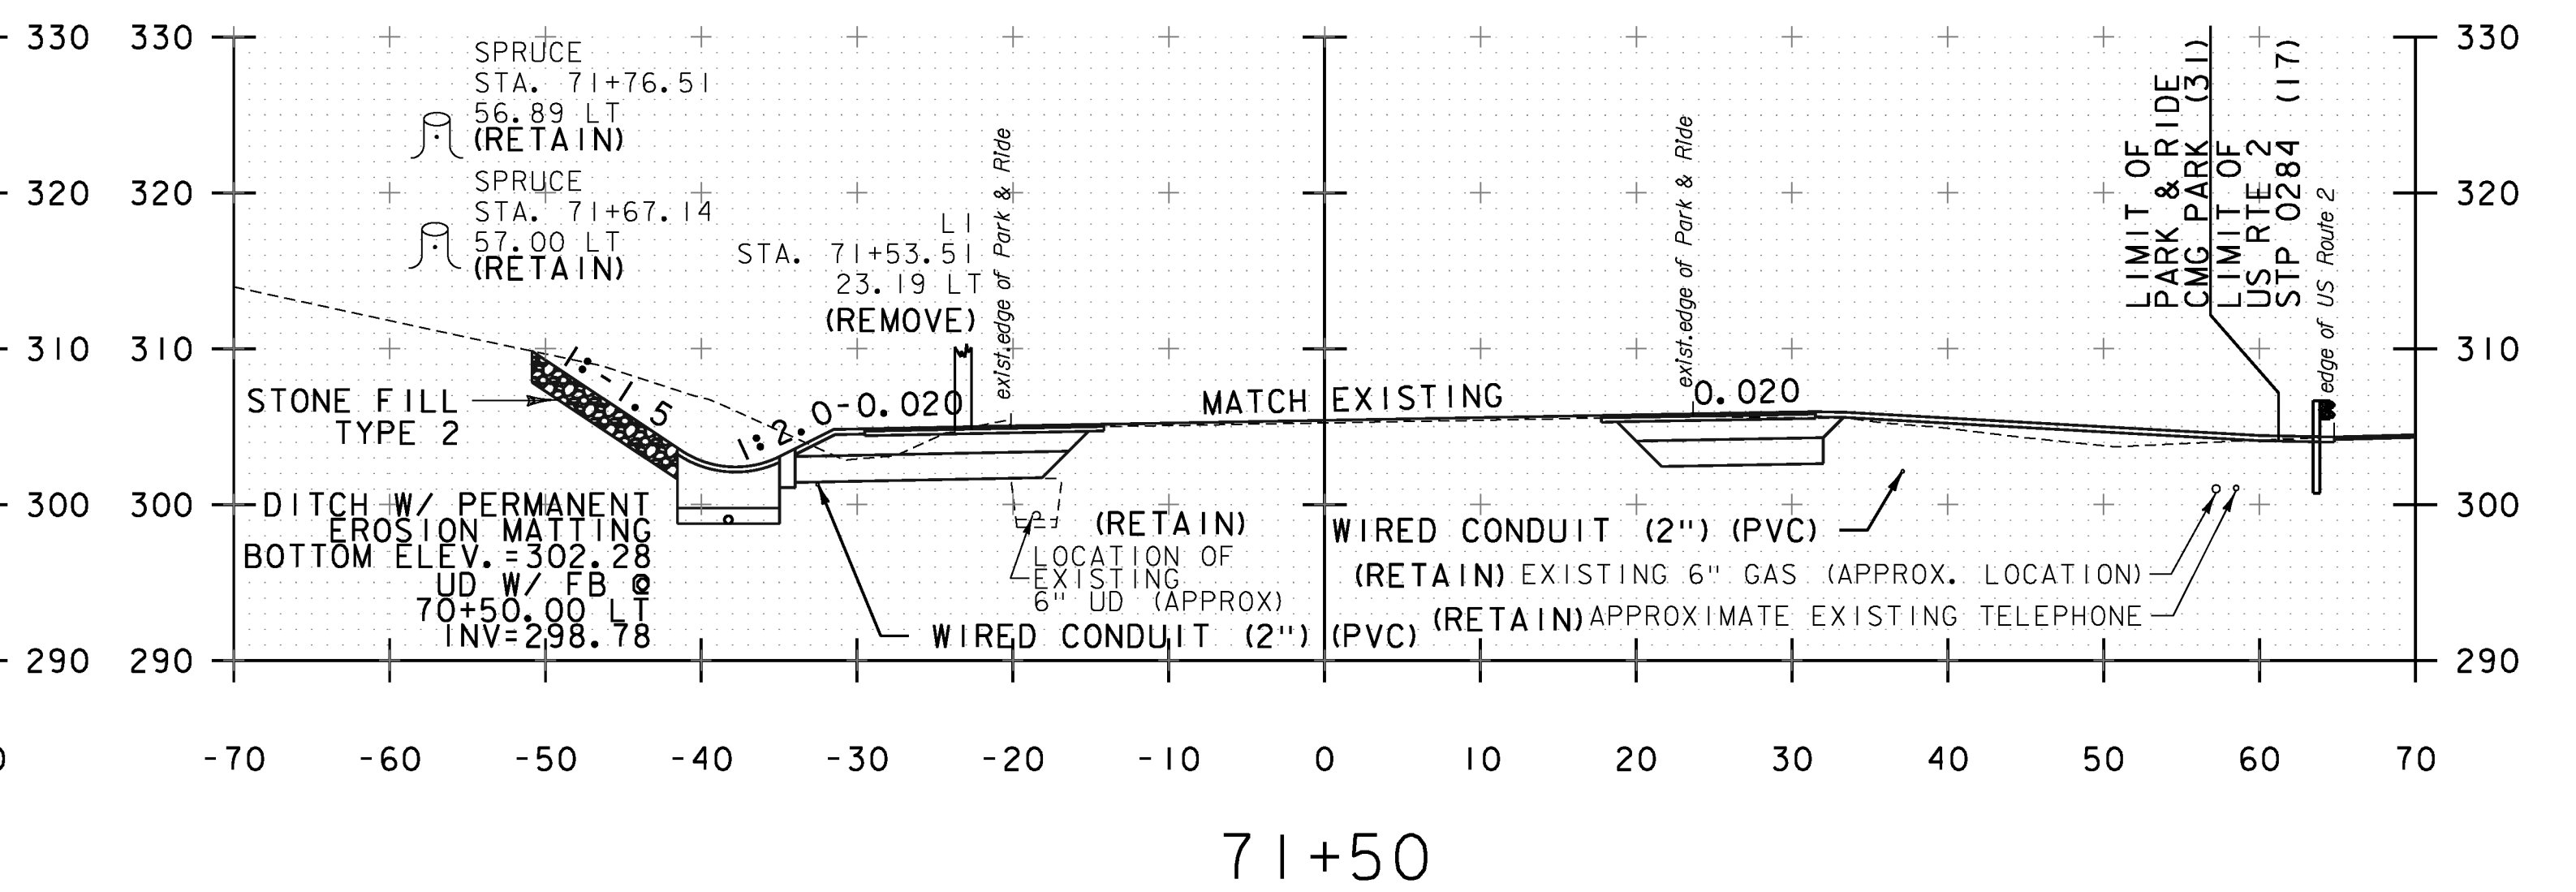


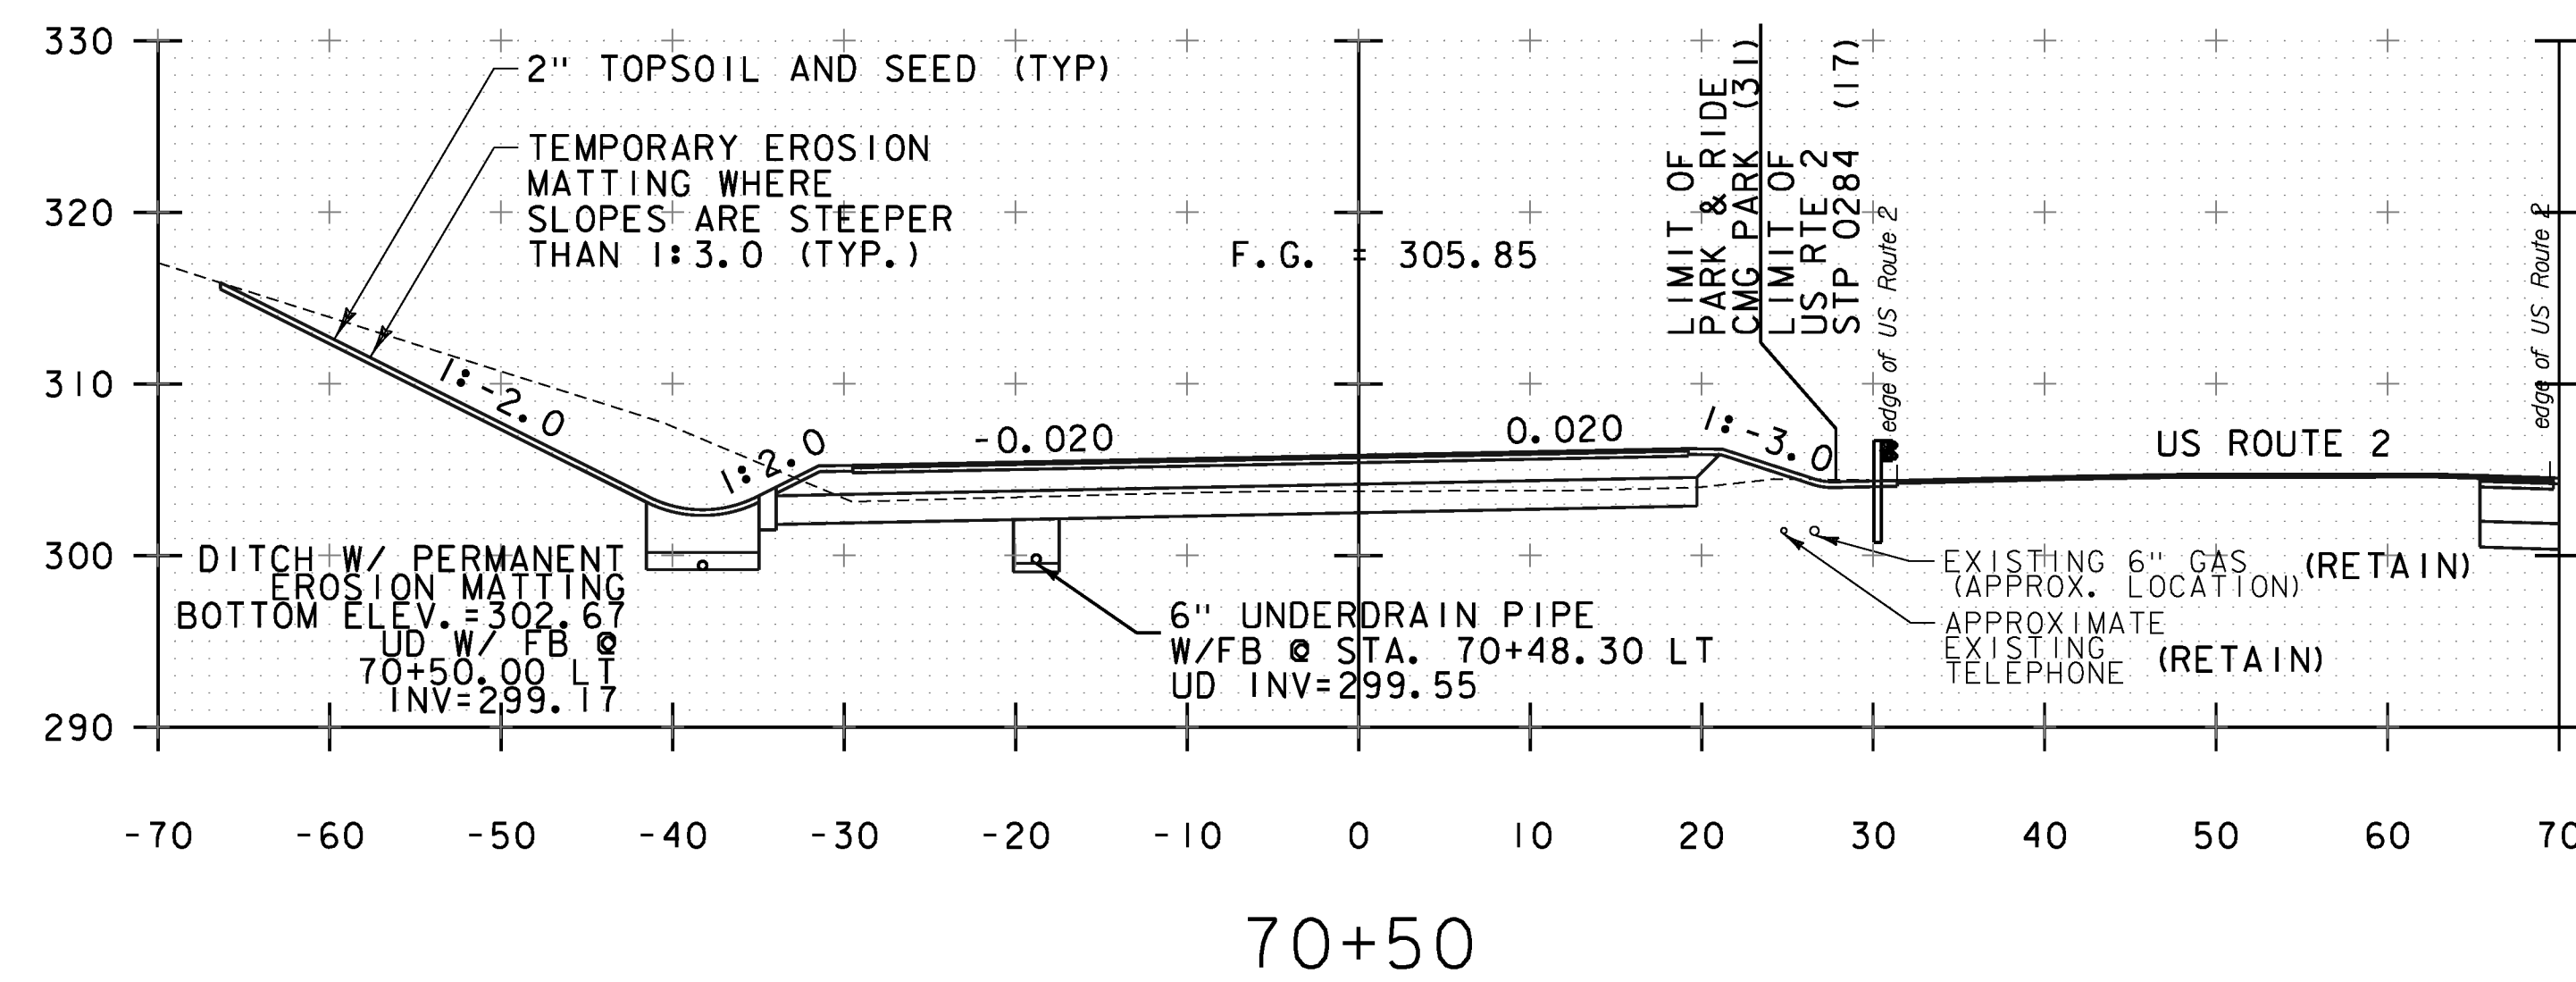

STA. 70+00 TO STA. 71+50

PROJECT NAME:	RICHMOND
PROJECT NUMBER:	CMG PARK (31)
FILE NAME: z97ci86xsl.dgn	PLOT DATE: 4/29/2013
PROJECT LEADER: ERIK ATKINS	DRAWN BY: S.FORTIER
DESIGNED BY: T.BIGELOW	CHECKED BY: E. ATKINS
PARK & RIDE CROSS SECTIONS SHEET 1	SHEET 129 OF 133