




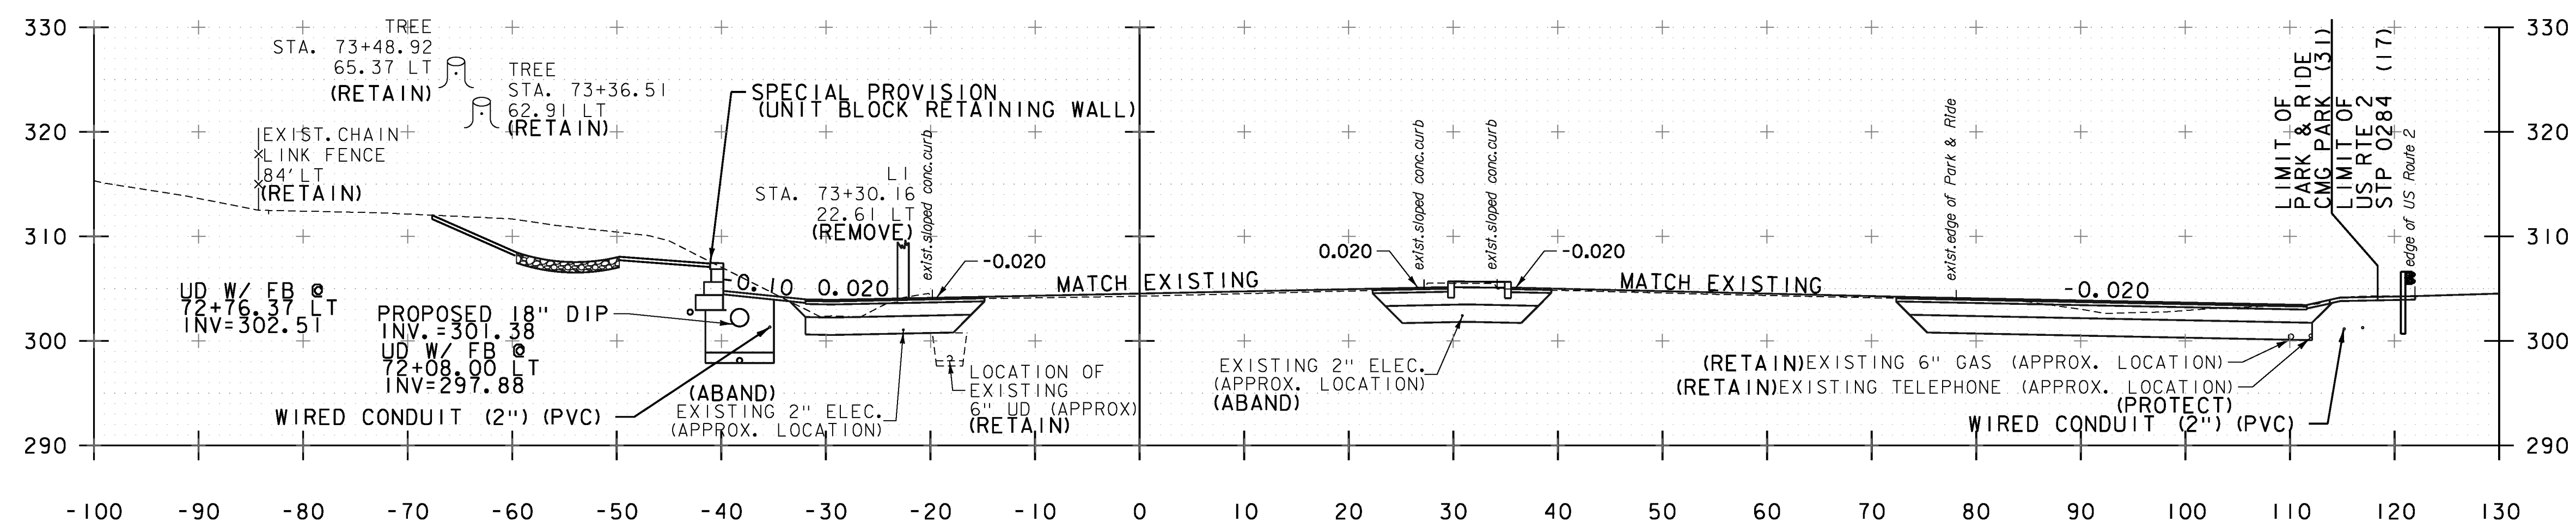

73+19.77 @ WP#2
SPECIAL PROVISION (UNIT BLOCK RETAINING WALL)

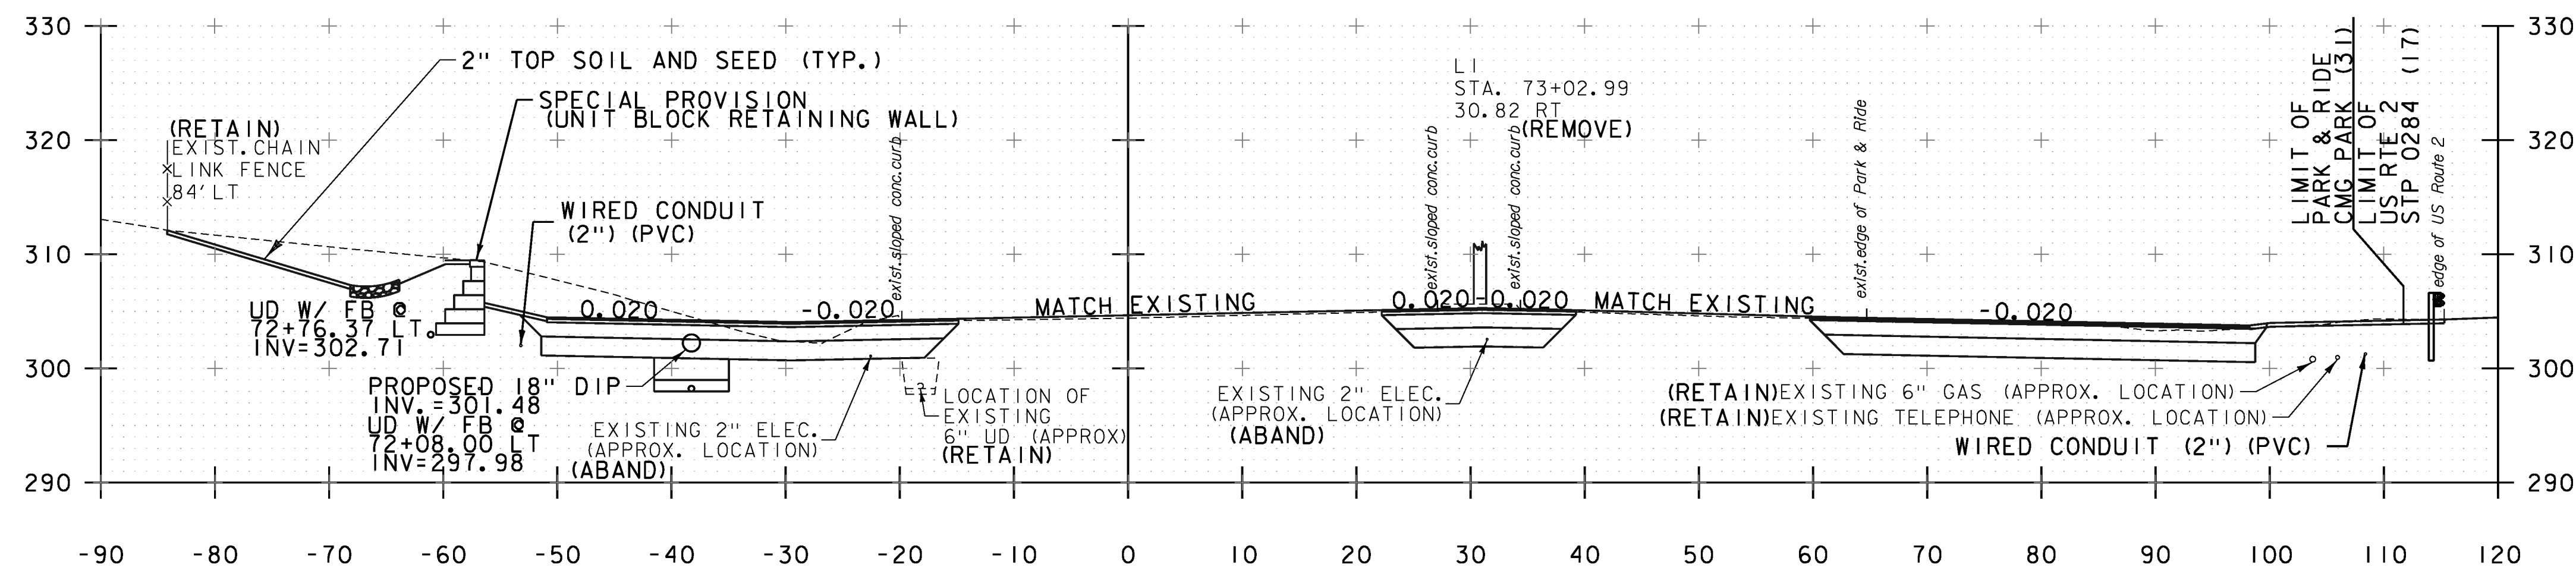

73+00

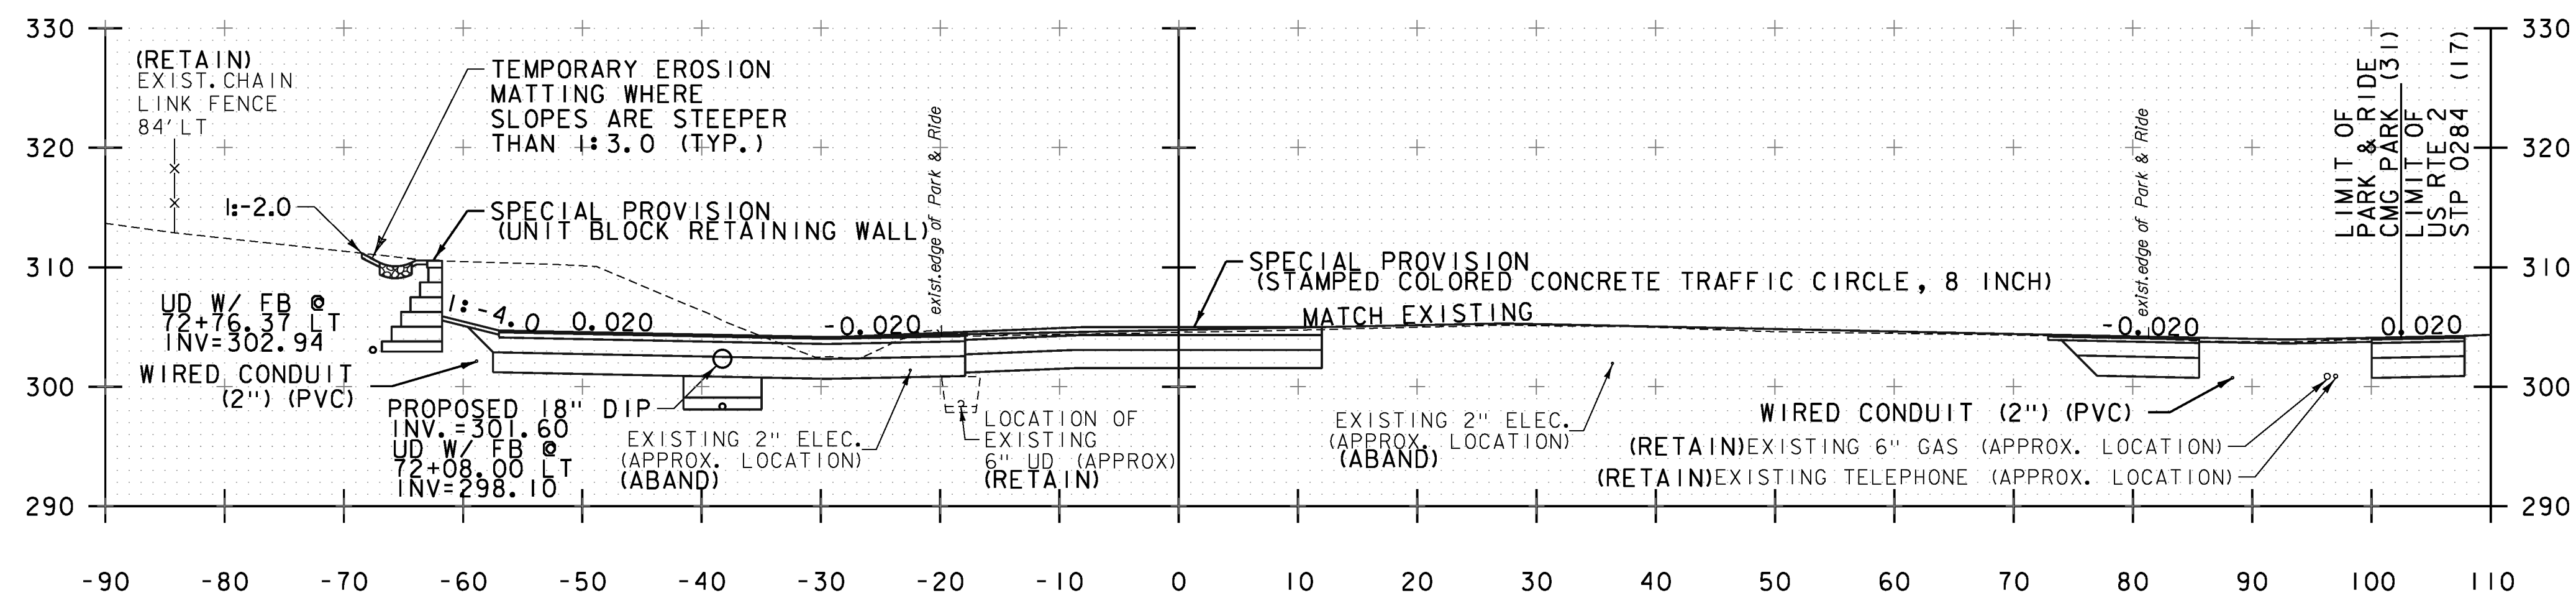

72+76.37 @ CENTER OF
SPECIAL PROVISION (STAMPED CONCRETE TRAFFIC CIRCLE, 8 INCH)

STA. 72+76.37 TO STA. 73+20

PROJECT NAME: RICHMOND
PROJECT NUMBER: CMG PARK (31)

FILE NAME: z97ci86xsl.dgn
PROJECT LEADER: ERIK ATKINS
DESIGNED BY: T. BIGELOW
PARK & RIDE CROSS SECTIONS SHEET 3

PLOT DATE: 4/29/2013
DRAWN BY: S. FORTIER
CHECKED BY: E. ATKINS
SHEET 131 OF 133