



74+50

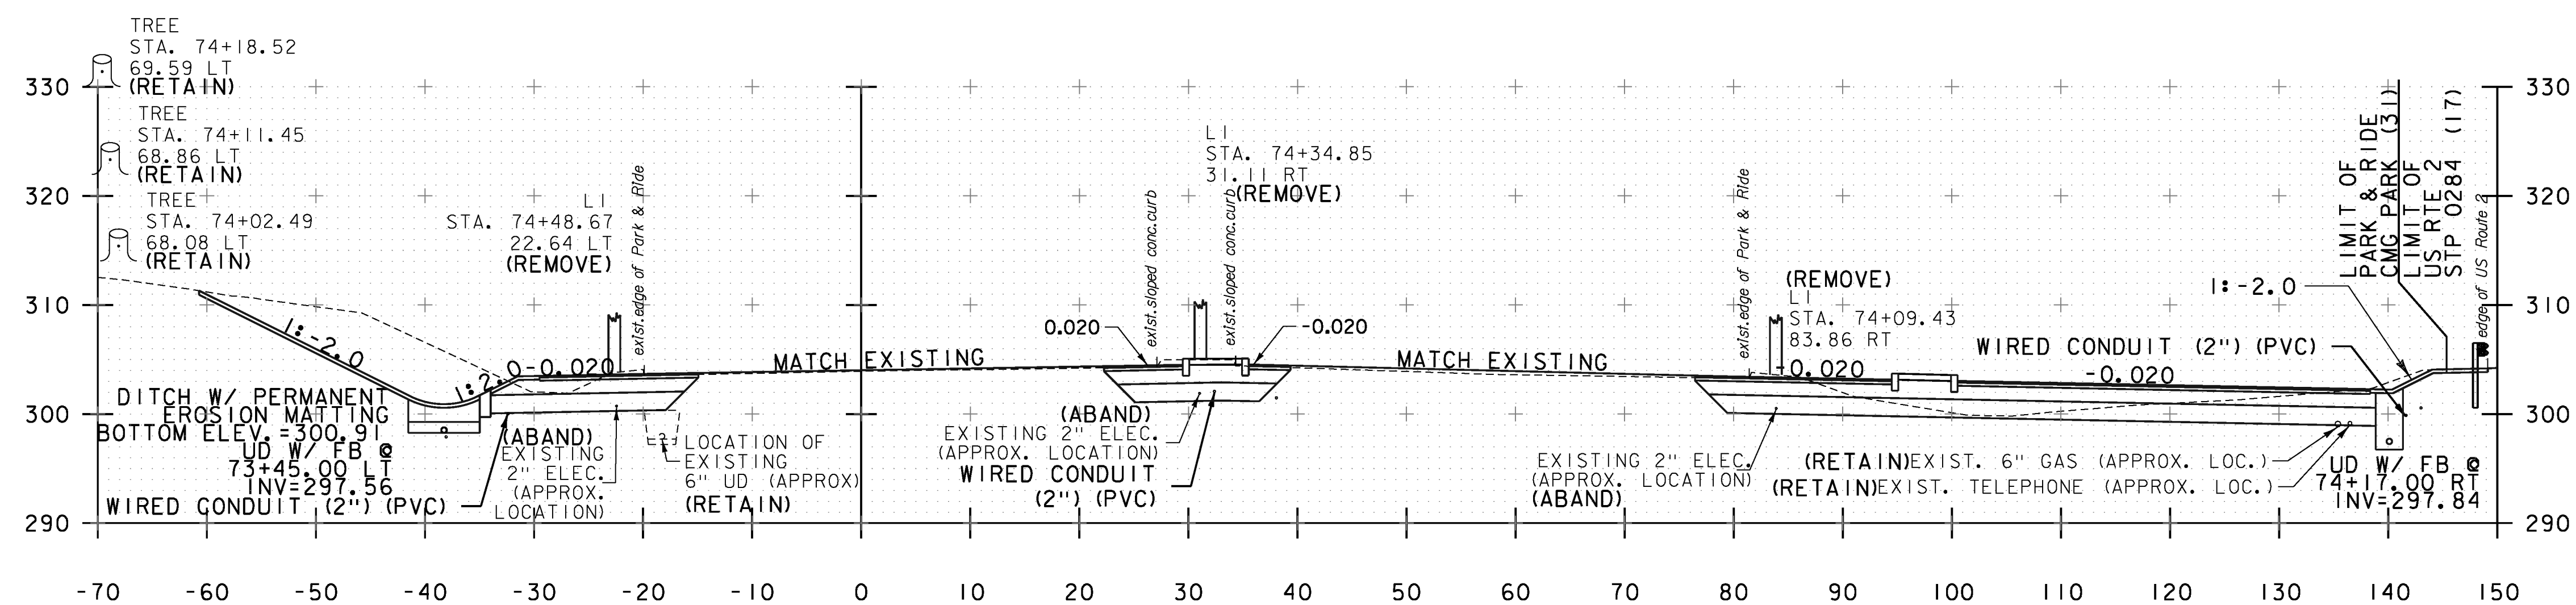

74+00

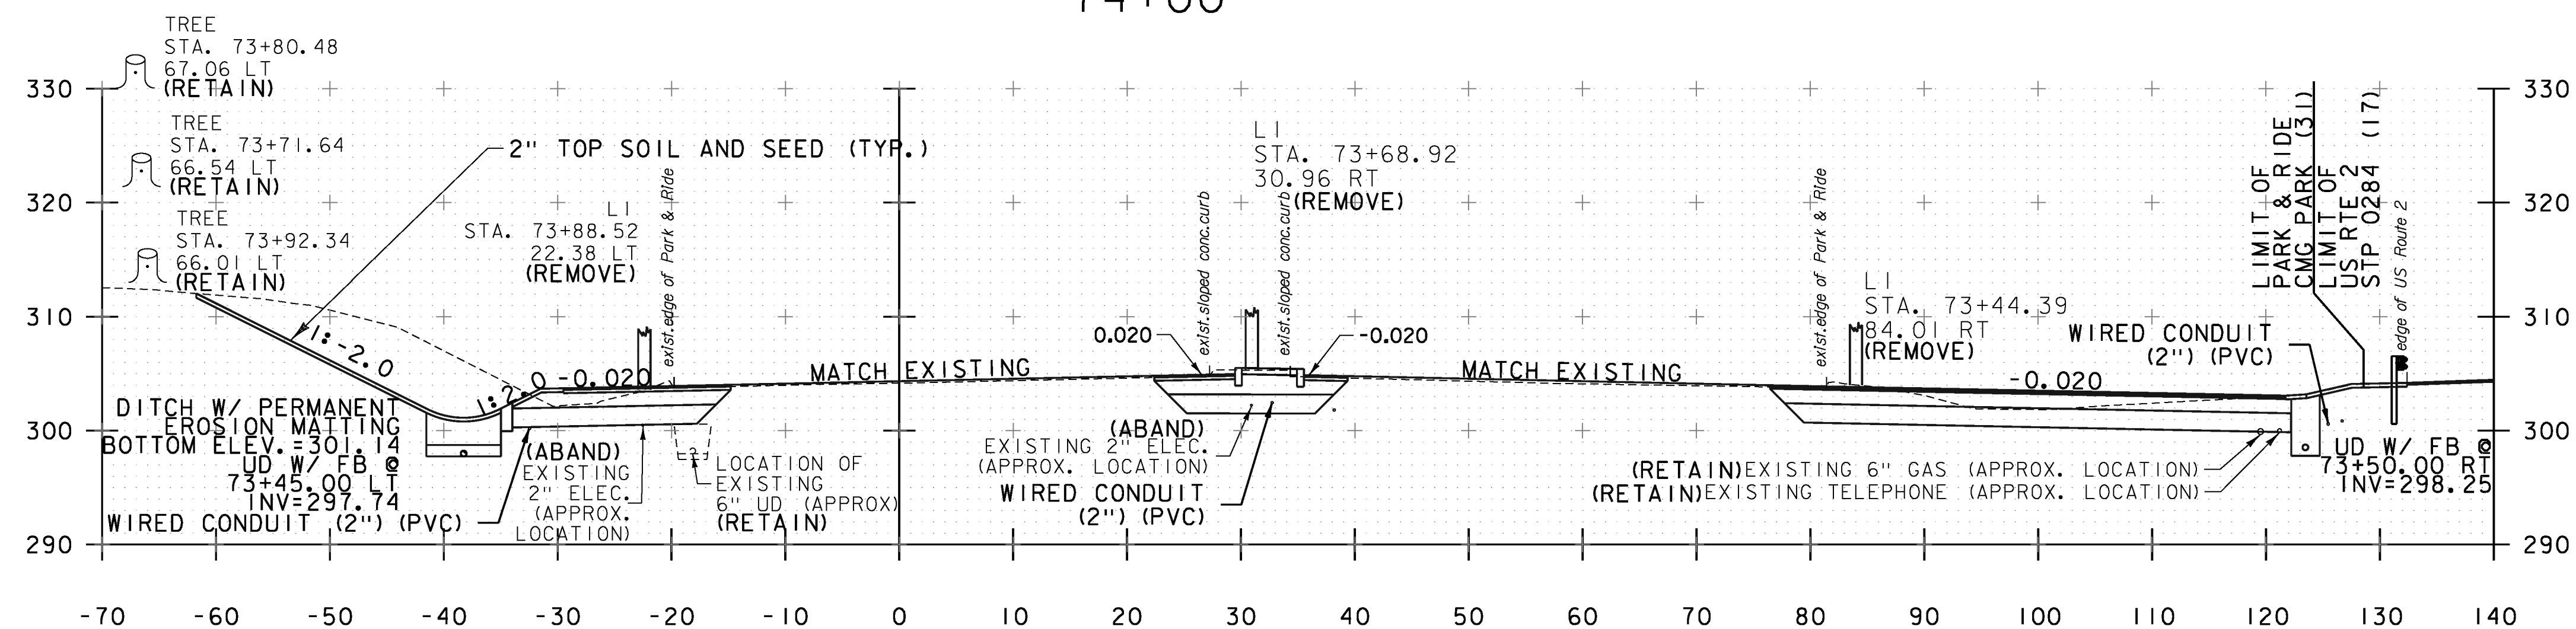

73+50

STA. 73+50 TO STA. 74+50

PROJECT NAME: RICHMOND
PROJECT NUMBER: CMG PARK (31)

FILE NAME: z97ci86xsl.dgn PLOT DATE: 4/29/2013
PROJECT LEADER: ERIK ATKINS DRAWN BY: S. FORTIER
DESIGNED BY: T. BIGELOW CHECKED BY: E. ATKINS
PARK & RIDE CROSS SECTIONS SHEET 4 SHEET 132 OF 133