
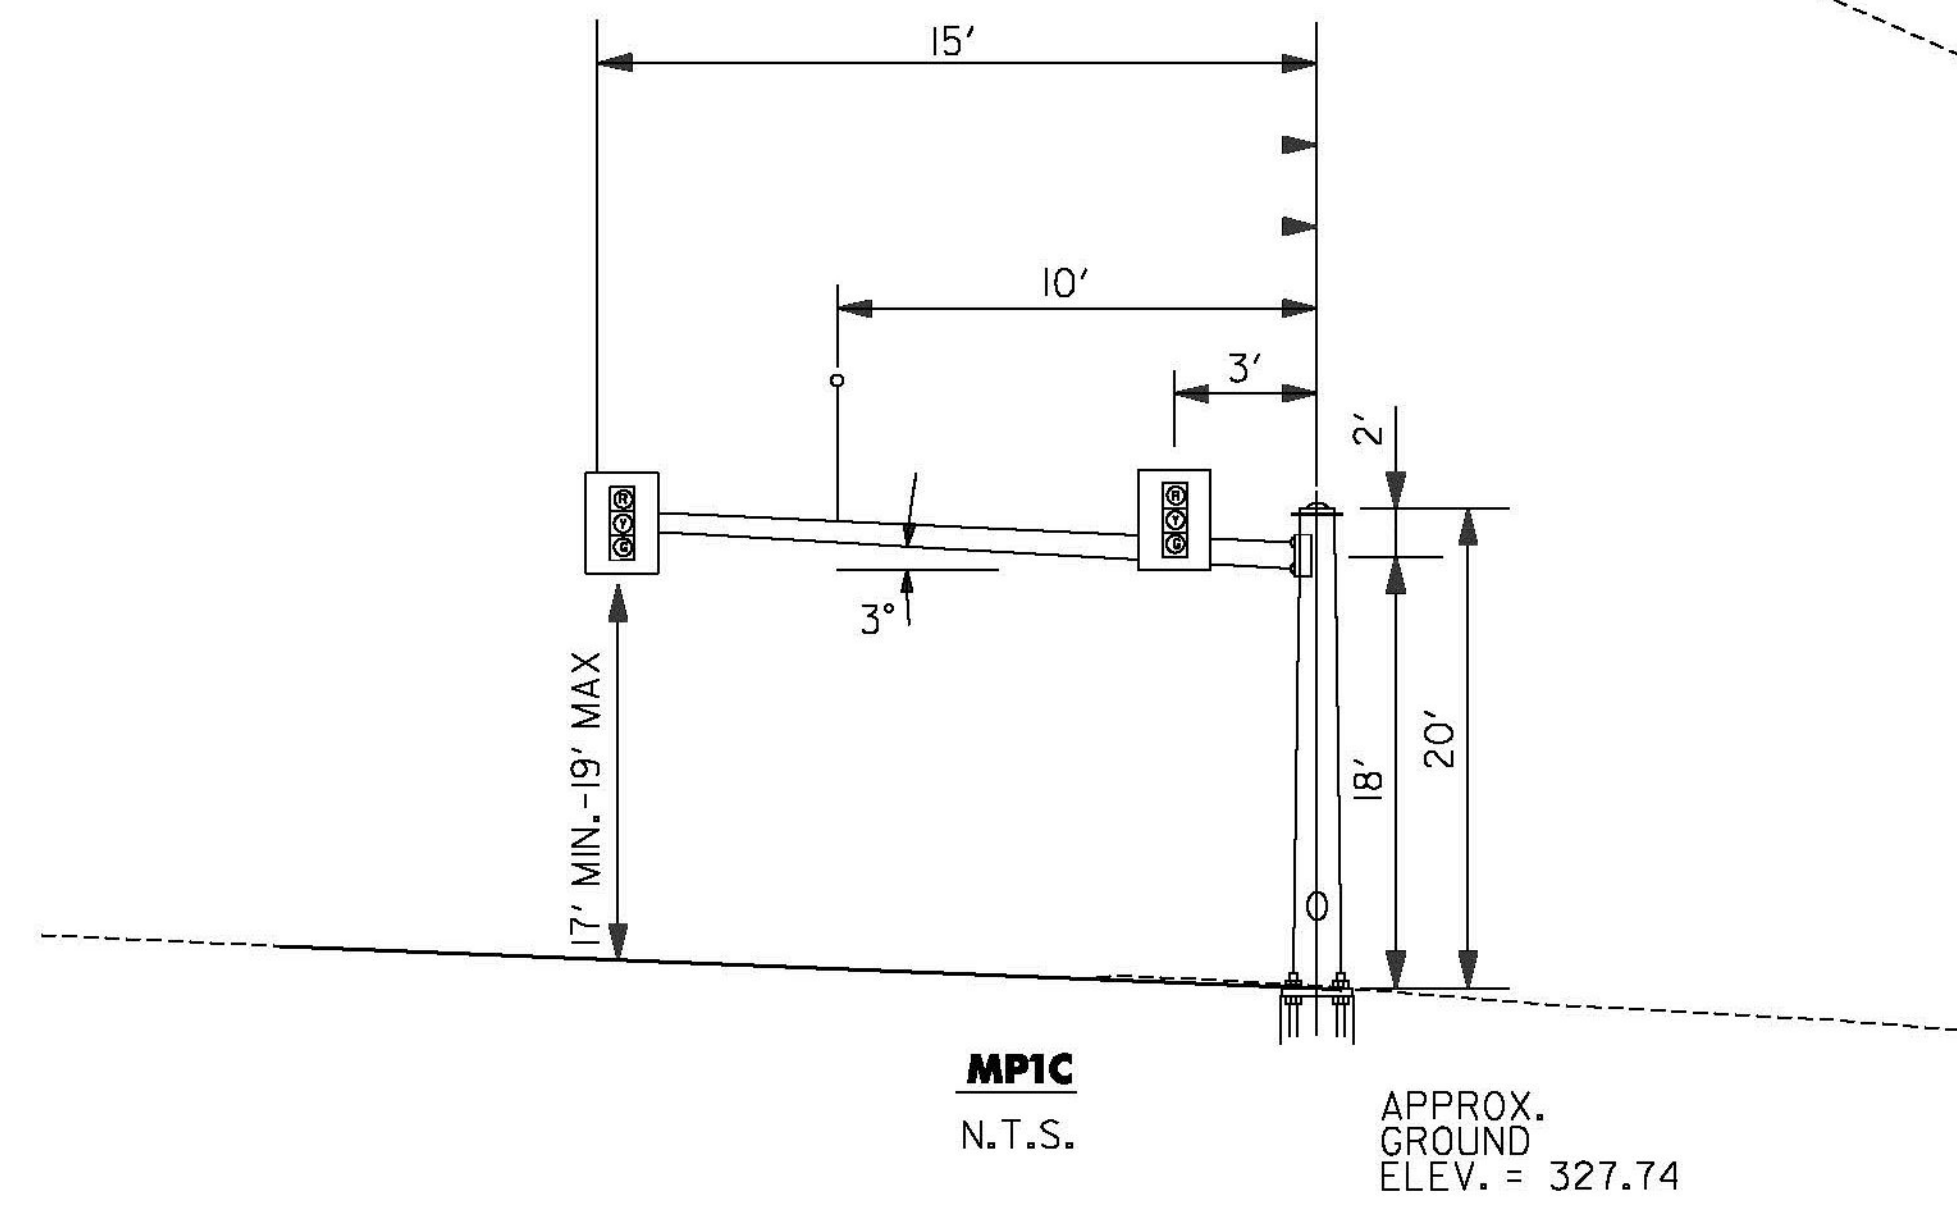
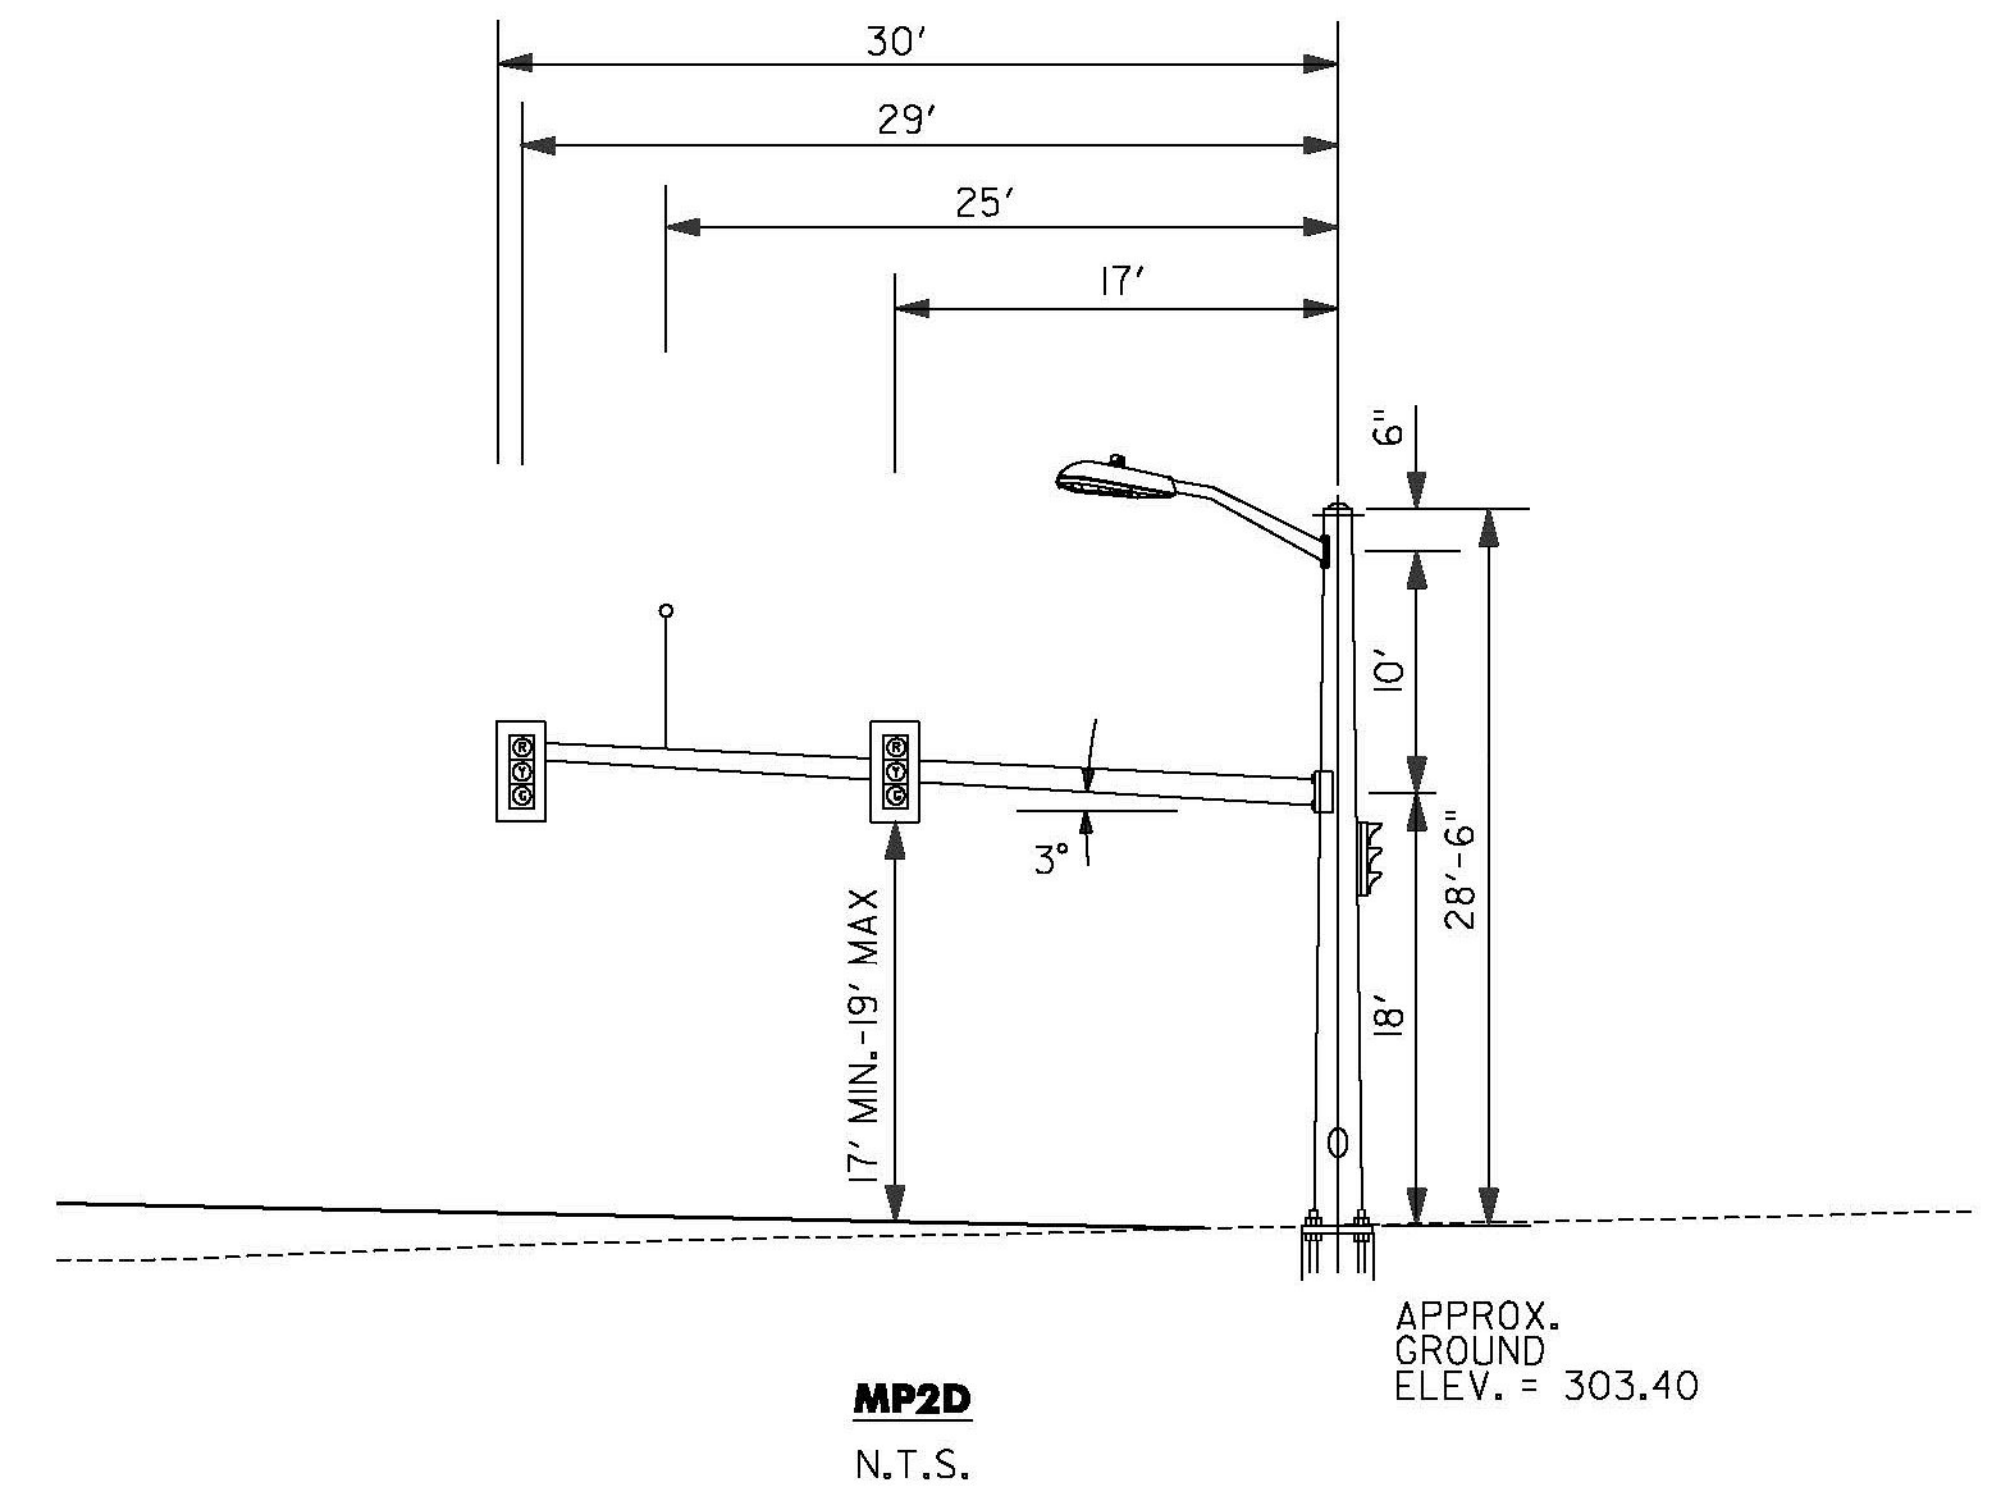
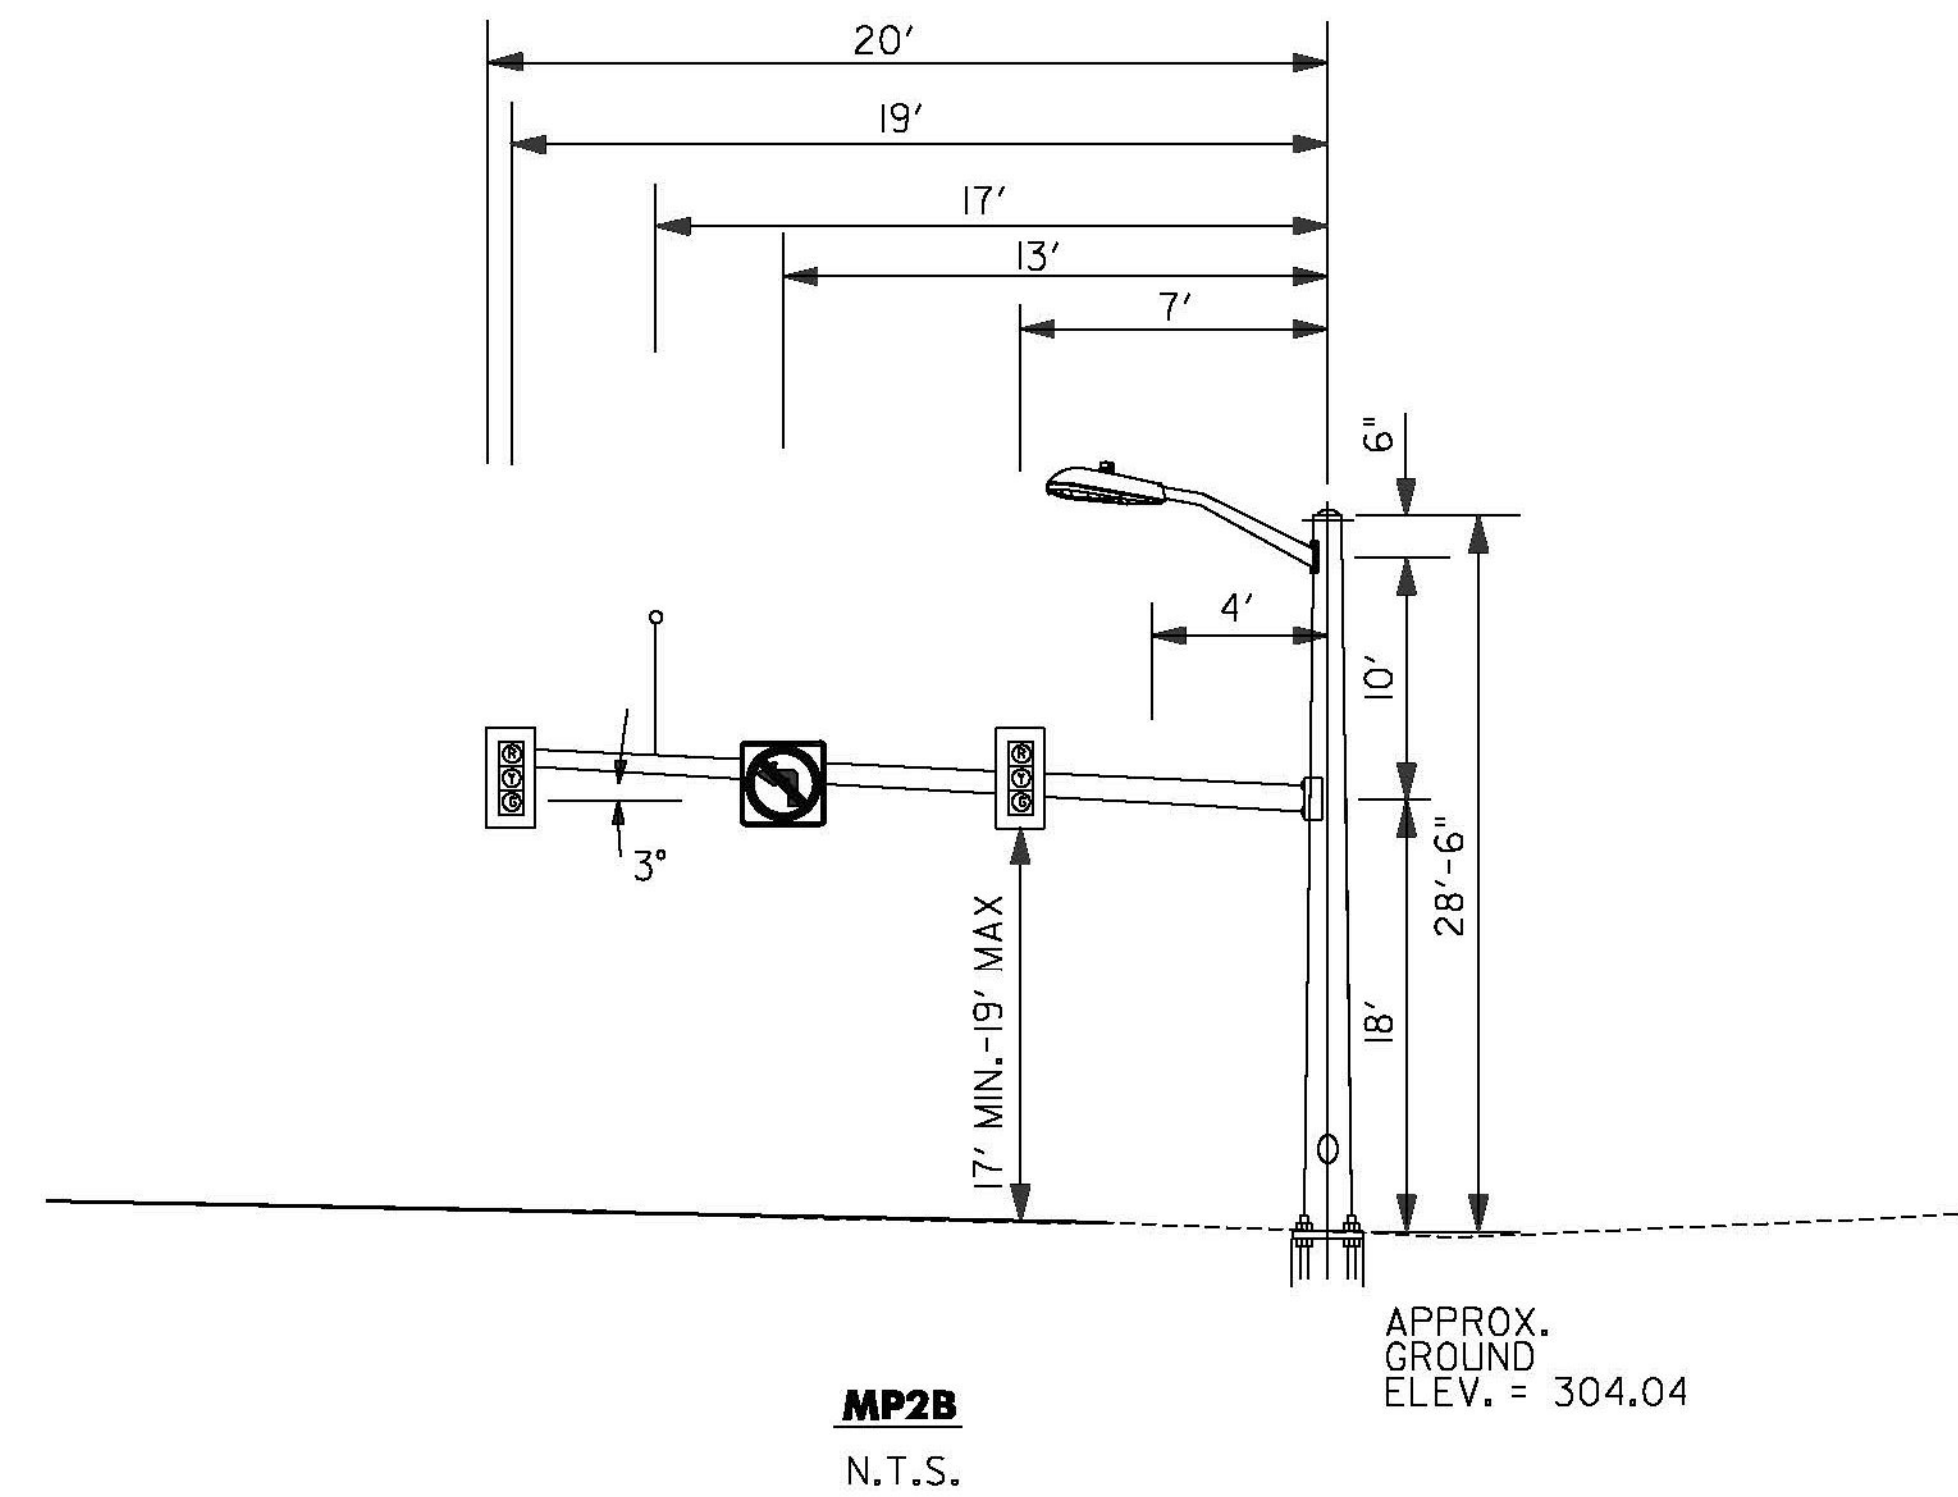
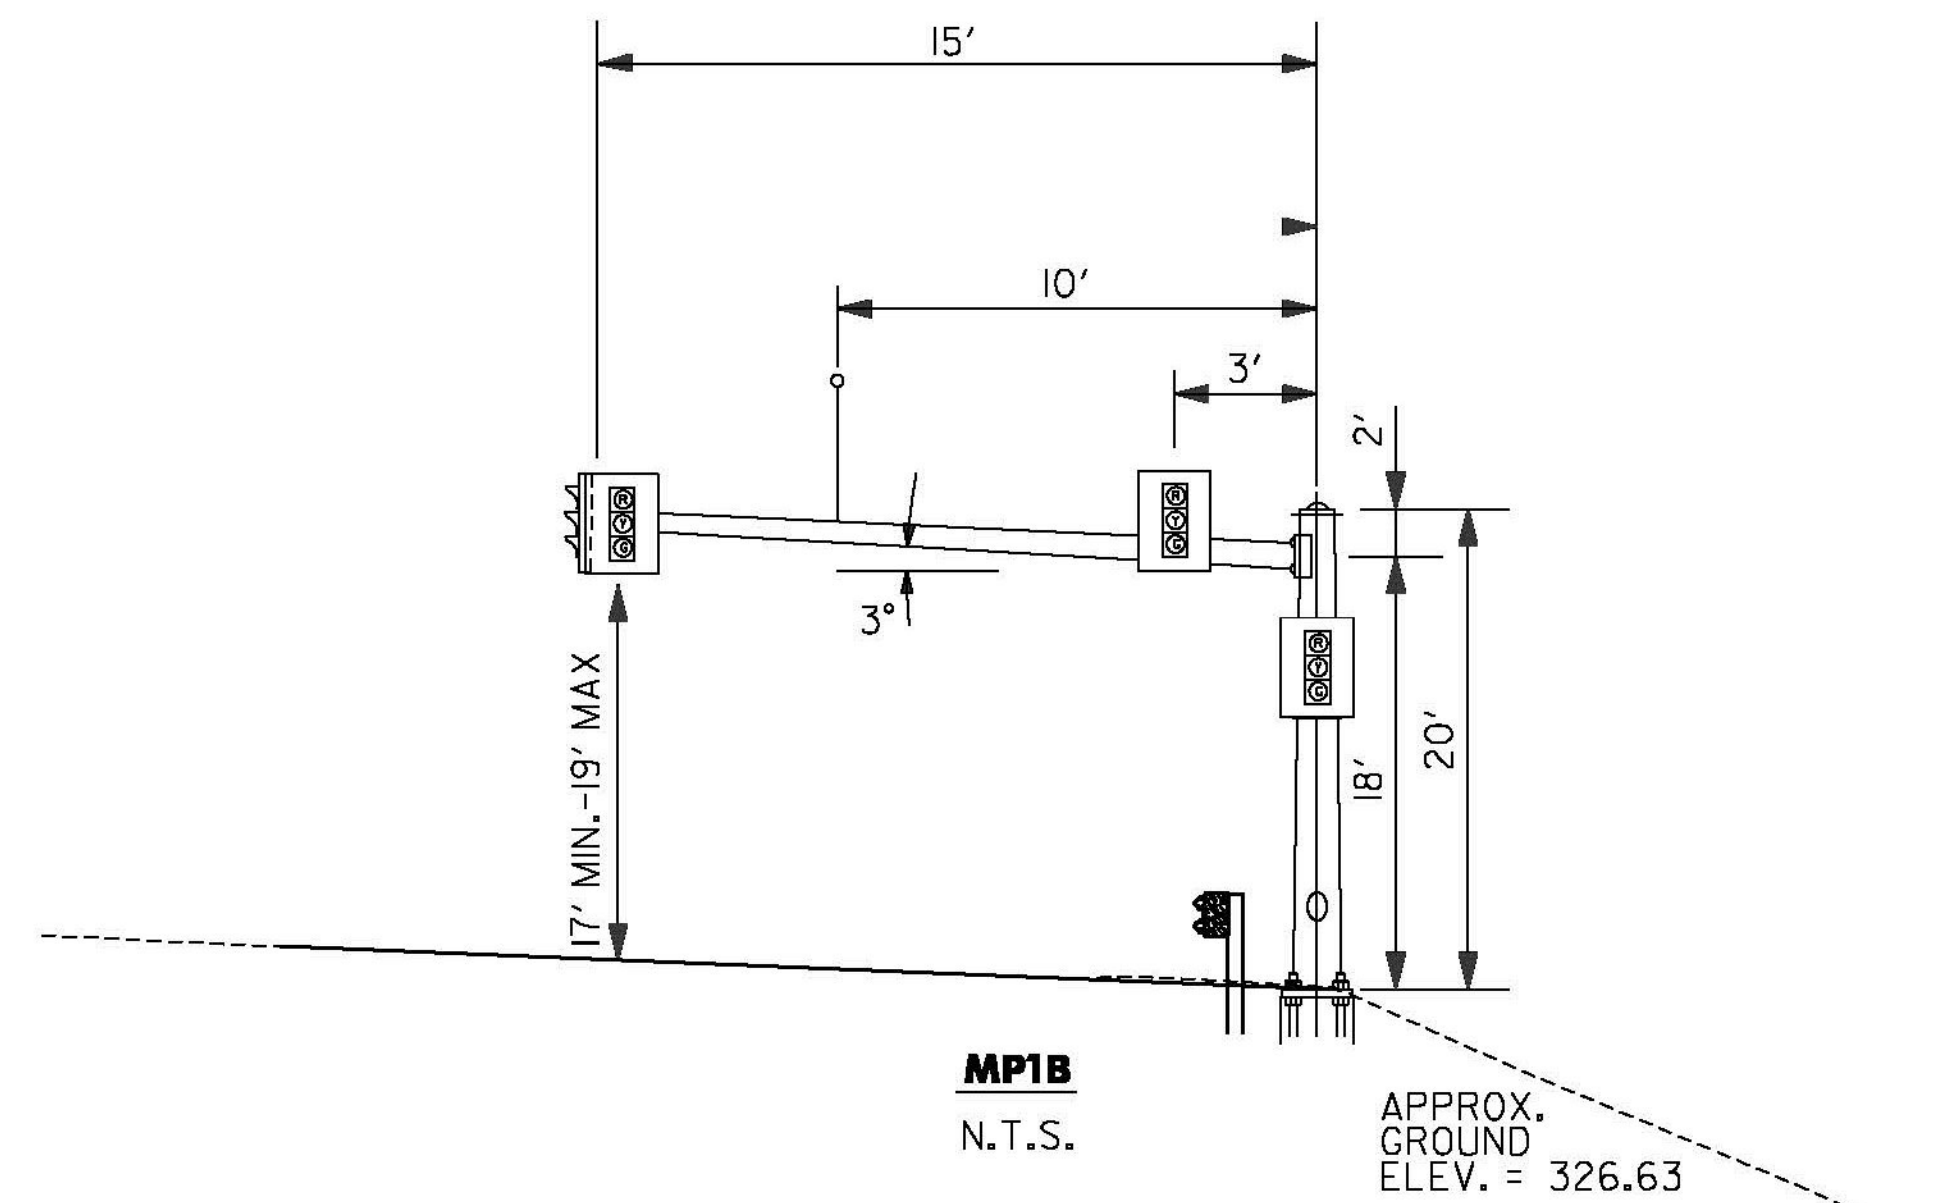
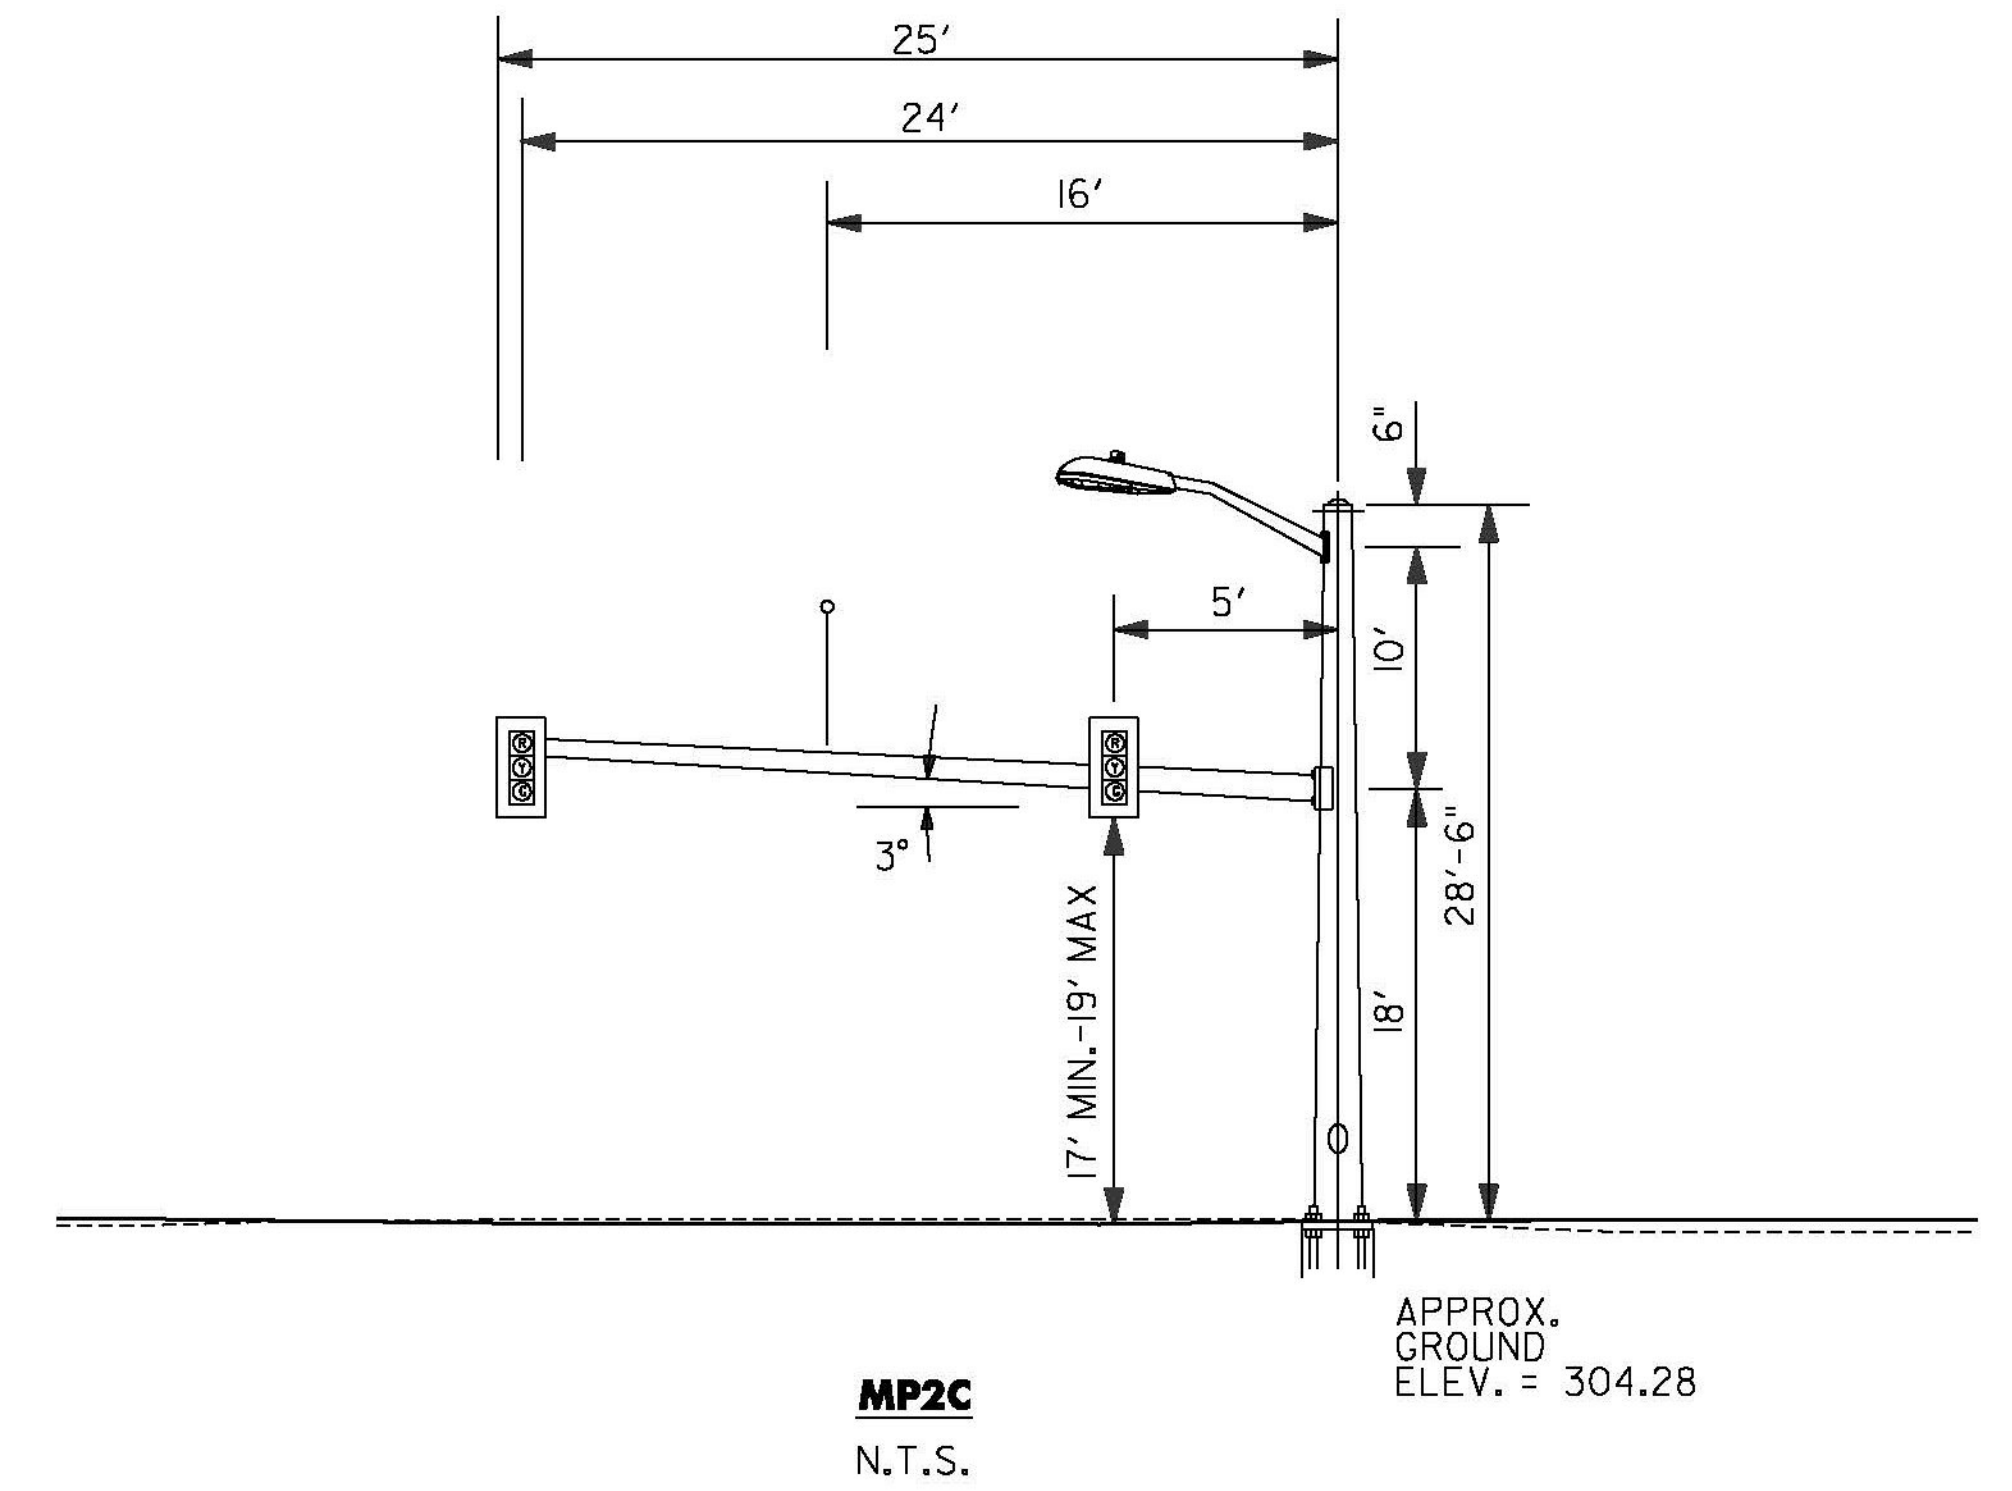
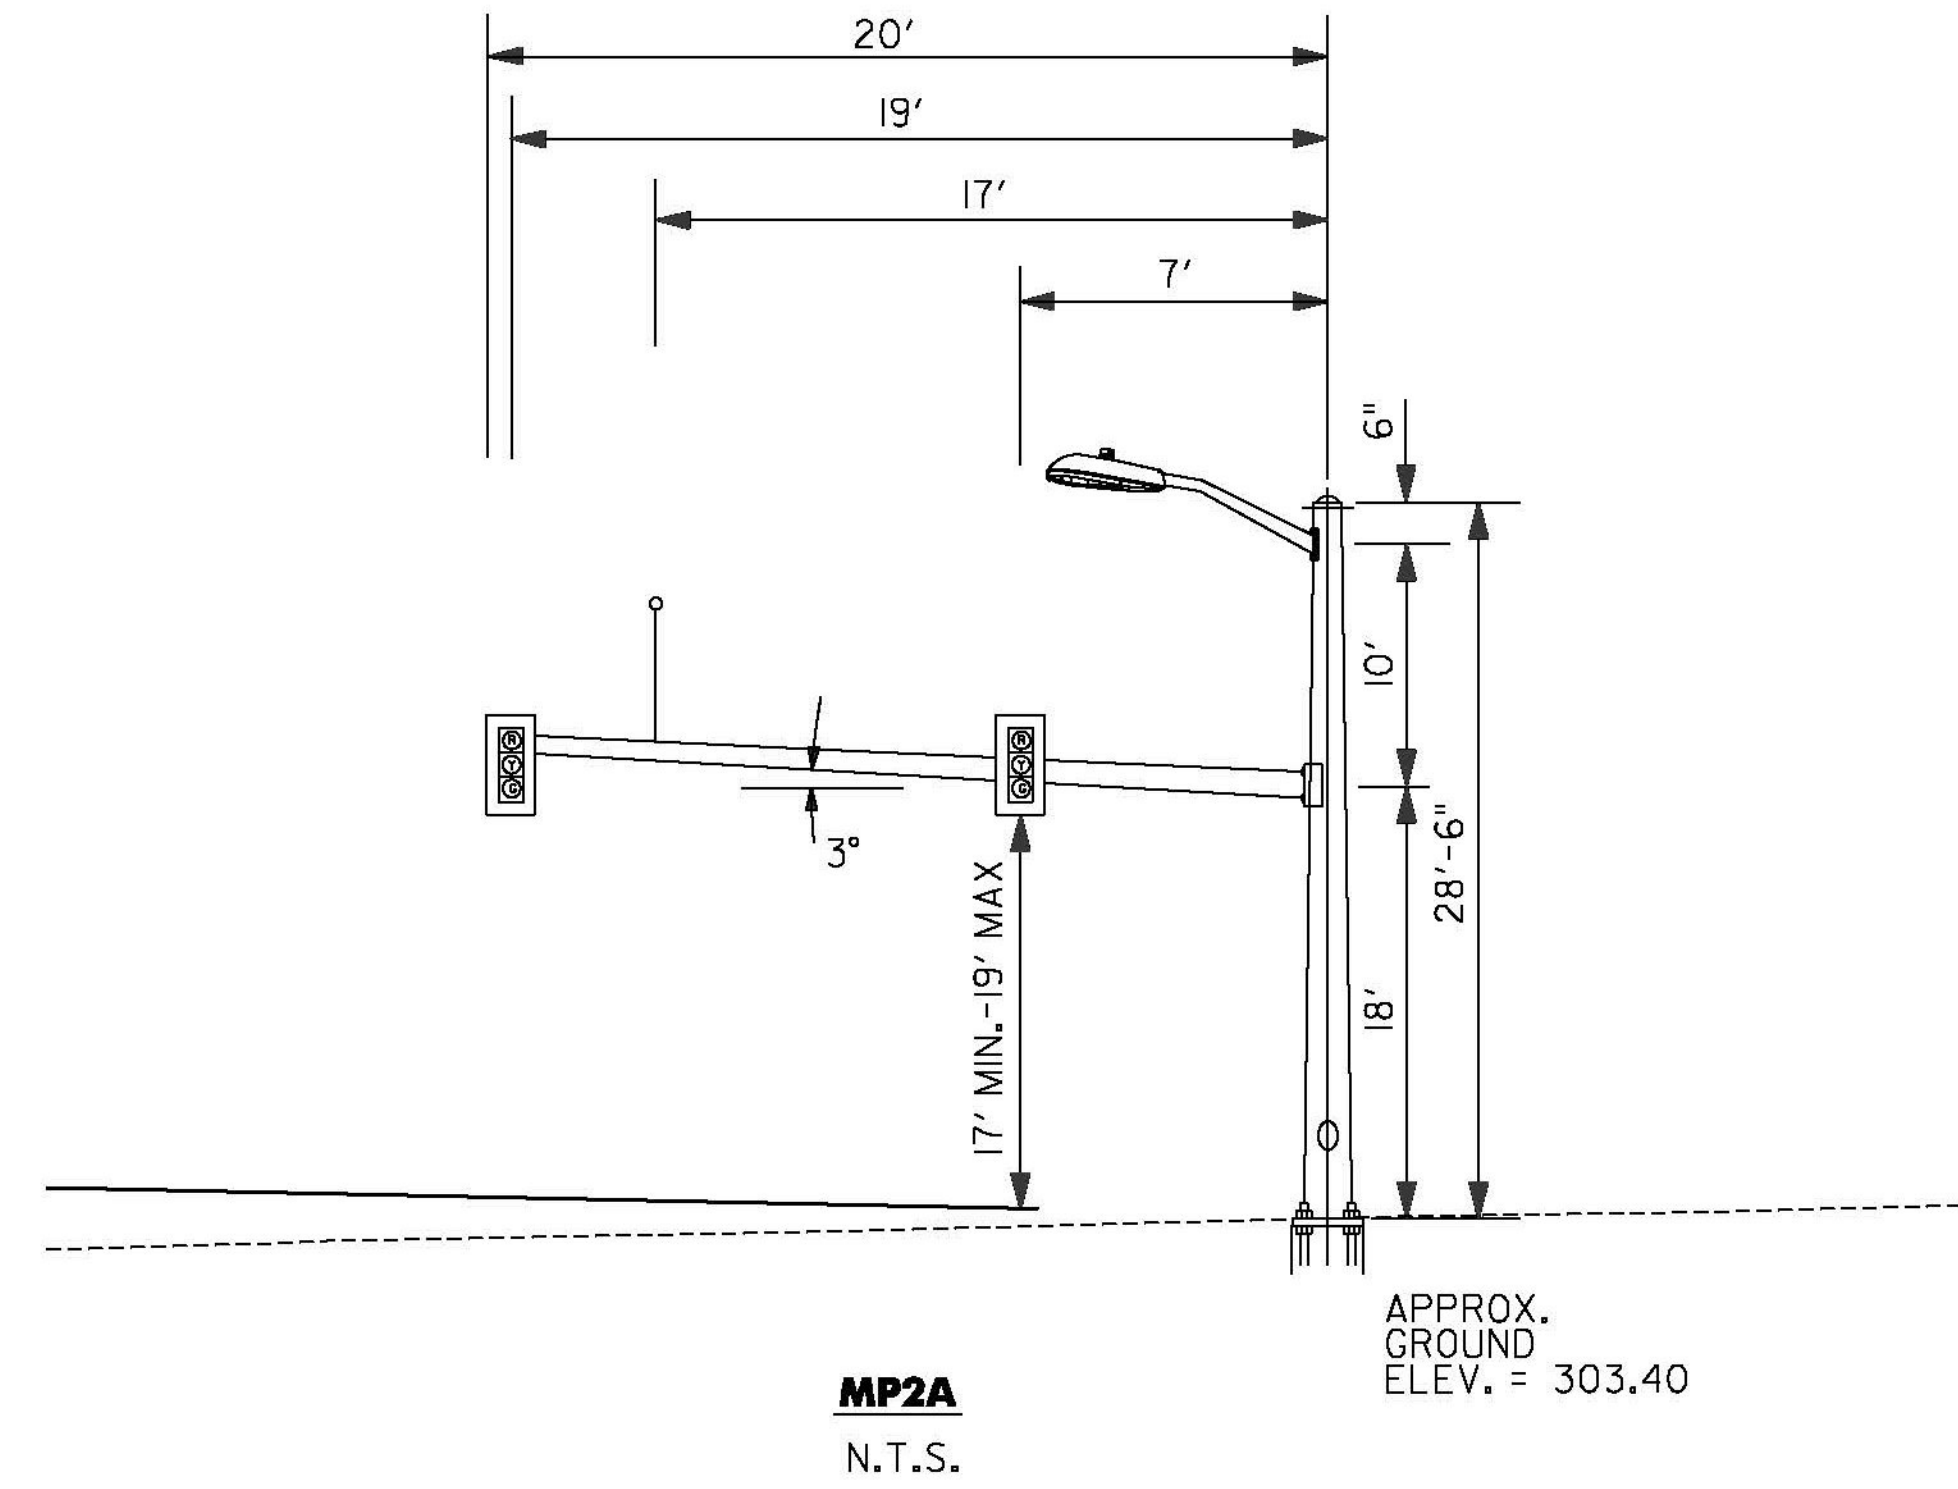


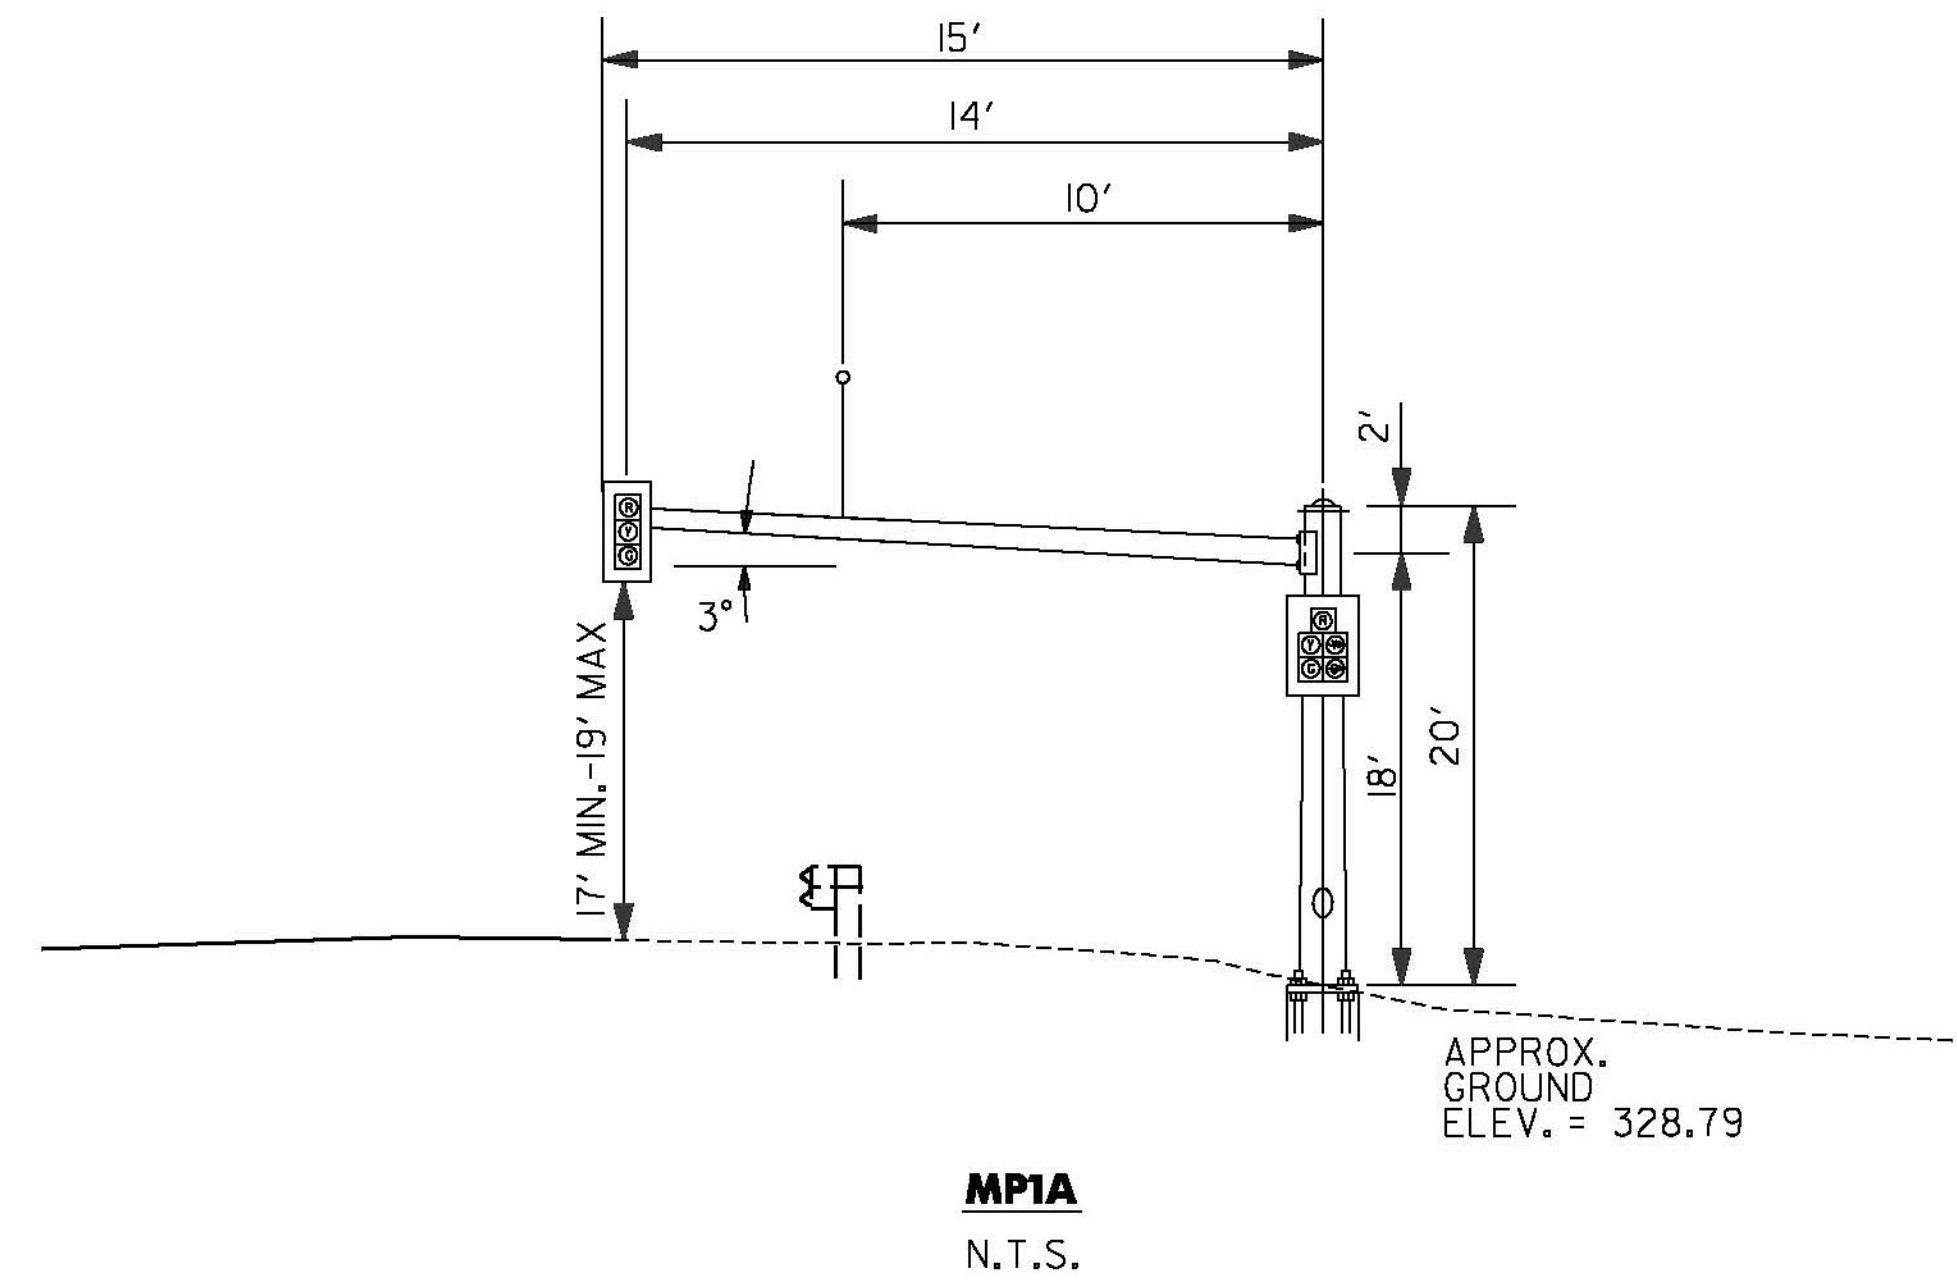

PROJECT NAME:	RICHMOND
PROJECT NUMBER:	STP 0284 (17)
FILE NAME: z97cl86trfbd2.dgn	PLOT DATE: 5/2/2013
PROJECT LEADER: JEFFREY MAXTUTIS	DRAWN BY: Y.CAO/LALMY
DESIGNED BY: J.SOBEL	CHECKED BY: D.FLYNN
TRAFFIC SIGNAL DETAIL SHEET 3	SHEET 73 OF 133