



PROFILE

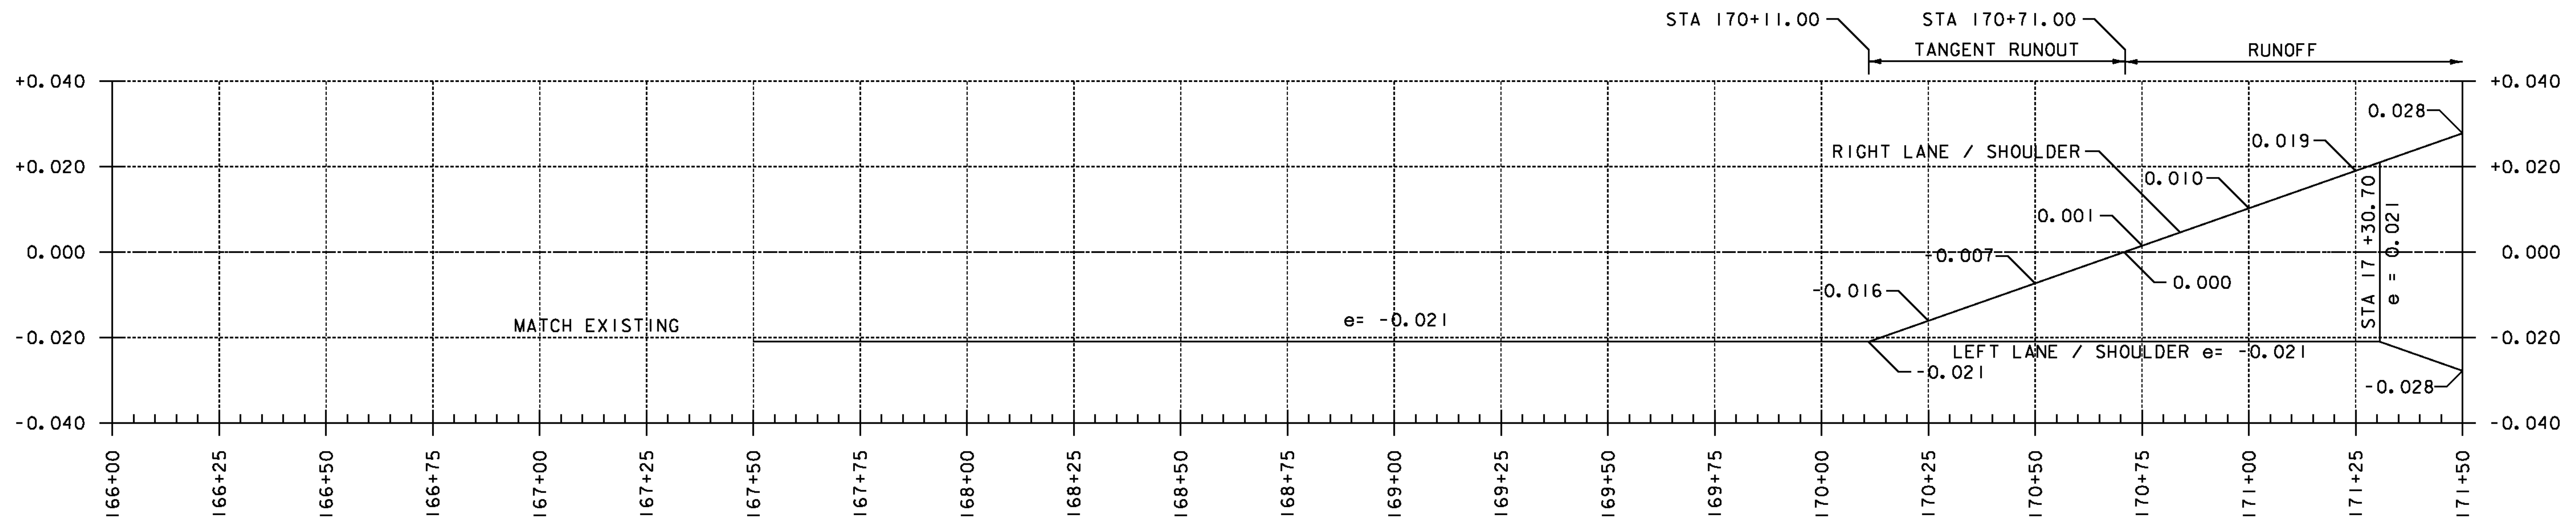

BANKING DIAGRAM

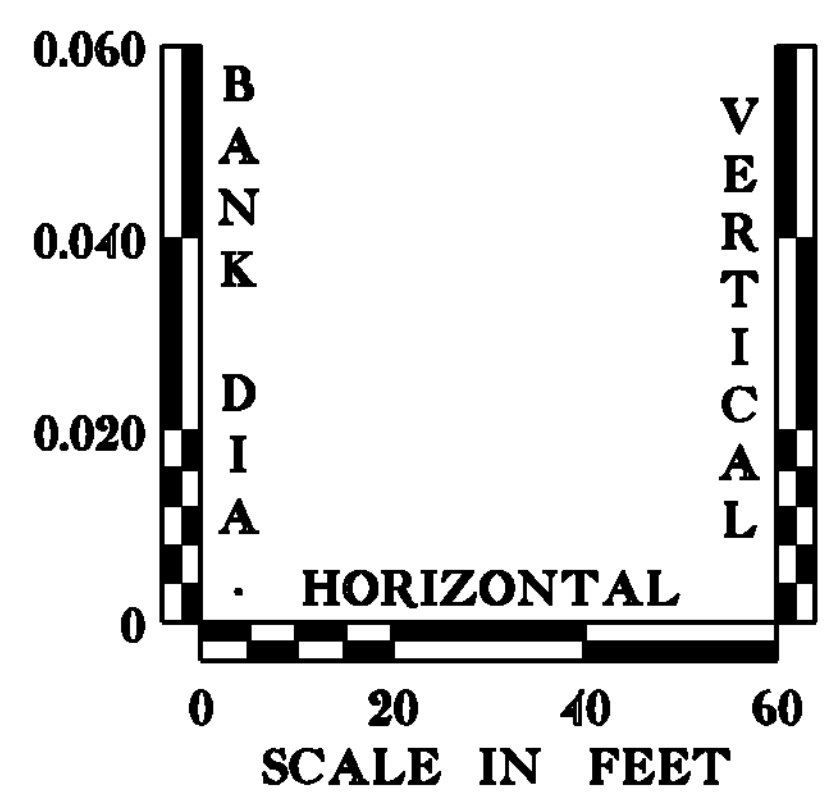

THE ELEVATIONS SHOWN TO THE NEAREST TENTH ARE THE OLD GROUND ALONG PROPOSED CENTERLINE. THE ELEVATIONS SHOWN TO THE NEAREST HUNDRETH ARE THE FINISHED GRADE ALONG THE PROPOSED CENTERLINE.

PROJECT NAME: ESSEX TOWN	PLOT DATE: 24-AUG-2012
PROJECT NUMBER: STP 5400 (5)	DRAWN BY: D. LYMAN
FILE NAME: +97d002pro.dgn	CHECKED BY: J. DEVLIN
PROJECT LEADER: J. SCHULTZ	SHEET 21 OF 64
DESIGNED BY: D. LYMAN	
VT ROUTE 117 - PROFILE SHEET 1	