



PROFILE

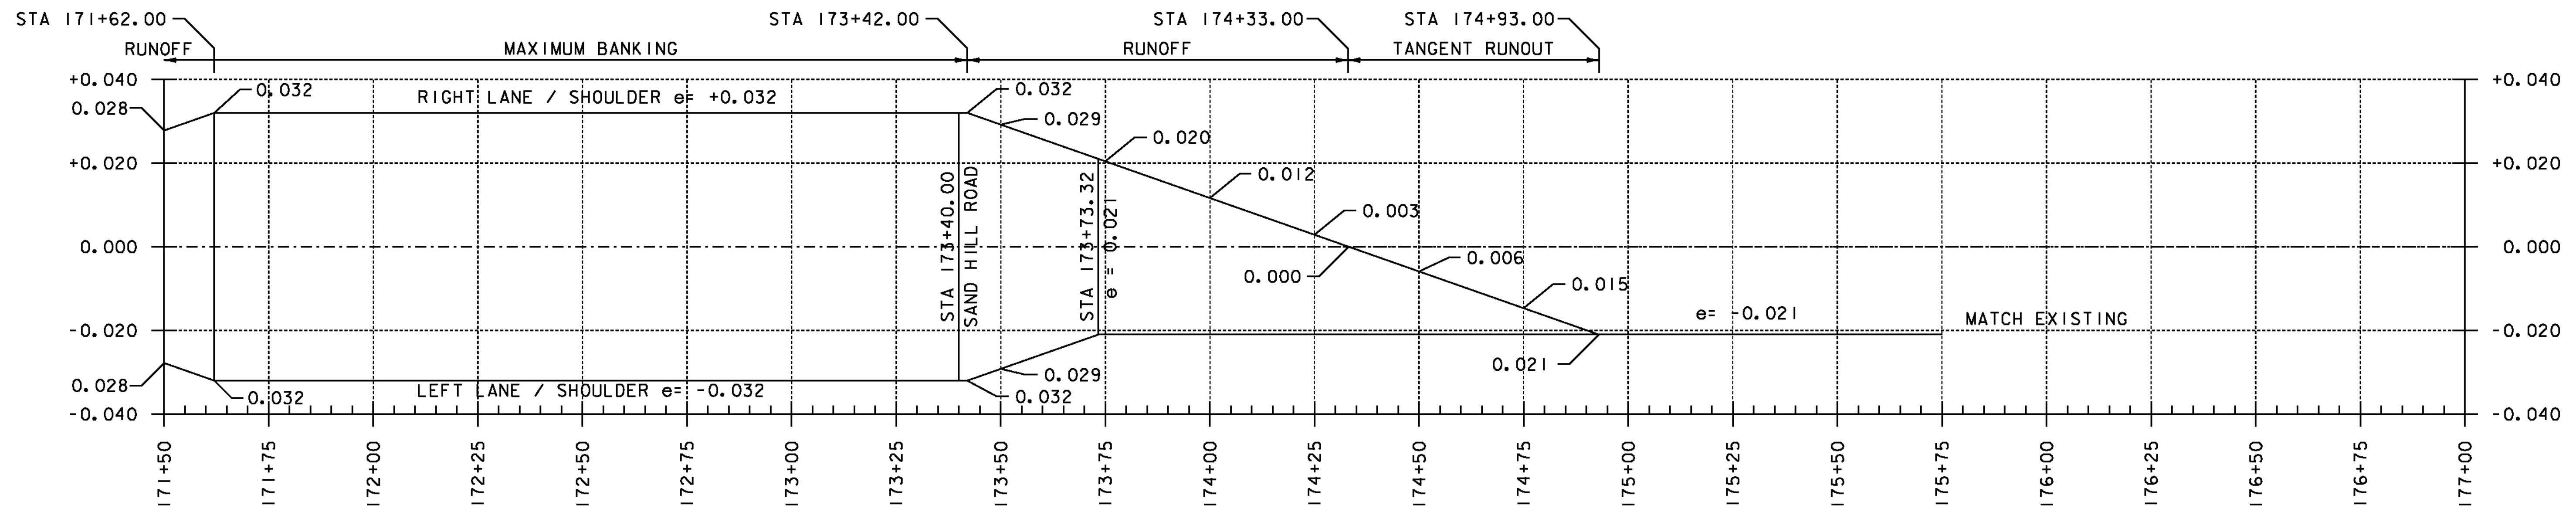

BANKING DIAGRAM

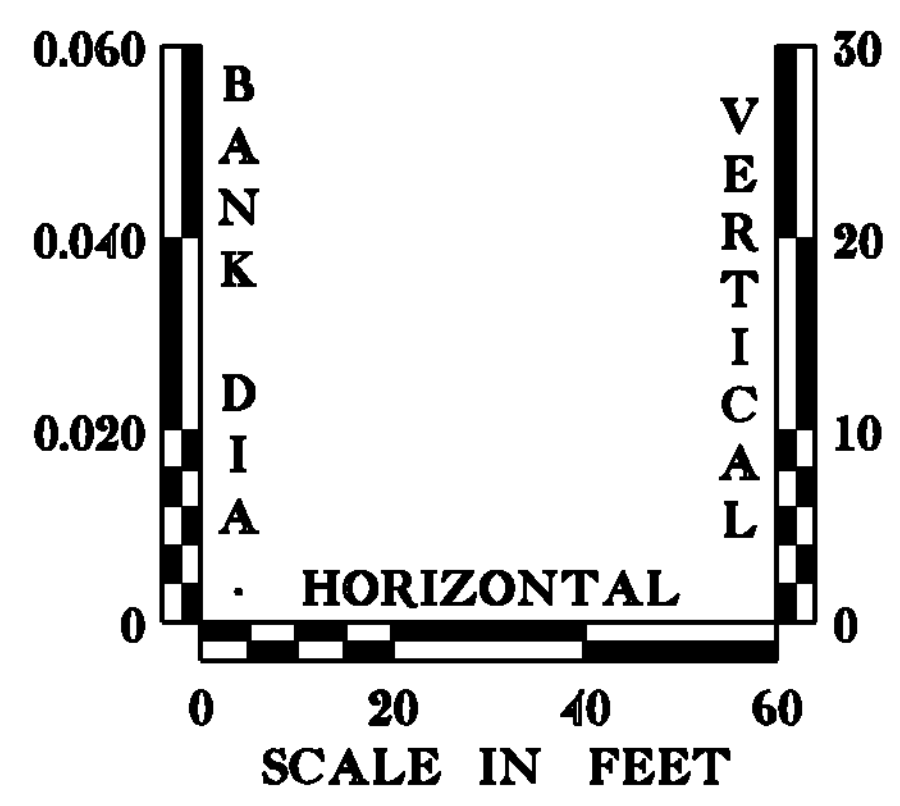

PROJECT NAME:	ESSEX TOWN	FILE NAME:	+97d002pro.dgn	PLOT DATE:	24-AUG-2012
PROJECT NUMBER:	STP 5400 (5)	PROJECT LEADER:	J. SCHULTZ	DRAWN BY:	D. LYMAN
		DESIGNED BY:	D. LYMAN	CHECKED BY:	J. DEVLIN
		VT ROUTE 117 - PROFILE SHEET 2		SHEET	23 OF 64

THE ELEVATIONS SHOWN TO THE NEAREST TENTH ARE THE OLD GROUND ALONG PROPOSED CENTERLINE.
 THE ELEVATIONS SHOWN TO THE NEAREST HUNDRETH ARE THE FINISHED GRADE ALONG THE PROPOSED CENTERLINE.