


**LEGEND**  
 — AER E&T — AERIAL ELECTRIC & TELEPHONE

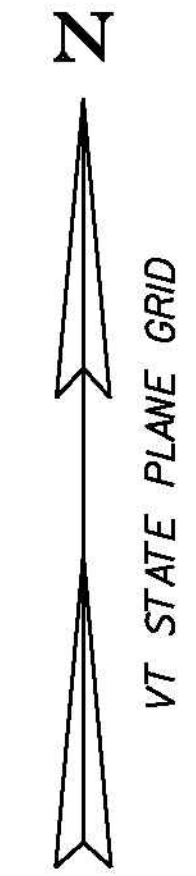

MATCH LINE STA 171+50

PROJECT NAME: ESSEX TOWN  
 PROJECT NUMBER: STP 5400 (5)  
 FILE NAME: +97d002ecexistingbdr.dgn  
 PROJECT LEADER: J. SCHULTZ  
 DESIGNED BY: D. LYMAN  
 EPSC EXISTING CONDITIONS SHEET 2

PLOT DATE: 24-AUG-2012  
 DRAWN BY: D. LYMAN  
 CHECKED BY: J. DEVLIN  
 SHEET 29 OF 64

