


**LEGEND**

- AER E&T — AERIAL ELECTRIC & TELEPHONE
- ▒ DISTURBED AREAS REQUIRING RE-VEGETATION
- △—○ LIMITS OF SOIL DISTURBANCE



MATCH LINE STA 171+50

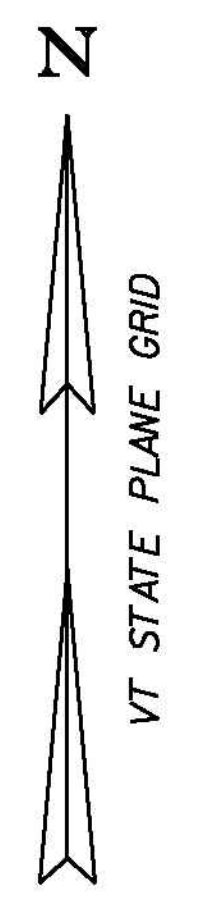

PROJECT NAME: ESSEX TOWN	
PROJECT NUMBER: STP 5400 (5)	
FILE NAME: +97d002ecf1nalbdr.dgn	PLOT DATE: 24-AUG-2012
PROJECT LEADER: J. SCHULTZ	DRAWN BY: D. LYMAN
DESIGNED BY: D. LYMAN	CHECKED BY: J. DEVLIN
EPSC FINAL CONDITIONS SHEET 2	SHEET 33 OF 64