








NOTES:

1. TRAFFIC CONTROL PHASE 2 CONSISTS OF WIDENING NORTHERLY OFF OF VT ROUTE 117, EXTENDING FROM THE EXISTING SHOULDER TO THE PROPOSED EDGE OF PAVEMENT. ALL DRAINAGE AND CHANNEL WORK TO BE COMPLETED BY THE END OF PHASE 2 AS WELL AS THE INSTALLATION OF CURB AND GUARDRAIL. REFER TO MUTCD FIGURE 6H-10. LANE CLOSURE ON TWO-LANE ROAD USING FLAGGERS (TYPICAL APPLICATION 10).
2. SEE SHEET 49 FOR ADDITIONAL NOTES.

LEGEND	
	FLAGGER
	CHANNELIZING DEVICE
	PHASE II CONSTRUCTION ZONE
	PHASE II TRAFFIC

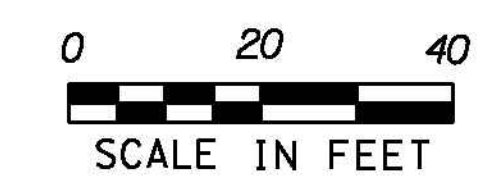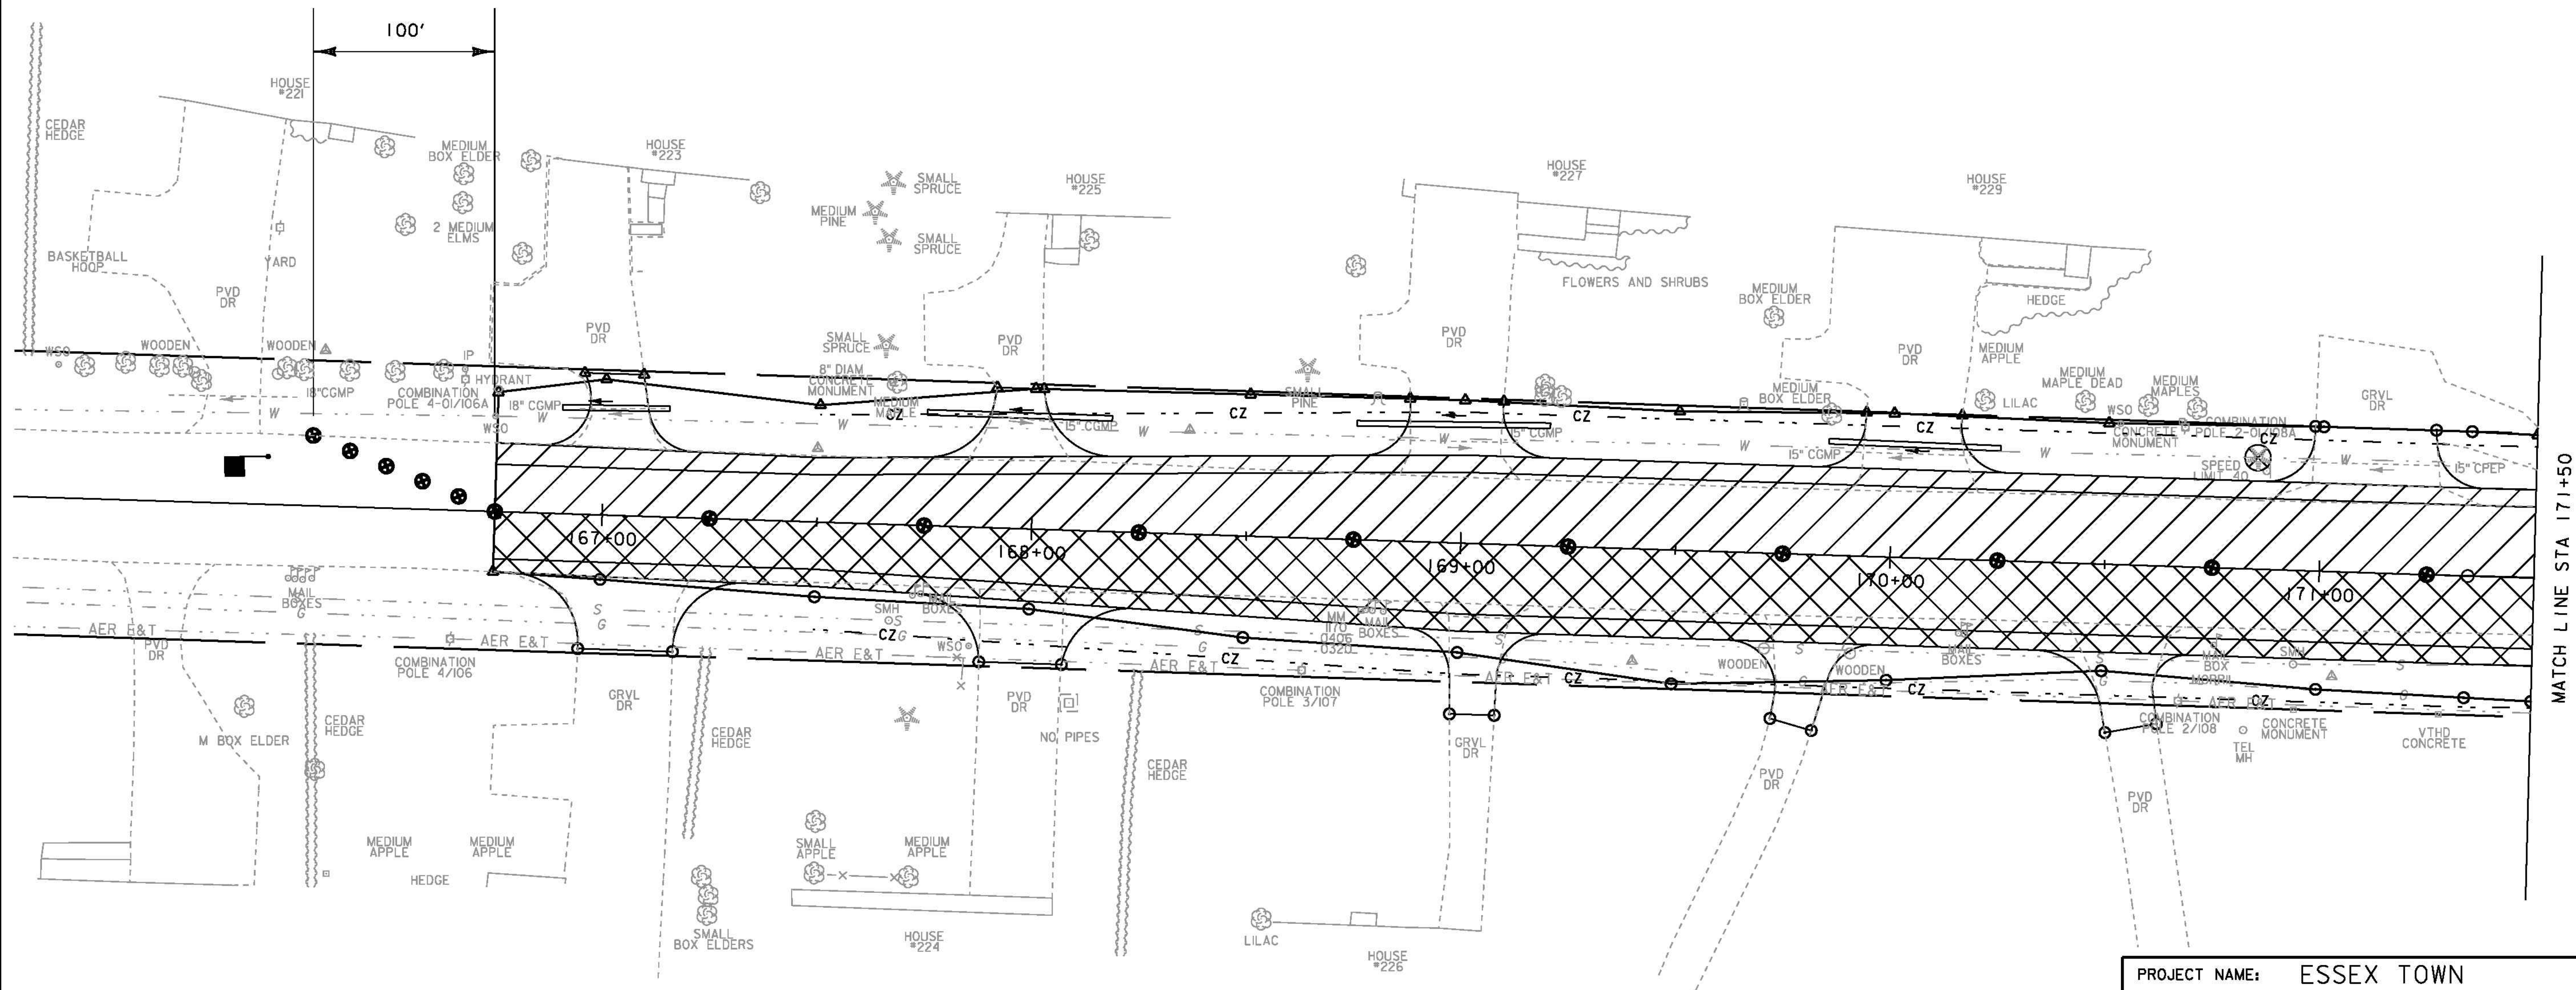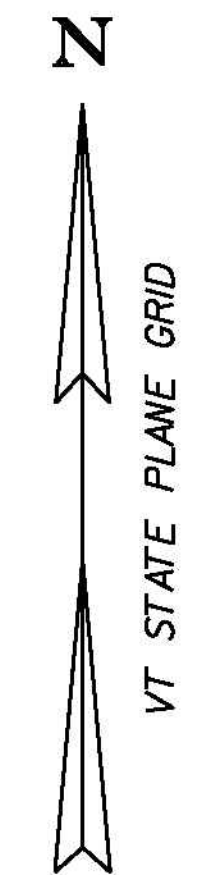

PROJECT NAME:	ESSEX TOWN	FILE NAME:	+97d002+cp2bdr.dgn	PLOT DATE:	24-AUG-2012
PROJECT NUMBER:	STP 5400 (5)	PROJECT LEADER:	J. SCHULTZ	DRAWN BY:	D. LYMAN
		DESIGNED BY:	D. LYMAN	CHECKED BY:	J. DEVLIN
		TC PHASE 2 LAYOUT SHEET 1		SHEET 51	OF 64