




175+00

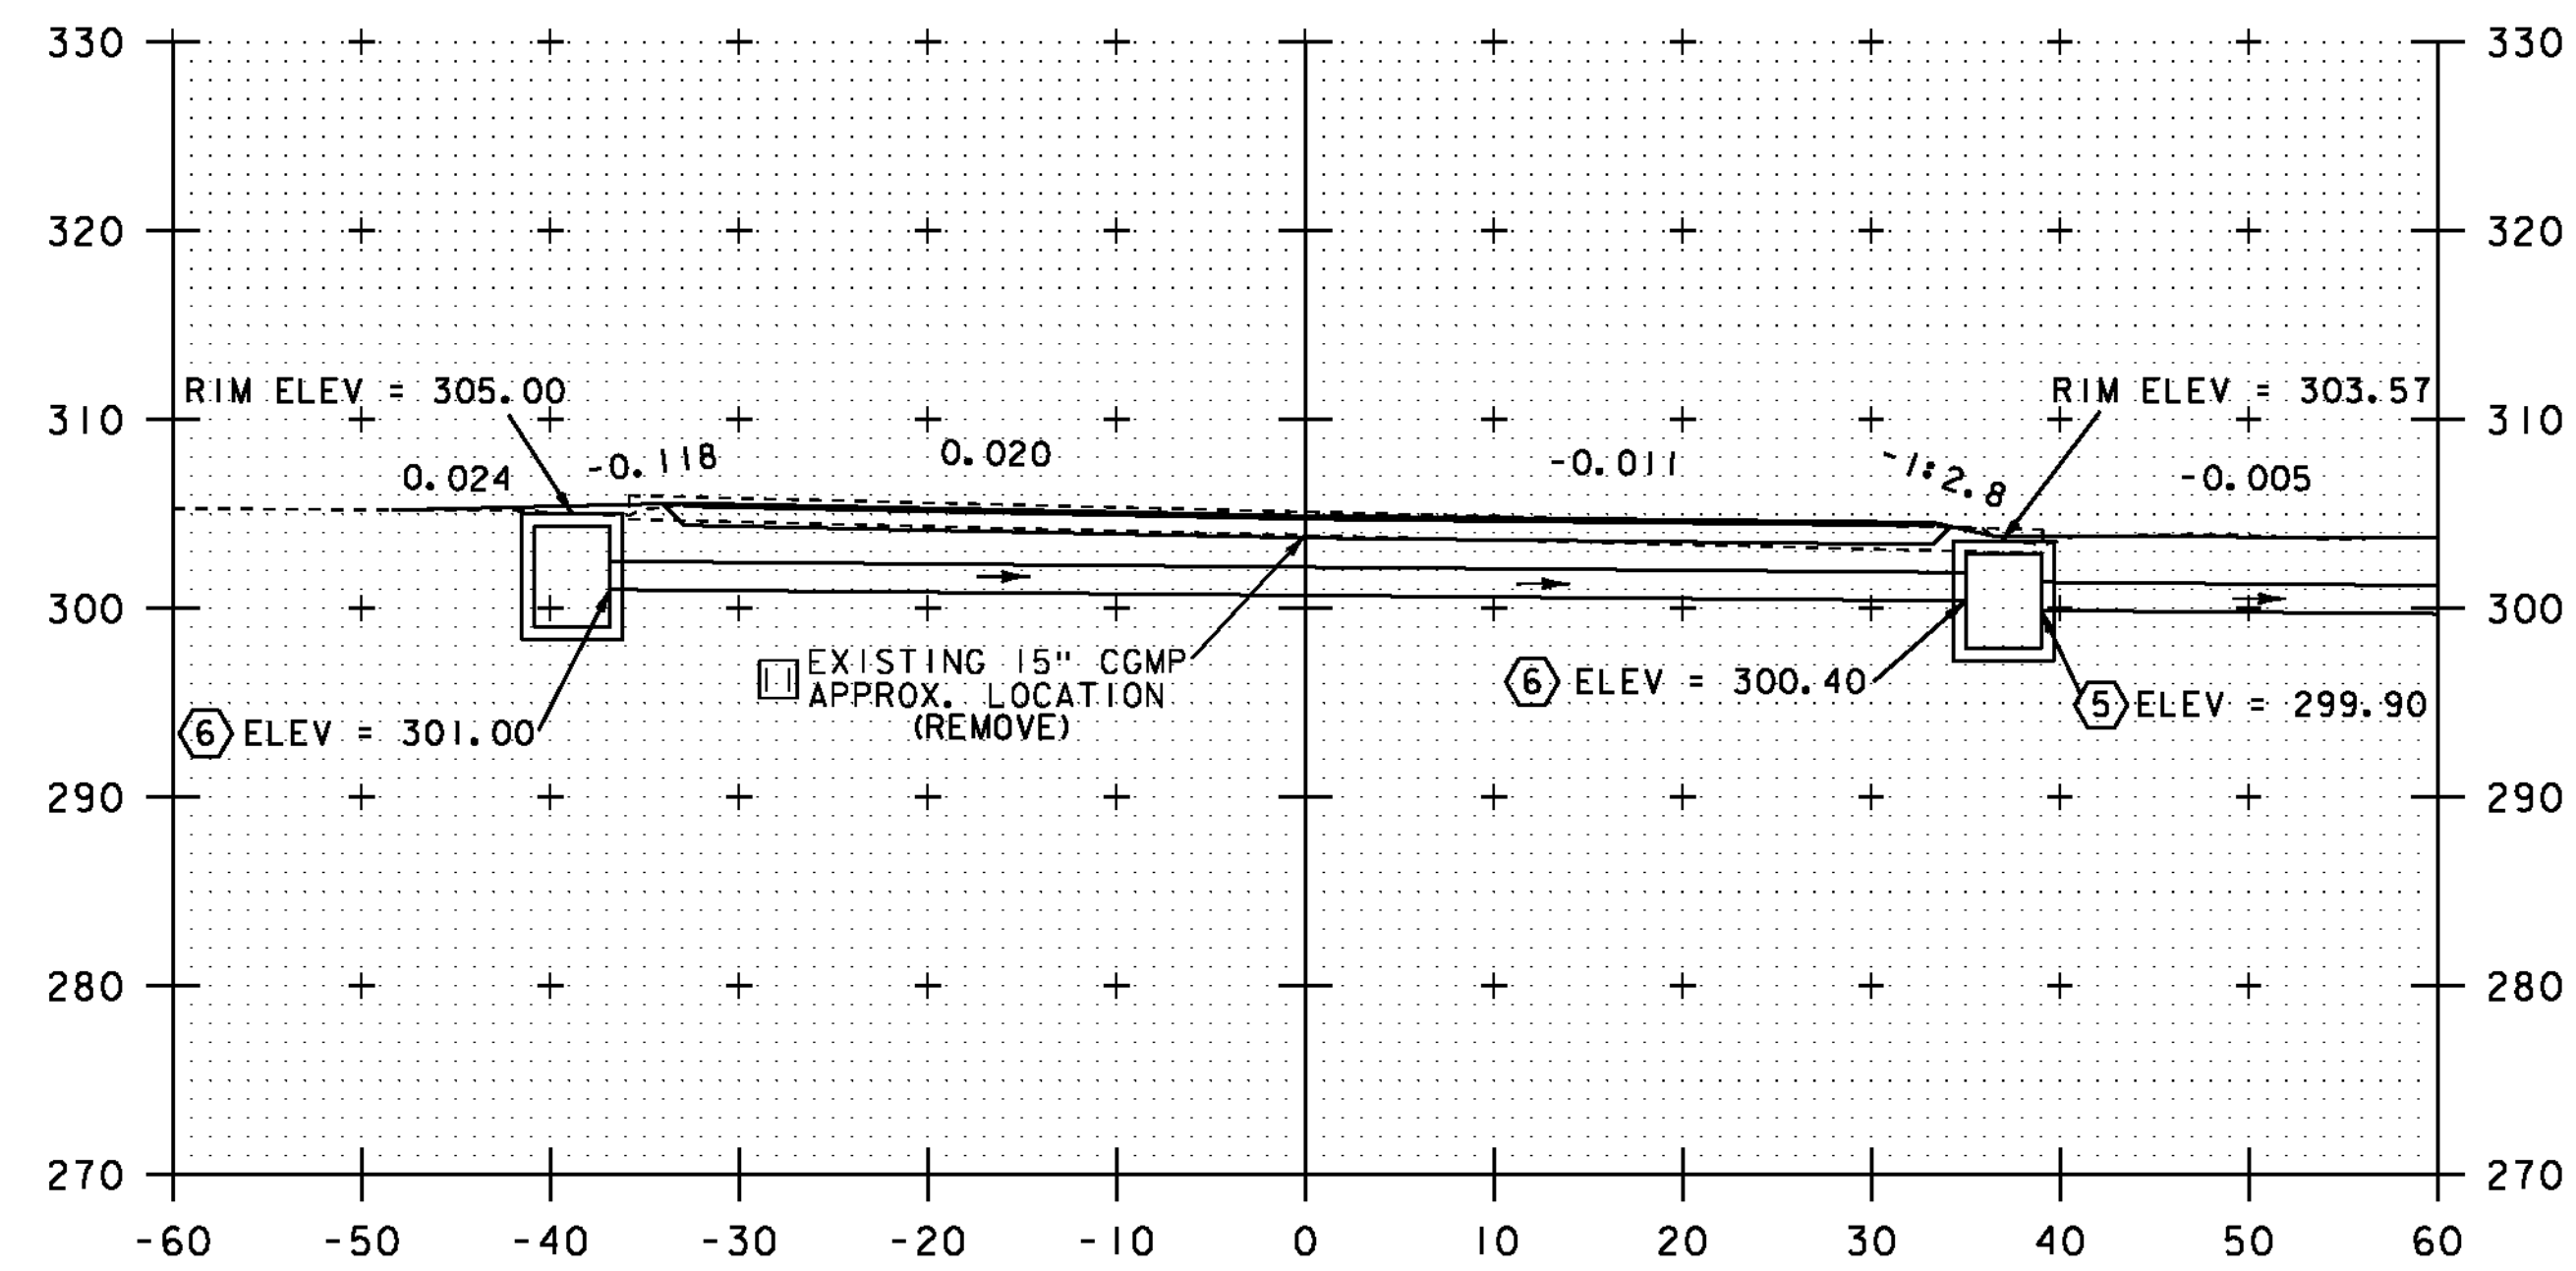


SECTION A-A

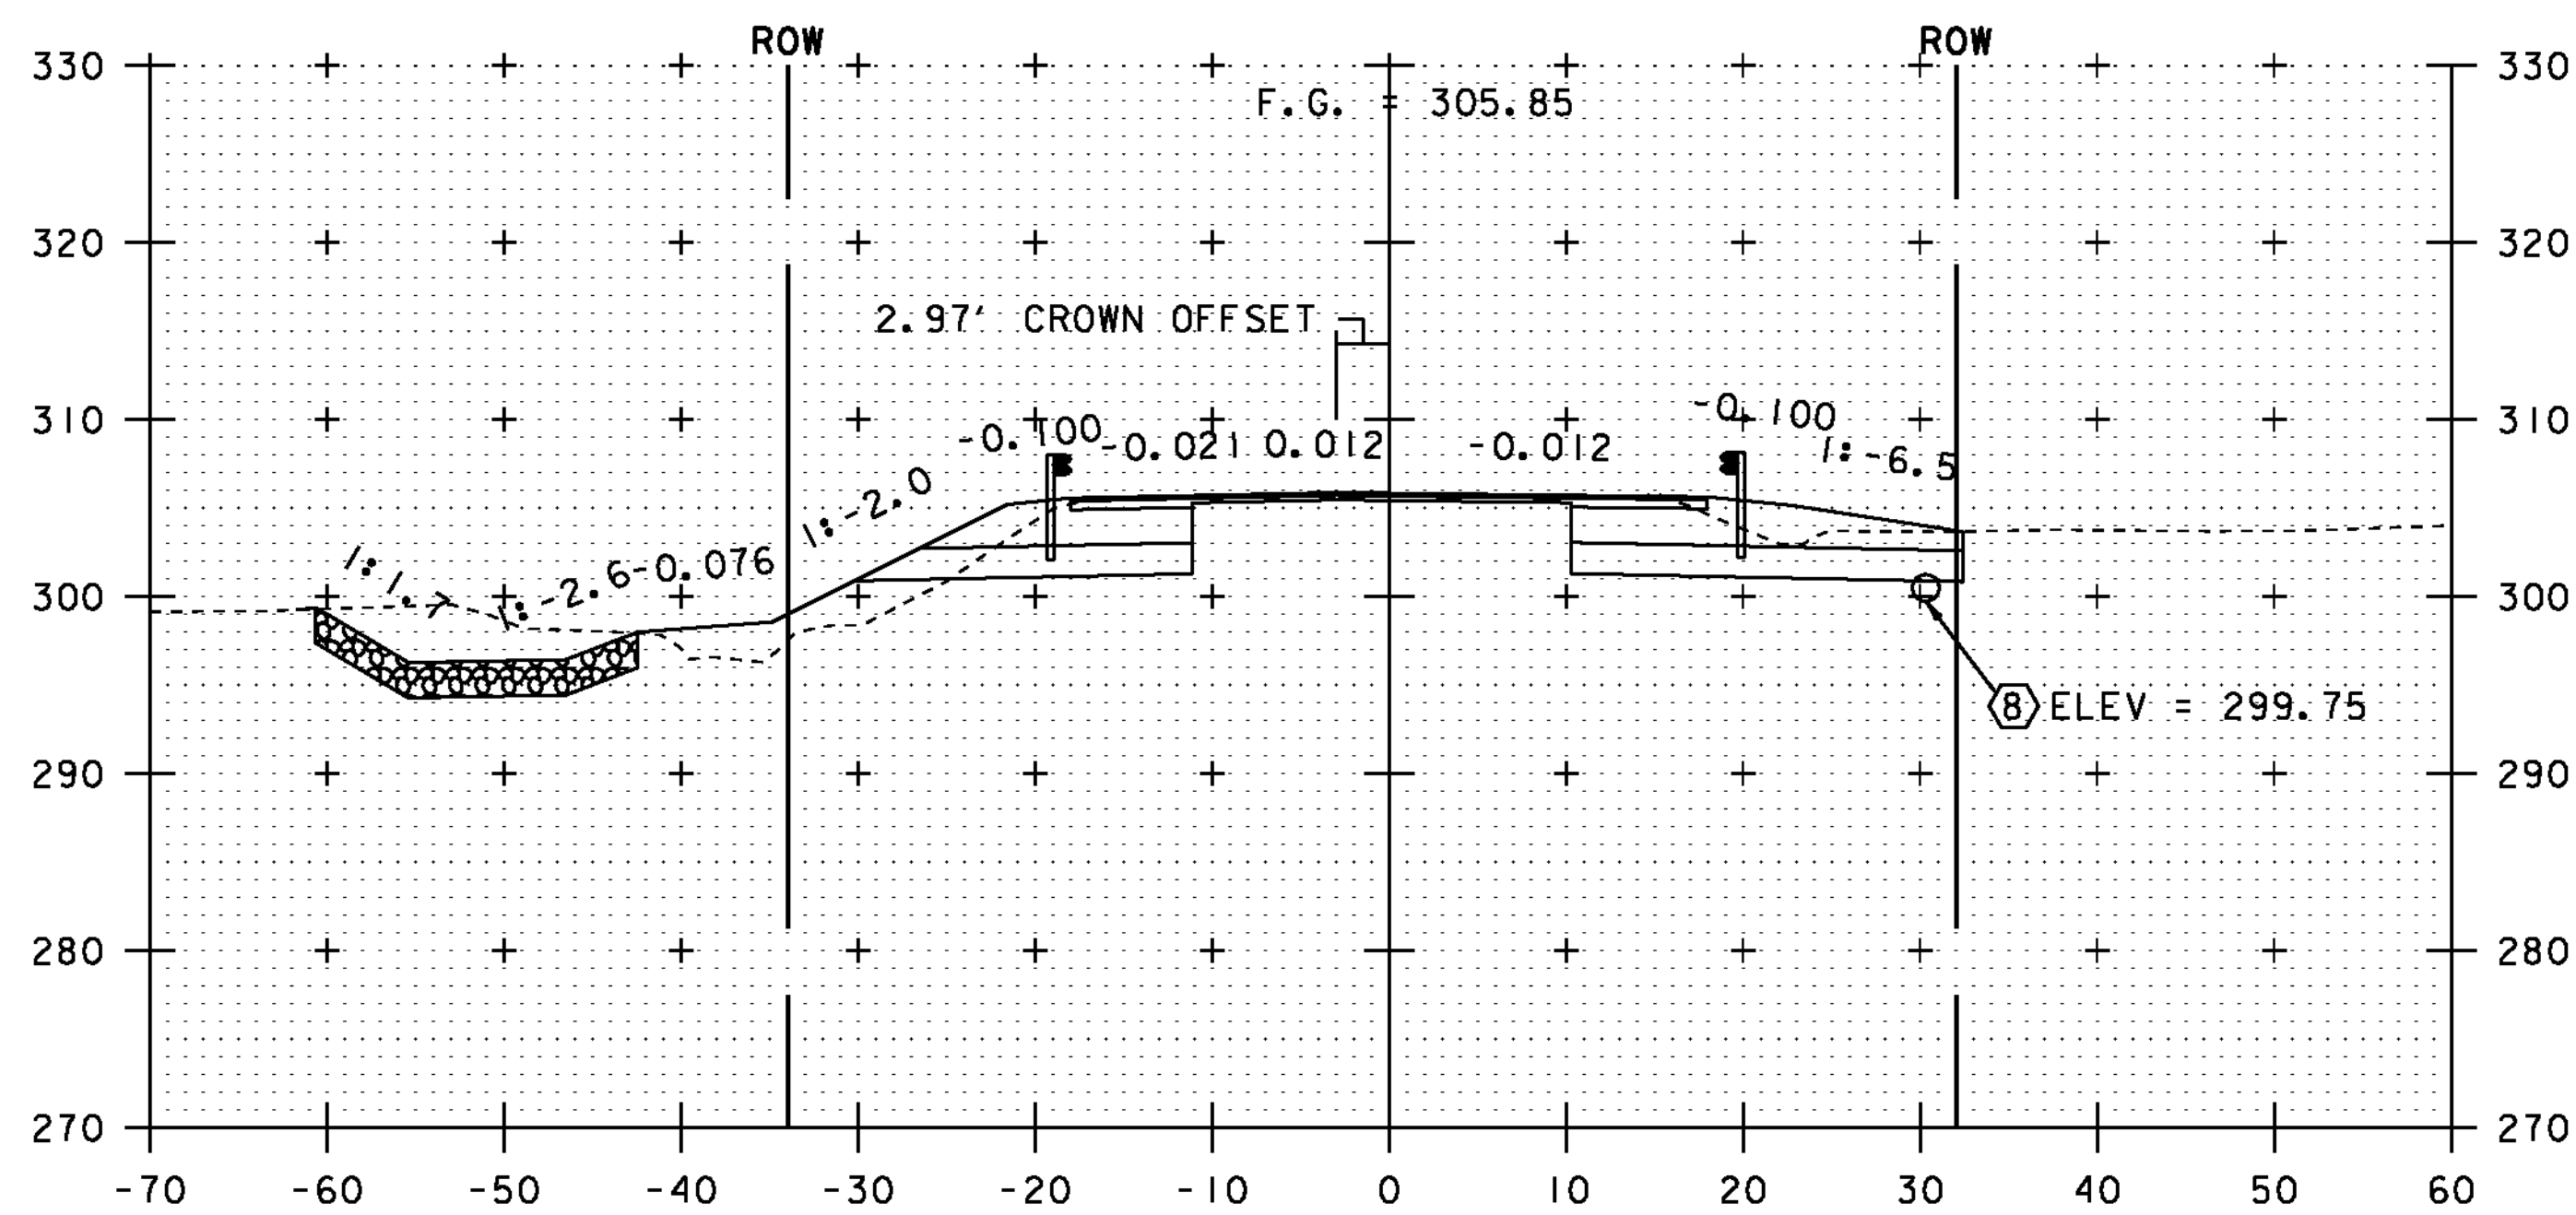

174+67

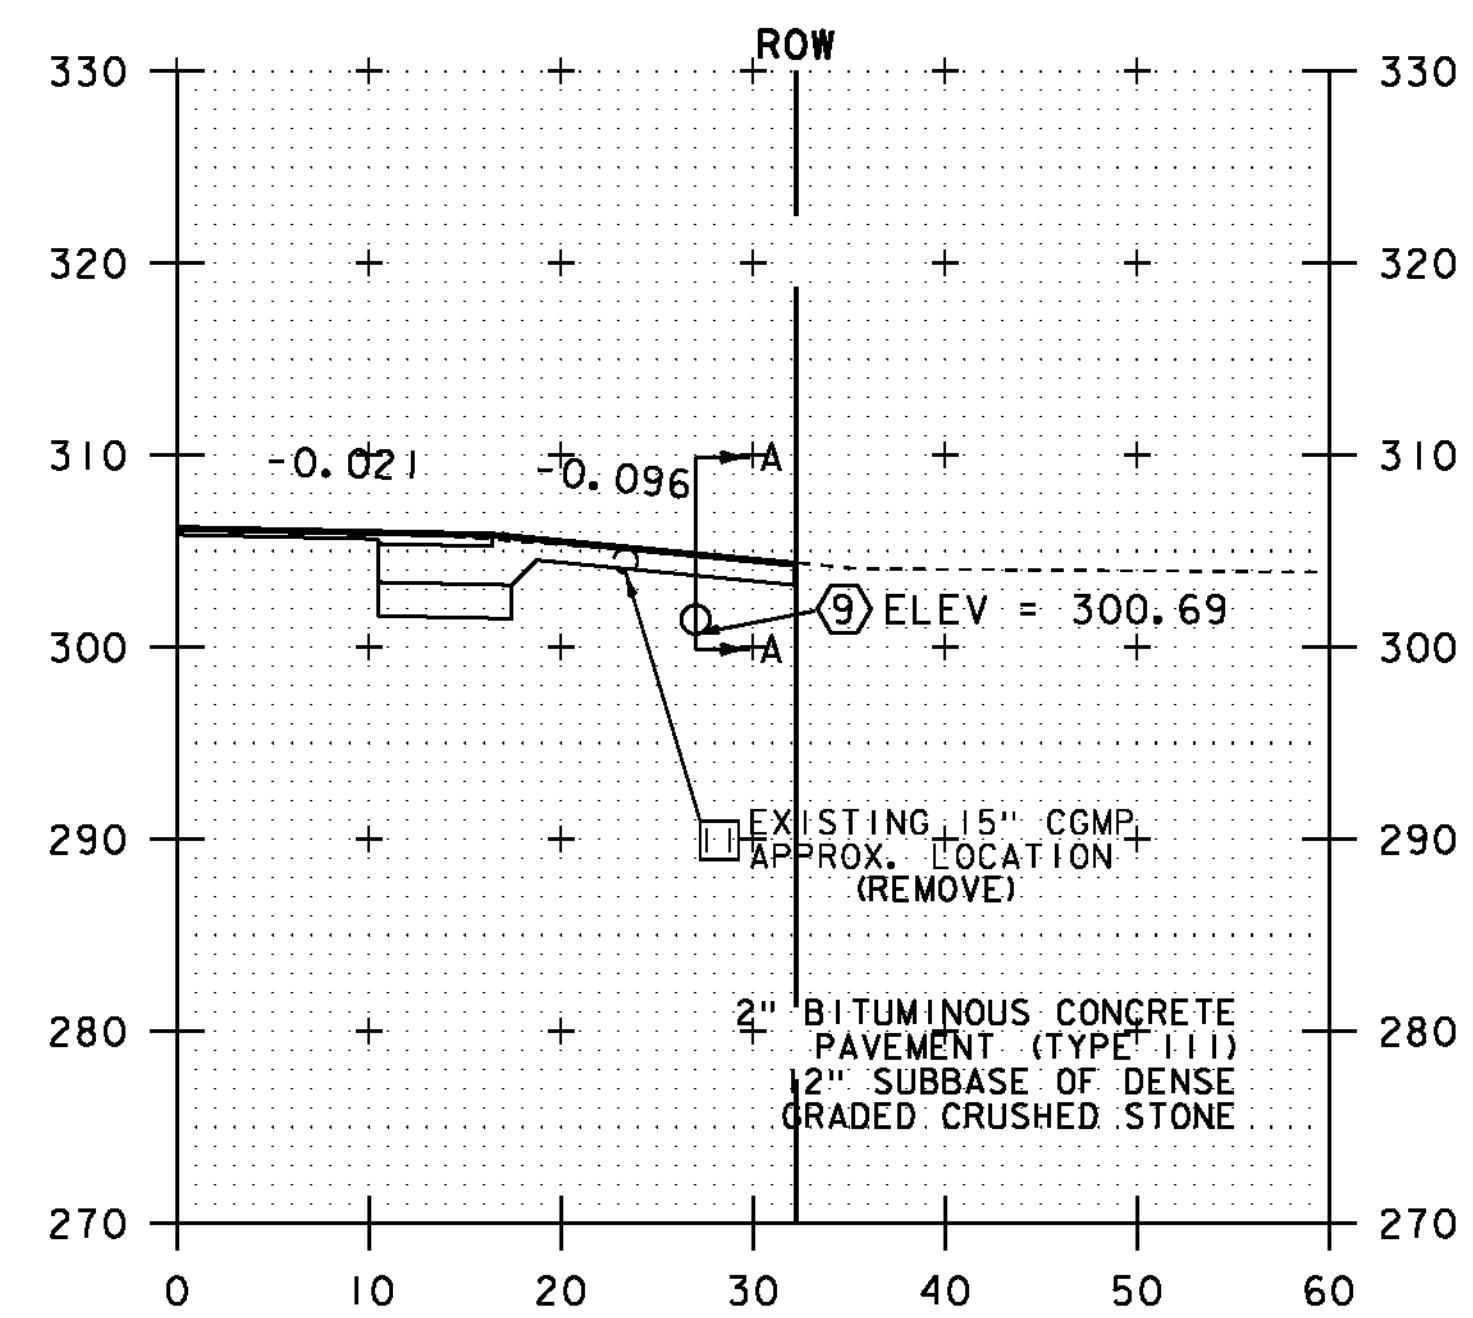

175+23
PAVED DRIVE RT

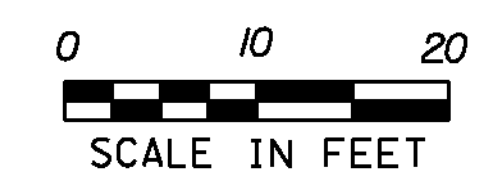

STA. 174+67 TO STA. 175+23

| | |
|------------------------------------|------------------------------|
| PROJECT NAME: ESSEX TOWN | PROJECT NUMBER: STP 5400 (5) |
| FILE NAME: +97d002xsl.dgn | DESIGNED BY: D. LYMAN |
| PROJECT LEADER: J. SCHULTZ | CHECKED BY: J. DEVLIN |
| DRAWN BY: D. LYMAN | PLOT DATE: 24-AUG-2012 |
| VT ROUTE 117 CROSS SECTION SHEET 9 | SHEET 63 OF 64 |