


THE CONTRACTOR SHALL NOTIFY "DIGSAFE" AT 1-888-DIG-SAFE PRIOR TO ANY EXCAVATION.

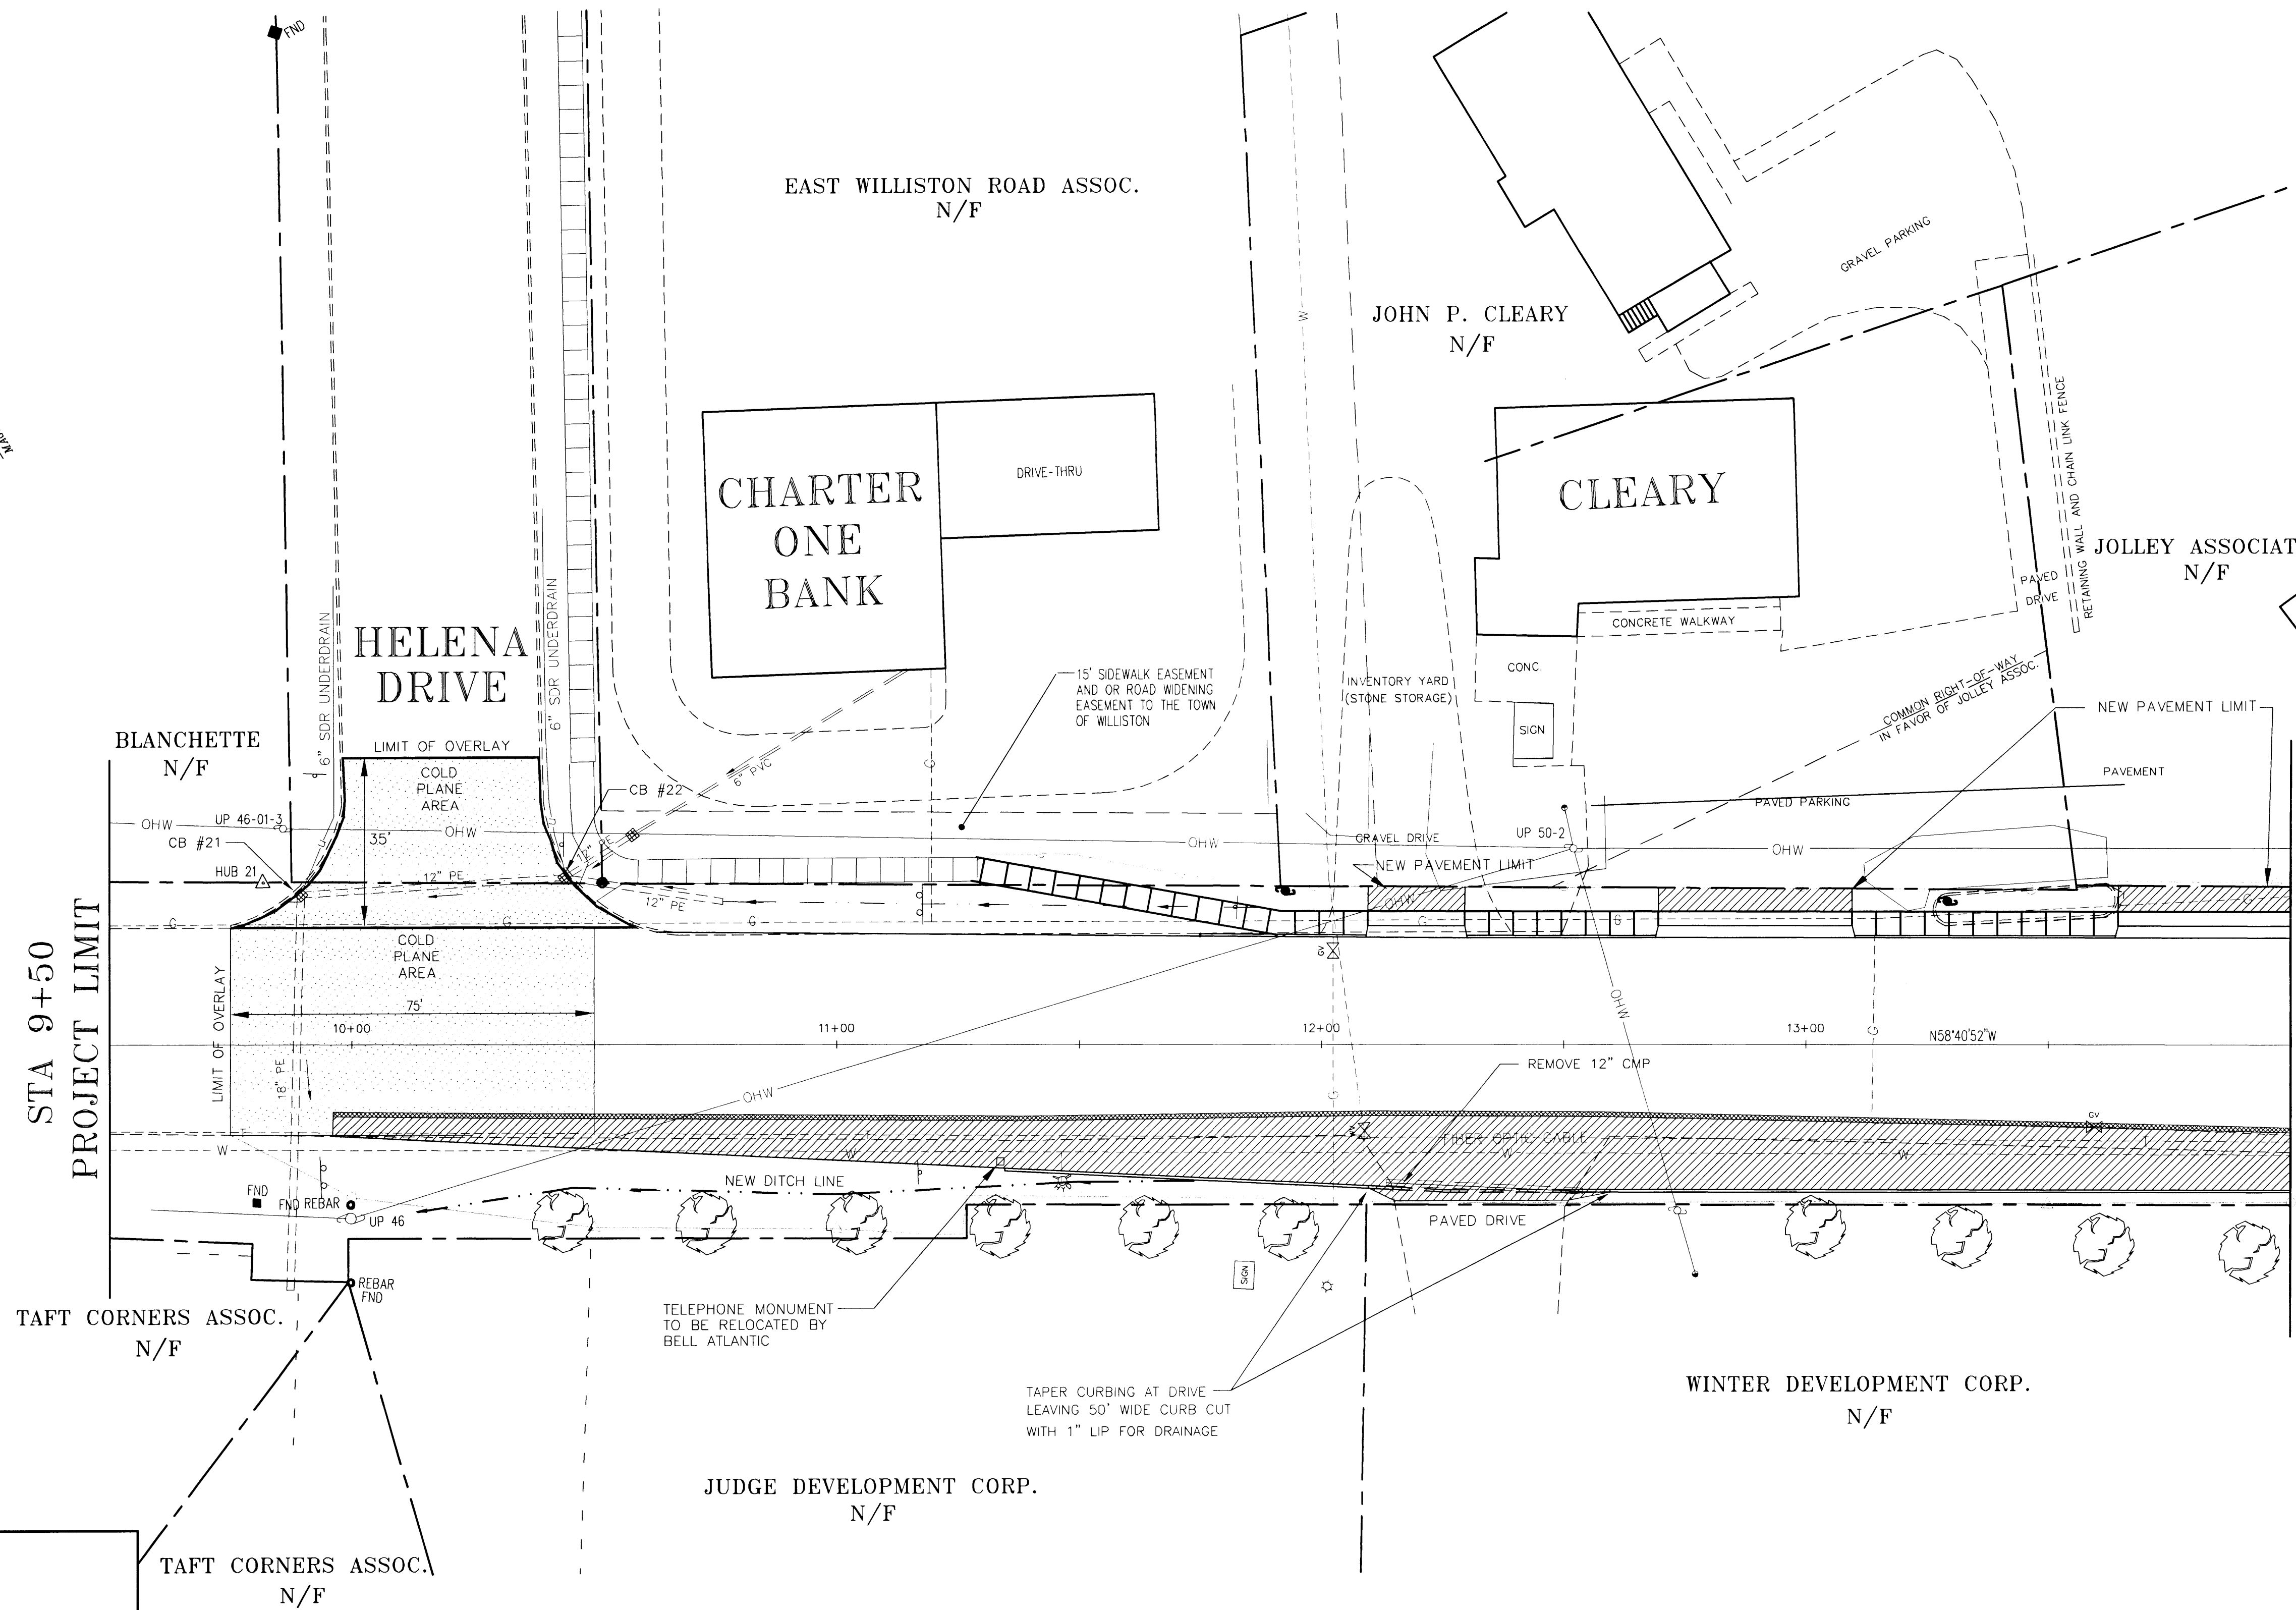

**CONSTRUCT DRIVES**  
 12+19 LT.  
 12+33 RT.  
 12+90 LT.  
 13+85 LT.

**PORTLAND CEMENT CONCRETE SIDEWALK (5" THICK)**  
 11+28 - 12+05 LT.  
 12+33 - 12+66 LT.  
 13+14 - 13+61 LT.

**PORTLAND CEMENT CONCRETE SIDEWALK (8" THICK)**  
 12+05 - 12+33 LT.  
 12+66 - 13+14 LT.  
 13+61 - 14+00 LT.

**CAST-IN-PLACE CEMENT CONCRETE CURB, TYPE B**  
 11+75 - 12+09 LT.  
 12+29 - 12+70 LT.  
 11+35 - 14+00 RT.  
 13+10 - 13+65 LT.

**REMOVAL OF EXISTING CURB**  
 13+26 - 13+64, 24' - 31' LT.

**ADJUST ELEVATION OF VALVE BOX**  
 12+02 LT.  
 12+09 RT.  
 13+60 RT.

**HYDRANT, RELOCATE**  
 11+47 RT.

**CHANGING ELEVATION OF D.I.'S, C.B.'S OR MANHOLES**  
 9+89 LT.  
 10+44 LT.


STA 9+50  
PROJECT LIMIT

MATCHLINE - SHEET 9  
STA 14+00

**LEGEND**

- — — — — PROPERTY LINE
- - - - - EASEMENT LINE
- - - - - SWALE LINE
- - - - - EXISTING EDGE OF PAVEMENT
- - - - - EXISTING CURBING
- - - - - LIMIT OF CUT
- - - - - LIMIT OF FILL
- — — — — GAS LINE W/ GATE VALVE
- — — — — WATER LINE W/ HYDRANT & GATE VALVE
- — — — — SEWER LINE & MANHOLE
- — — — — BURIED TELEPHONE LINE
- — — — — STORM PIPE & CATCH BASIN
- — — — — UTILITY POLE & OVERHEAD WIRES
- ○ ○ ○ ○ TREES
- ☆ LIGHT POLE
- SIGN POST
- FND ■ CONCRETE MONUMENT FOUND
- IPF ● IRON PIPE FOUND

NOTE: STA. 10+00 - STA. 15+75 ROADWAY WIDENING MAY INVOLVE EXCAVATION AROUND EXISTING FIBER OPTIC CABLE AND/OR VT GAS MAIN. CONTRACTOR SHALL UTILIZE HAND DIGGING AND PROTECTION IF DEEMED NECESSARY BY RESIDENT ENGINEER & THE BELL ATLANTIC / VT GAS FOREMAN.

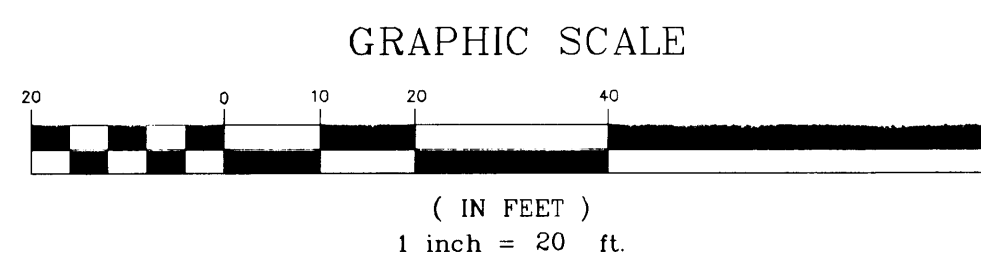

**RECORD DRAWINGS**  
 THIS RECORD DRAWING HAS BEEN PREPARED BY GRIFFIN INTERNATIONAL, INC. BASED ON BASE PLAN DESIGN DRAWINGS PROVIDED BY LAMOUREUX & DICKINSON, INC. CHANGES MADE TO THE DESIGN PLANS ARE INDICATED. THE INFORMATION PROVIDED REGARDING ANY DEVIATION FROM THE DESIGN PLANS ARE BASED ON RESIDENT ENGINEER NOTES AND MEASUREMENT OF ABOVEGROUND FEATURES.

**CONTRACT PLANS**

<b>VERMONT AGENCY OF TRANSPORTATION</b>	
<b>WILLISTON NHG 5500 (10)S "TAFT CORNERS"</b>	
(US ROUTE 2 & VT ROUTE 2A)	
WILLISTON	VERMONT
<b>HORIZONTAL LAYOUT &amp; CONSTRUCTION PLANS</b>	
<b>LAMOUREUX &amp; DICKINSON Consulting Engineers Inc.</b>	
14 Morse Drive Essex Junction, VT 05452 (802) 878-4450	
<b>Engineers-Planners-Surveyors</b>	
design RJD drawn JLC checked RJD	scale 1"=20' sh. no. <b>8</b>