

THE CONTRACTOR SHALL NOTIFY "DIGSAFE" AT 1-888-DIG-SAFE PRIOR TO ANY EXCAVATION.

NOTE: STA 19+15 - 19+90 COLD PLANE AREA MAY BE DELETED AT THE DISCRETION OF THE ENGINEER IF ROUTE 2 RECONSTRUCTION BY MAPLE TREE PLACE IS PLANNED DURING THE SAME CONSTRUCTION SEASON.


PORTLAND CEMENT CONCRETE SIDEWALK (6" THICK)
18+50 - 19+08 LT.

CAST-IN-PLACE CEMENT CONCRETE CURB, TYPE B
18+50 - 19+08 LT.

REMOVAL OF EXISTING CURB
18+50 - 19+08 LT.

SIDEWALK RAMP
19+05 LT.


CHANGING ELEVATION OF D.I.'S, C.B.'S, OR MANHOLES
19+20 LT. CB#23

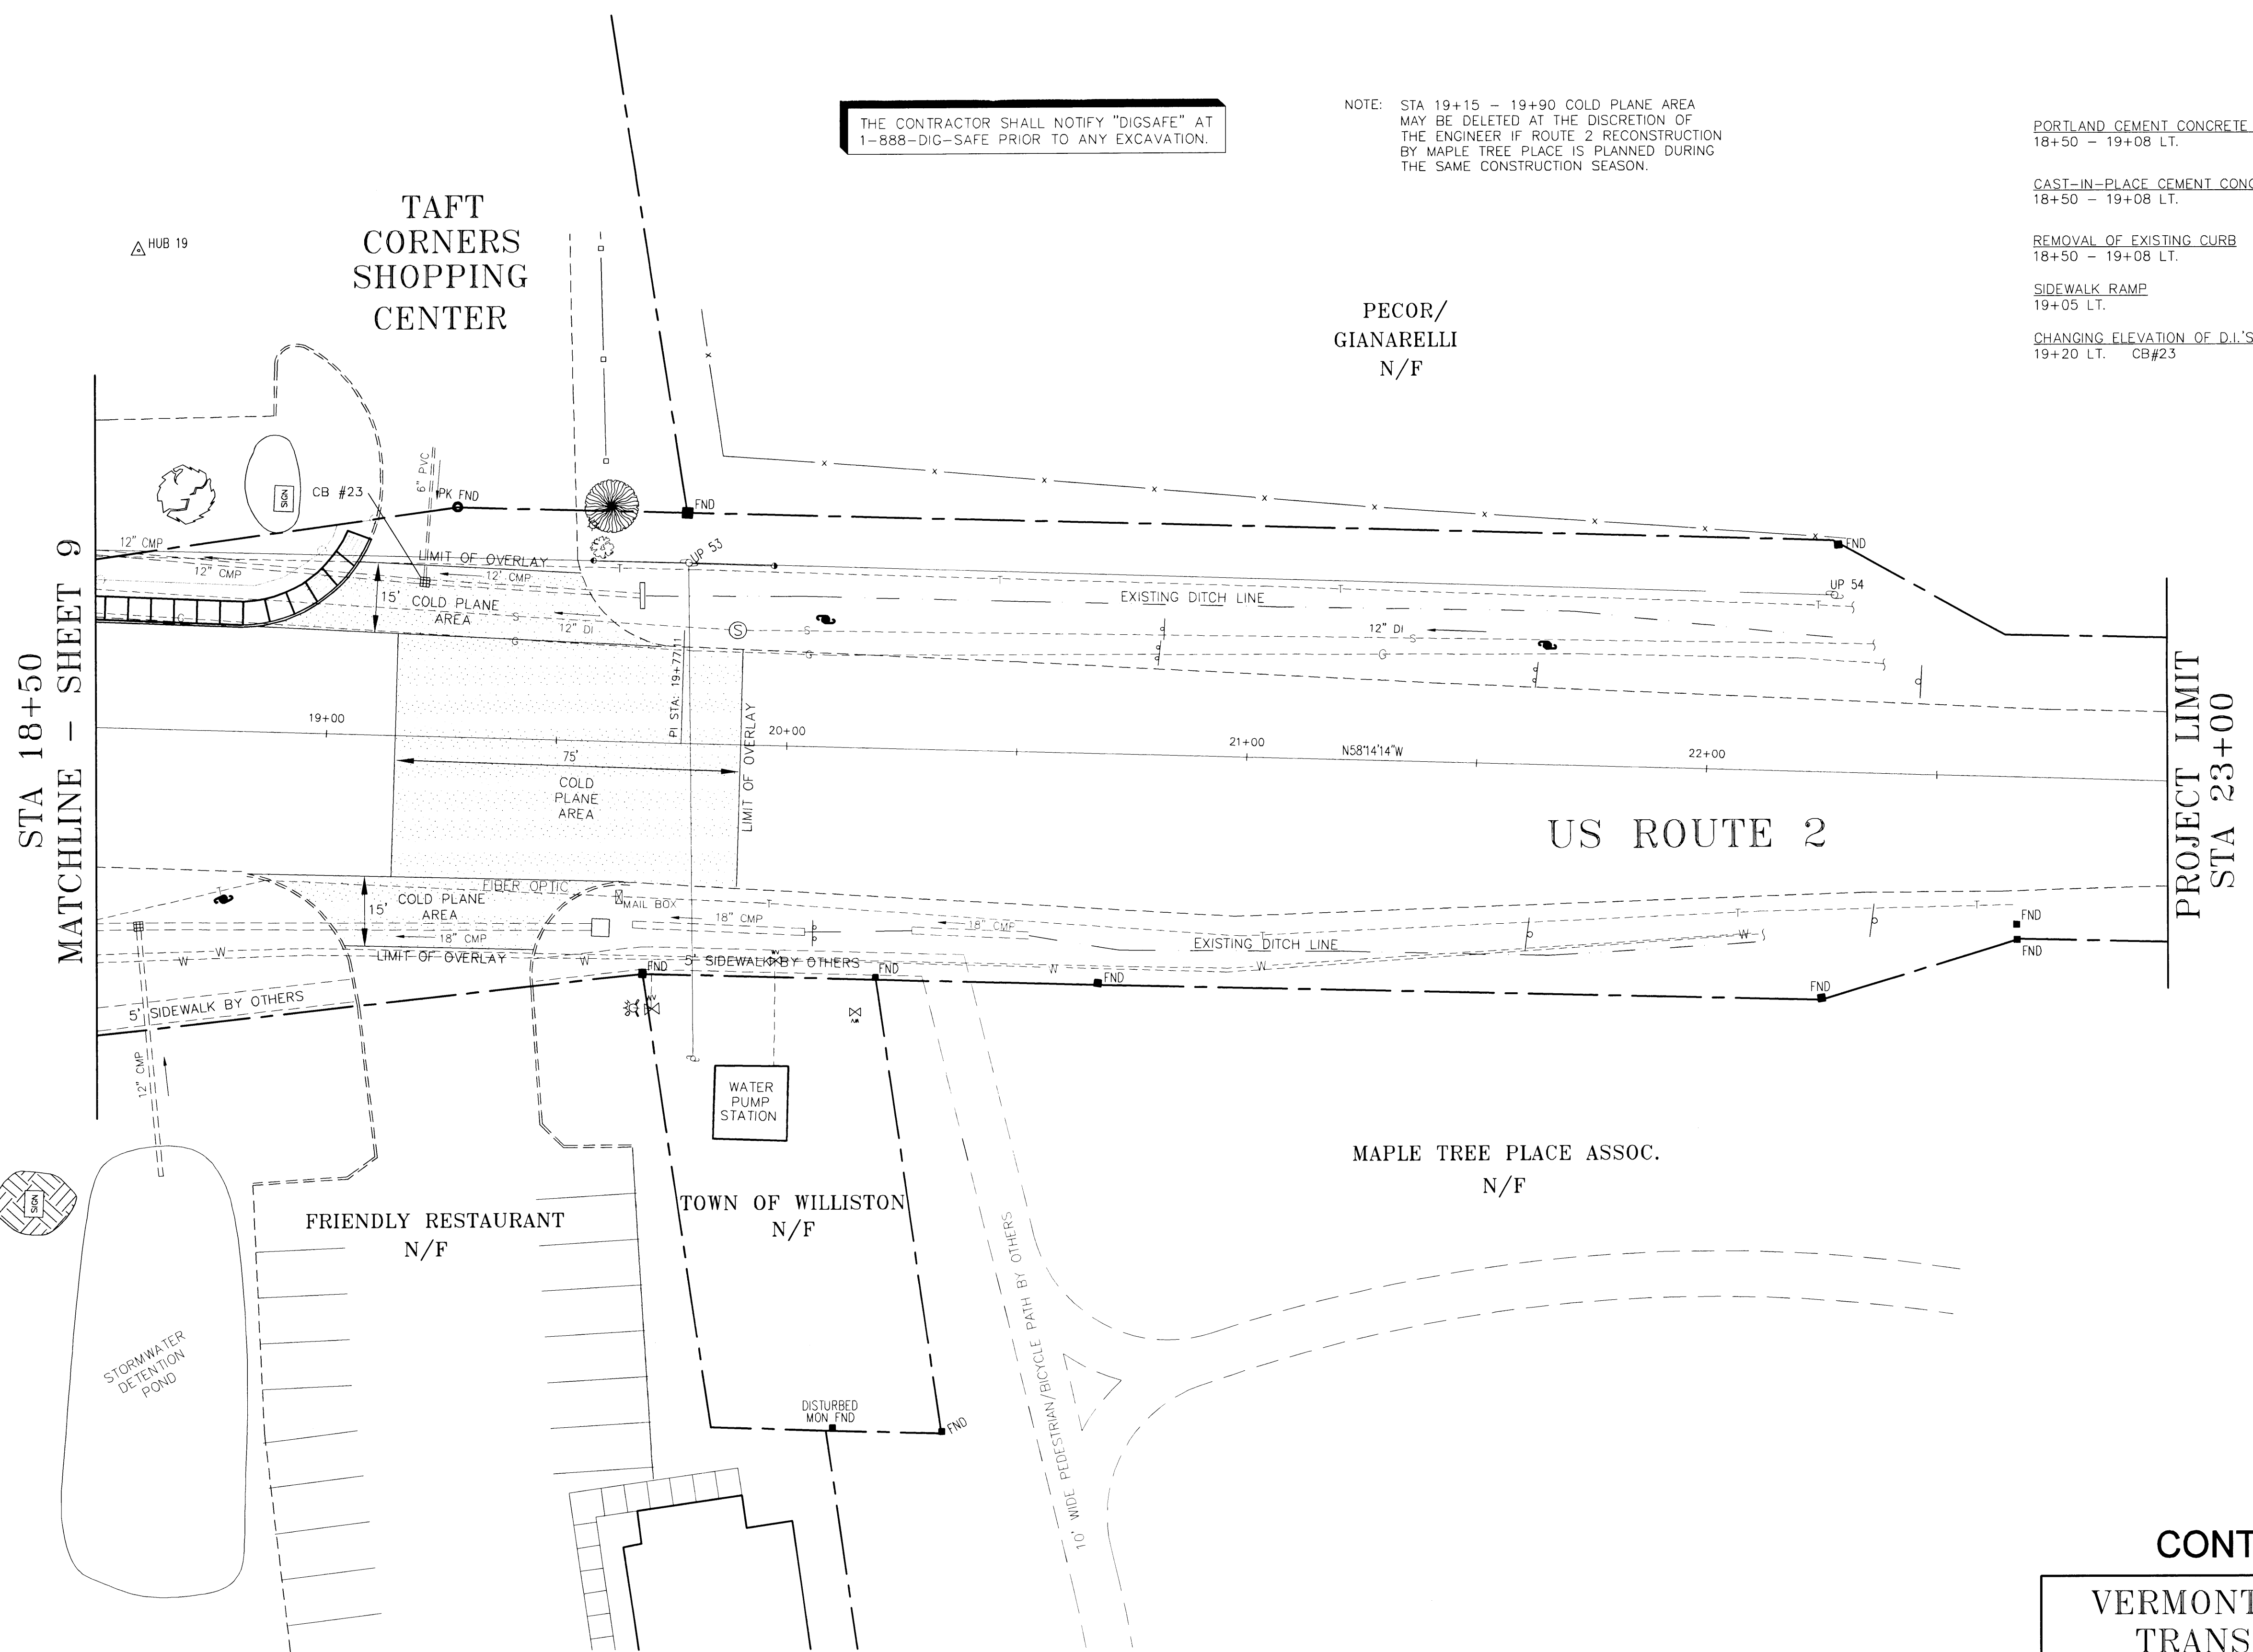

STA 18+50
MATCHLINE - SHEET 9

PROJECT LIMIT
STA 23+00

LEGEND	
	PROPERTY LINE
	EASEMENT LINE
	SWALE LINE
	EXISTING EDGE OF PAVEMENT
	EXISTING CURBING
	LIMIT OF CUT
	LIMIT OF FILL
	GAS LINE W/ GATE VALVE
	WATER LINE W/ HYDRANT & GATE VALVE
	SEWER LINE & MANHOLE
	BURIED TELEPHONE LINE
	STORM PIPE & CATCH BASIN
	UTILITY POLE & OVERHEAD WIRES
	TREES
	LIGHT POLE
	SIGN POST
	CONCRETE MONUMENT FOUND
	IRON PIPE FOUND

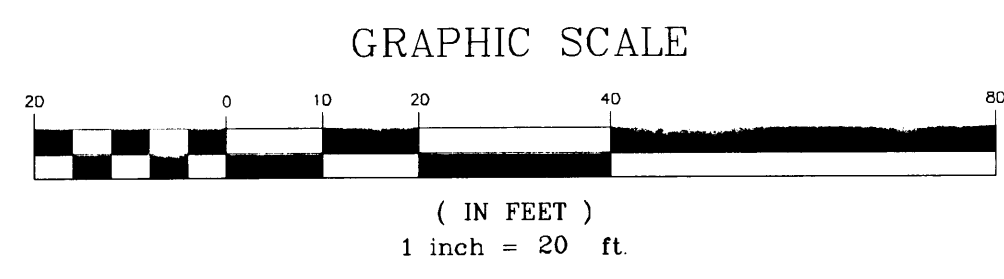

RECORD DRAWINGS
THIS RECORD DRAWING HAS BEEN PREPARED BY GRIFFIN INTERNATIONAL, INC. BASED ON BASE PLAN DESIGN DRAWINGS PROVIDED BY LAMOUREUX & DICKINSON, INC. CHANGES MADE TO THE DESIGN PLANS ARE INDICATED. THE INFORMATION PROVIDED REGARDING ANY DEVIATION FROM THE DESIGN PLANS ARE BASED ON RESIDENT ENGINEER NOTES AND MEASUREMENT OF ABOVEGROUND FEATURES.

CONTRACT PLANS

VERMONT AGENCY OF
TRANSPORTATION

WILLISTON NHG 5500 (10)S
"TAFT CORNERS"
(US ROUTE 2 & VT ROUTE 2A)

WILLISTON VERMONT

HORIZONTAL LAYOUT & CONSTRUCTION PLANS	design
	RJD
	drawn
	JLC
checked	
RJD	
scale	
1" = 20'	
sht. no.	
10	

LAMOUREUX & DICKINSON
Consulting Engineers Inc.
14 Morse Drive
Essex Junction, VT 05452
(802) 878-4450
Engineers-Planners-Surveyors

DATE PLOTTED: 08/14/2018 10:54:11 AM FILE: C:\PROJECTS\2018\NHG 5500 (10)S\TAFT CORNERS\TAFT CORNERS.dwg PLOTTER: HP DesignJet 5000