
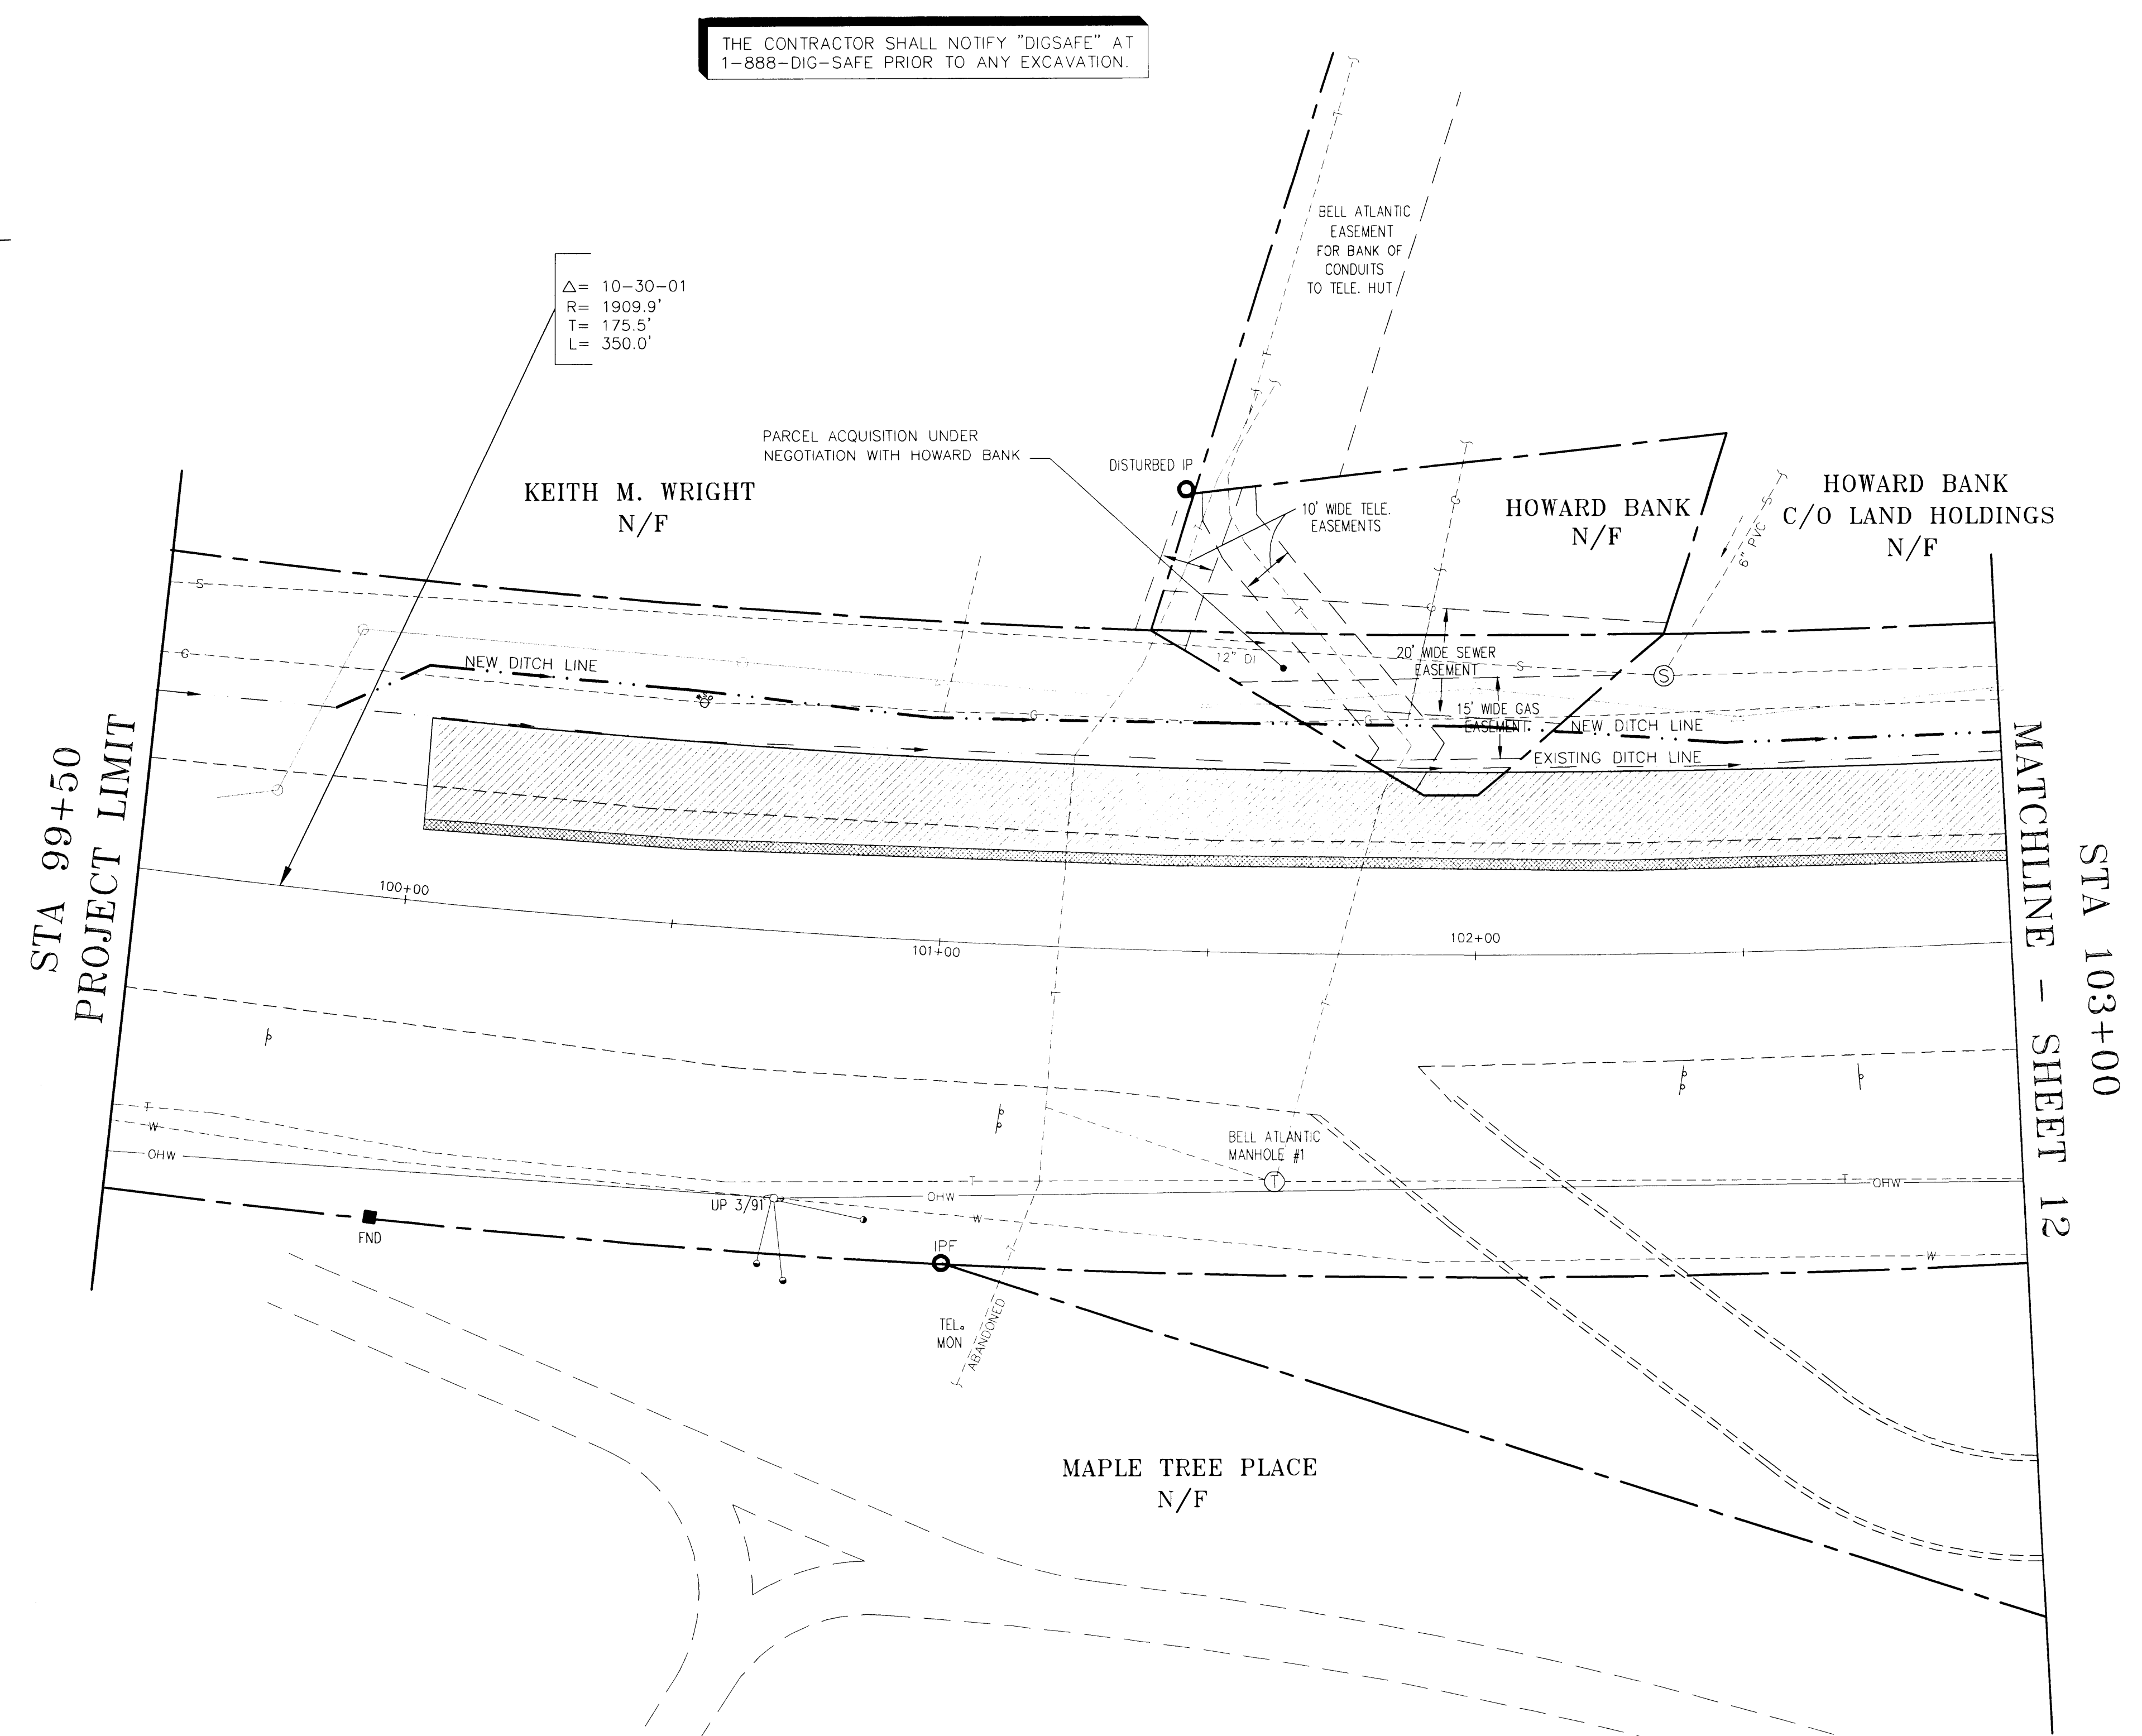


THE CONTRACTOR SHALL NOTIFY "DIGSAFE" AT 1-888-DIG-SAFE PRIOR TO ANY EXCAVATION.

NOTE:
ALL WORK SOUTH OF STA. 102+50 MAY BE DELETED FROM THE CONTRACT AT THE TIME OF CONTRACT AWARD IF THE NEEDED RIGHT-OF-WAY REQUIRED FROM THE HOWARD BANK HAS NOT YET BEEN OBTAINED.

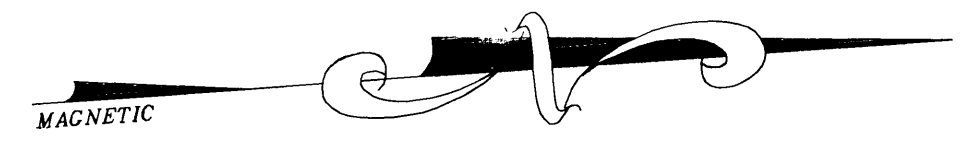

$\Delta = 10-30-01$
 $R = 1909.9'$
 $T = 175.5'$
 $L = 350.0'$

PARCEL ACQUISITION UNDER NEGOTIATION WITH HOWARD BANK

BELL ATLANTIC EASEMENT FOR BANK OF CONDUITS TO TELE. HUT

HOWARD BANK C/O LAND HOLDINGS N/F

STA 99+50 PROJECT LIMIT


MATCHLINE - SHEET 12 STA 103+00

MAPLE TREE PLACE N/F

LEGEND

- — — — — PROPERTY LINE
- - - - - EASEMENT LINE
- - - - - SWALE LINE
- - - - - EXISTING EDGE OF PAVEMENT
- ===== EXISTING CURBING
- - - - - LIMIT OF CUT
- - - - - LIMIT OF FILL
- x--- GAS LINE W/ GATE VALVE
- #--- WATER LINE W/ HYDRANT & GATE VALVE
- S--- SEWER LINE & MANHOLE
- T--- BURIED TELEPHONE LINE
- ===== STORM PIPE & CATCH BASIN
- O--- OHW --- UTILITY POLE & OVERHEAD WIRES
- ☀ --- TREES
- ☆ --- LIGHT POLE
- ⊥ --- SIGN POST
- FND ■ --- CONCRETE MONUMENT FOUND
- IPF ● --- IRON PIPE FOUND

GRAPHIC SCALE

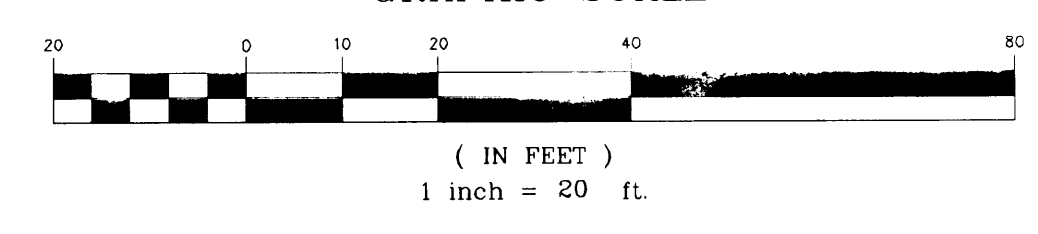

RECORD DRAWINGS

THIS RECORD DRAWING HAS BEEN PREPARED BY GRIFFIN INTERNATIONAL, INC. BASED ON BASE PLAN DESIGN DRAWINGS PROVIDED BY LAMOUREUX & DICKINSON, INC. CHANGES MADE TO THE DESIGN PLANS ARE INDICATED. THE INFORMATION PROVIDED REGARDING ANY DEVIATION FROM THE DESIGN PLANS ARE BASED ON RESIDENT ENGINEER NOTES AND MEASUREMENT OF ABOVEGROUND FEATURES.

CONTRACT PLANS

VERMONT AGENCY OF TRANSPORTATION
WILLISTON NHG 5500 (10)S
"TAFT CORNERS"
(US ROUTE 2 & VT ROUTE 2A)
WILLISTON VERMONT

HORIZONTAL LAYOUT & CONSTRUCTION PLANS

LAMOUREUX & DICKINSON Consulting Engineers Inc.
14 Morse Drive
Essex Junction, VT 05452
(802) 878-4450
Engineers-Planners-Surveyors

design	RJD
drawn	JLC
checked	RJD
scale	1" = 20'
sht. no.	11