

THE CONTRACTOR SHALL NOTIFY "DIGSAFE" AT 1-888-DIG-SAFE PRIOR TO ANY EXCAVATION.

$\Delta = 6-32-06$
 $R = 1909.9'$
 $T = 106.3'$
 $L = 212.29'$

HOWARD BANK
C/O LAND HOLDINGS
N/F

INTERSTATE
CORPORATE
CENTER


WINTER DEV. CORP.
N/F

PORTLAND CEMENT CONCRETE SIDEWALK (5" THICK)
105+12 - 107+00 RT.
BITUMINOUS CONCRETE SIDEWALK (10' WIDE)
104+88 - 107+00 LT.
CHANGING ELEVATION OF D.I.'S, C.B.'S, OR MANHOLES
106+92 LT. CB#19

STA 103+00
MATCHLINE - SHEET 11

MATCHLINE - SHEET 9
STA 107+00

LEGEND	
	PROPERTY LINE
	EASEMENT LINE
	SWALE LINE
	EXISTING EDGE OF PAVEMENT
	EXISTING CURBING
	LIMIT OF CUT
	LIMIT OF FILL
	GAS LINE W/ GATE VALVE
	WATER LINE W/ HYDRANT & GATE VALVE
	SEWER LINE & MANHOLE
	BURIED TELEPHONE LINE
	STORM PIPE & CATCH BASIN
	UTILITY POLE & OVERHEAD WIRES
	TREES
	LIGHT POLE
	SIGN POST
	CONCRETE MONUMENT FOUND
	IRON PIPE FOUND

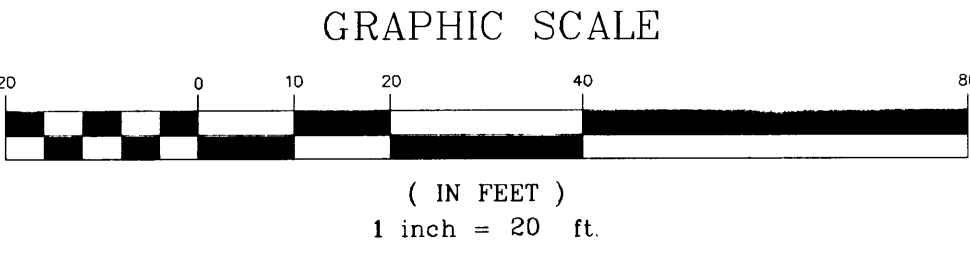

RECORD DRAWINGS
THIS RECORD DRAWING HAS BEEN PREPARED BY GRIFFIN INTERNATIONAL, INC. BASED ON BASE PLAN DESIGN DRAWINGS PROVIDED BY LAMOUREUX & DICKINSON, INC. CHANGES MADE TO THE DESIGN PLANS ARE INDICATED. THE INFORMATION PROVIDED REGARDING ANY DEVIATION FROM THE DESIGN PLANS ARE BASED ON RESIDENT ENGINEER NOTES AND MEASUREMENT OF ABOVEGROUND FEATURES.

CONTRACT PLANS

VERMONT AGENCY OF
TRANSPORTATION

WILLISTON NHG 5500 (10)S
"TAFT CORNERS"
(US ROUTE 2 & VT ROUTE 2A)

WILLISTON VERMONT

design	RJD
drawn	JLC
checked	RJD
scale	1"=20'
sht. no.	12

LAMOUREUX & DICKINSON
Consulting Engineers Inc.
14 Morse Drive
Essex Junction, VT 05452
(802) 878-4450
Engineers-Planners-Surveyors

