




STA: 12+50

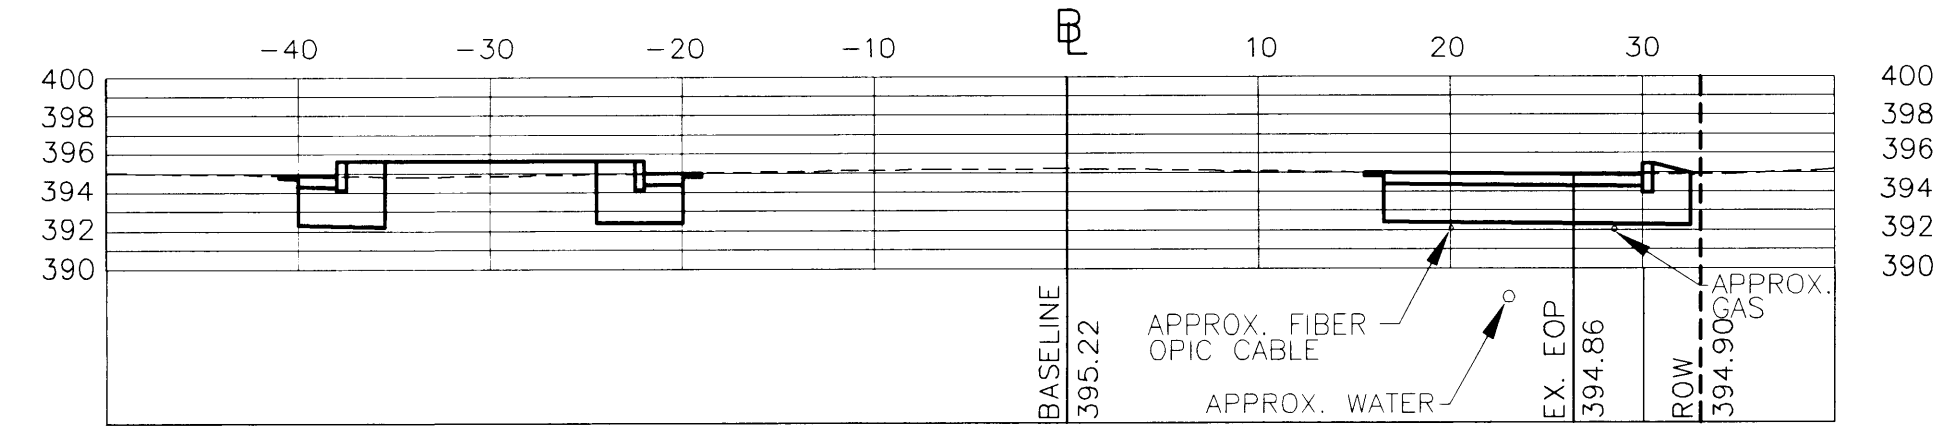


STA: 15+50

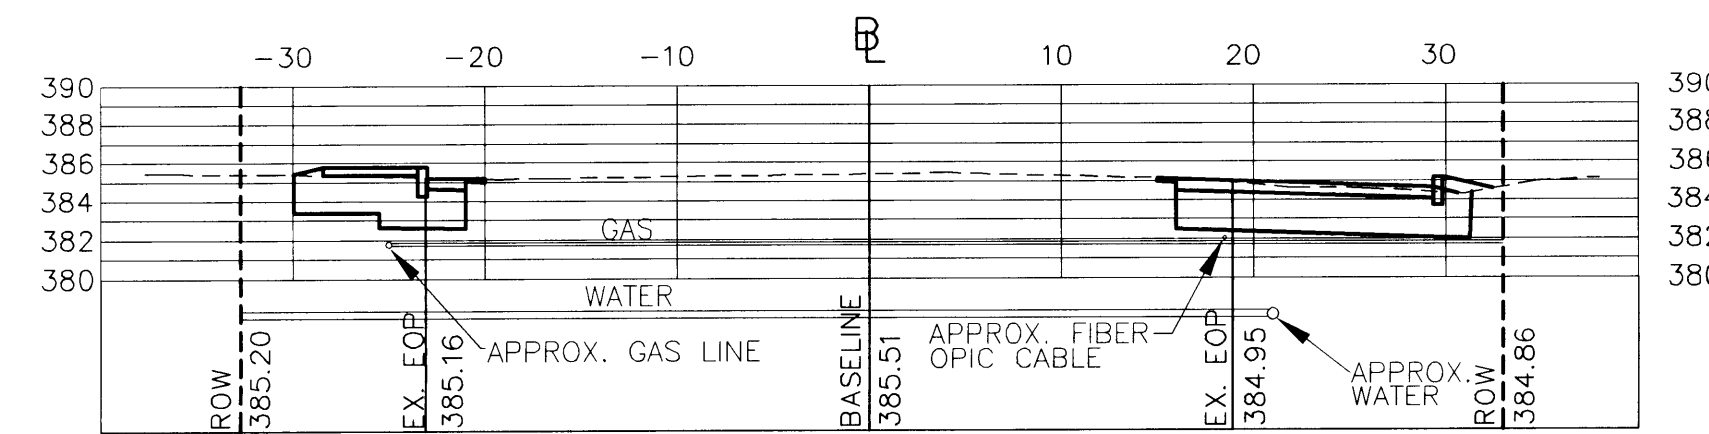


STA: 12+00

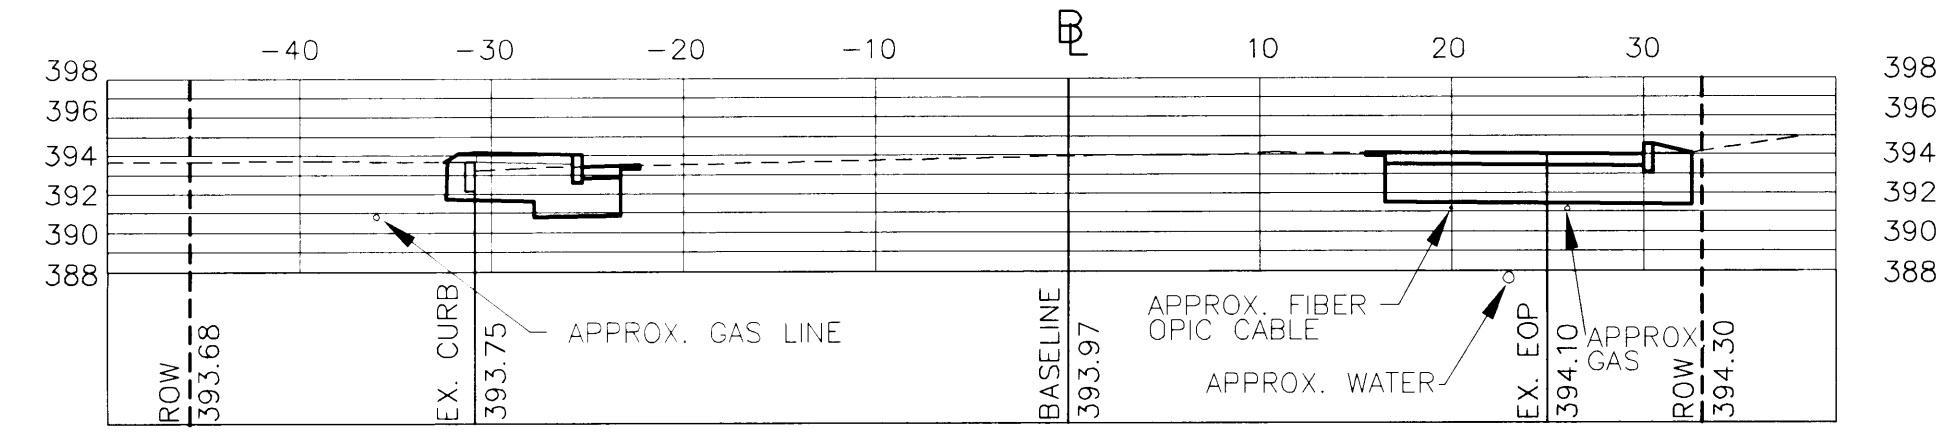


STA: 15+00

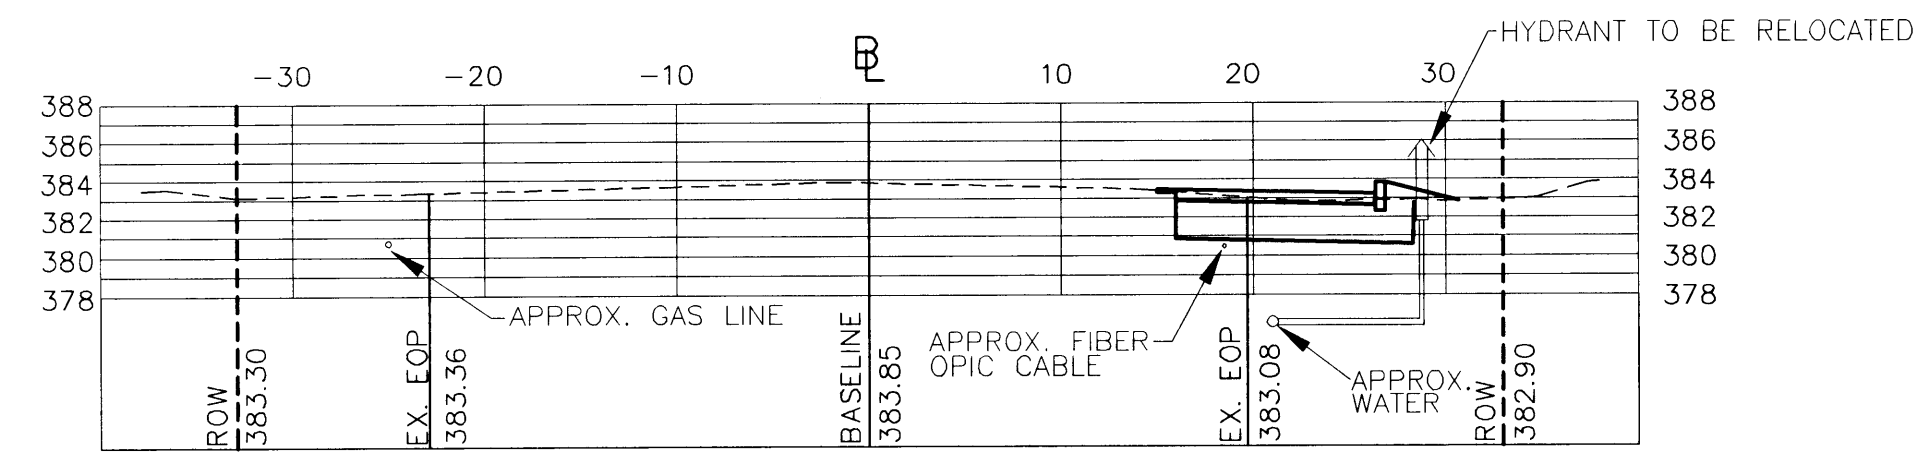


STA: 11+50

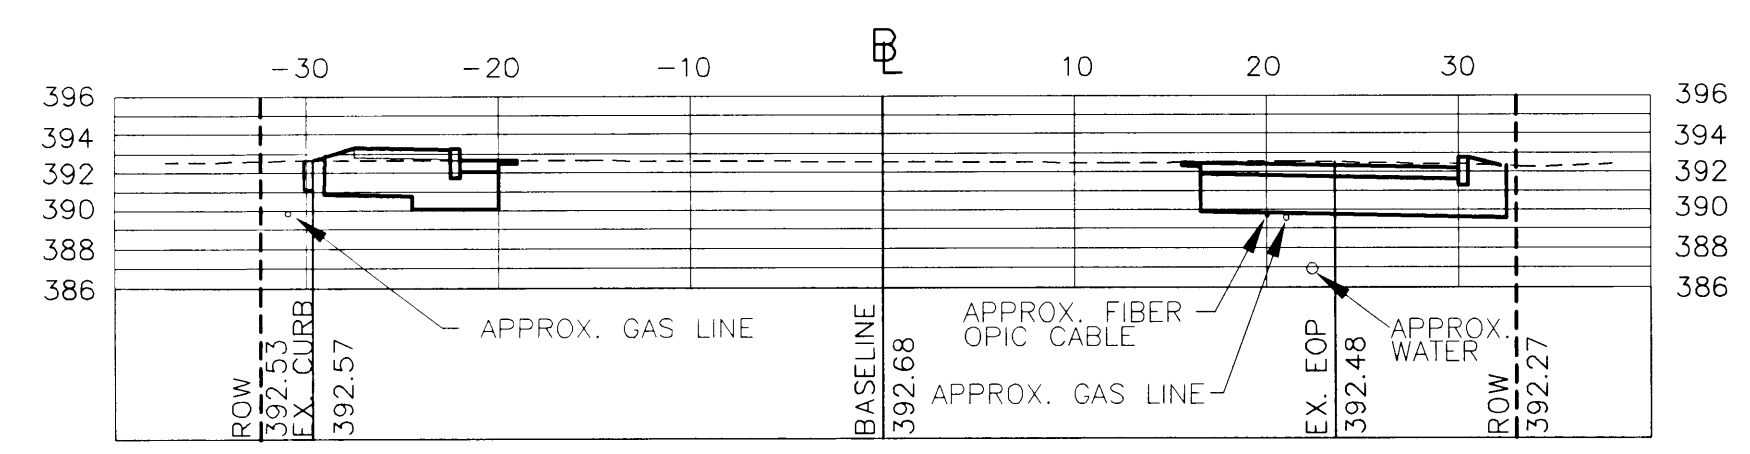


STA: 14+50

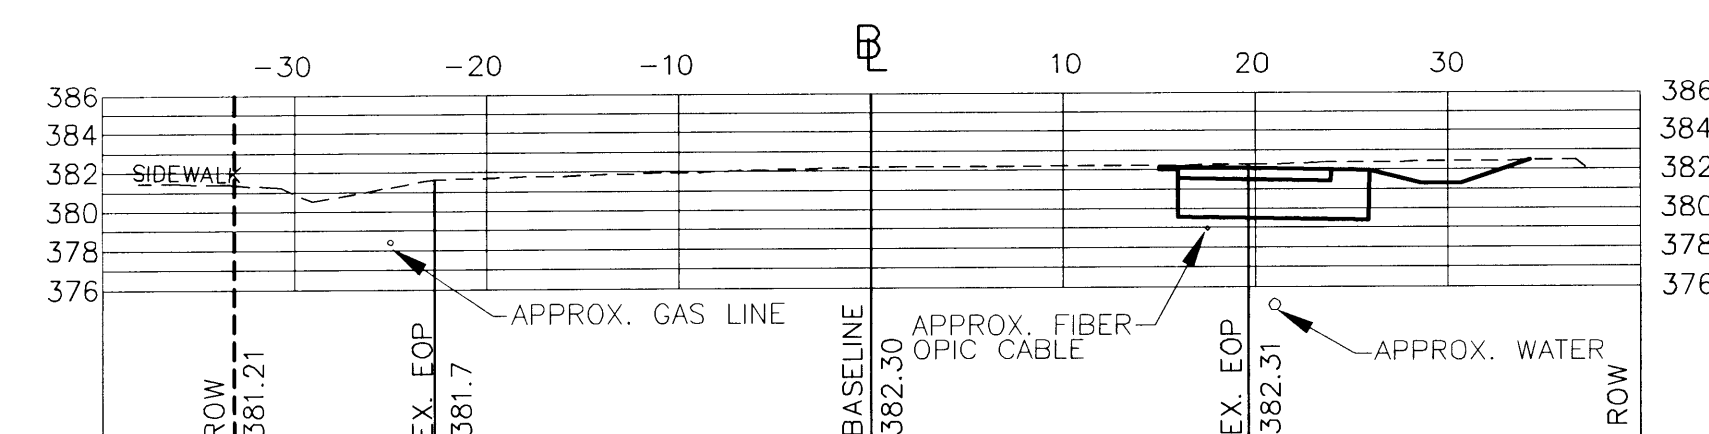


STA: 11+00

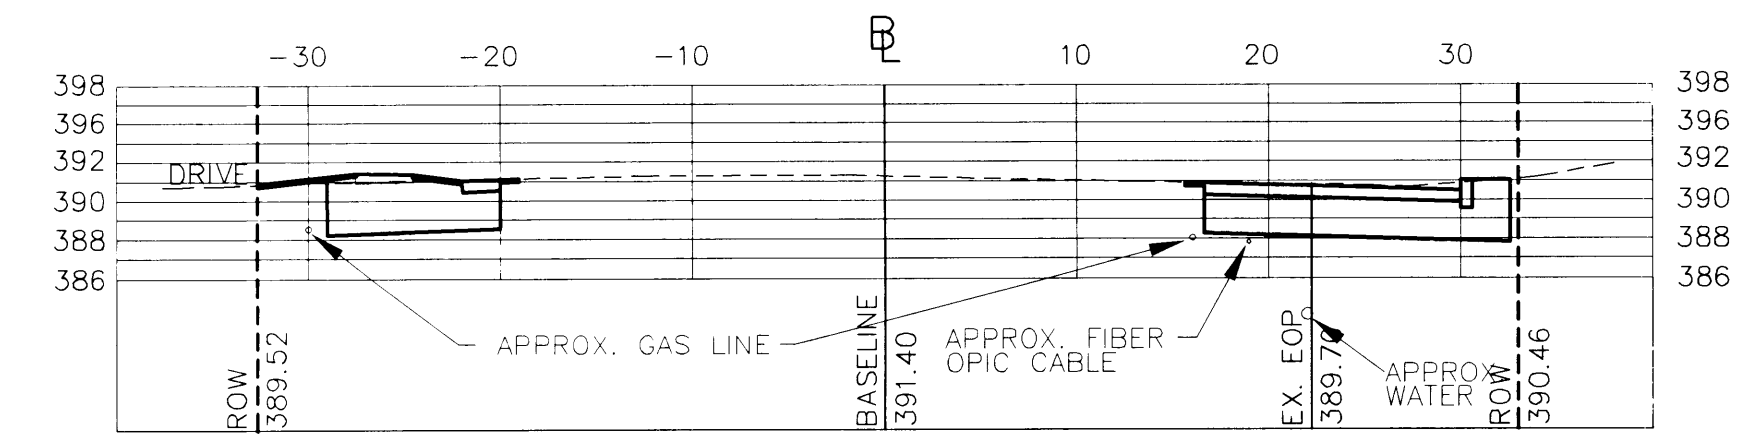


STA: 14+00

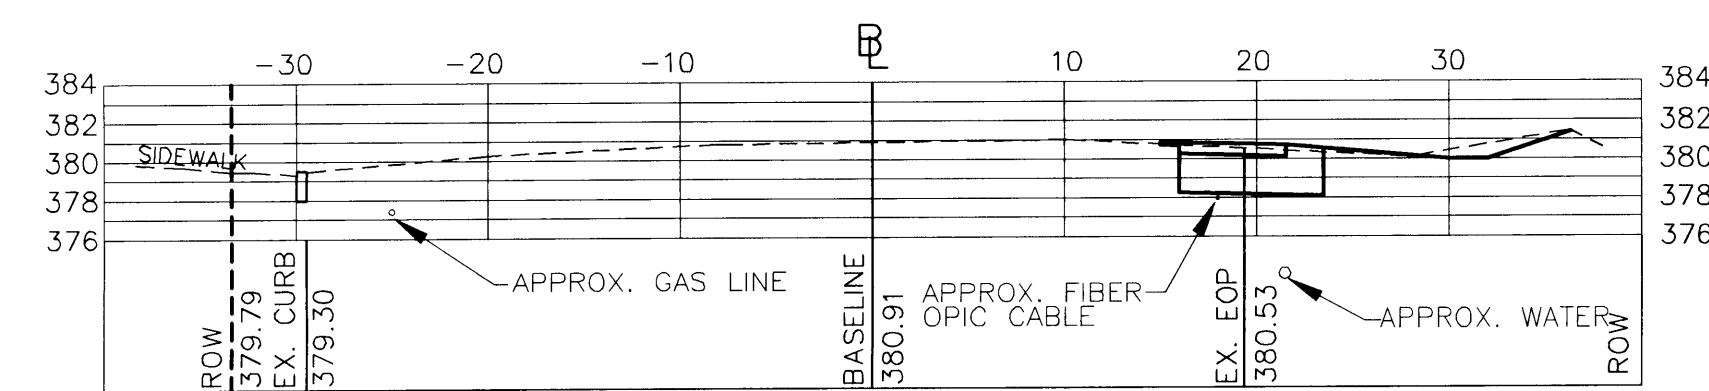


STA: 10+50

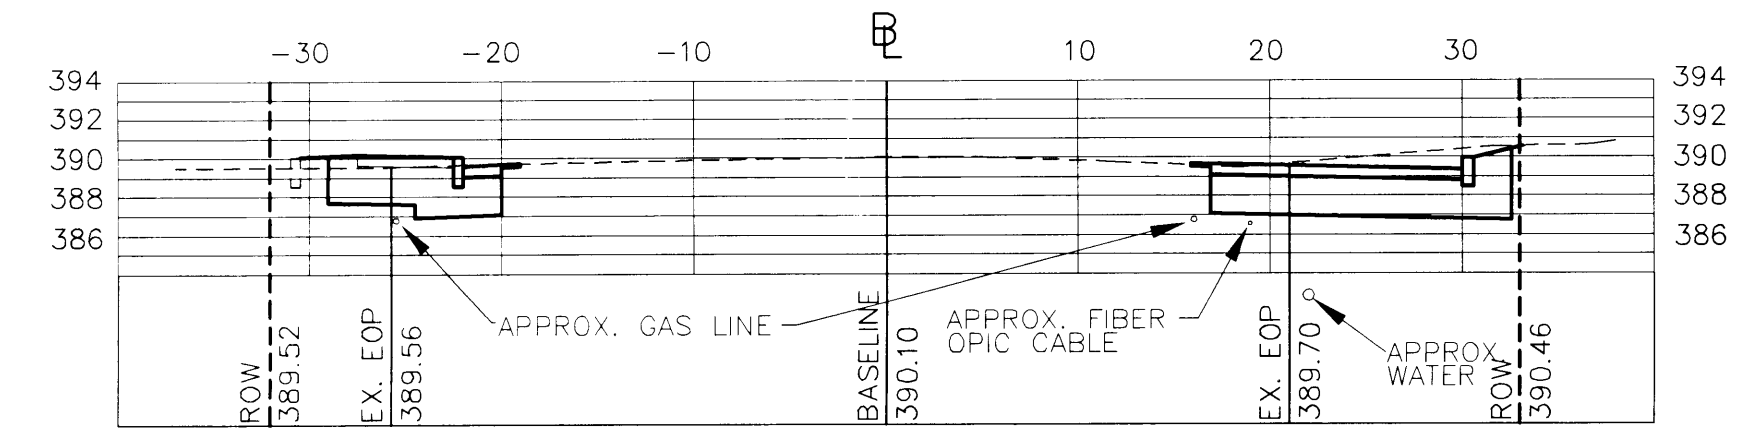

STA: 13+50

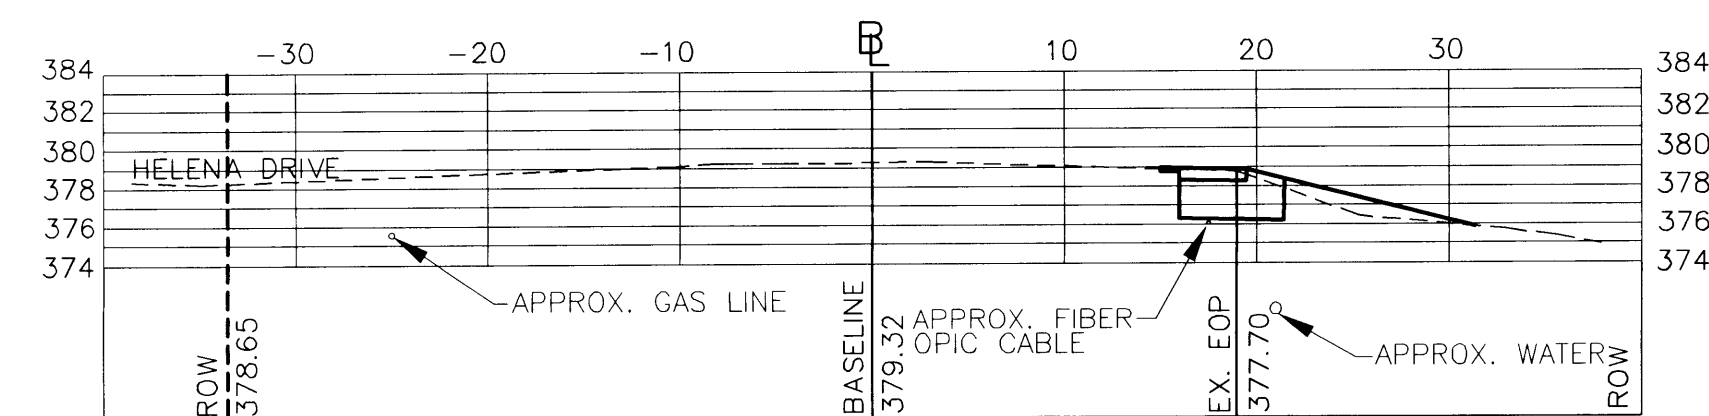

STA: 10+00

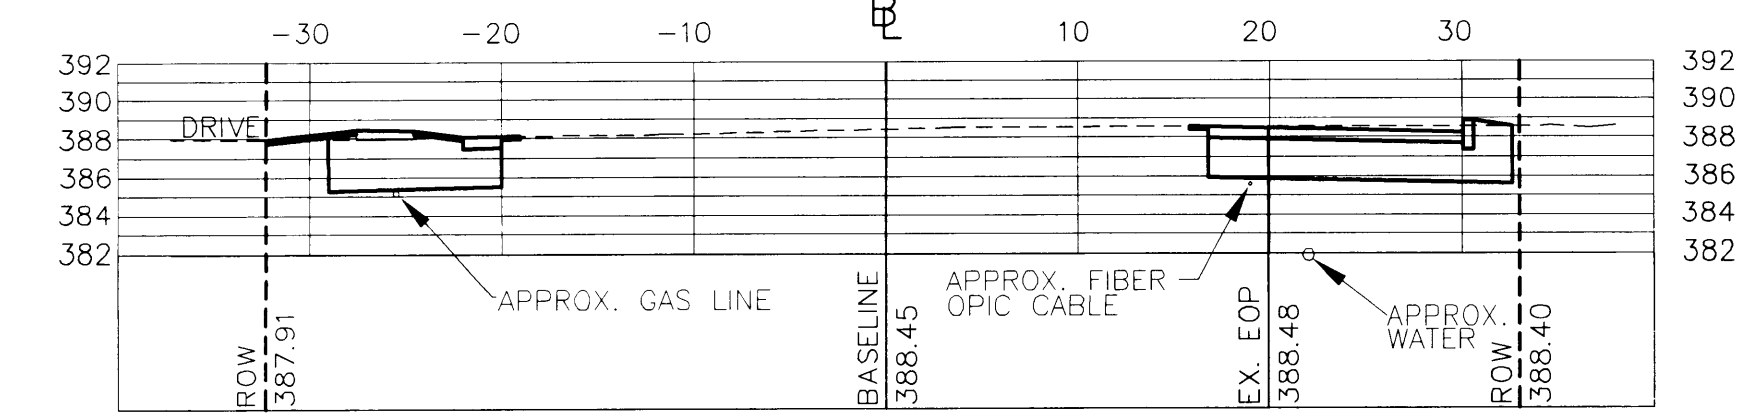

STA: 13+00

**RECORD DRAWINGS**  
 THIS RECORD DRAWING HAS BEEN PREPARED BY GRIFFIN INTERNATIONAL, INC. BASED ON BASE PLAN DESIGN DRAWINGS PROVIDED BY LAMOUREUX & DICKINSON, INC.. CHANGES MADE TO THE DESIGN PLANS ARE INDICATED. THE INFORMATION PROVIDED REGARDING ANY DEVIATION FROM THE DESIGN PLANS ARE BASED ON RESIDENT ENGINEER NOTES AND MEASUREMENT OF ABOVEGROUND FEATURES.

**CONTRACT PLANS**

**VERMONT AGENCY OF TRANSPORTATION**

**WILLISTON NHG 5500 (10)S "TAFT CORNERS"**  
 (US ROUTE 2 & VT ROUTE 2A)

WILLISTON VERMONT

**CROSS SECTIONS (U.S. ROUTE 2 - WEST)**

LAMOUREUX & DICKINSON Consulting Engineers Inc.  
 14 Morse Drive  
 Essex Junction, VT 05452  
 (802) 878-4450  
 Engineers-Planners-Surveyors

design RJD/JLC  
 drawn JLC  
 checked RJD  
 scale 1"=10'  
 sht. no. 15