




STA: 18+50

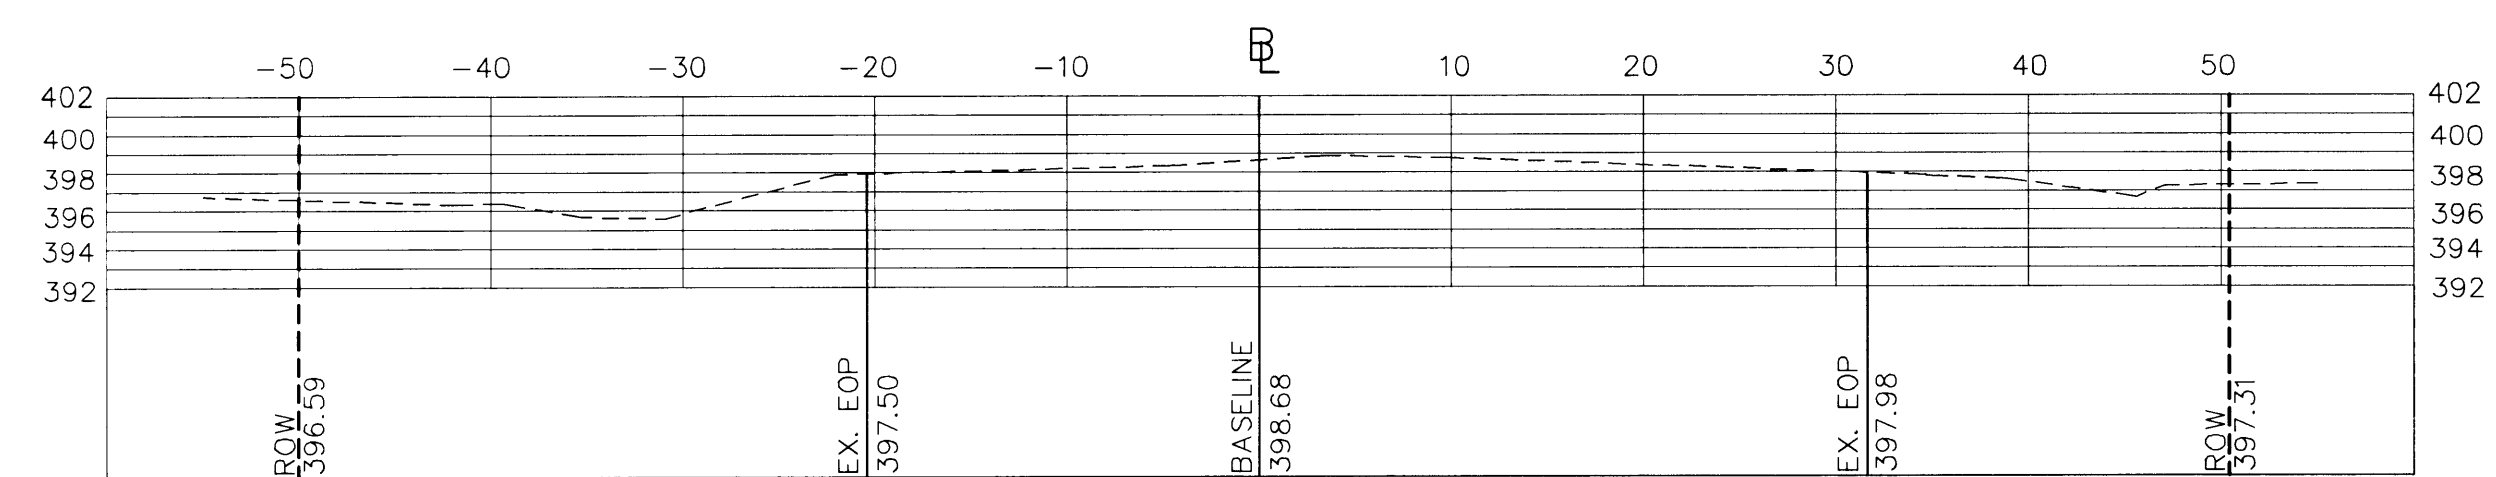


STA: 20+00

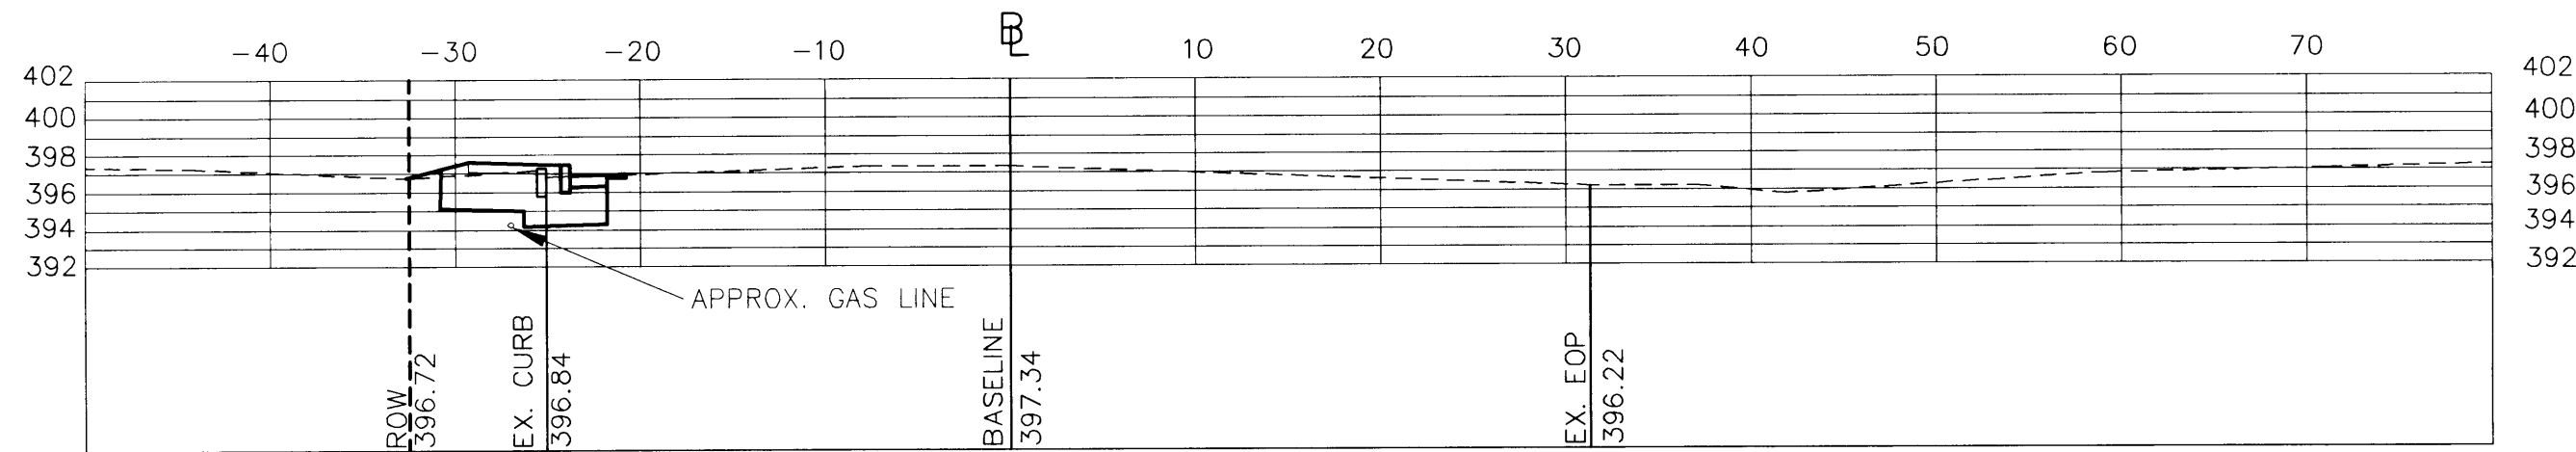


STA: 18+00

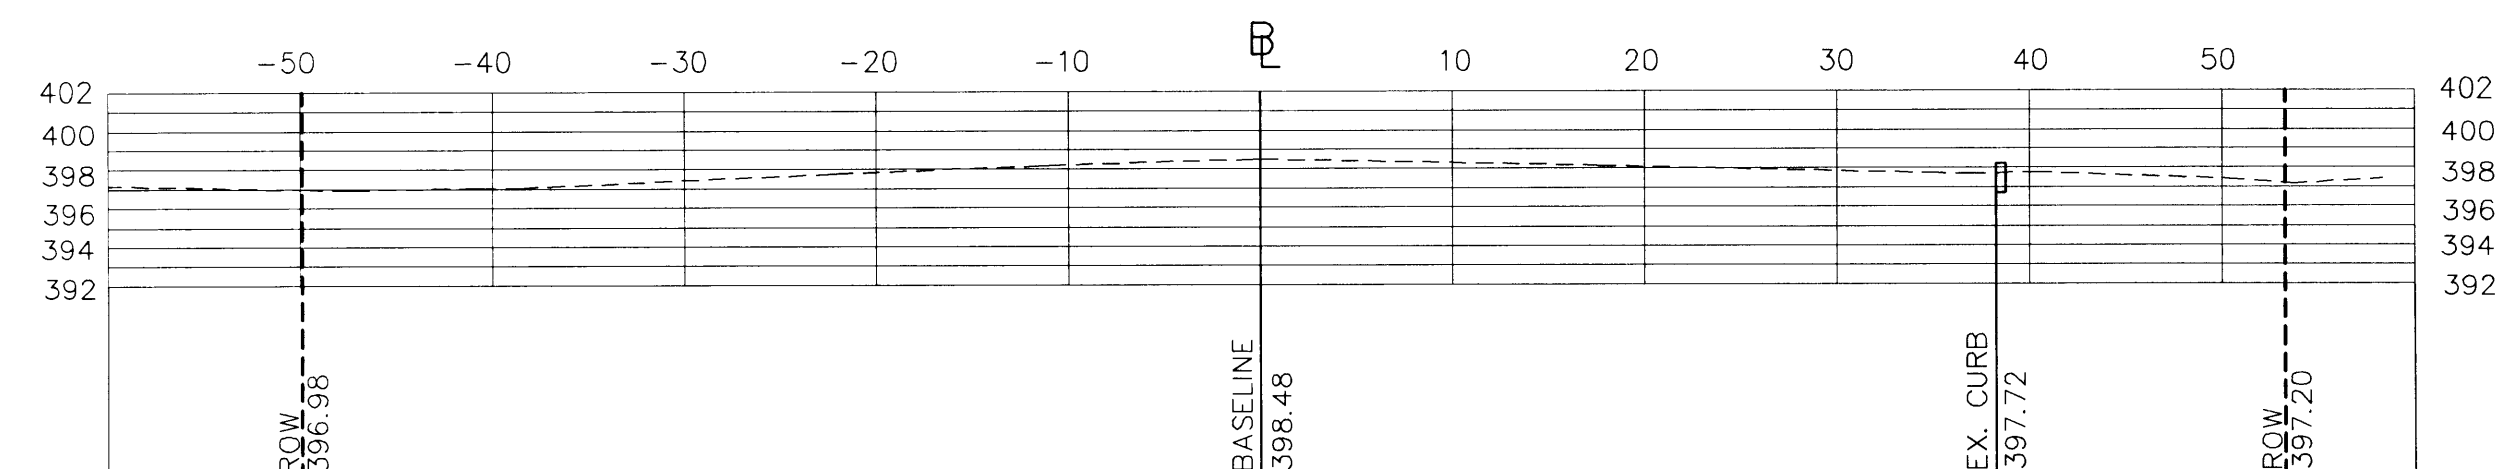


STA: 19+50

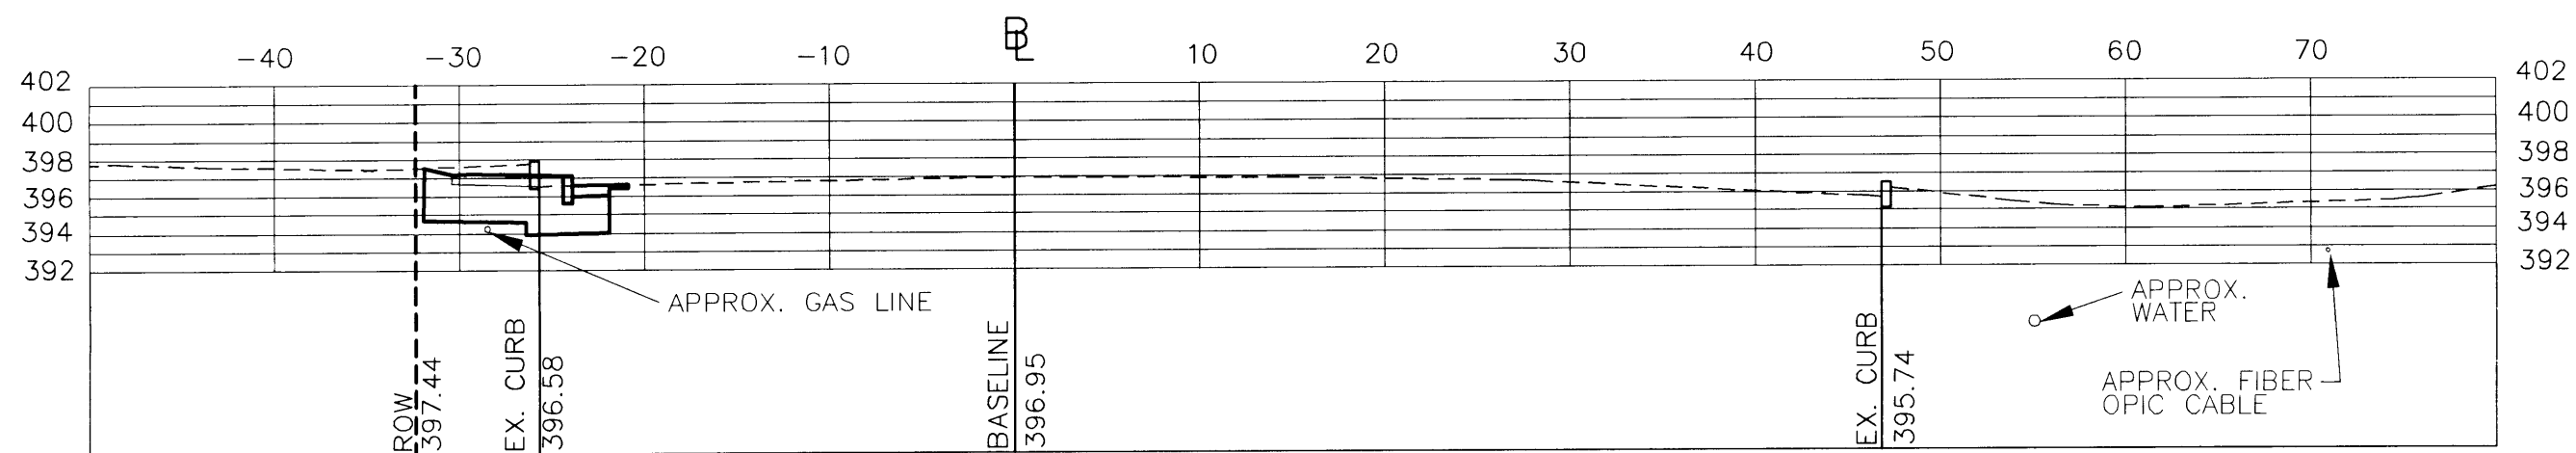


STA: 17+50

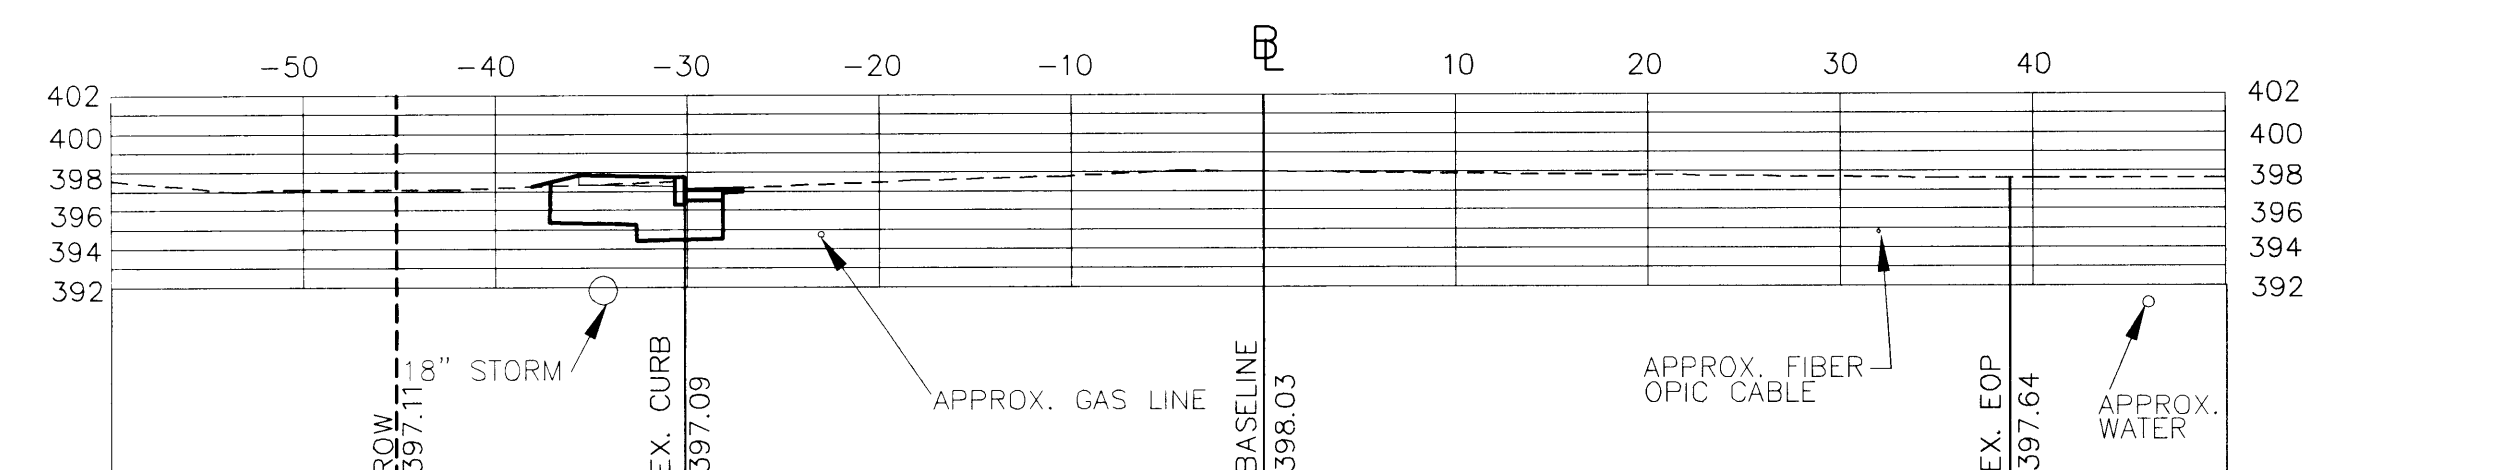


STA: 19+00

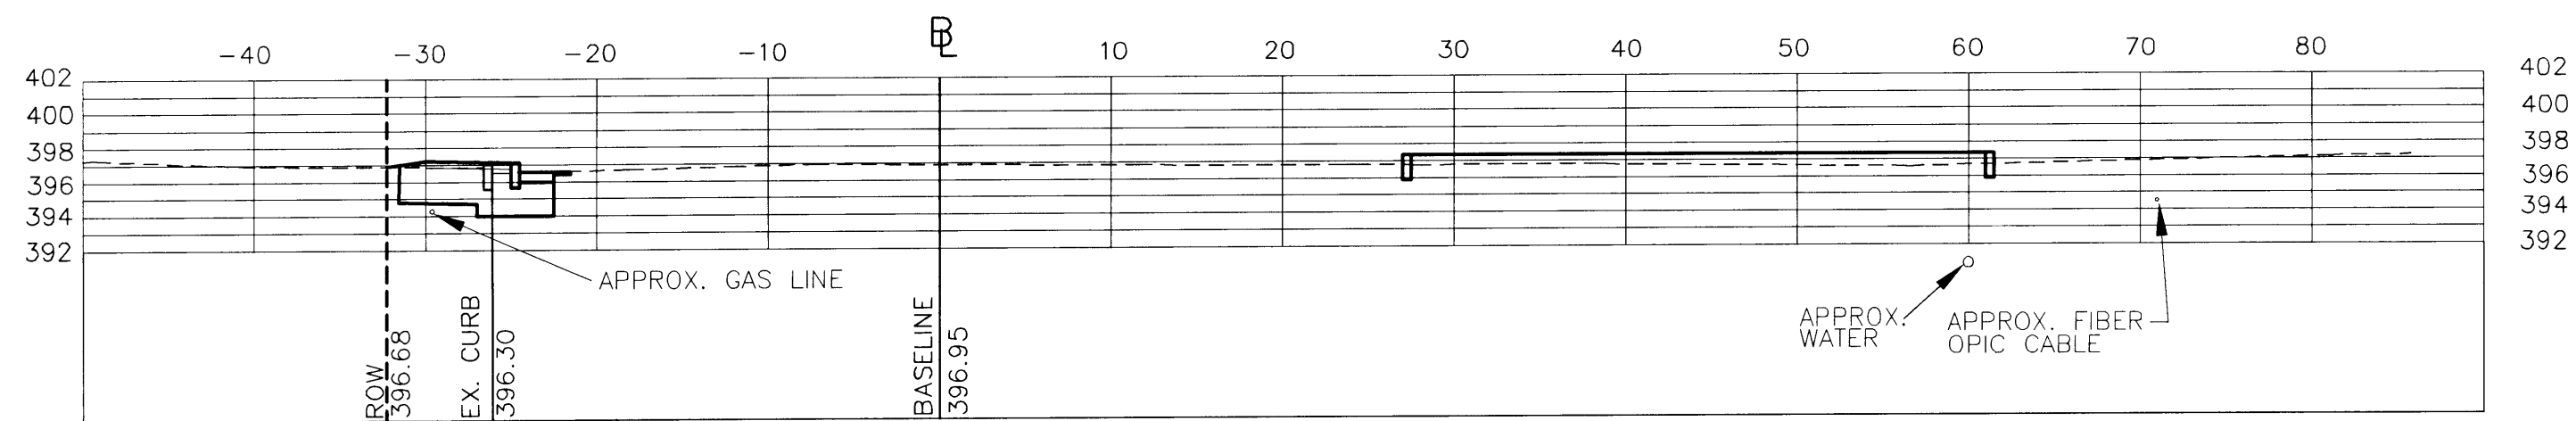

STA: 17+00

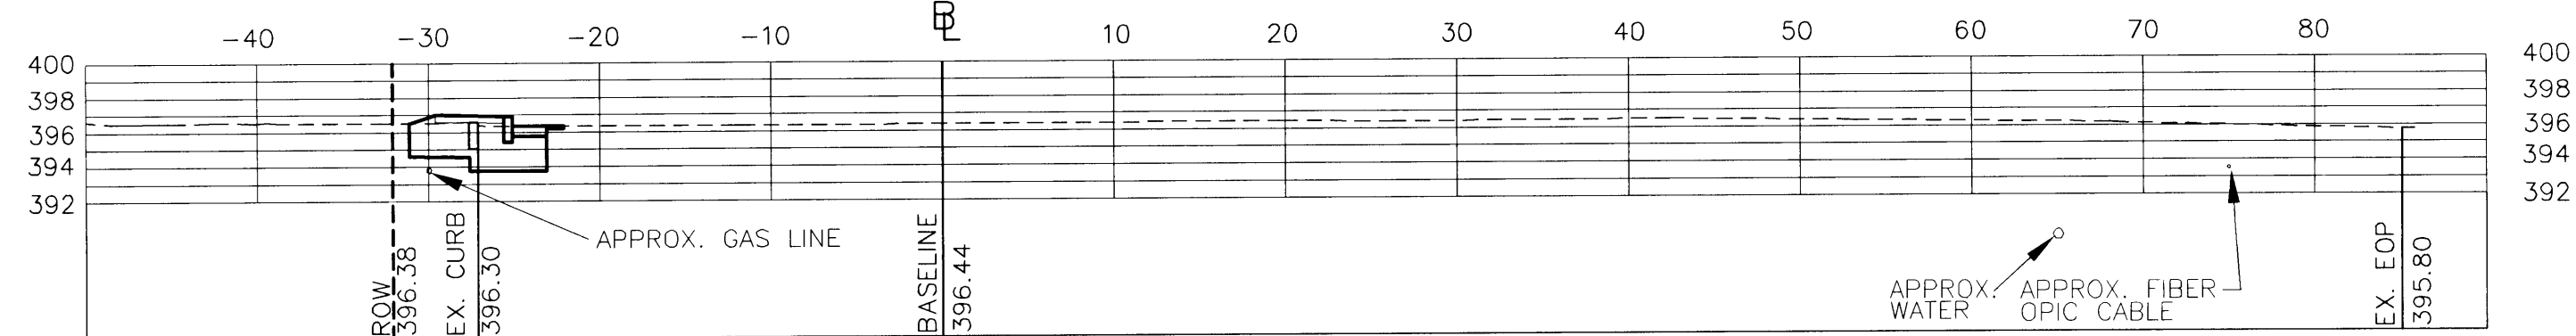

STA: 16+50

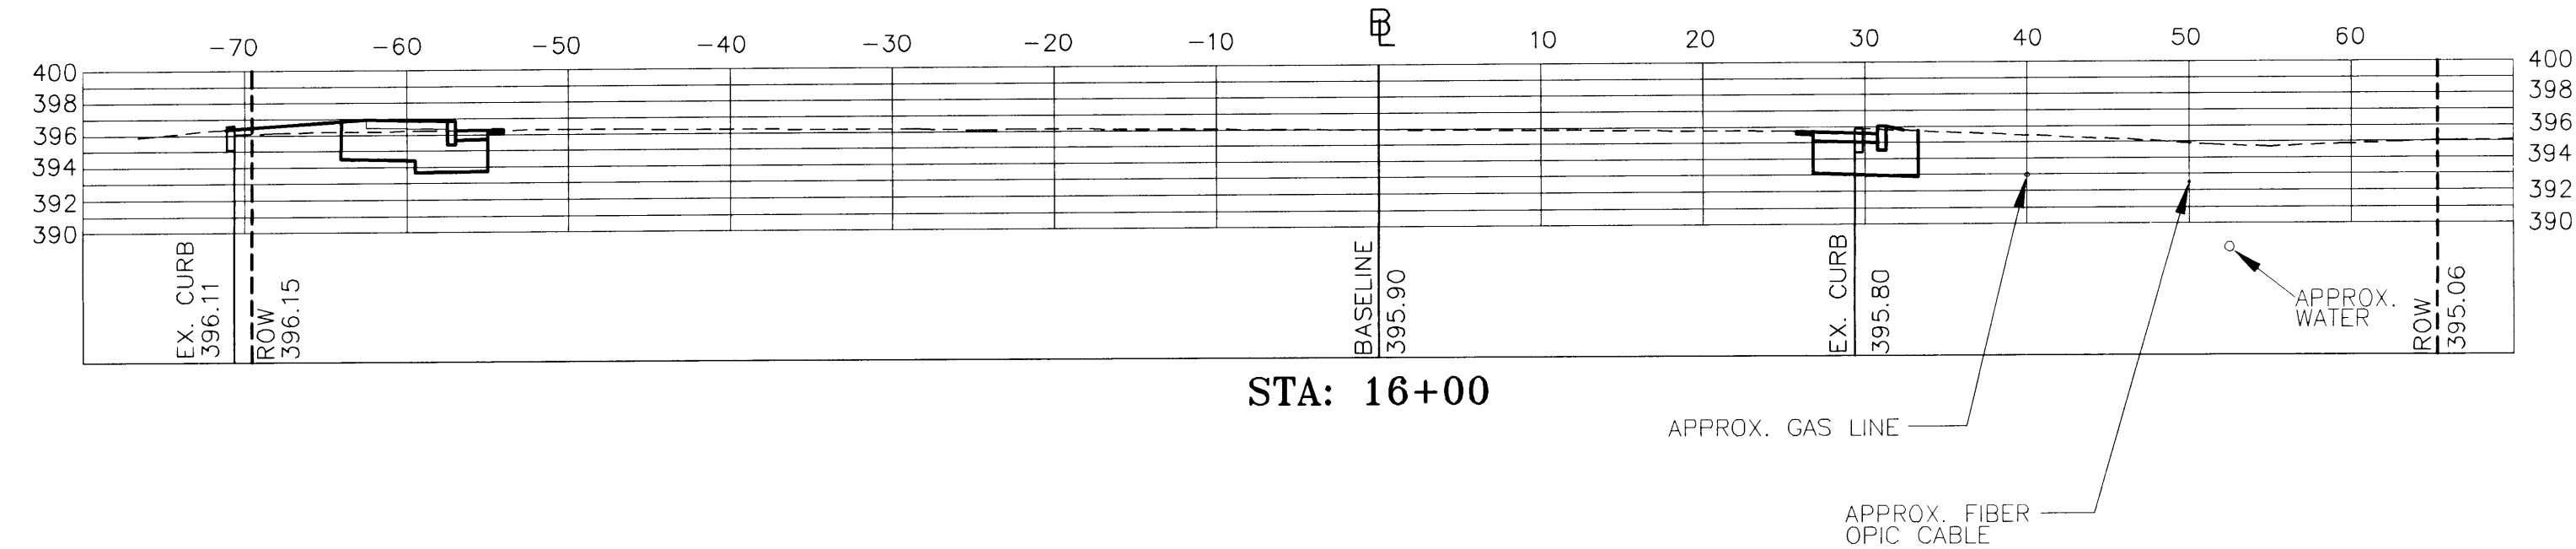

STA: 16+00

CONTRACT PLANS

**VERMONT AGENCY OF
TRANSPORTATION**

**WILLISTON NHG 5500 (10)S
"TAFT CORNERS"
(US ROUTE 2 & VT ROUTE 2A)**

WILLISTON VERMONT

**CROSS SECTIONS
(U.S. ROUTE 2 - EAST)**

<p>LAMOUREUX & DICKINSON Consulting Engineers Inc. 14 Morse Drive Essex Junction, VT 05452 (802) 878-4450 Engineers-Planners-Surveyors</p>	<p>design RJD/JLC drawn JLC checked RJD scale 1"=10' sht. no. 16</p>
--	---

RECORD DRAWINGS

THIS RECORD DRAWING HAS BEEN PREPARED BY GRIFFIN INTERNATIONAL, INC. BASED ON BASE PLAN DESIGN DRAWINGS PROVIDED BY LAMOUREUX & DICKINSON, INC. CHANGES MADE TO THE DESIGN PLANS ARE INDICATED. THE INFORMATION PROVIDED REGARDING ANY DEVIATION FROM THE DESIGN PLANS ARE BASED ON RESIDENT ENGINEER NOTES AND MEASUREMENT OF ABOVEGROUND FEATURES.

DATE PLOTTED: 11/14/2013 10:00:00 AM