




STA: 112+00

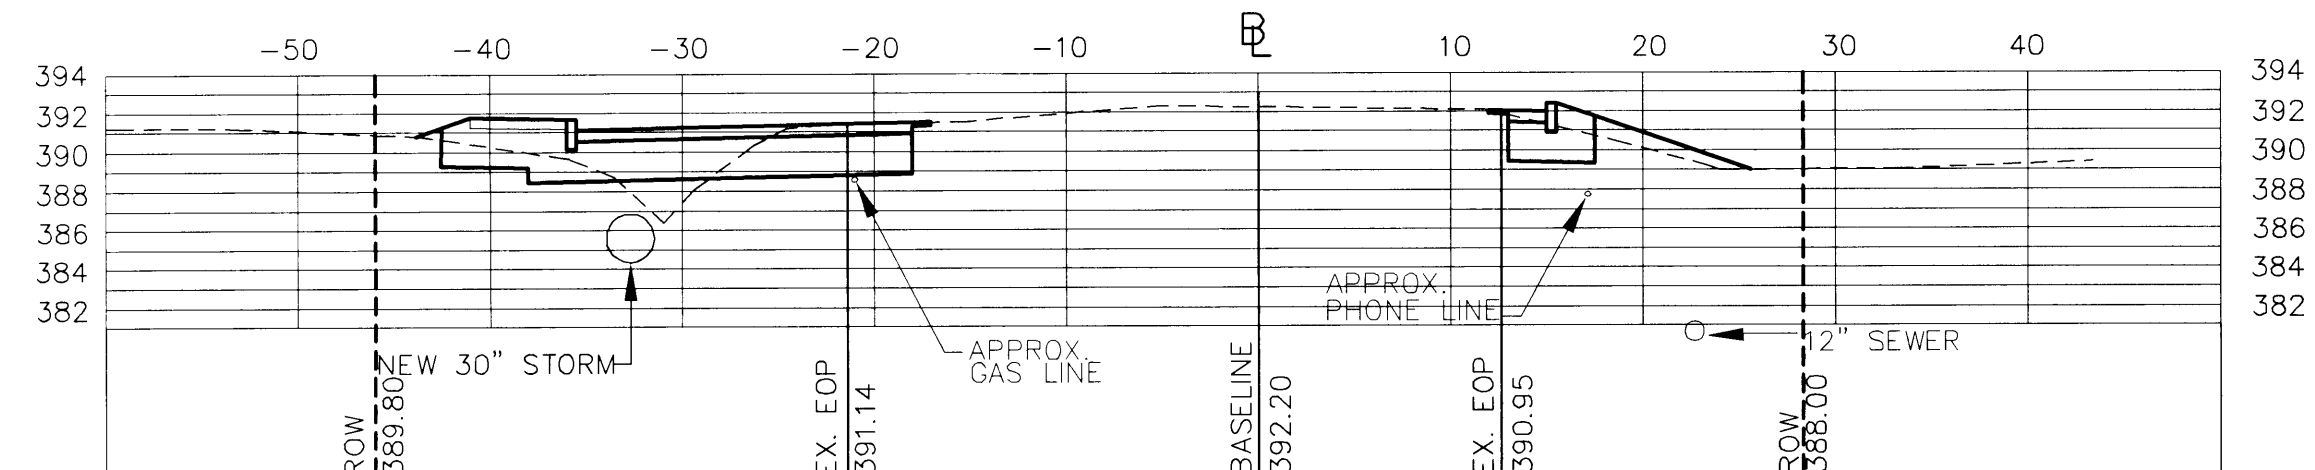


STA: 113+50

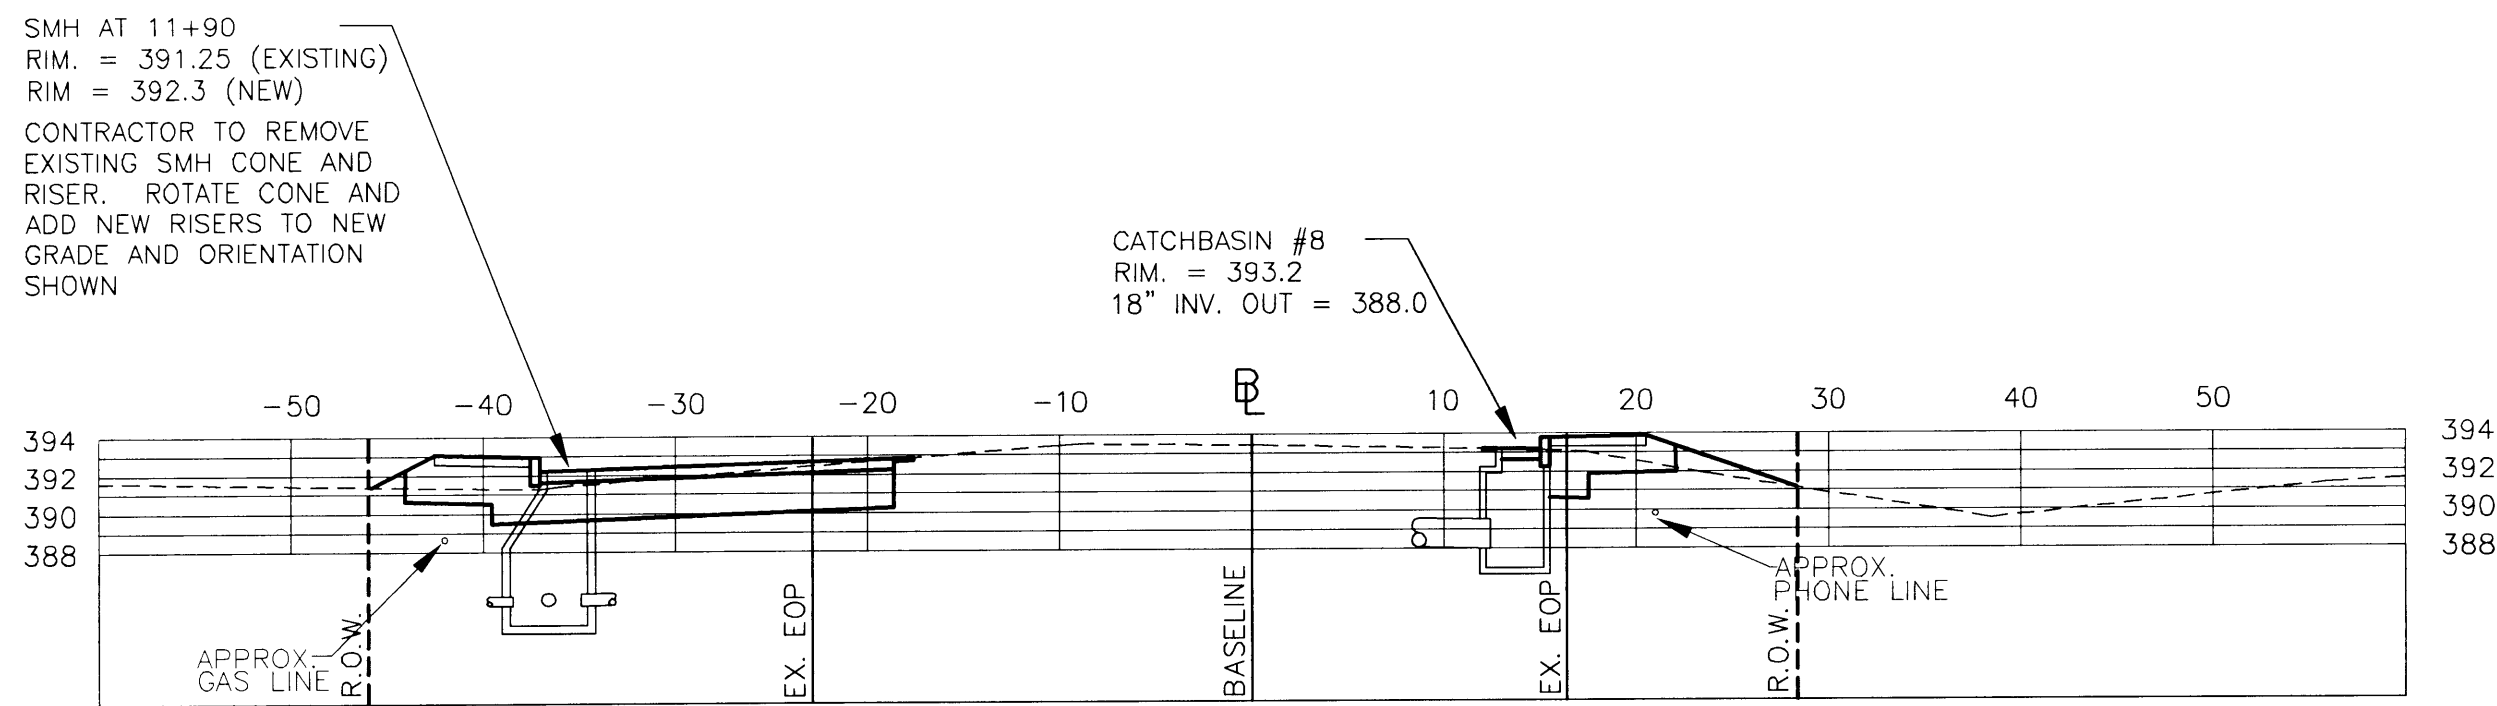


STA: 111+87

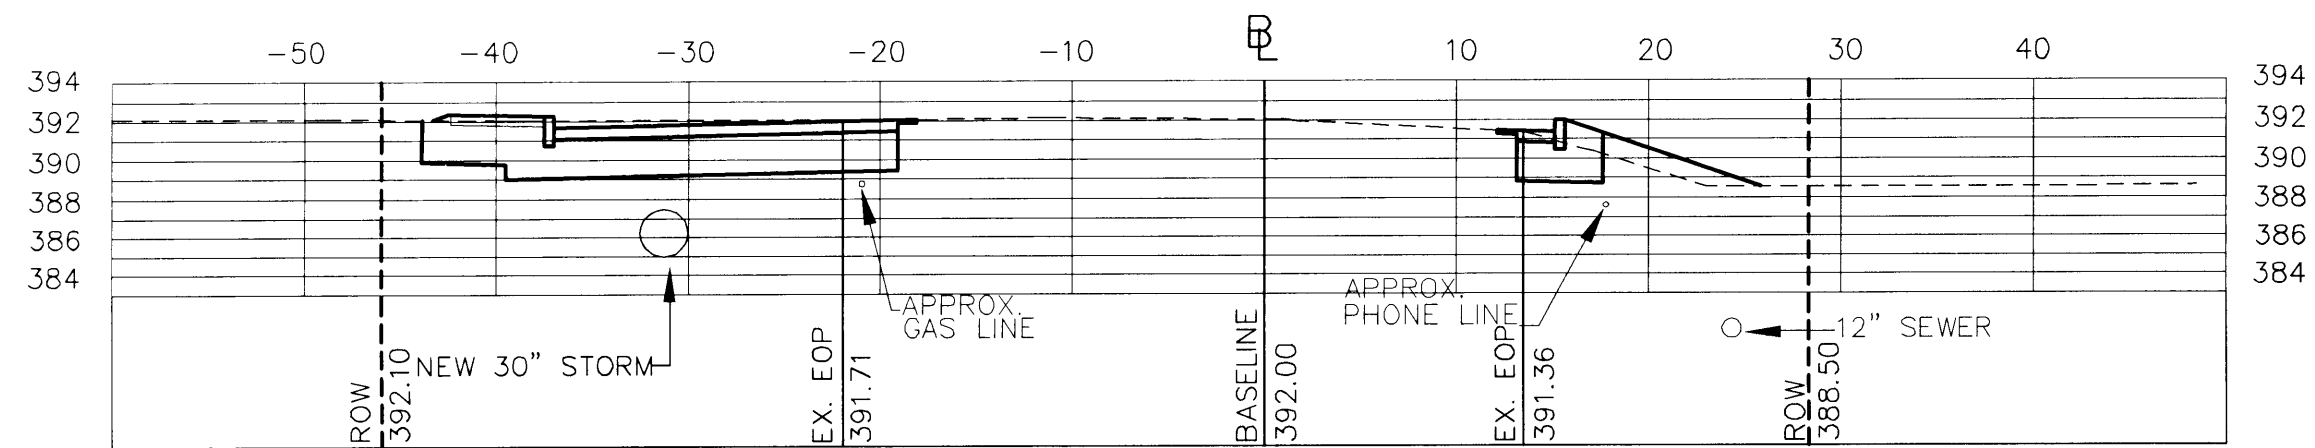


STA: 113+00

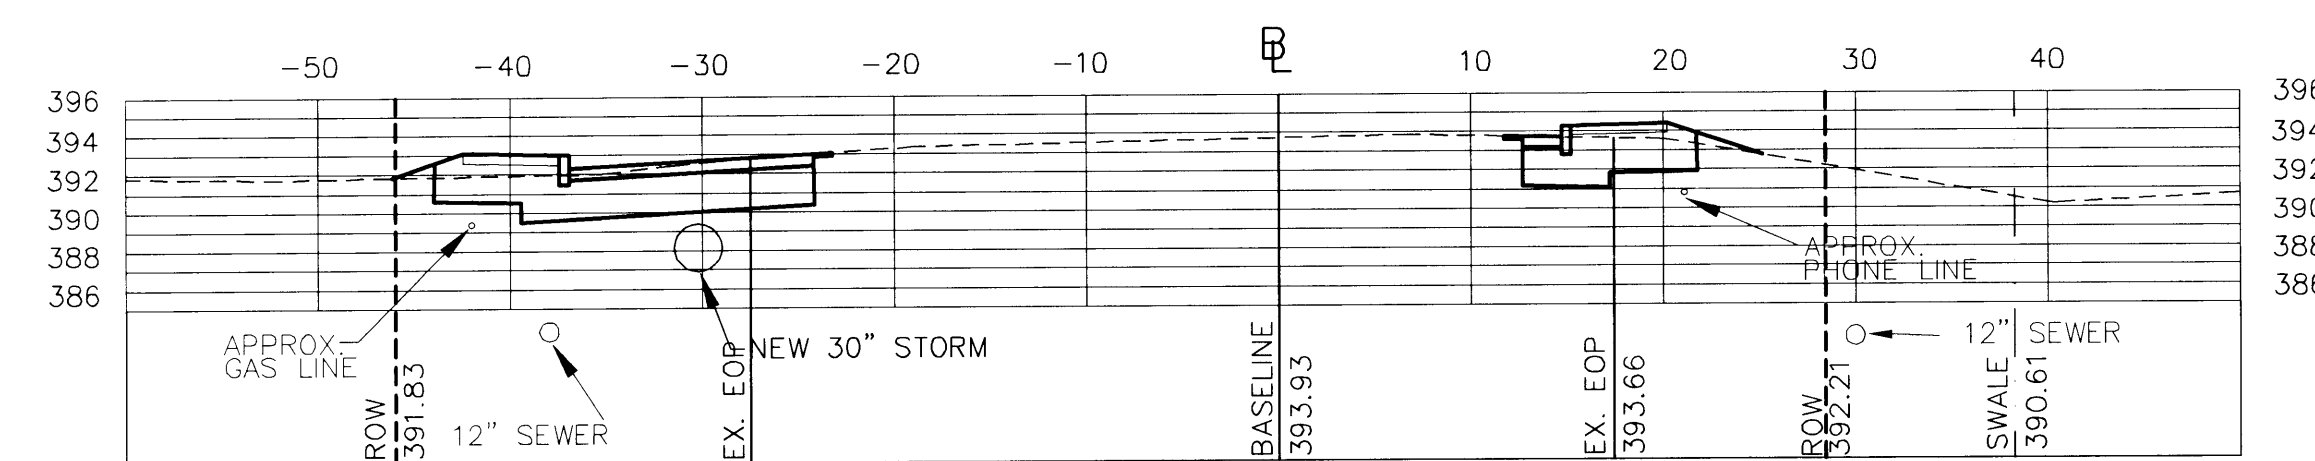


STA: 111+50

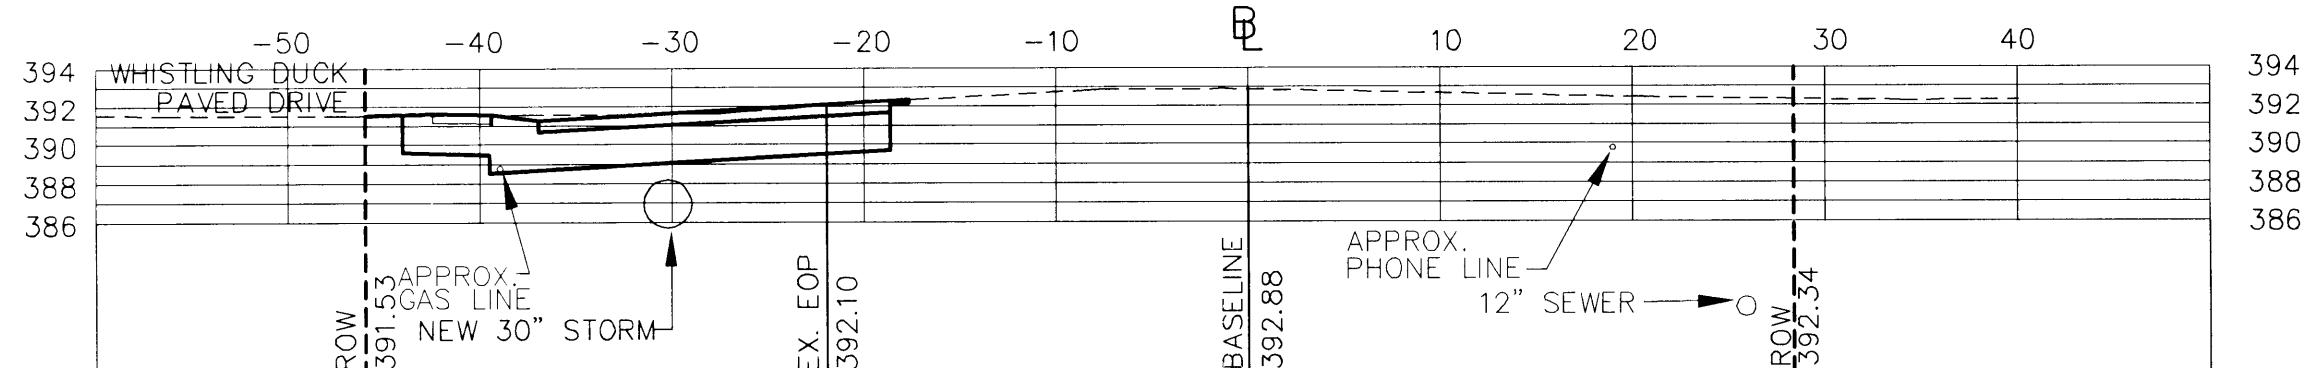


STA: 112+50

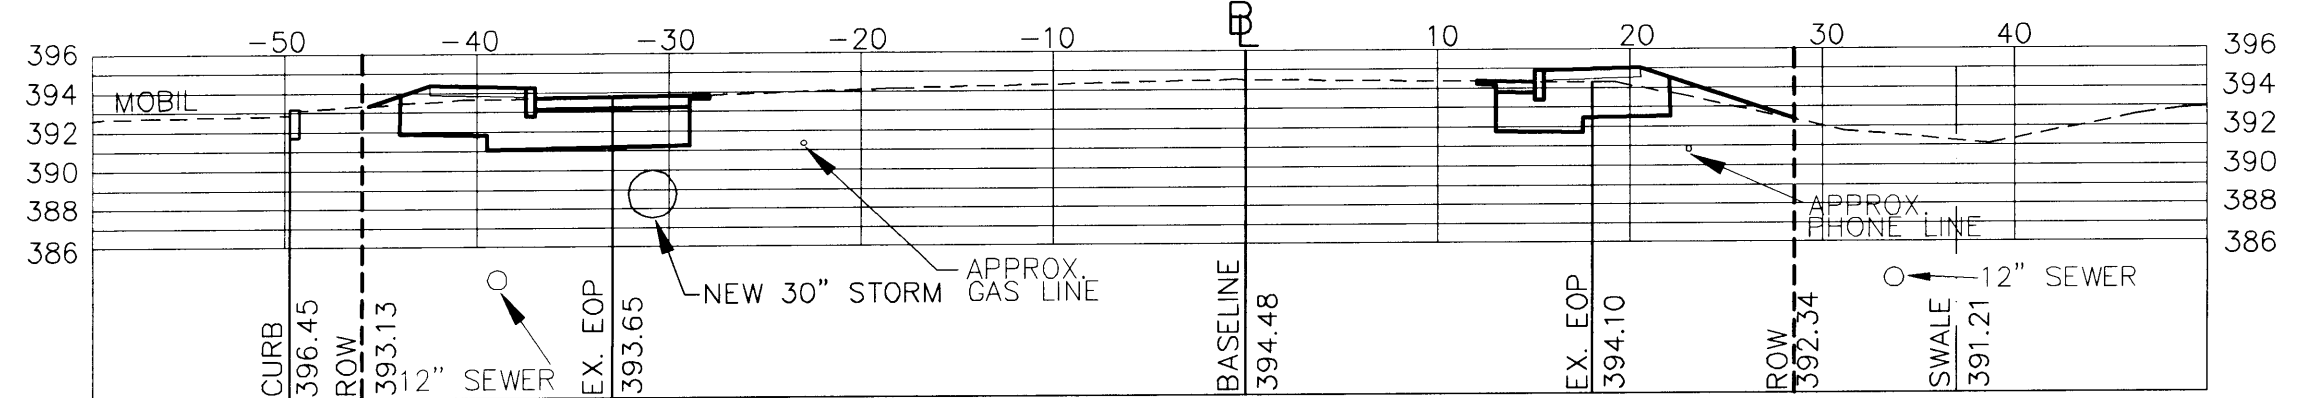

STA: 111+00

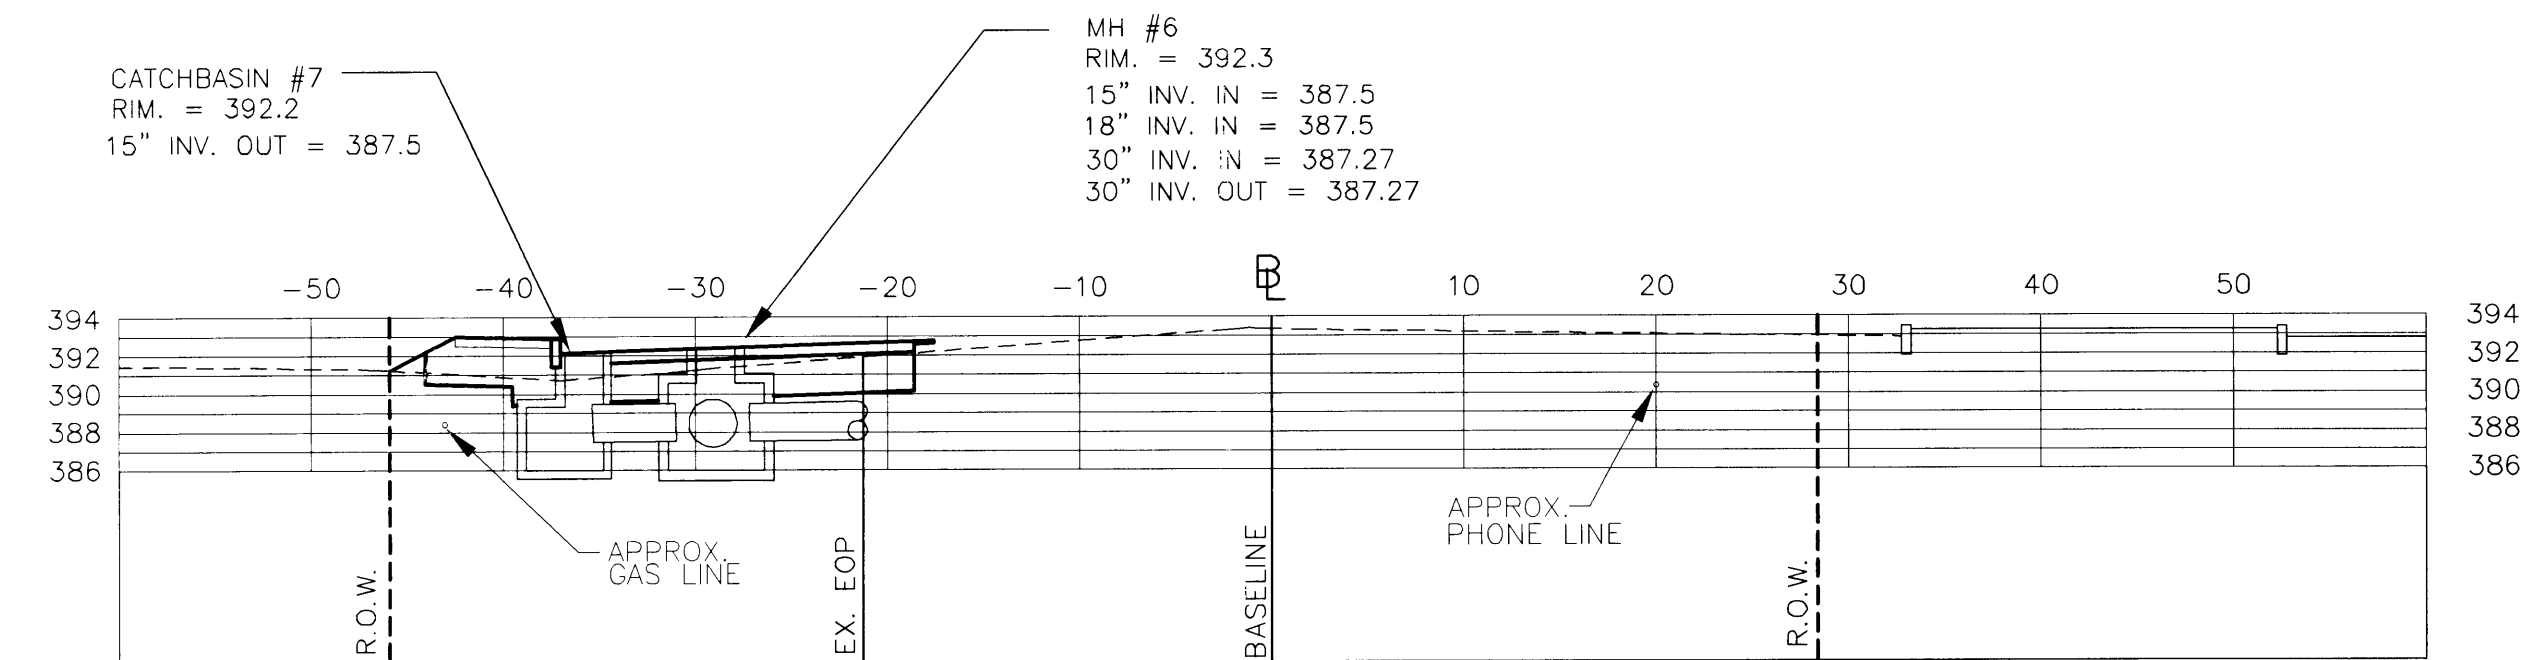

STA: 112+15

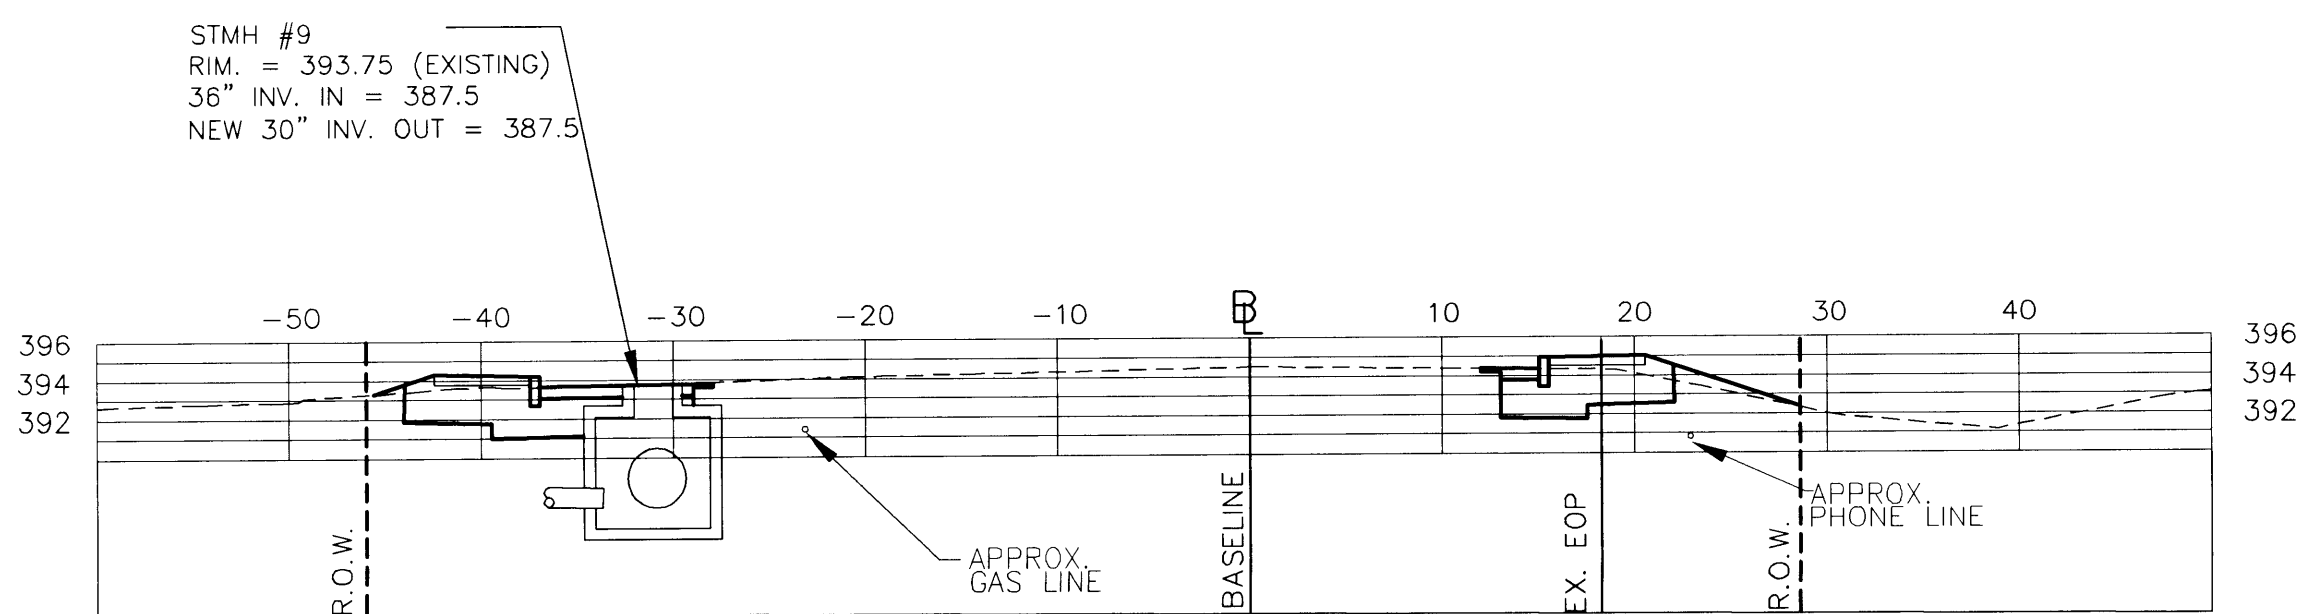

STA: 110+98

**RECORD DRAWINGS**  
 THIS RECORD DRAWING HAS BEEN PREPARED BY GRIFFIN INTERNATIONAL, INC. BASED ON BASE PLAN DESIGN DRAWINGS PROVIDED BY LAMOUREUX & DICKINSON, INC. CHANGES MADE TO THE DESIGN PLANS ARE INDICATED. THE INFORMATION PROVIDED REGARDING ANY DEVIATION FROM THE DESIGN PLANS ARE BASED ON RESIDENT ENGINEER NOTES AND MEASUREMENT OF ABOVEGROUND FEATURES.

**CONTRACT PLANS**  
**VERMONT AGENCY OF TRANSPORTATION**  
 WILLISTON NHG 5500 (10)S  
 "TAFT CORNERS"  
 (US ROUTE 2 & VT ROUTE 2A)  
 WILLISTON VERMONT  
**CROSS SECTIONS**  
 (VT ROUTE 2A NORTH)  
 LAMOUREUX & DICKINSON  
 Consulting Engineers Inc.  
 14 Morse Drive  
 Essex Junction, VT 05452  
 (802) 878-4450  
 Engineers-Planners-Surveyors

design	RJD/JLC
drawn	JLC
checked	RJD
scale	1"=10'
sht. no.	21