


STA 9+50  
PROJECT LIMIT

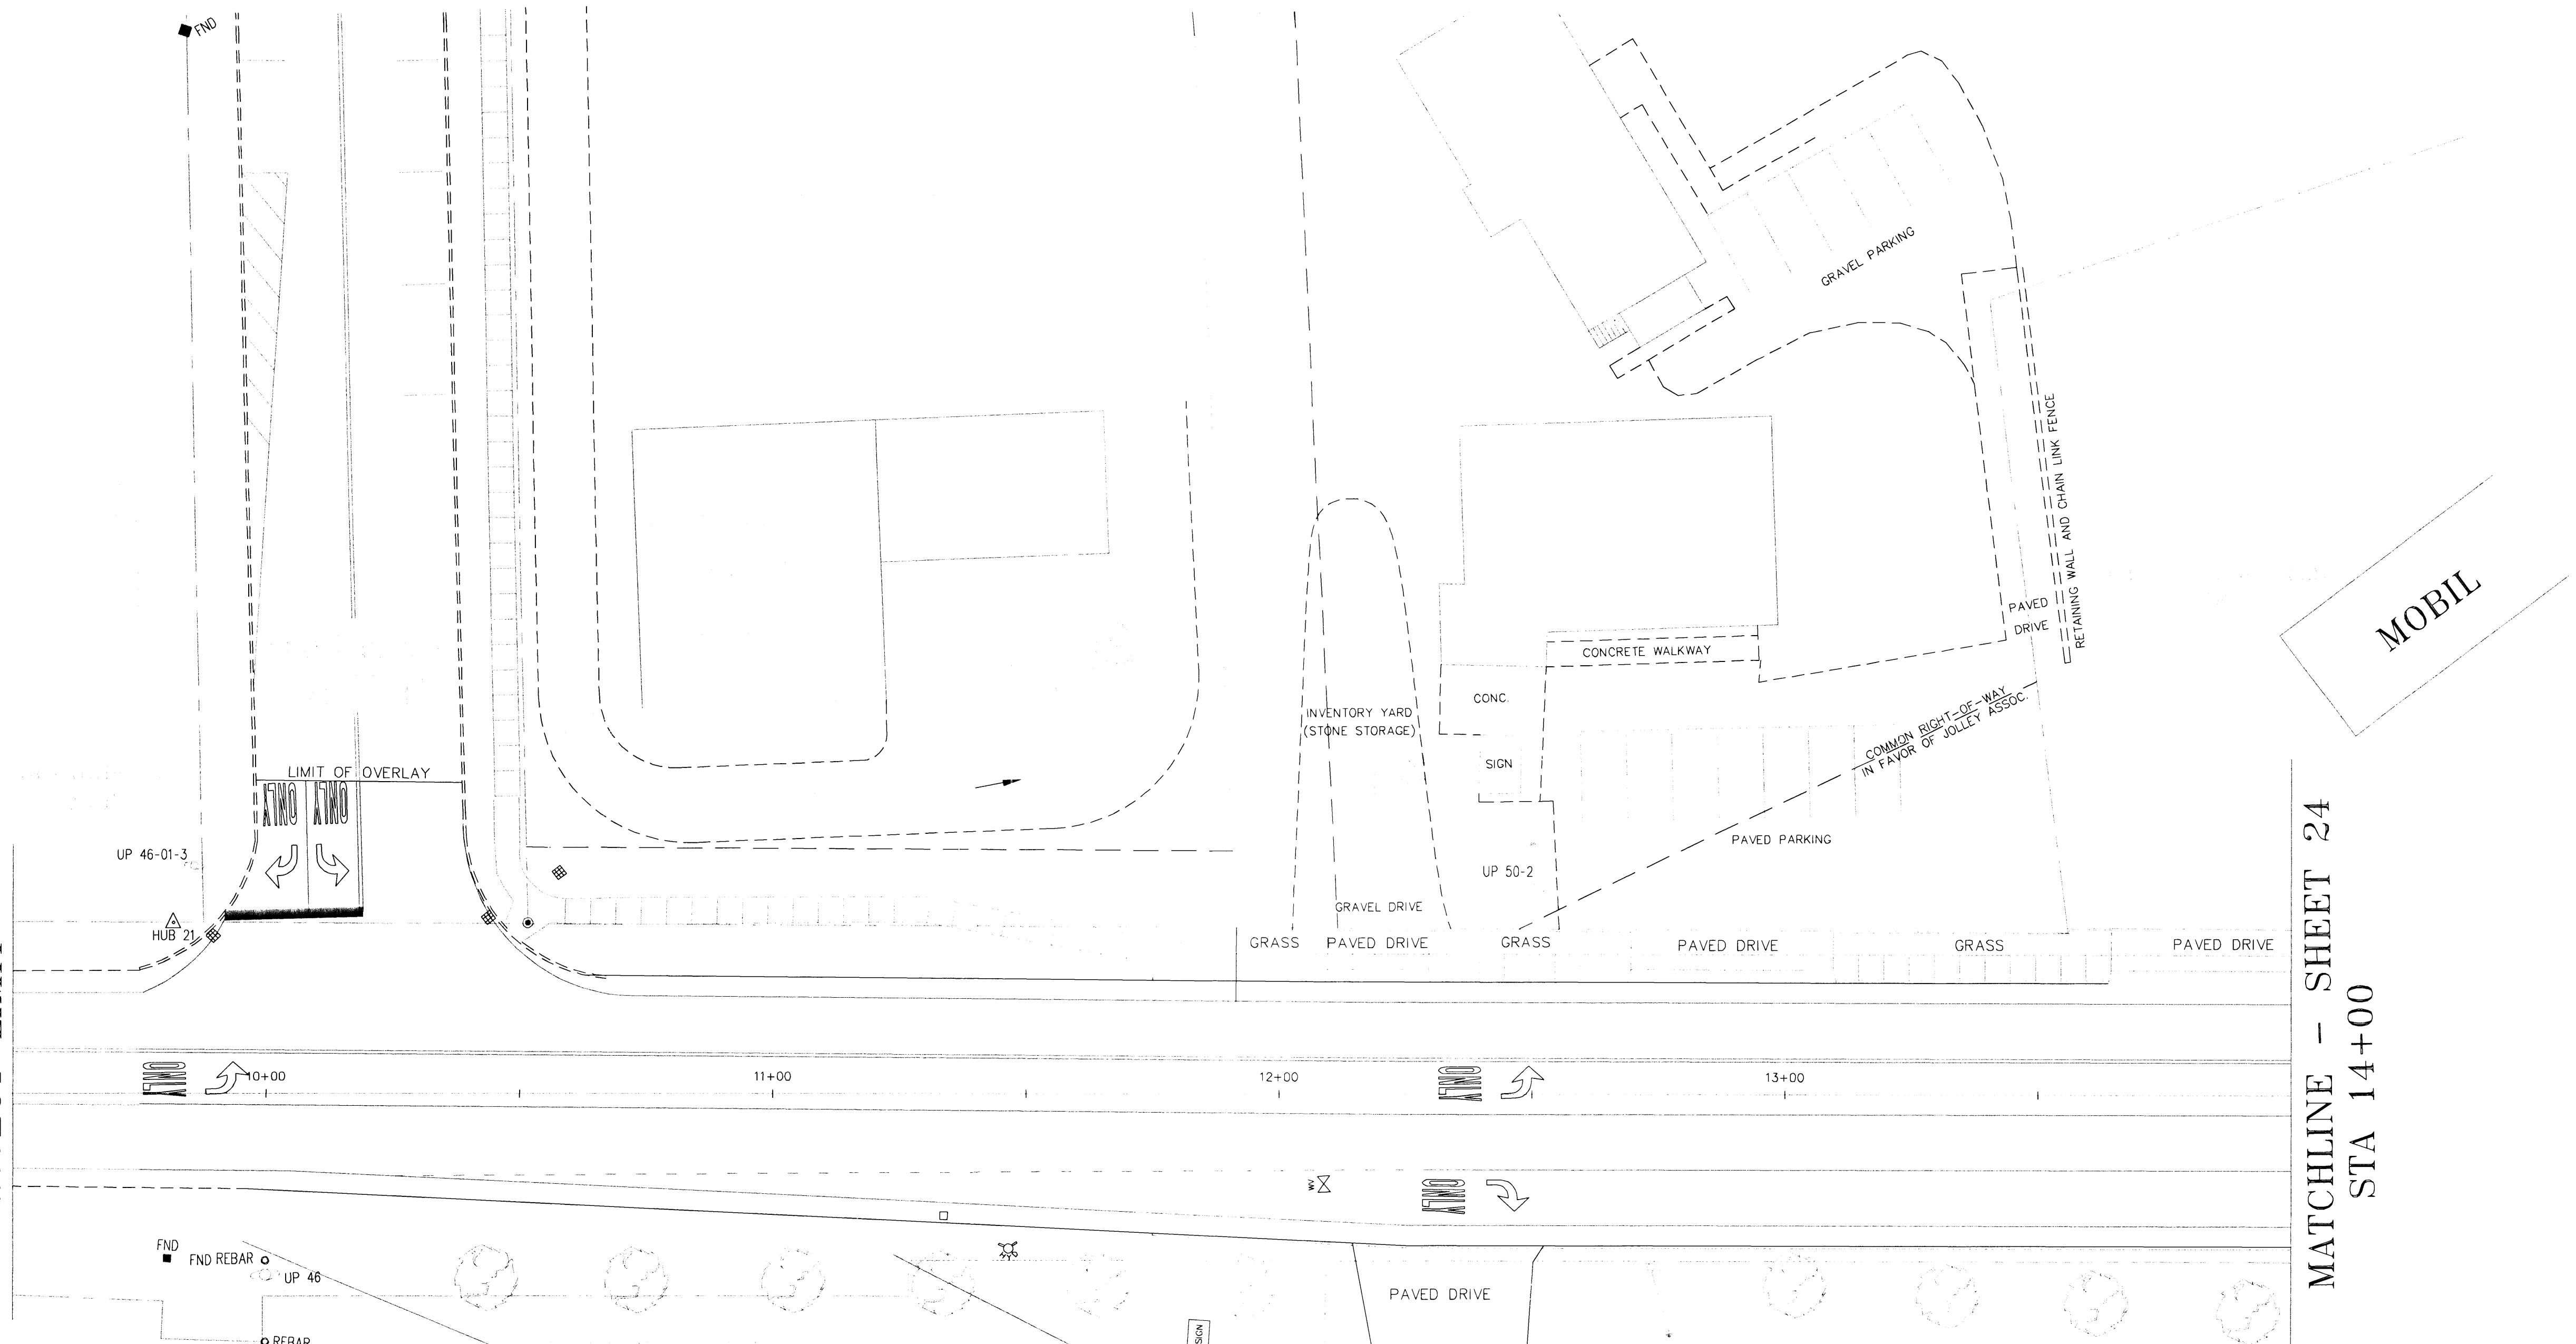

MATCHLINE - SHEET 24  
STA 14+00

**DURABLE LETTER OR SYMBOL**

- 9+76 - 9+84 LT. (ONLY)
- 9+88 - 9+96 LT. (1 ARROW)
- 9+99 - 10+06 LT. (ONLY)
- 9+99 - 10+06 LT. (1 ARROW)
- 10+09 - 10+16 LT. (ONLY)
- 10+09 - 10+16 LT. (1 ARROW)
- 12+29 - 12+37 RT. (ONLY)
- 12+32 - 12+40 LT. (ONLY)
- 12+41 - 12+49 RT. (1 ARROW)
- 12+44 - 12+52 LT. (1 ARROW)

**DURABLE 4" WHITE LINE**

- 9+75 - 9+92 LT.
- 9+75 - 14+00 RT.
- 9+75 - 14+00 RT. (DOTTED)
- 10+26 - 12+29 RT. (DOTTED)
- 10+43 - 14+00 LT.
- 12+29 - 14+00 RT.

**DURABLE 4" YELLOW LINE**

- 9+75 - 14+00 LT. (DBL.)
- 10+18 - 10+19 LT. (DBL.)


**DURABLE 24" STOP BAR**

- 9+92 - 10+19 LT.

**REMOVING SIGNS**

- 9 - AS SHOWN

NOTE: SIGNS SHOWN AS RETAINED OR SALVAGED MAY NEED TO BE REPLACED AT THE DISCRETION OF THE ENGINEER.

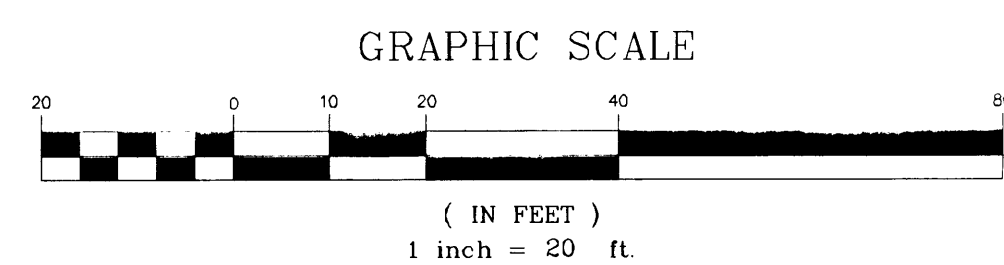

**RECORD DRAWINGS**  
THIS RECORD DRAWING HAS BEEN PREPARED BY GRIFFIN INTERNATIONAL, INC. BASED ON BASE PLAN DESIGN DRAWINGS PROVIDED BY LAMOUREUX & DICKINSON, INC. CHANGES MADE TO THE DESIGN PLANS ARE INDICATED. THE INFORMATION PROVIDED REGARDING ANY DEVIATION FROM THE DESIGN PLANS ARE BASED ON RESIDENT ENGINEER NOTES AND MEASUREMENT OF ABOVEGROUND FEATURES.

**CONTRACT PLANS**

**VERMONT AGENCY OF TRANSPORTATION**

**WILLISTON NHG 5500 (10)S  
"TAFT CORNERS"  
(US ROUTE 2 & VT ROUTE 2A)**

WILLISTON

VERMONT

**PAVEMENT MARKING & SIGN LAYOUT SHEET**

LAMOUREUX & DICKINSON  
Consulting Engineers Inc.  
14 Morse Drive  
Essex Junction, VT 05452  
(802) 878-4450  
Engineers-Planners-Surveyors

design  
RJD/JLC  
drawn  
DWE/JLC  
checked  
RJD  
scale  
1"=20'  
sht. no.